


AS-BUILT

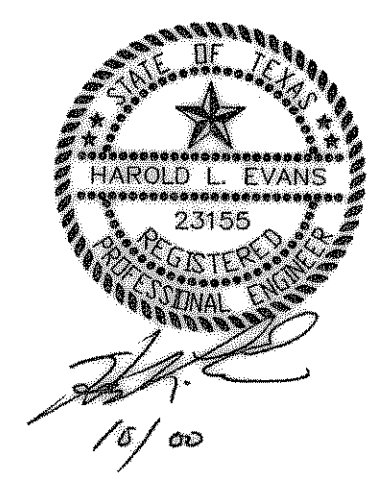

AS BUILT

		<b>HAROLD L. EVANS</b> CONSULTING ENGINEER P.O. BOX 28355 2331 CUS THOMASSON ROAD, SUITE 102 DALLAS, TEXAS 75228, (214) 328-0133		<b>LOT GRADING PLAN</b>		SHEET NO. 13
				<b>FOXCHASE NO. 6</b> <b>CITY OF ROCKWALL</b>		JOB NO. 98111
REVISION DESCRIPTION <small>FOXCHCR22</small>		DATE 8/19/99	SCALE 1" = 40'	DESIGN H.L.E.	DRAWN	