


STEVEN D. HILMERSRICH
VOL. 685, PG. 122

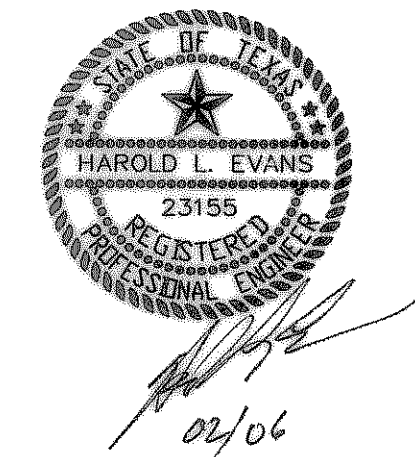

AS-BUILT

REVISION DESCRIPTION		DATE	SCALE	DESIGN	DRAWN	LOT GRADING PLAN FOXCHASE NO. 7 CITY OF ROCKWALL	SHEET NO. 9 11 JOB NO. 98111
		9/2/03	1" = 40'	H.L.E.			
		HAROLD L. EVANS CONSULTING ENGINEER P.O. BOX 570355 2331 GUS THOMASSON ROAD, SUITE 102 DALLAS, TEXAS 75370, (214) 328-8138					