



EXISTING DRAINAGE AREAS

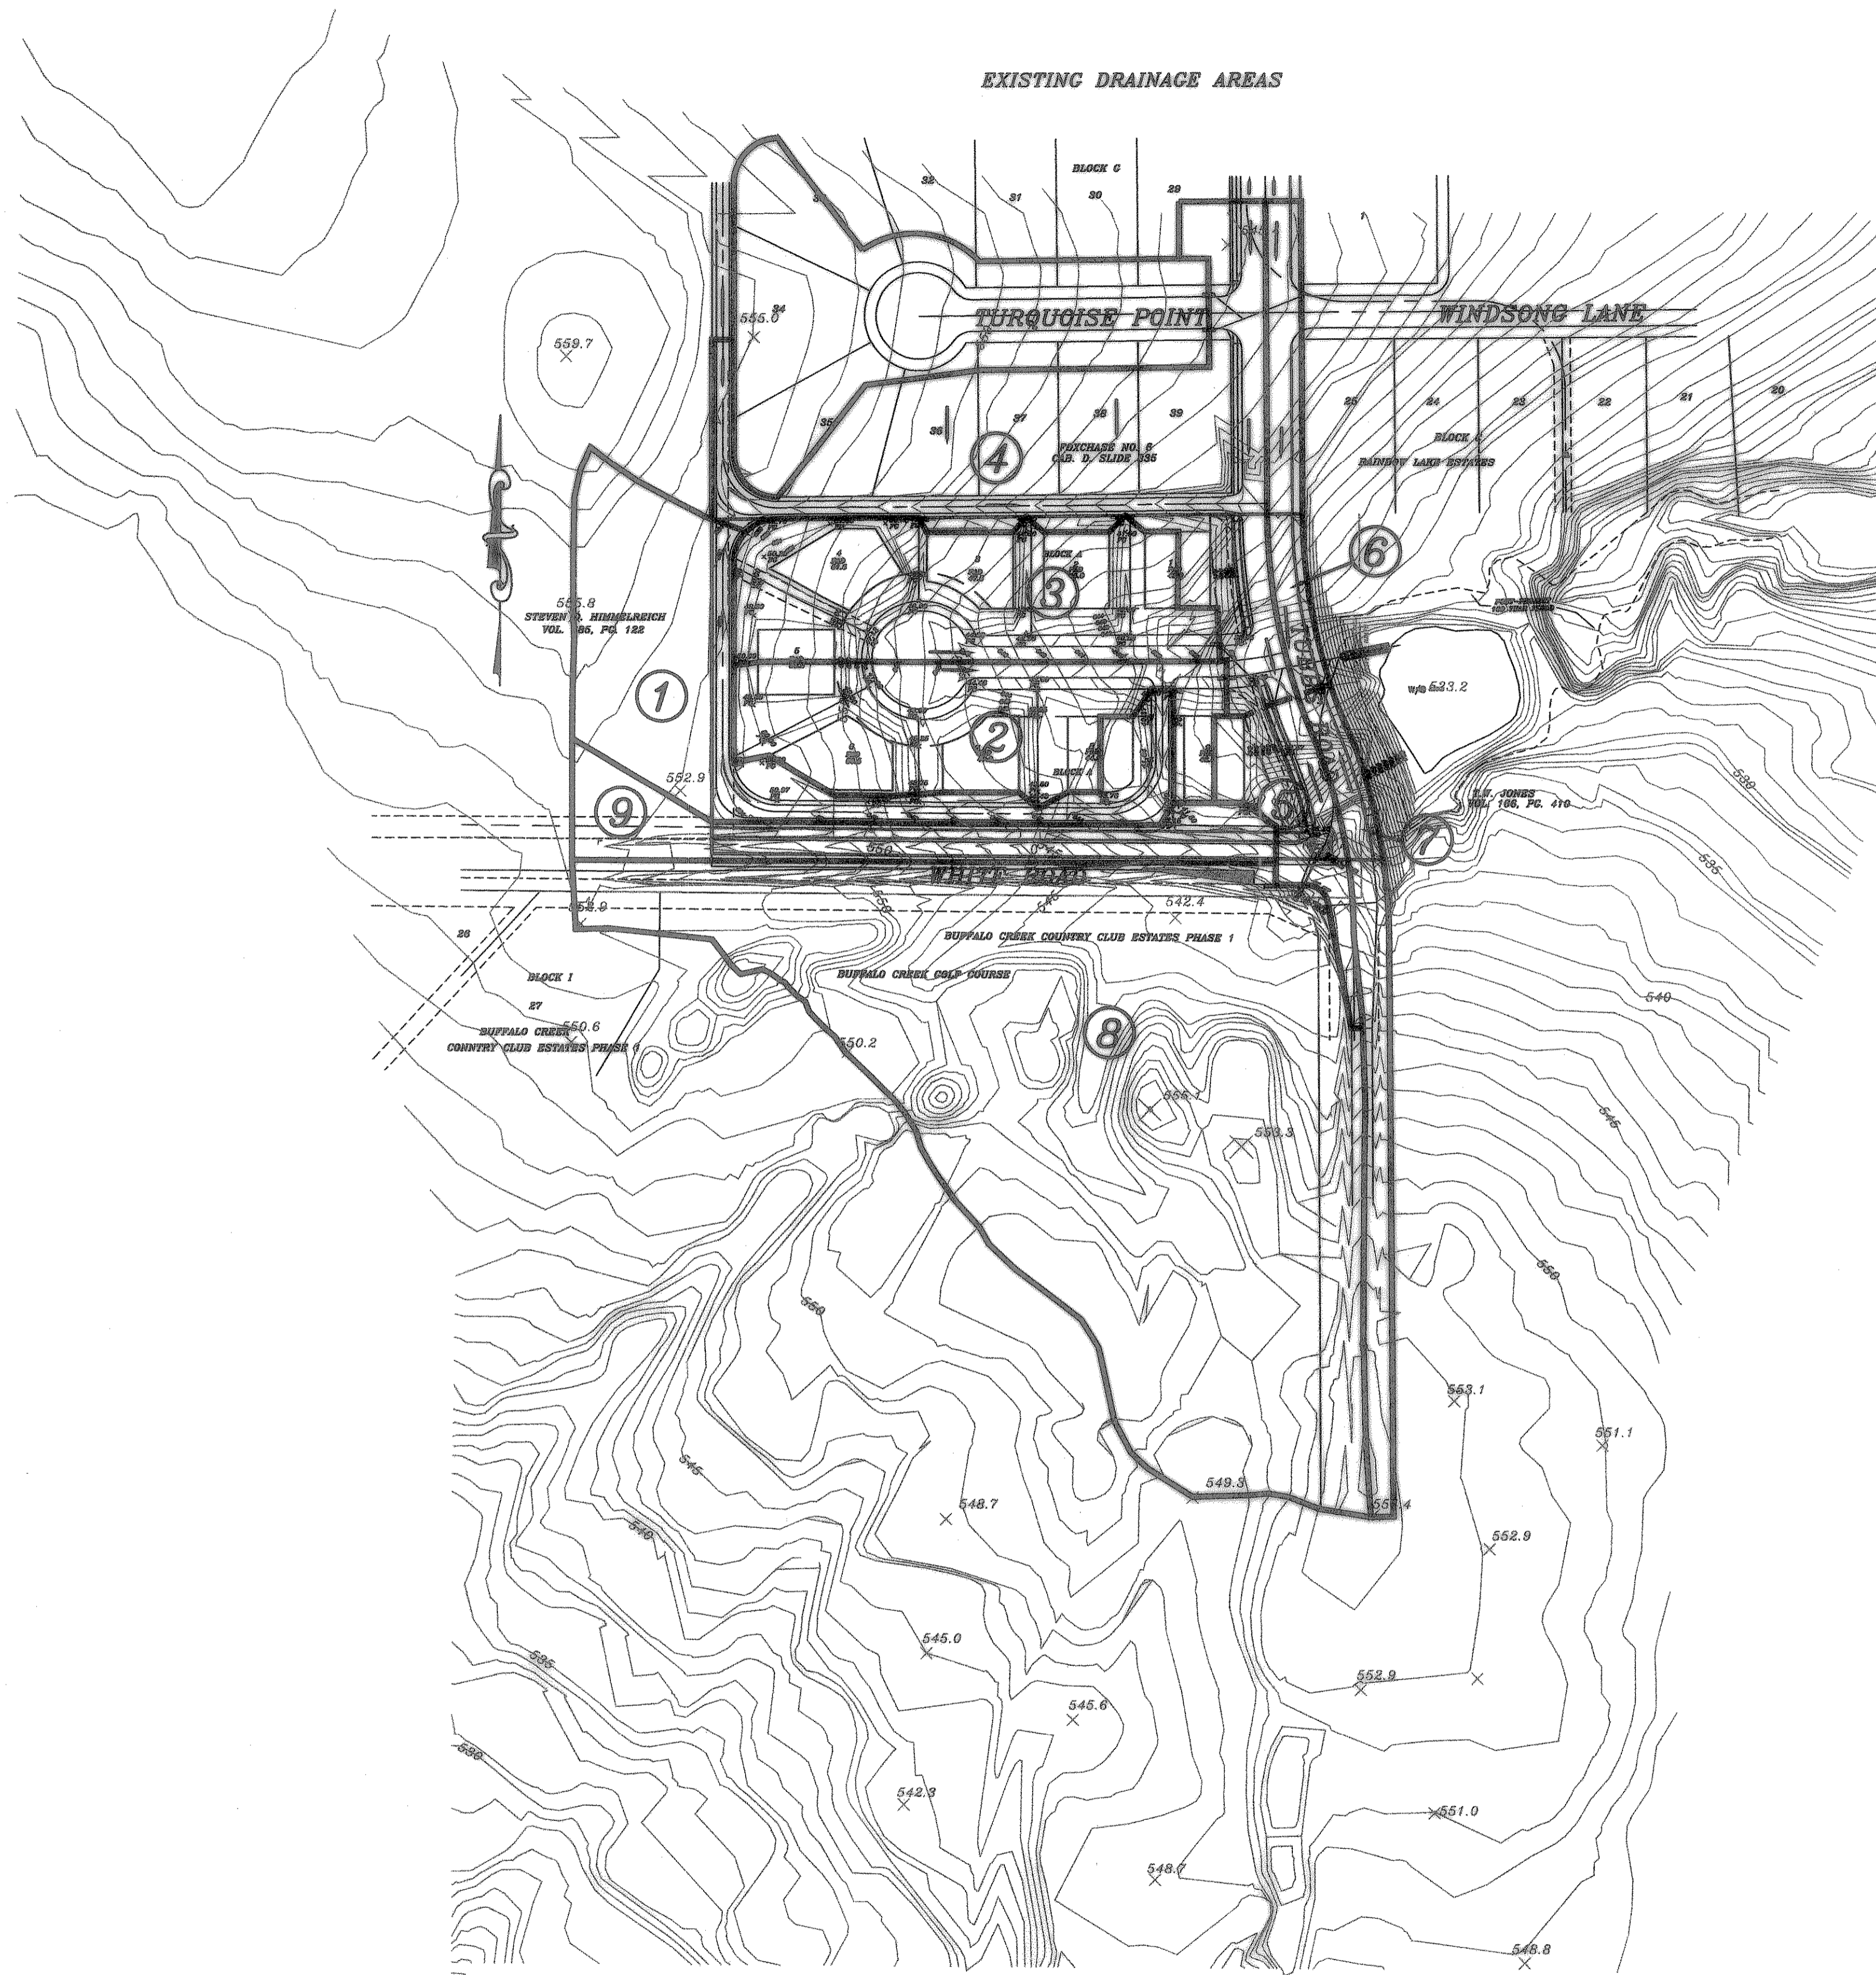

EXISTING CONDITIONS
DRAINAGE TABLE

DRAINAGE AREA NO.	ACRES	T.C.	C	I 100 YR.	Q 100 YR.	SUM Q 100 YR.
1	1.35	10	0.5	9.8	6.62	
2	1.08	"	"	"	5.29	11.91
3	1.22	"	"	"	5.98	17.89
4	1.95	"	"	"	9.56	27.45
5	0.36	"	"	"	1.76	29.21
6	0.34	"	"	"	1.67	30.88
7	0.48	"	"	"	2.35	33.23
8 (GOLF COURSE)	5.33	"	0.95	"	18.28	18.28
9	0.68	"	0.9	"	3.33	54.84

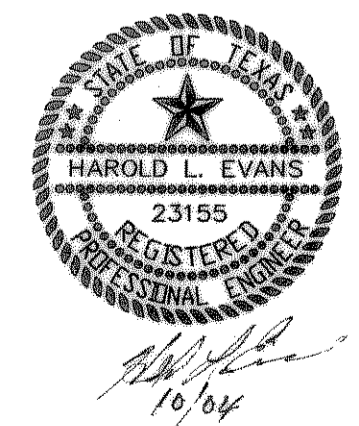

HAROLD L. EVANS CONSULTING ENGINEER P.O. BOX 570355 2331 GUS THOMASSON ROAD, SUITE 102 DALLAS, TEXAS 75270, (214) 328-8133		DRAINAGE AREA MAP EXISTING CONDITIONS FOXCHASE NO. 7 CITY OF ROCKWALL		SHEET NO. 6 11
REV.	DATE 6/8/04	SCALE 1" = 100'	DESIGN H.L.E.	JOB NO. 98111
POST DRN		REVISION DESCRIPTION	DATE 8/2/08	DRAWN