
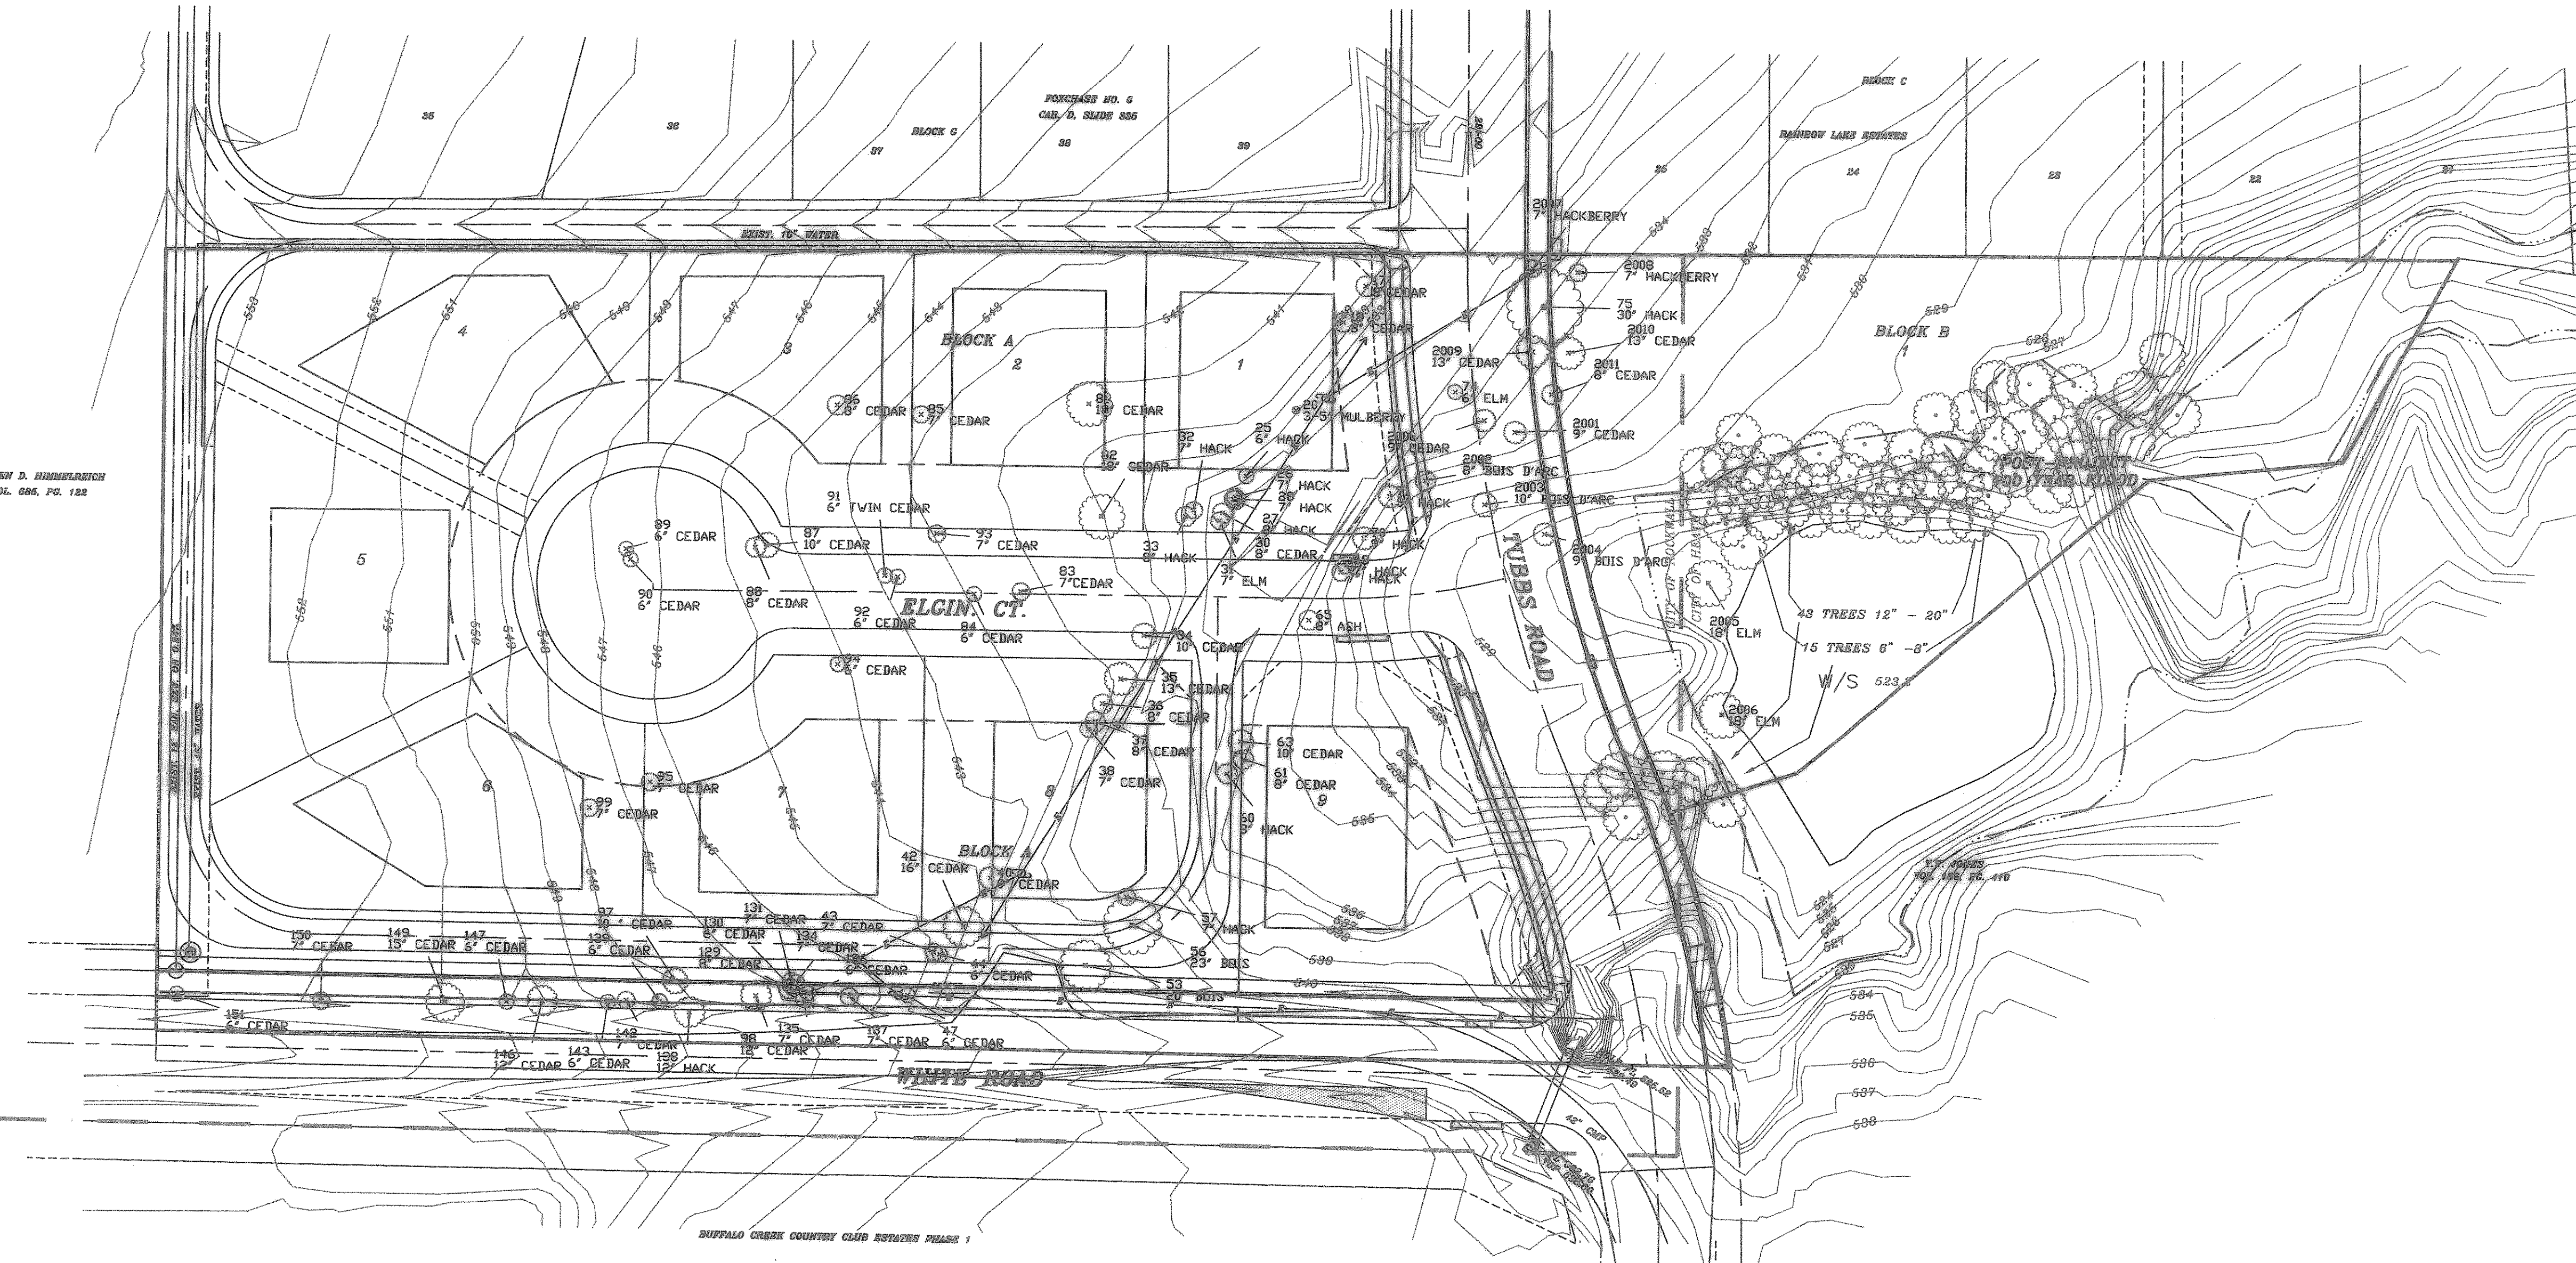


Foxchase No. 7 Tree List		Foxchase No. 7 Tree List	
No.	Type	No.	Type
17	8" Cedar	87	10" Cedar
18	8" Cedar	88	8" Cedar
20	3-5" Mulberry	89	6" Cedar
25	6" Hackberry	90	6" Cedar
26	7" Hackberry	91	6" Twin Cedar
27	8" Hackberry	92	6" Cedar
28	7" Hackberry	93	7" Cedar
30	8" Cedar	94	6" Cedar
31	7" Elm	95	7" Cedar
32	7" Hackberry	97	10" Cedar
33	8" Hackberry	98	12" Cedar
34	10" Cedar	129	8" Cedar
35	13" Cedar	130	6" Cedar
36	8" Cedar	131	7" Cedar
37	8" Cedar	134	7" Cedar
38	7" Cedar	135	7" Cedar
40	9" Cedar	136	6" Cedar
42	16" Cedar	137	7" Cedar
43	7" Cedar	138	12" Hackberry
44	6" Cedar	139	6" Cedar
47	6" Cedar	142	7" Cedar
53	20" Bois d'Arc	143	6" Cedar
56	23" Bois d'Arc	146	12" Cedar
57	7" Hackberry	147	6" Cedar
60	8" Hackberry	149	15" Cedar
61	8" Cedar	150	7" Cedar
63	10" Cedar	151	6" Cedar
65	8" Ash	2000	9" Cedar
67	7" Hackberry	2001	9" Cedar
68	7" Hackberry	2002	8" Bois d'Arc
70	9" Hackberry	2003	10" Bois d'Arc
71	9" Hackberry	2004	9" Elm
74	6" Elm	2005	18" Elm
75	30" Hackberry	2006	18" Elm
81	18" Cedar	2007	7" Hackberry
82	18" Cedar	2008	7" Hackberry
83	7" Cedar	2009	13" Cedar
84	6" Cedar	2010	13" Cedar
85	7" Cedar	2011	8" Cedar
86	8" Cedar		

Foxchase No. 7
Trees To Be Replaced

No.	Type
20	3-5" Mulberry
31	7" Elm
35	13" Cedar
42	16" Cedar
65	8" Ash
81	18" Cedar
82	18" Cedar
Tree Inches 95	

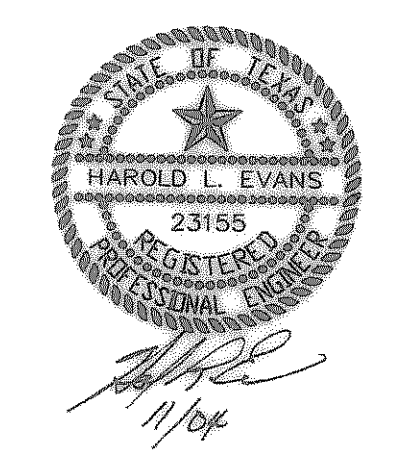

STEVEN D. HUNTER
VOL. 006, PG. 122

HAROLD L. EVANS CONSULTING ENGINEER P.O. BOX 570365 2881 GUS THOMASSON ROAD, SUITE 102 DALLAS, TEXAS 75270. (214) 388-8182		TREE SURVEY TUBBS ROAD FOXCHASE NO. 7 CITY OF ROCKWALL		SHEET NO. 10 11 JOB NO. 98111
REVISION DESCRIPTION FOX TREE	DATE 10/28/03	SCALE 1" = 40' 1" = 6'	DESIGN H.L.E.	DRAWN