


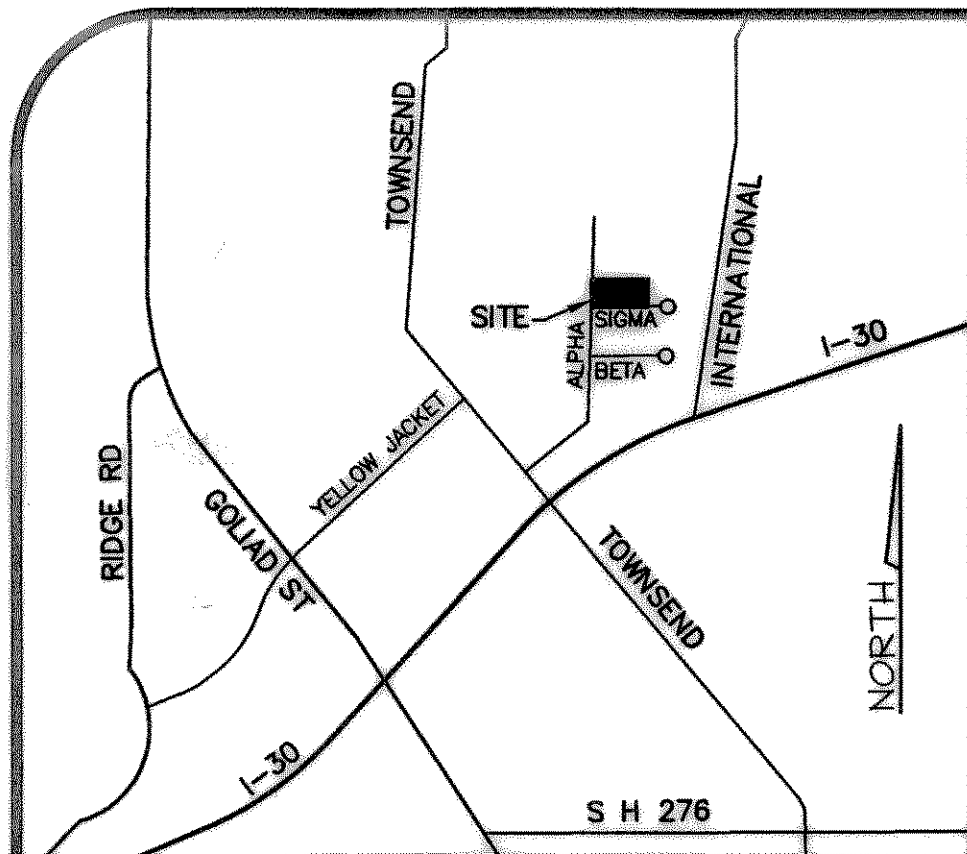

LOCATION MAP
NO SCALE

SITE CONSTRUCTION PLANS

FOR


GIS INVESTIGATIONS

ELLIS CENTER PHASE TWO

LOT 6, BLOCK C

IN THE


CITY OF ROCKWALL, TEXAS

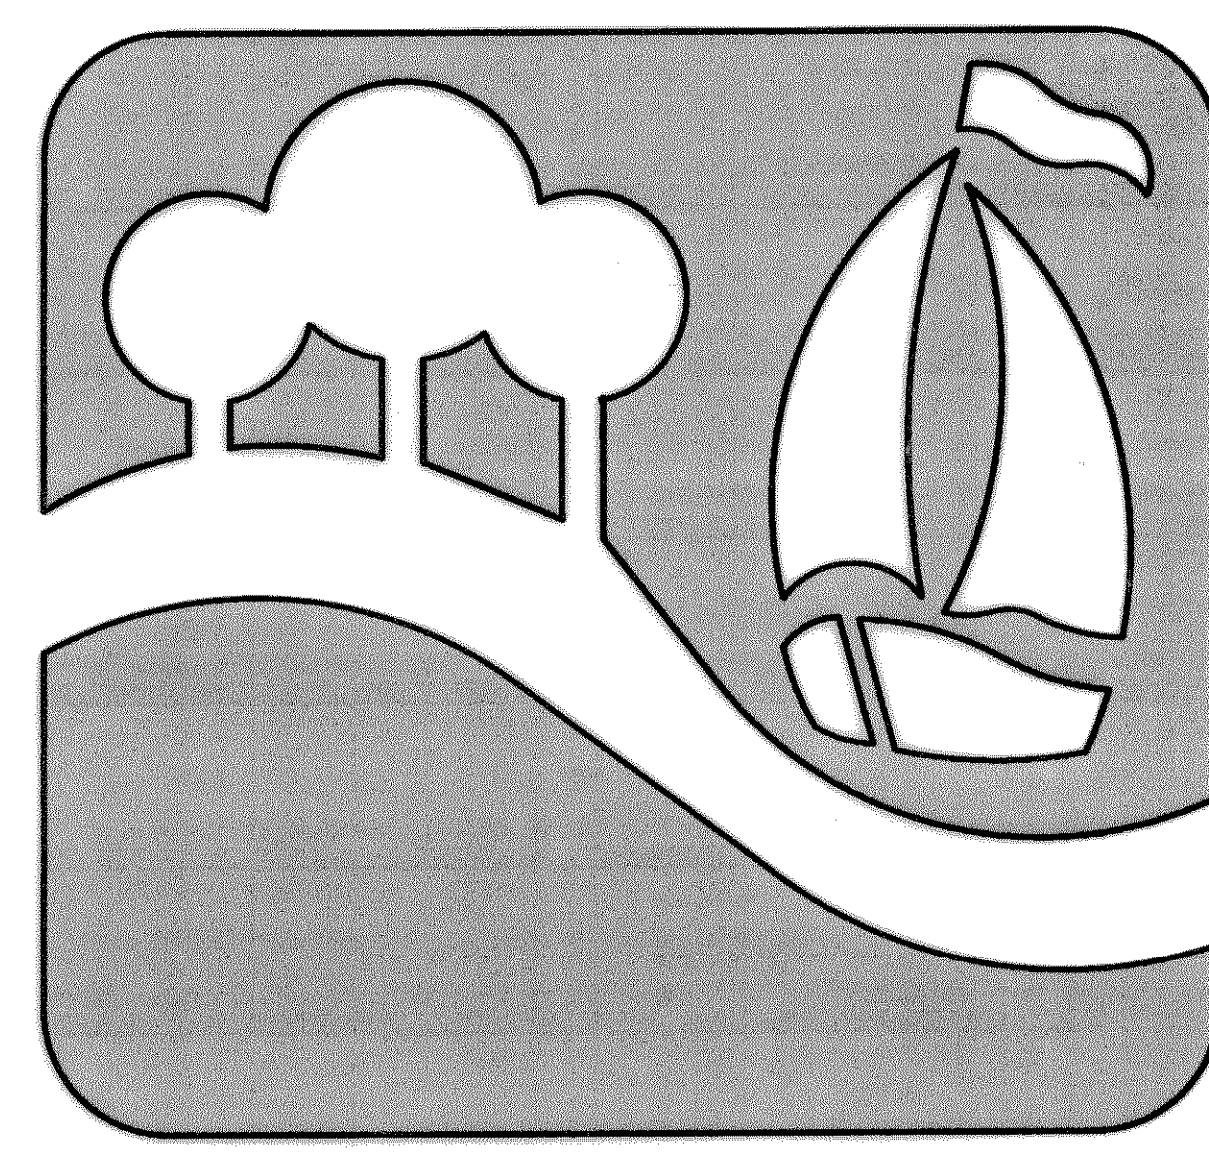


"THE NEW HORIZON"

SHEET INDEX

Sheet No.	Description
1	Cover Sheet
2	Replat
3	Replat
A1.01	Site Plan
C1	Grading Plan
C2	Drainage Area Map
C3	Water / Sewer & Drainage Plan
C4	Erosion Control
C5	Typical Details & Notes

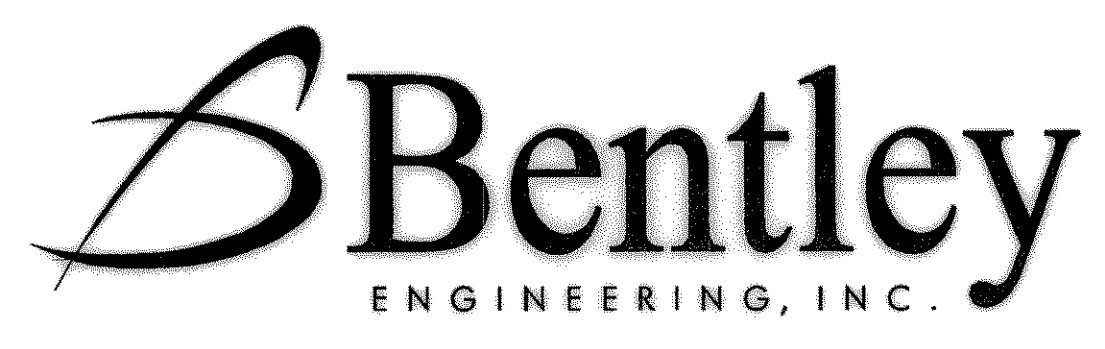

4125 BROADWAY BLVD.
SUITE A250
GARLAND, TEXAS 75043
PH. 972.240.4821
FA X. 972.240.0922

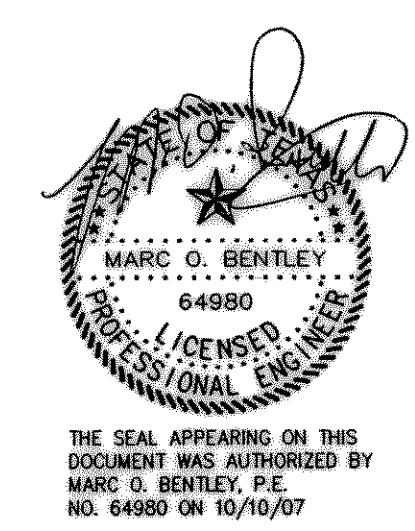

OWNER:
HILL TOLBERT & ASSOCIATES
496 NATIONAL DRIVE
ROCKWALL, TX 75032
972-771-6111
GREG HILL

RECORD DRAWING

IMPROVEMENTS INDICATED ON THIS PLAN WHERE MADE IN
ACCORDANCE WITH THE PROJECT PLANS & SPECIFICATIONS.
THE DESIGN ENGINEER IS NOT AWARE OF ANY CHANGES TO
THESE PLANS OTHER THAN THOSE PROVIDED ON A
CONTRACTOR SET OF MARKUPS.

DATE: JUNE 24, 2008

OCTOBER 2007