




DIRECTIONAL CURB RAMP	CITY OF ROCKWALL	DATE	DRAWING NO.
		MAR. '17	R-2125A

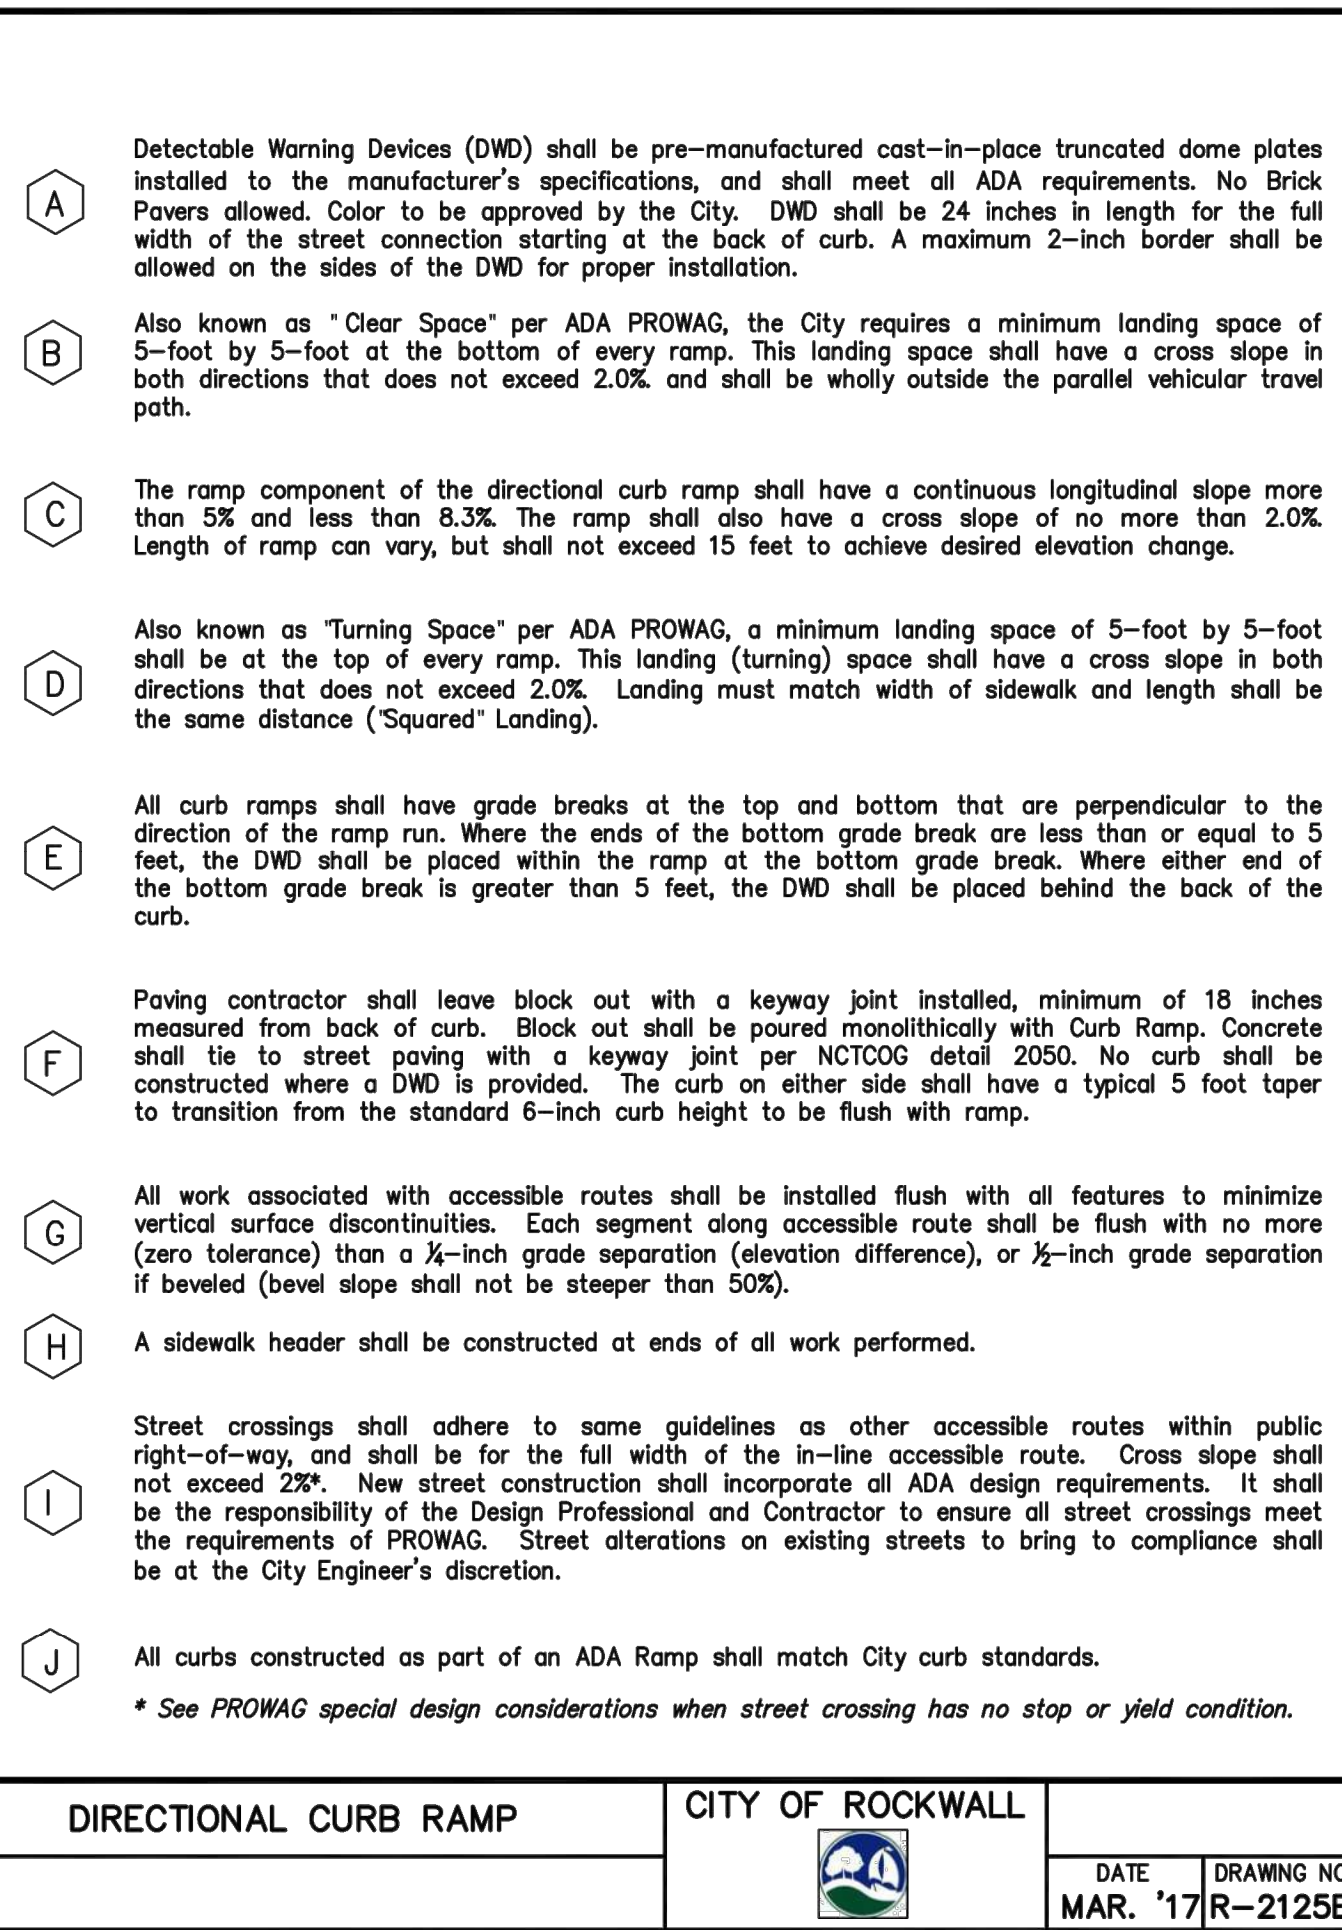


DIRECTIONAL CURB RAMP	CITY OF ROCKWALL	DATE	DRAWING NO.
		MAR. '17	R-2125B

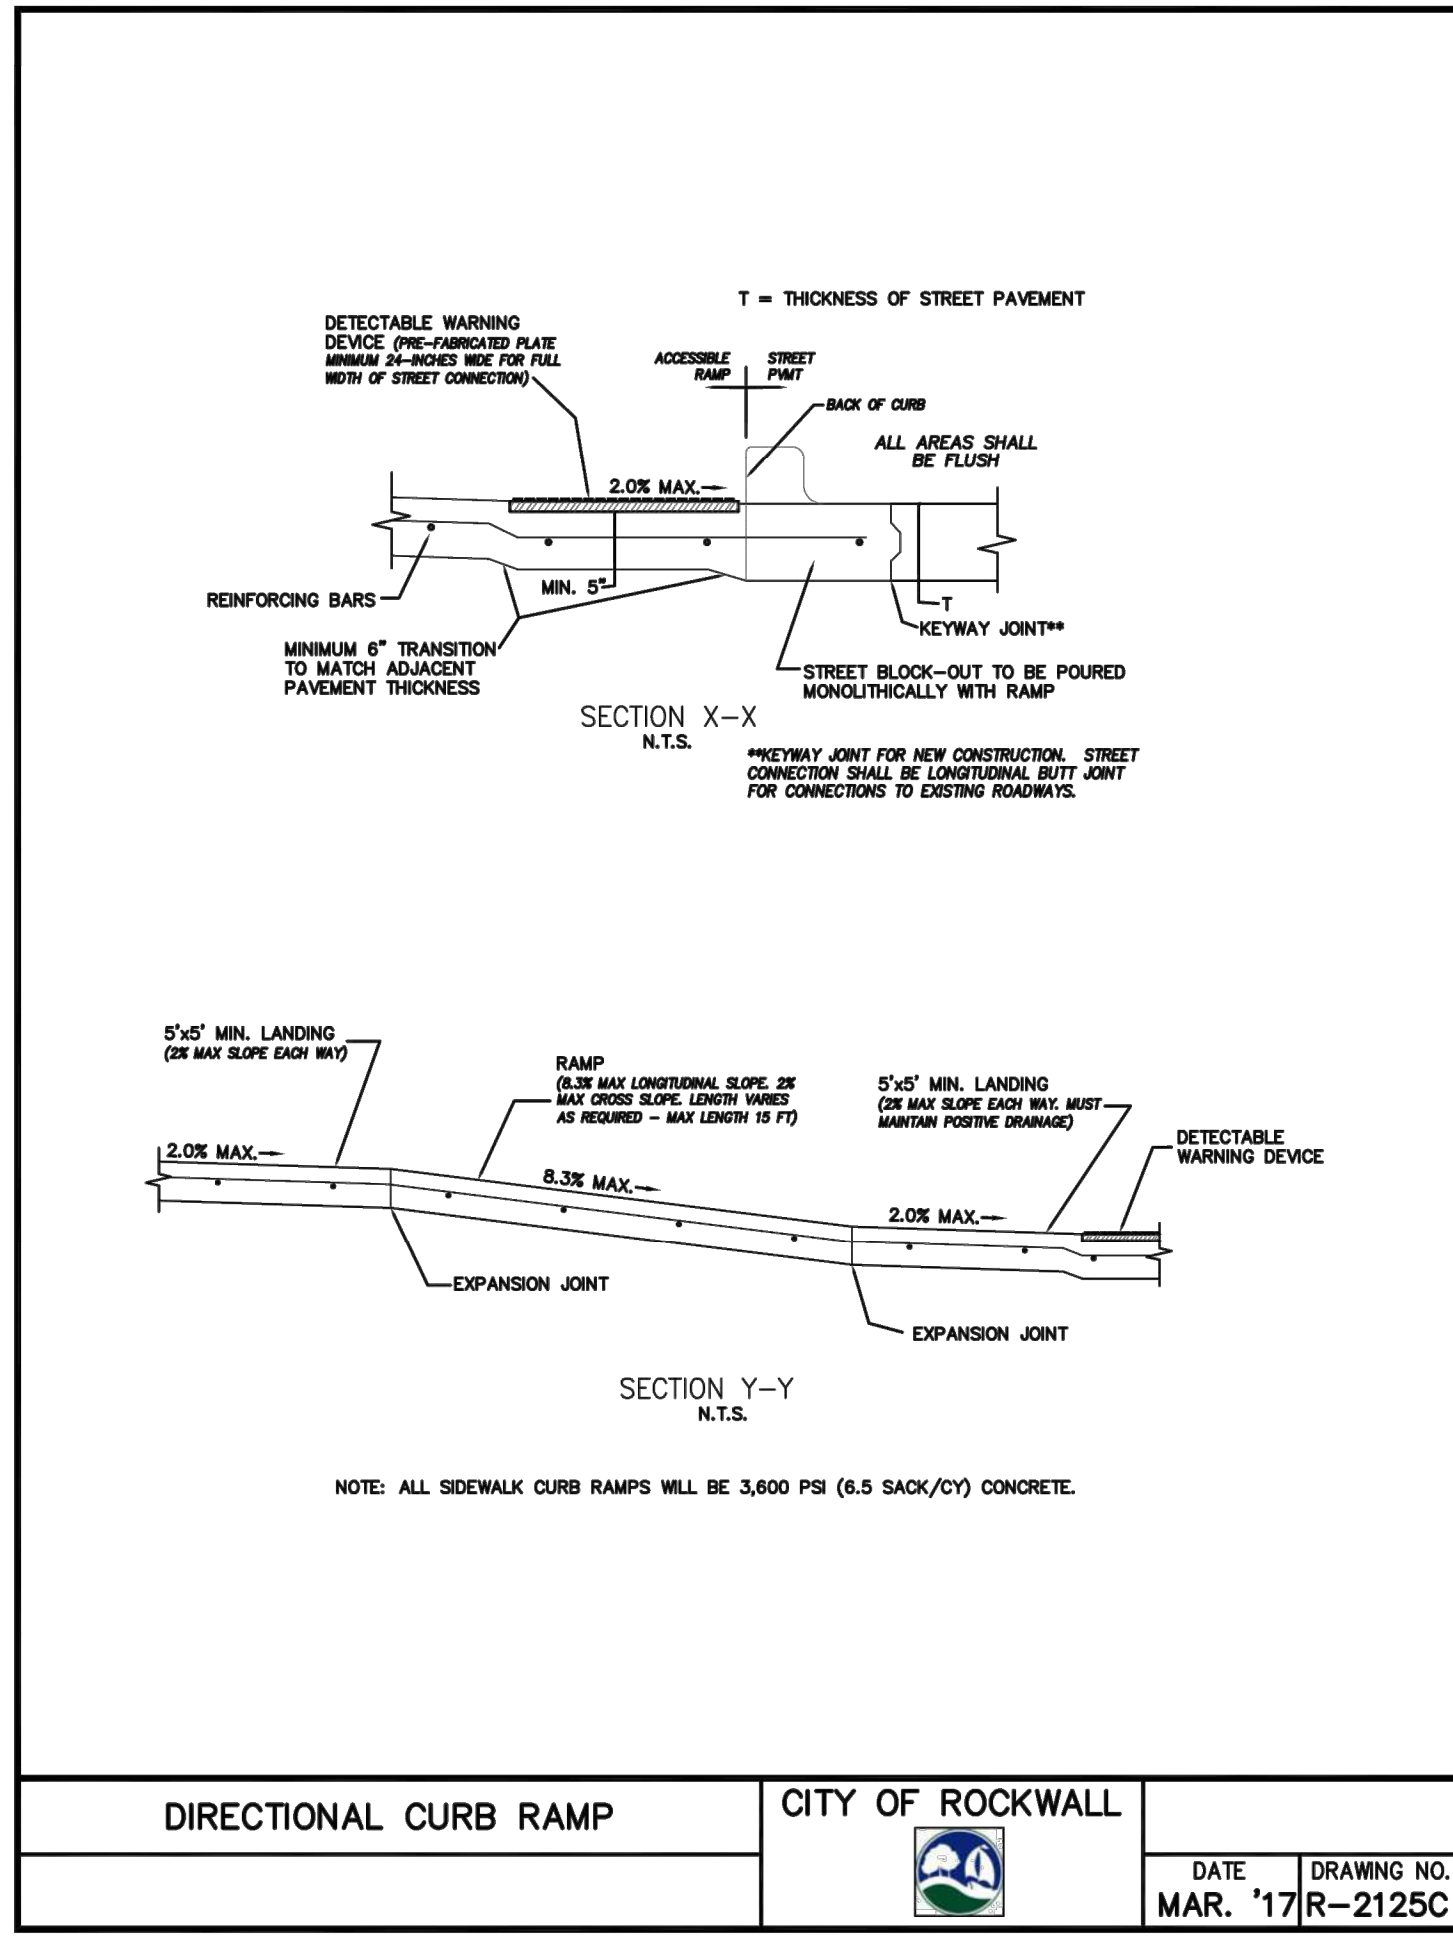


DIRECTIONAL CURB RAMP	CITY OF ROCKWALL	DATE	DRAWING NO.
		MAR. '17	R-2125C

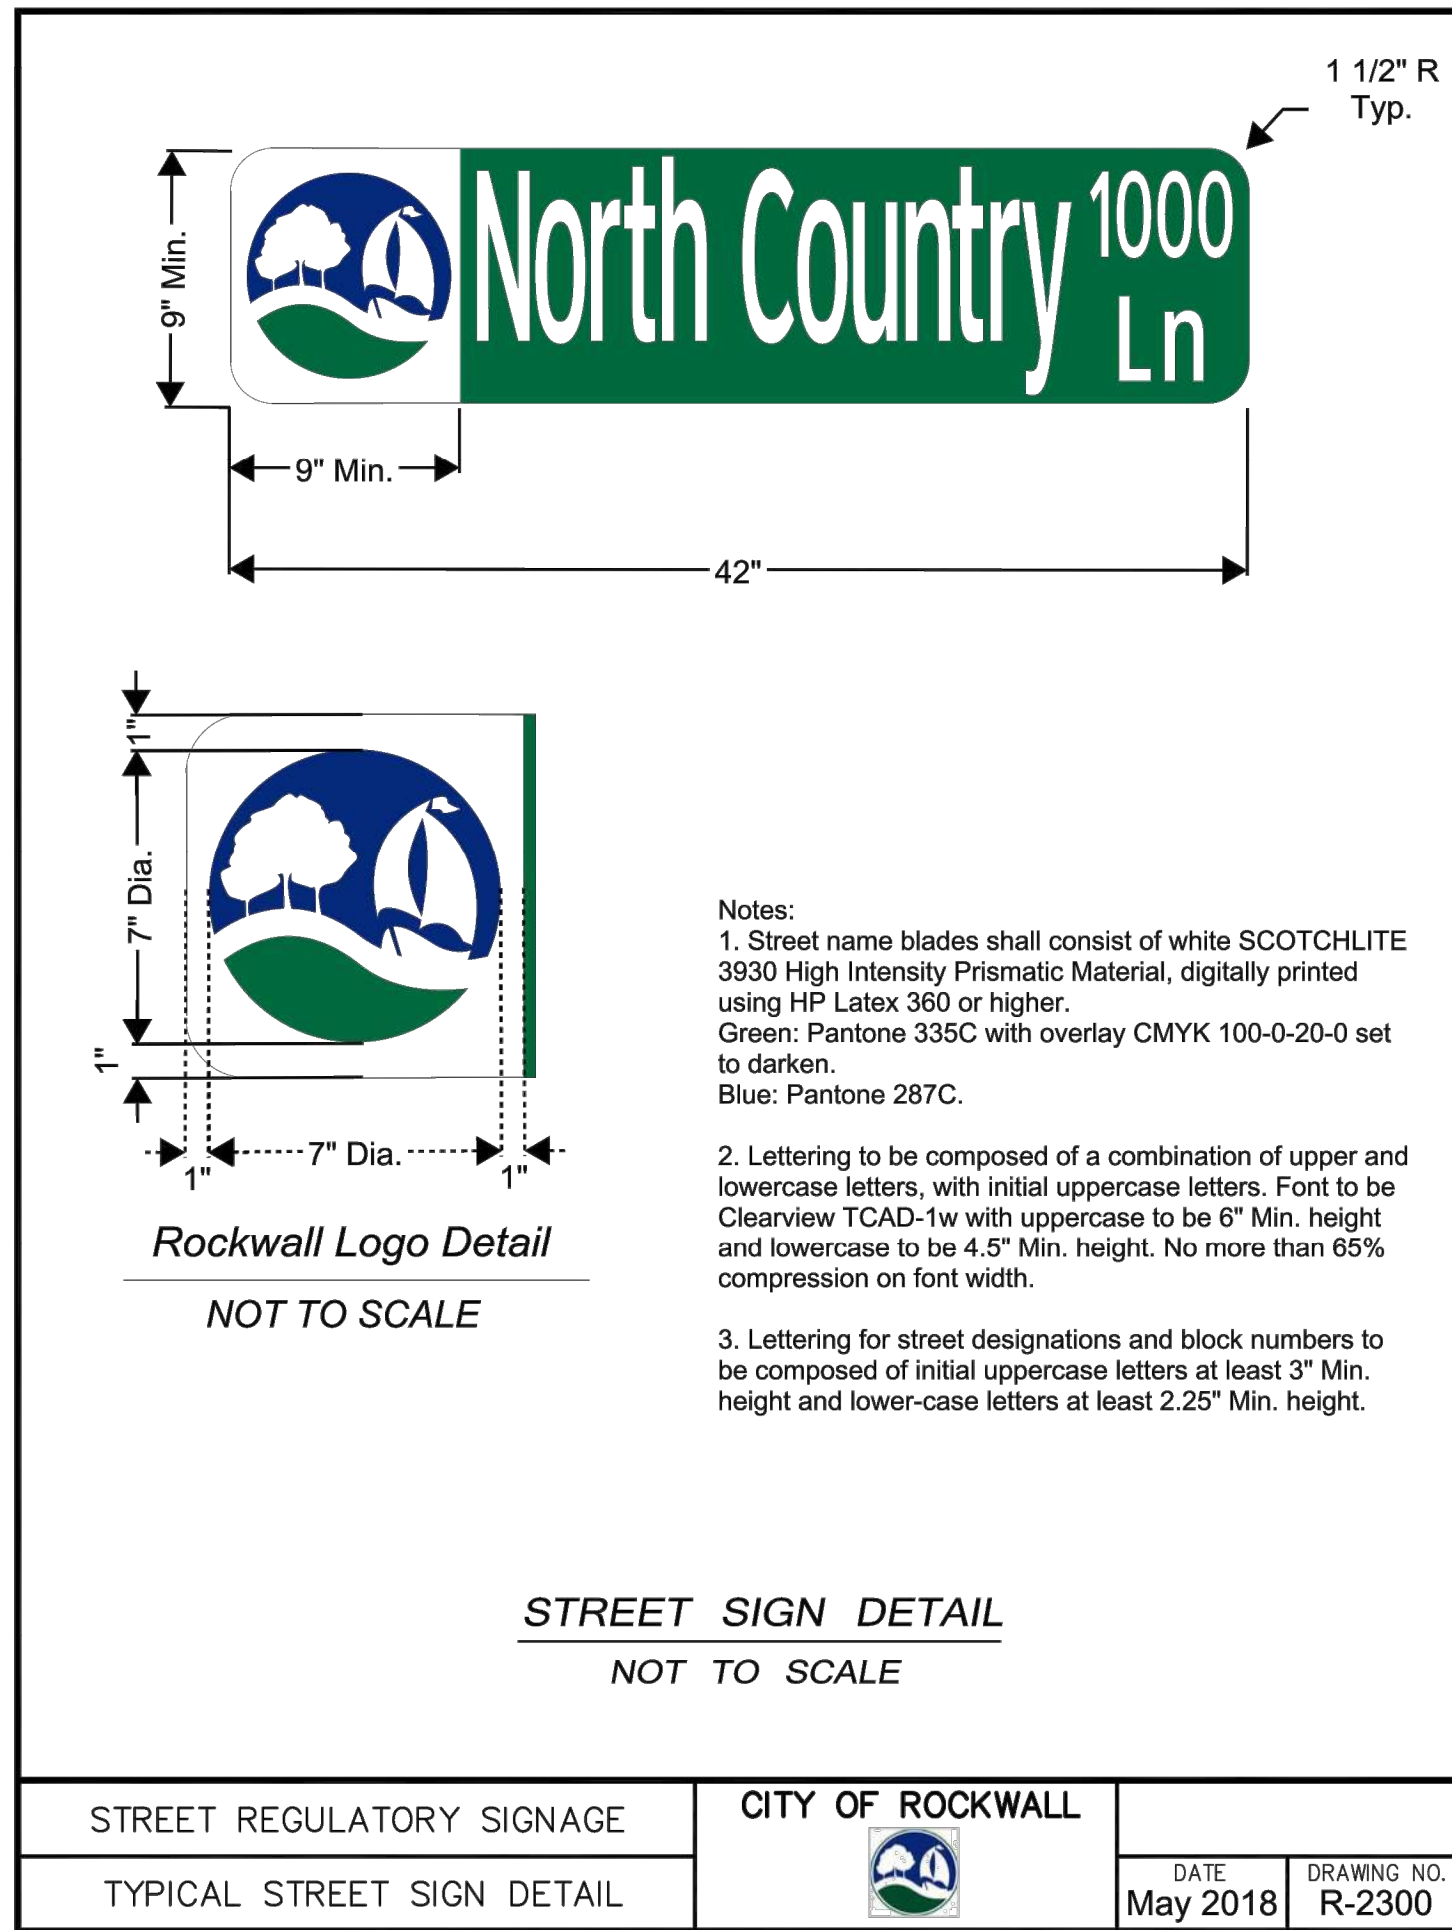

STREET REGULATORY SIGNAGE	CITY OF ROCKWALL	DATE	DRAWING NO.
TYPICAL STREET SIGN DETAIL		May 2018	R-2300

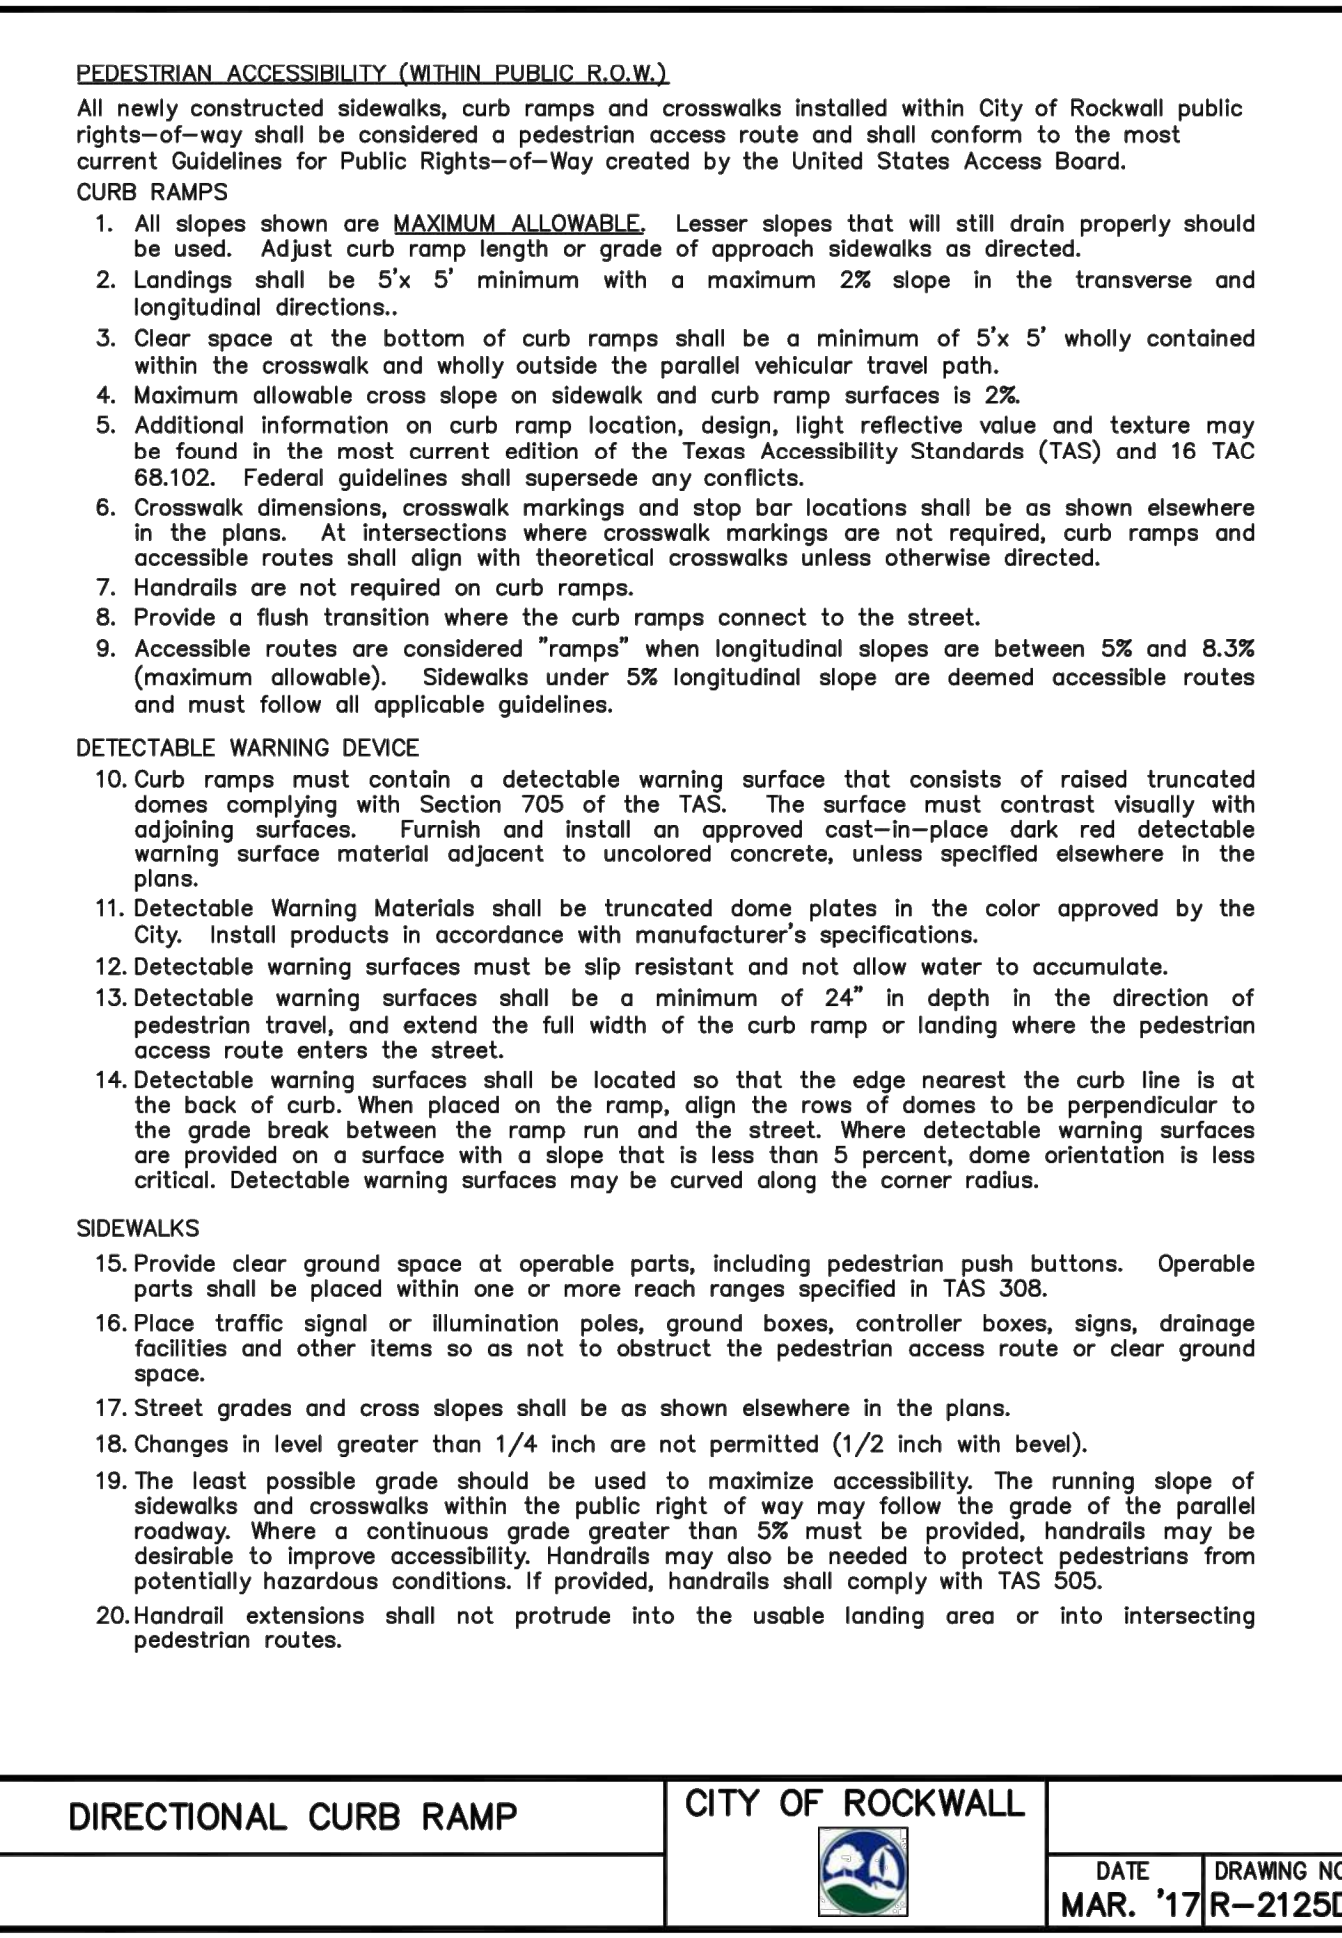

DIRECTIONAL CURB RAMP	CITY OF ROCKWALL	DATE	DRAWING NO.
		MAR. '17	R-2125D

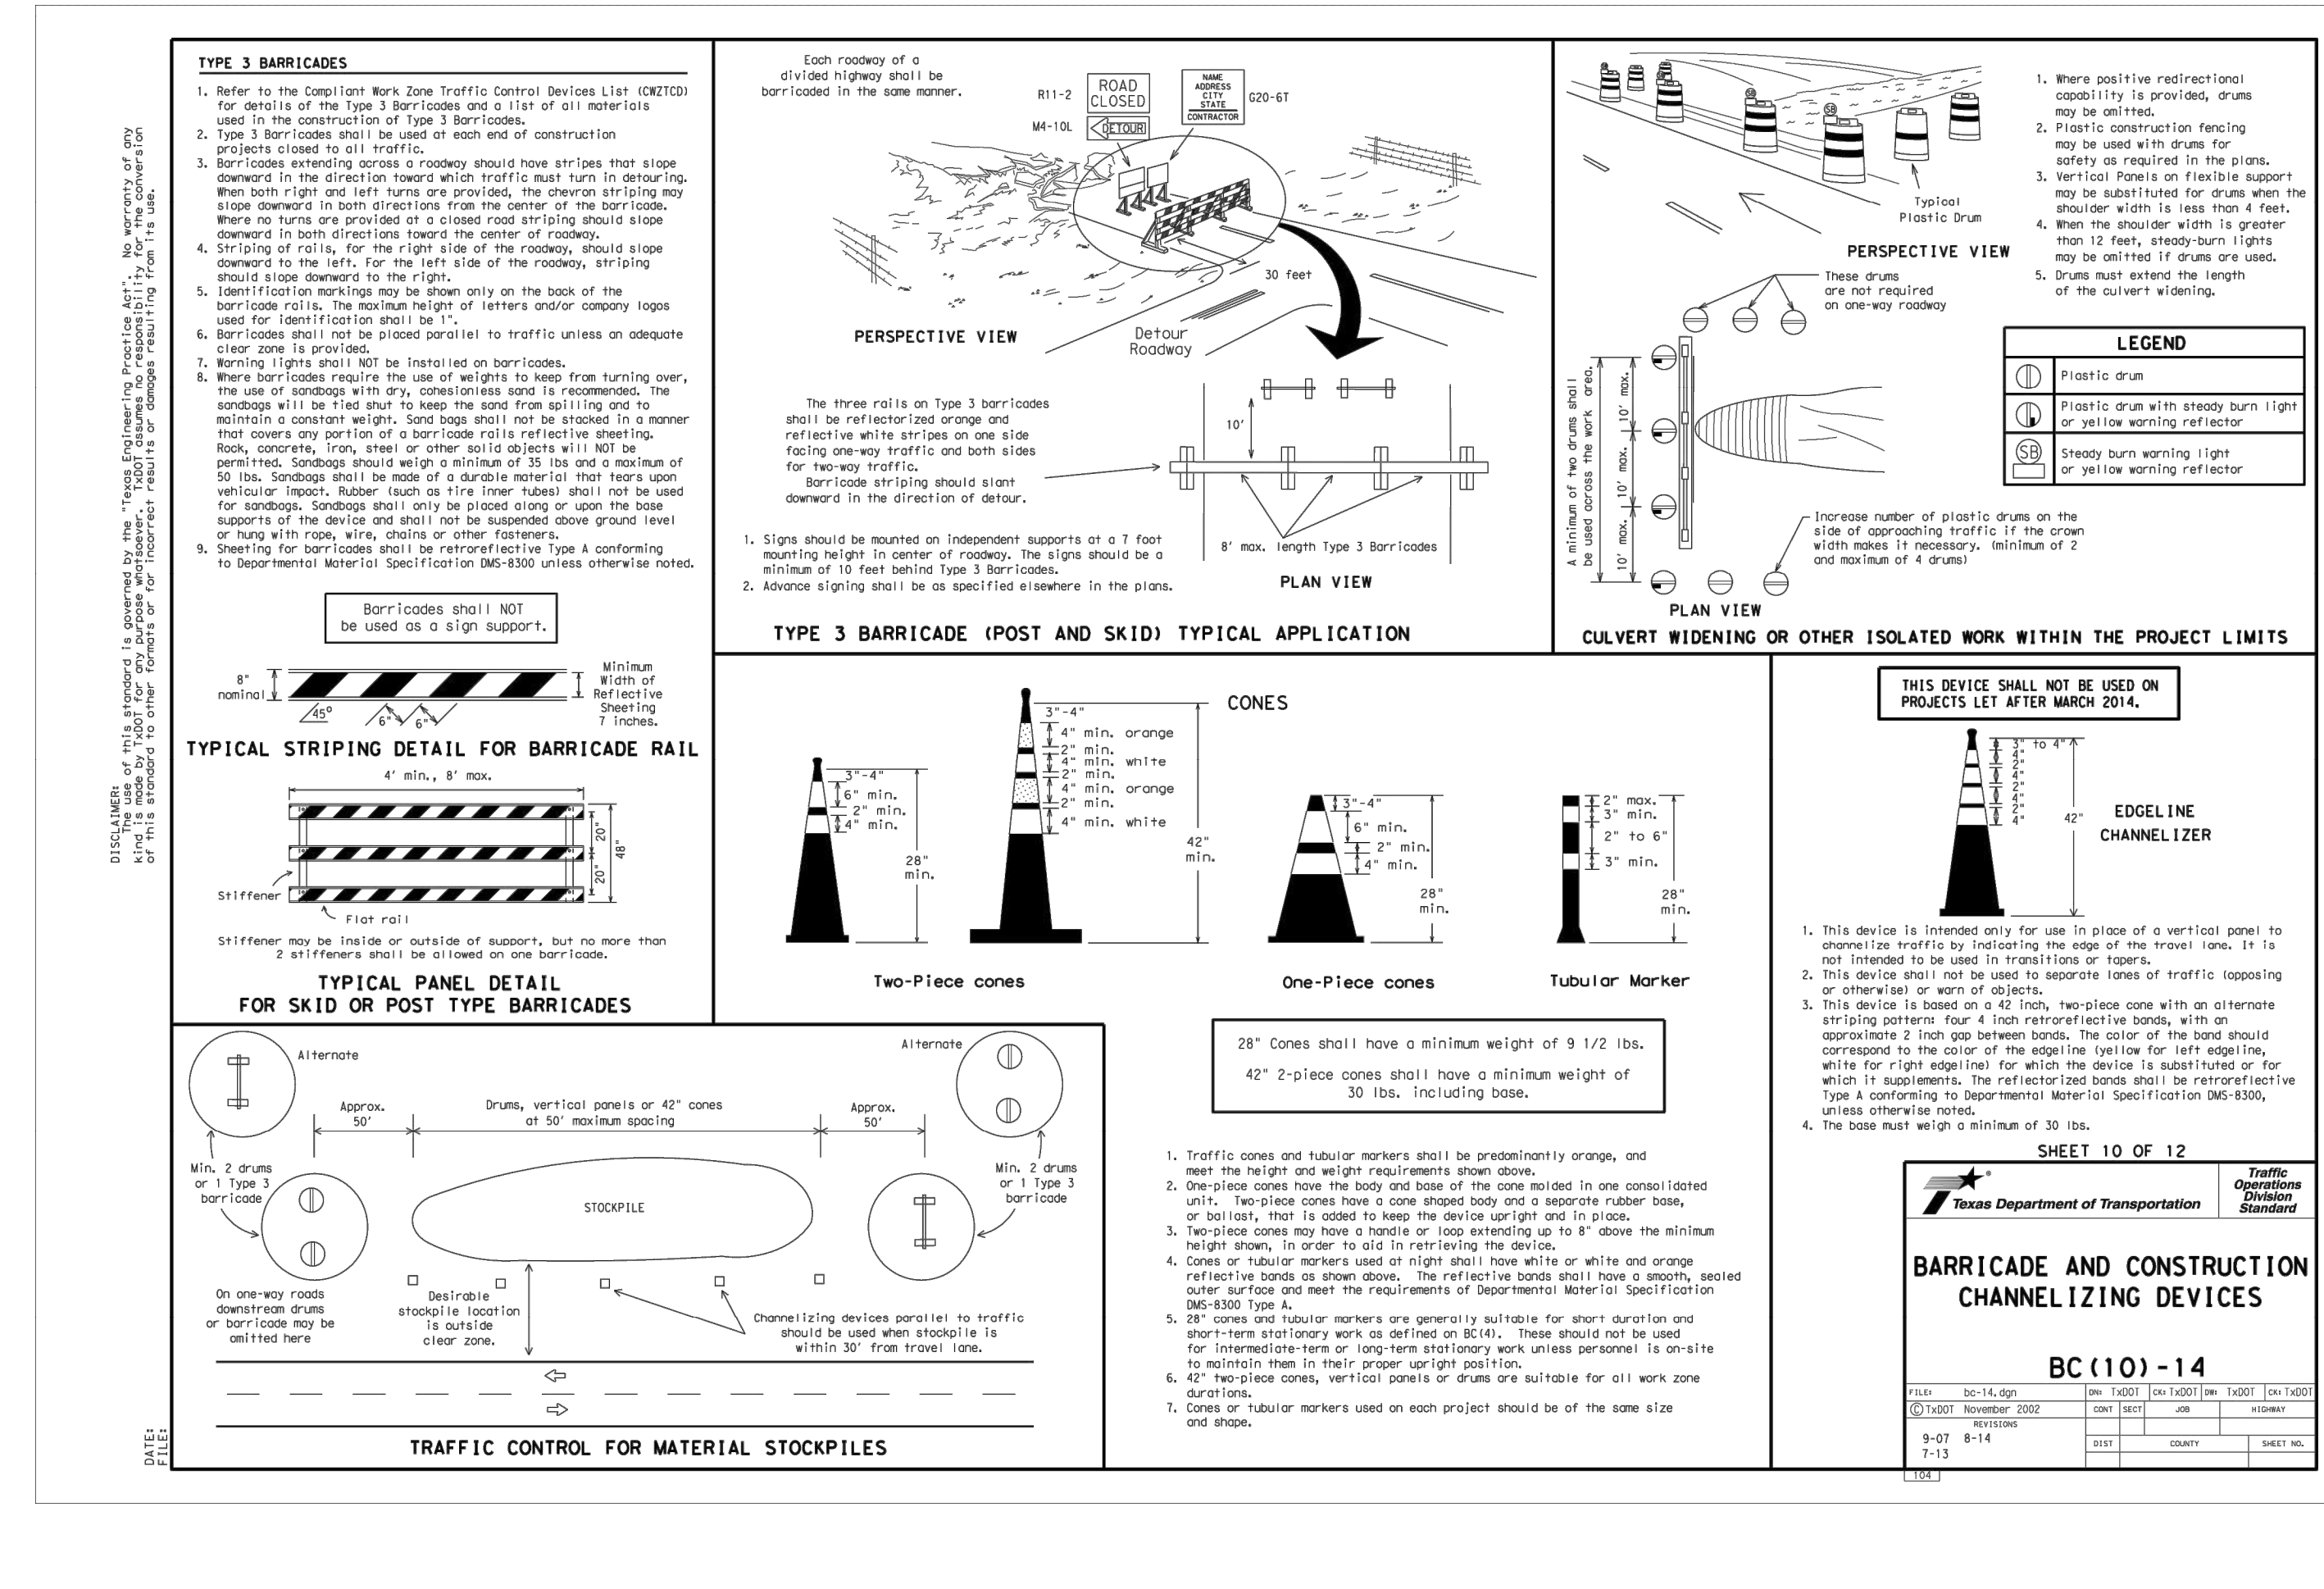

DIRECTIONAL CURB RAMP	CITY OF ROCKWALL	DATE	DRAWING NO.
		MAR. '17	R-2125E

DATE

NO. REVISION

STATE OF TEXAS
ADAM S. REEVES
 98410
 LICENSED PROFESSIONAL ENGINEER
 6.8.2021

PAPE-PAWSON ENGINEERS
 FORT WORTH | SAN ANTONIO | AUSTIN | HOUSTON | DALLAS
 6500 W HWY. STE 700 | FT. WORTH, TX 76102 | 817.870.8668
 TEXAS BOARD OF PROFESSIONAL ENGINEERS, FIRM REGISTRATION #470

RECORD DRAWING

THESE RECORD DRAWINGS ARE BASED ON AS-BUILT DOCUMENTS PROVIDED BY THE CONTRACTOR OR DEVELOPER. FIELD INSPECTION OF CONSTRUCTION, IF REQUIRED FOR COMPLIANCE WITH CERTAIN REGULATORY STANDARDS, WAS NOT PERFORMED BY THE DESIGN ENGINEER. IT IS NOT GUARANTEED THAT THIS DOCUMENT REPRESENTS AS-BUILT CONDITIONS.

03/22/2022

GIDEON GROVE - PHASE 2
 CITY OF ROCKWALL, ROCKWALL COUNTY, TEXAS

PAVING DETAILS

PLAT NO. #

JOB NO. 6126300

DATE June 21

DESIGNER COR

CHECKED COR DRAWN COR

SHEET 31