


PRE-DEVELOPMENT DRAINAGE AREA CALCULATIONS											
Area ID.	Areas Drained				Weighted Runoff Coefficient C	CA	Tc (min)	Design Storm Frequency	100 Year (in/hr)	Q100 Year (cfs)	Drains To/Remarks
	Total Drainage Area (acres)	Parks or Open Area (C=0.35) (acres)	Residential (C=0.5) (acres)	Commercial (C=0.9) (acres)							
(1)	(2)	(3)	(4)	(5)	(6)	(7)	(8)	(9)	(10)	(11)	(12)
Onsite		0.35	0.5	0.9							
A	25.50	25.50			0.35	8.93	20	100	8.30	74.08	Drain to existing 36" Pipe
B1	0.78	0.78			0.35	0.27	20	100	8.30	2.27	Existing Inlet in John King
B2	0.60	0.60			0.35	0.21	20	100	8.30	1.74	Existing Inlet in John King
B3	1.11	1.11			0.35	0.39	20	100	8.30	3.22	Existing Inlet in John King
B4	0.36	0.36			0.35	0.13	20	100	8.30	1.05	Existing Inlet in John King
C	1.72	1.72			0.35	0.60	20	100	8.30	5.00	Existing Wye Inlet
TOTAL	30.07									81.31	

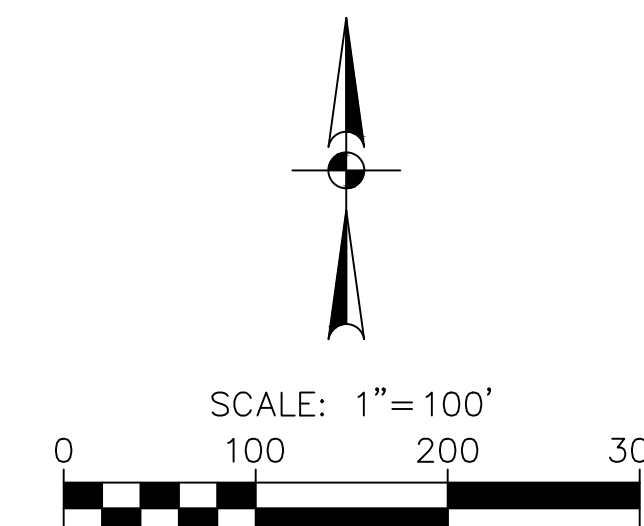

BENCHMARKS

BM No. 1
 X-CUT SET IN CONCRETE LOCATED IN THE CENTER OF A CURB INLET IN THE WEST SOUTHWESTERLY CURB LINE OF NORTH JOHN KING BOULEVARD AND BEING +/- 235' SOUTHWEST OF THE NORTHWEST CORNER OF THE SUBJECT TRACT AND +/- 535' NORTHWEST OF THE INTERSECTION OF N. JOHN KING BOULEVARD AND EAST QUAIL RUN ROAD. ELEV. 546.16'
BM No. 2
 X-CUT SET IN CONCRETE LOCATED IN THE CENTER OF A CURB INLET IN THE WEST CURB LINE OF NORTH JOHN KING BOULEVARD AND BEING +/- 662' NORTH OF THE INTERSECTION NORTH JOHN KING BOULEVARD AND WEST QUAIL RUN ROAD AND +/- 723' SOUTHWEST OF THE INTERSECTION OF N. JOHN KING BOULEVARD AND EAST QUAIL RUN ROAD. ELEV. 530.38'

MASTER DRAINAGE LEGEND

- EXISTING MAJOR CONTOUR
- EXISTING MINOR CONTOUR
- DRAINAGE AREA
- - - EXISTING STORM DRAIN
- PROPOSED FLOW DIRECTION
- A-1 1.00 DRAINAGE AREA ACRES
- - - OVERLAND/SHEET FLOW
- - - SHALLOW CONCENTRATED
- - - CHANNEL

RECORD DRAWING

THESE RECORD DRAWINGS ARE BASED ON AS-BUILT DOCUMENTS PROVIDED BY THE CONTRACTOR OR DEVELOPER. FIELD INSPECTION OF CONSTRUCTION, IF REQUIRED FOR COMPLIANCE WITH CERTAIN REGULATORY STANDARDS, WAS NOT PERFORMED BY THE DESIGN ENGINEER. IT IS NOT GUARANTEED THAT THIS DOCUMENT REPRESENTS "AS-BUILT" CONDITIONS.
 03/22/2022


UTILITY NOTE

THE EXISTING UTILITIES SHOWN ON THESE PLANS WERE COMPILED FROM VARIOUS SOURCES AND ARE INTENDED TO SHOW THE GENERAL EXISTENCE AND LOCATION OF THE UTILITY INFORMATION ON THE PLANS. THE CONTRACTOR SHALL CONTACT A UTILITY LOCATING SERVICE 48 HOURS PRIOR TO ANY CONSTRUCTION ACTIVITY. THE CONTRACTOR SHALL VERIFY THE EXACT LOCATION AND OF ALL EXISTING UTILITIES AND DETERMINE IF THERE ARE ANY CONFLICTS WITH THE PROPOSED FACILITIES. THE CONTRACTOR SHALL NOTIFY THE ENGINEER IMMEDIATELY WHEN CONFLICTS WITH EXISTING UTILITIES ARE DISCOVERED.

RESPONSIBILITY NOTE

ALL RESPONSIBILITY FOR THE ADEQUACY OF DESIGN REMAINS WITH THE DESIGN ENGINEER. THE CITY OF ROCKWALL, IN REVIEWING AND RELEASING PLANS FOR CONSTRUCTION, ASSUMES NO RESPONSIBILITY FOR THE ADEQUACY OR ACCURACY OF DESIGN.

NO.	REVISION	DATE

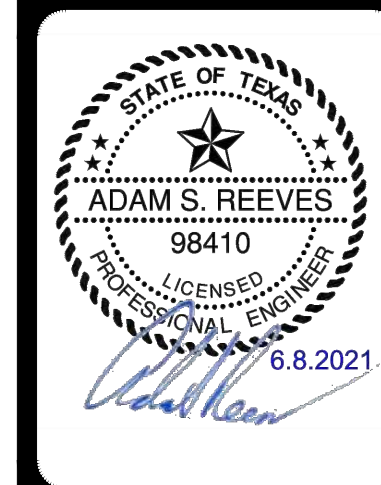

PAPE-DAWSON ENGINEERS
 FORT WORTH | SAN ANTONIO | AUSTIN | HOUSTON | DALLAS
 6500 W HWY. STE 700 | FT. WORTH, TX 76102 | 817.870.8668
 TEXAS BOARD OF PROFESSIONAL ENGINEERS, FIRM REGISTRATION #470

GIDEON GROVE - PHASE 2
 CITY OF ROCKWALL, ROCKWALL COUNTY, TEXAS
DRAINAGE AREA MAP
 EXISTING

PLAT NO.	#
JOB NO.	6126300
DATE	June 21
DESIGNER	ML
CHECKED	ASR DRAWN ML
SHEET	6

Date: Jun 09, 2021, 4:16pm User: fb_1fengrnc
 File: S:\projects\6126300\2.0 Design\2.4 Civil\2.4.3 Plan Sheets\3004-6126300.dwg
 THIS DOCUMENT HAS BEEN PRODUCED FROM MATERIAL THAT WAS STORED AND/OR TRANSMITTED ELECTRONICALLY AND MAY HAVE BEEN INADVERTENTLY ALTERED. RELY ONLY ON FINAL HARDCOPY MATERIALS BEARING THE CONSULTANT'S ORIGINAL SIGNATURE AND SEAL. AERIAL IMAGERY PROVIDED BY GOOGLE/© UNLESS OTHERWISE NOTED. Imagery © 2016, CAROL Digital Globe, Texas Orthology Program, USDA Farm Service Agency.