


LINE ~ "A"
CRESTWOOD BLVD.

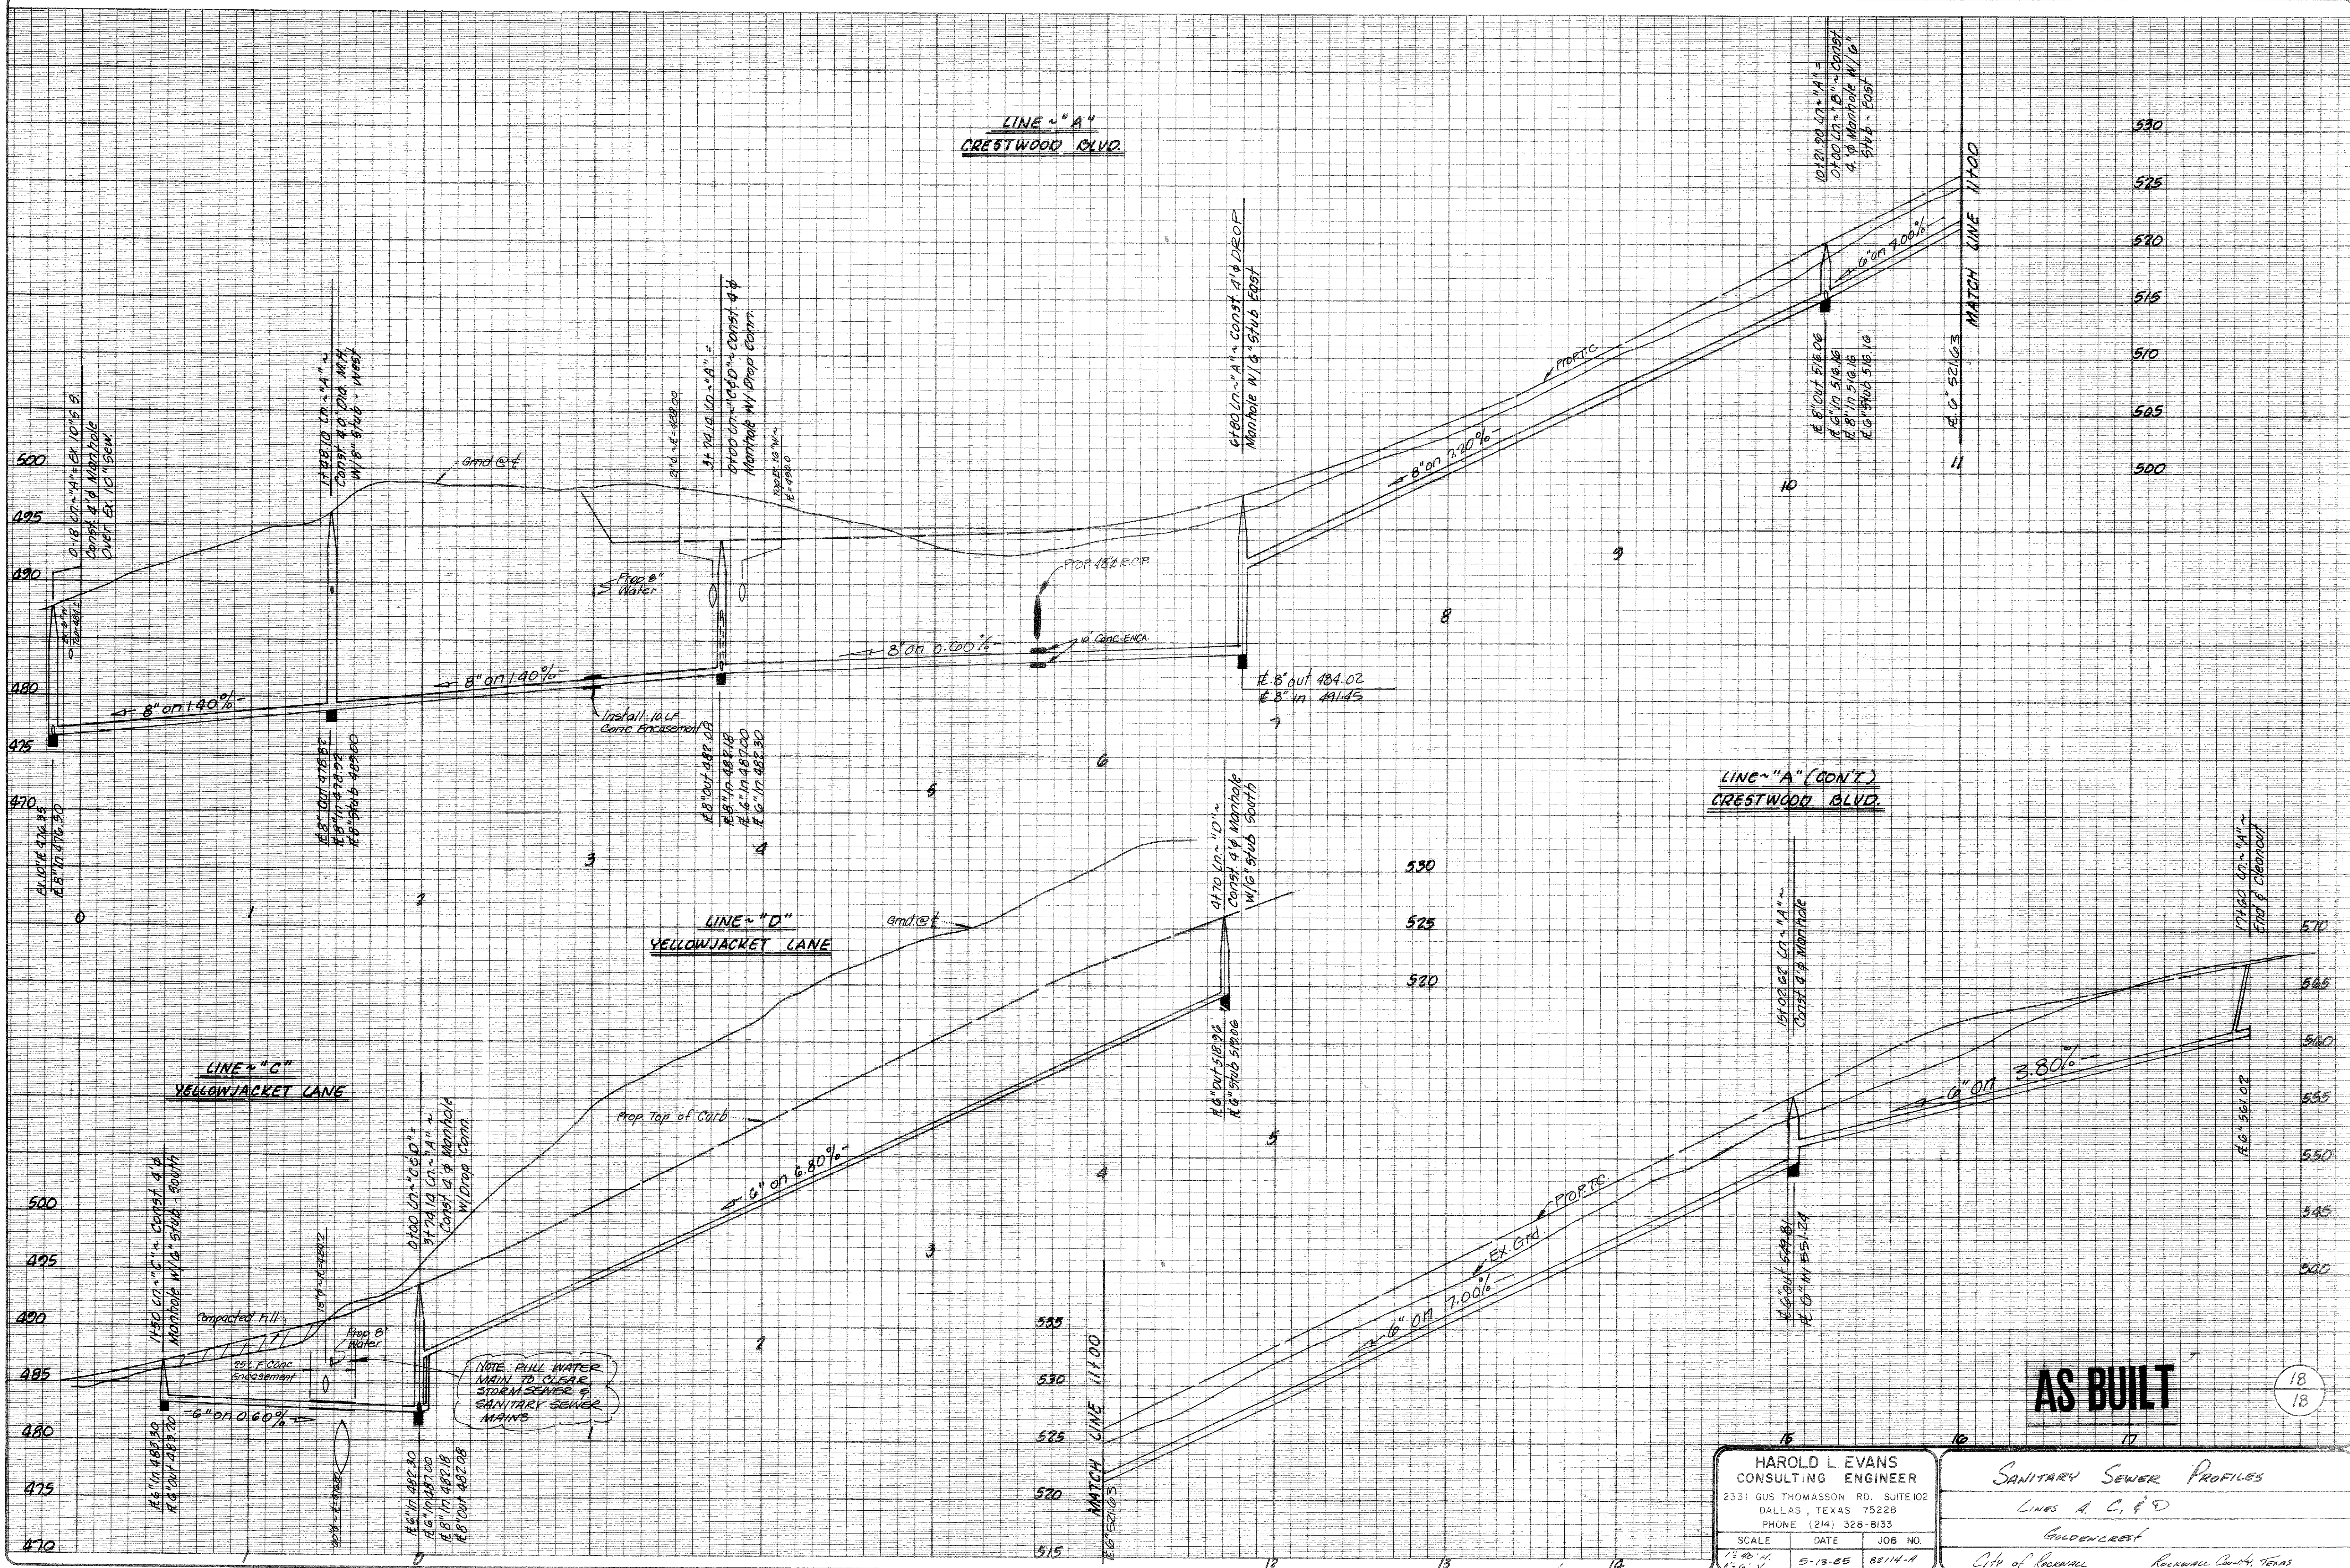

LINE ~ "A" (CONT.)
CRESTWOOD BLVD.

AS BUILT

HAROLD L. EVANS
CONSULTING ENGINEER
2331 GUS THOMASSON RD. SUITE 102
DALLAS, TEXAS 75228
PHONE (214) 328-8133

SANITARY SEWER PROFILES
LINES A, C, & D
GOLDENCREST
City of Rockwall Rockwall County, TEXAS

Revised NOV. 26 1985