

LAKE
RAY
HUBBARD

0400 Lr. "A" Conn. to
Wet Well Prop. With
Northshore Ph. 2-A
A=37'26'00"
R=160.00'
T=60.82'
L=98.00'


3178.00 Lr. "A"
Const. 4.0' Dia. M.H.

6175 Lr. "A"
Ead & C.O.

Install:
2-3" 90° Bends

Install:
1-8" x 6" Tee
1-8" x 6" Red.
1-6" 90° Bend
1-6" Valve
1- Fire Hydr.

Install:
1-6" Plug

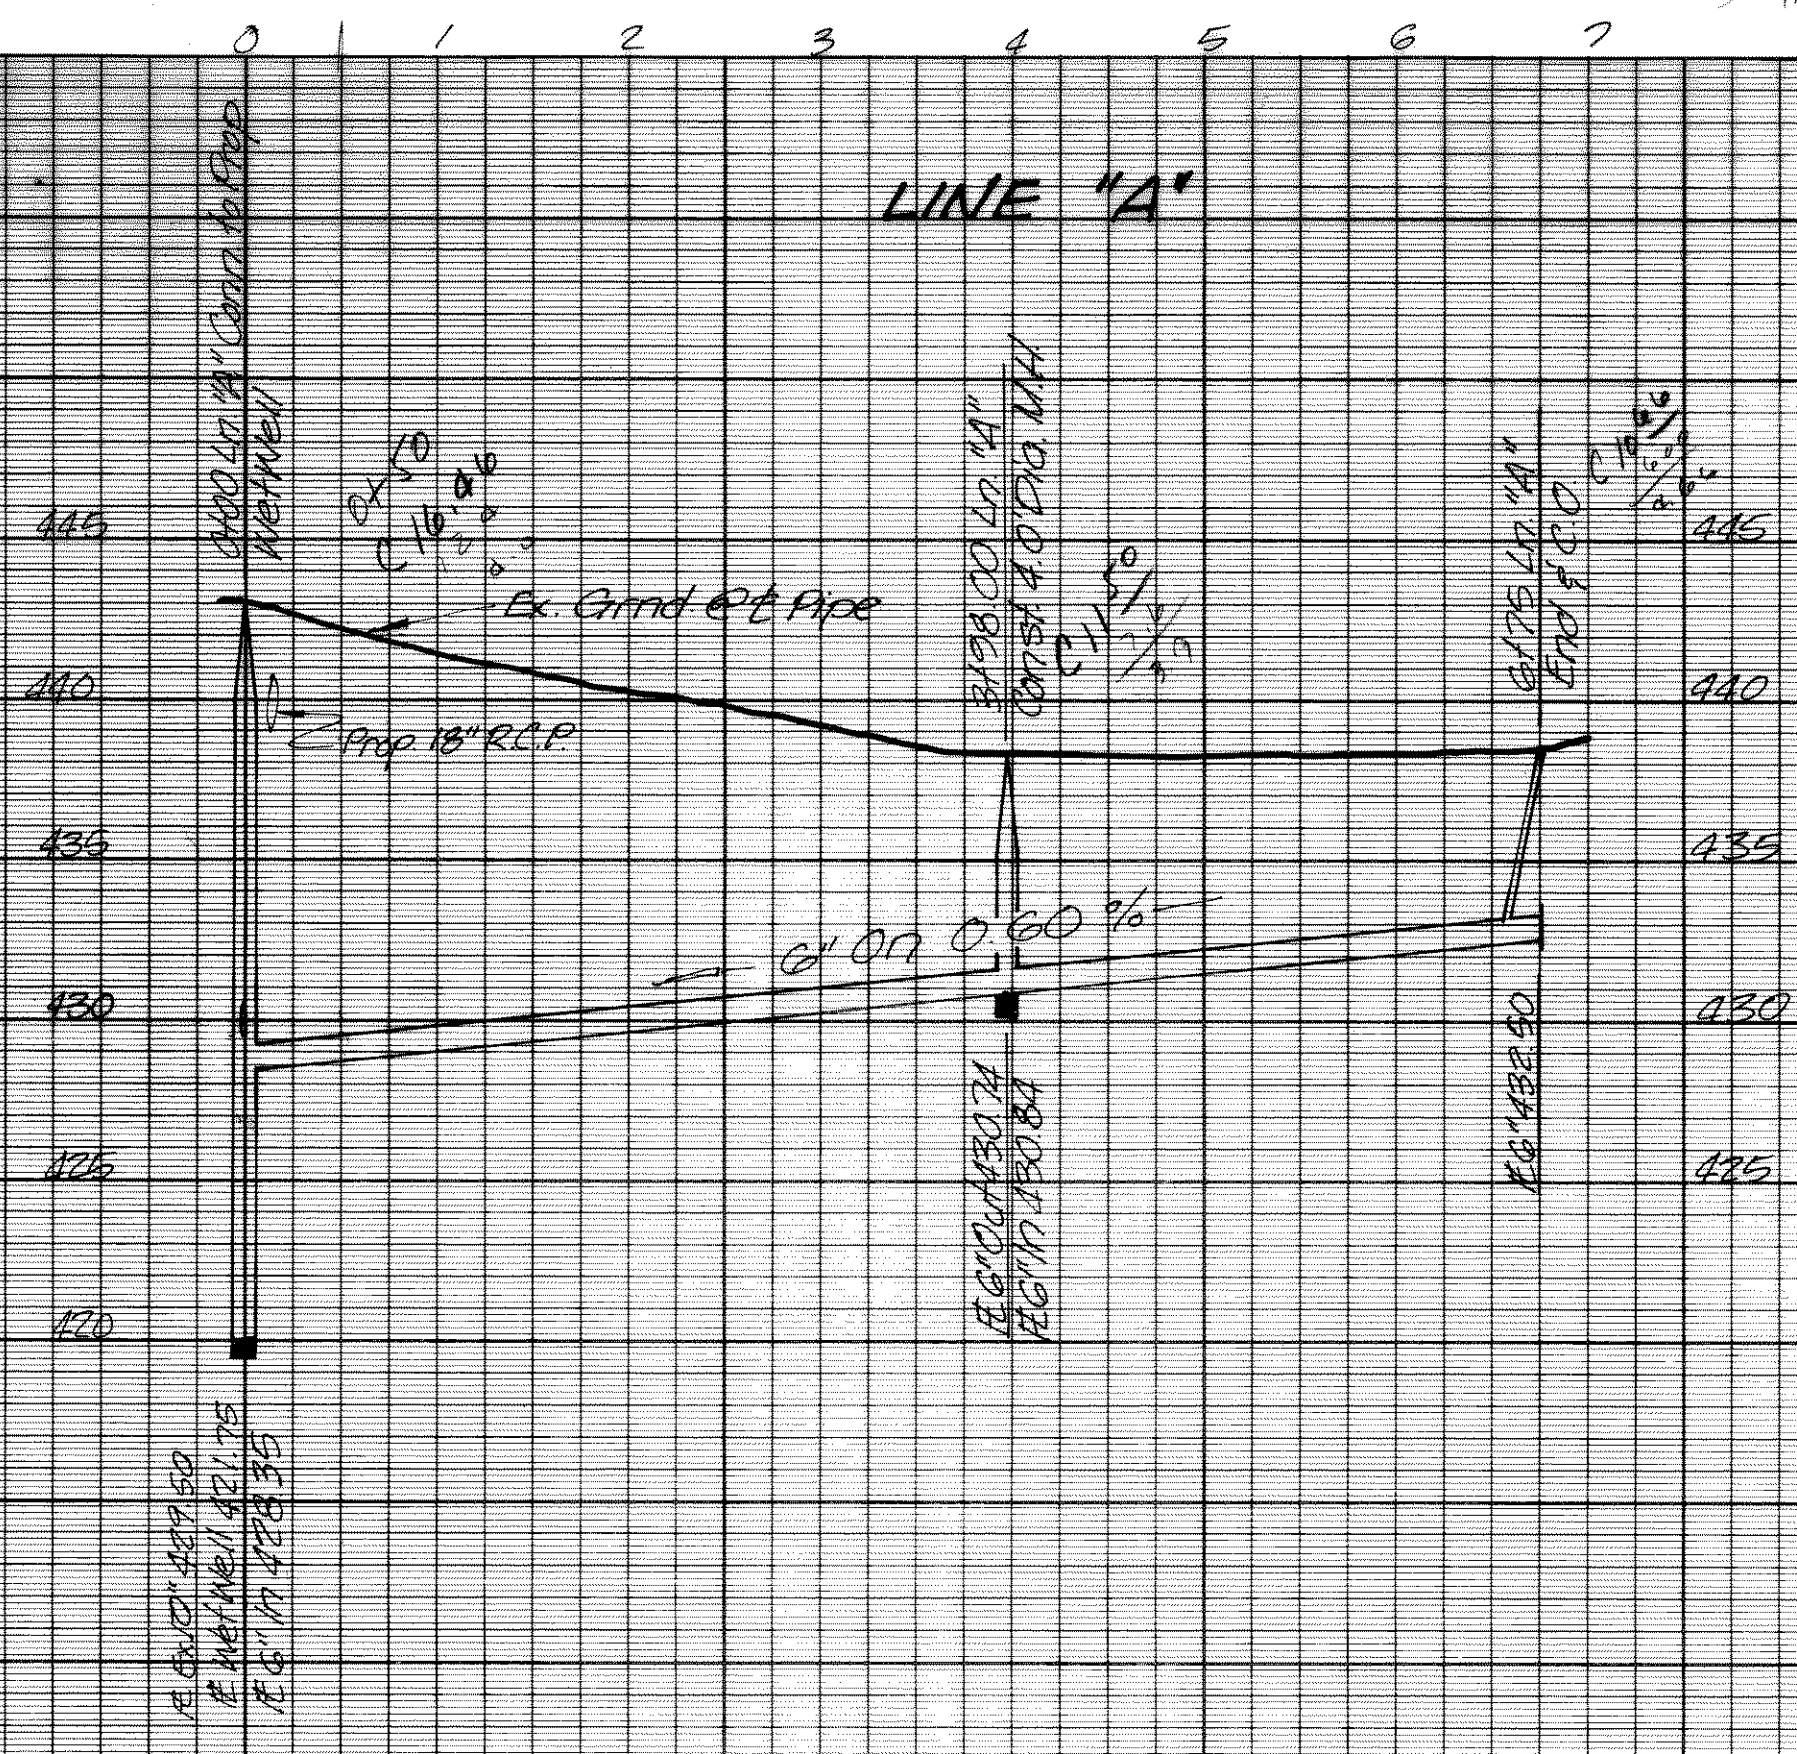

AS BUILT

(1 of 2)

WATER & SANITARY SEWER
GRADY RASH SUBDIVISION
CITY OF ROCKWALL
ROCKWALL COUNTY, TEXAS
HAROLD L. EVANS - CONSULTING ENGINEER

DESIGN	DRAWN	DATE	SCALE	NOTES	FILE	DB NO.
TWA	TWA	1-5-84	1"=100' 1"=6'V.			83265