

CIVIL SITE CONSTRUCTION PLANS

FOR

HAMPTON INN
LOT 7, BLOCK C
LA JOLLA POINTE ADDITION, PHASE 1
ROCKWALL, TEXAS

HAMPTON INN

PROPOSED COMERCIAL DEVELOPMENT
 LA JOLLA POINTE
 ROCKWALL, TEXAS

DEVELOPED BY:

MR. KAVEEN R. PATEL

6005 SILVERLEAF LANE
 GARLAND, TEXAS 75043

ARCHITECTURE BY:

RSS ARCHITECTS, L.L.C.


1304 W. ABRAM, SUITE #250
 ARLINGTON, TEXAS 76013

CIVIL ENGINEERING BY:

NOAKES ENGINEERING CO., INC.

3603-B WEST PIONEER PKWY
 ARLINGTON, TEXAS 76013
 SEP. 2006

Sheet Num.	Description
C1	- Cover Sheet
C2	- Plat Exhibit
C3	- Site Plan / Dimensional Control
C4	- Grading Plan
C5	- Drainage / Storm Sewer Plan
C6	- Utility Plan
C7	- Paving Plan
C8	- Erosion Control Plan
C9	- SWPPP 1
C10	- SWPPP 2
C11	- Landscape Plan

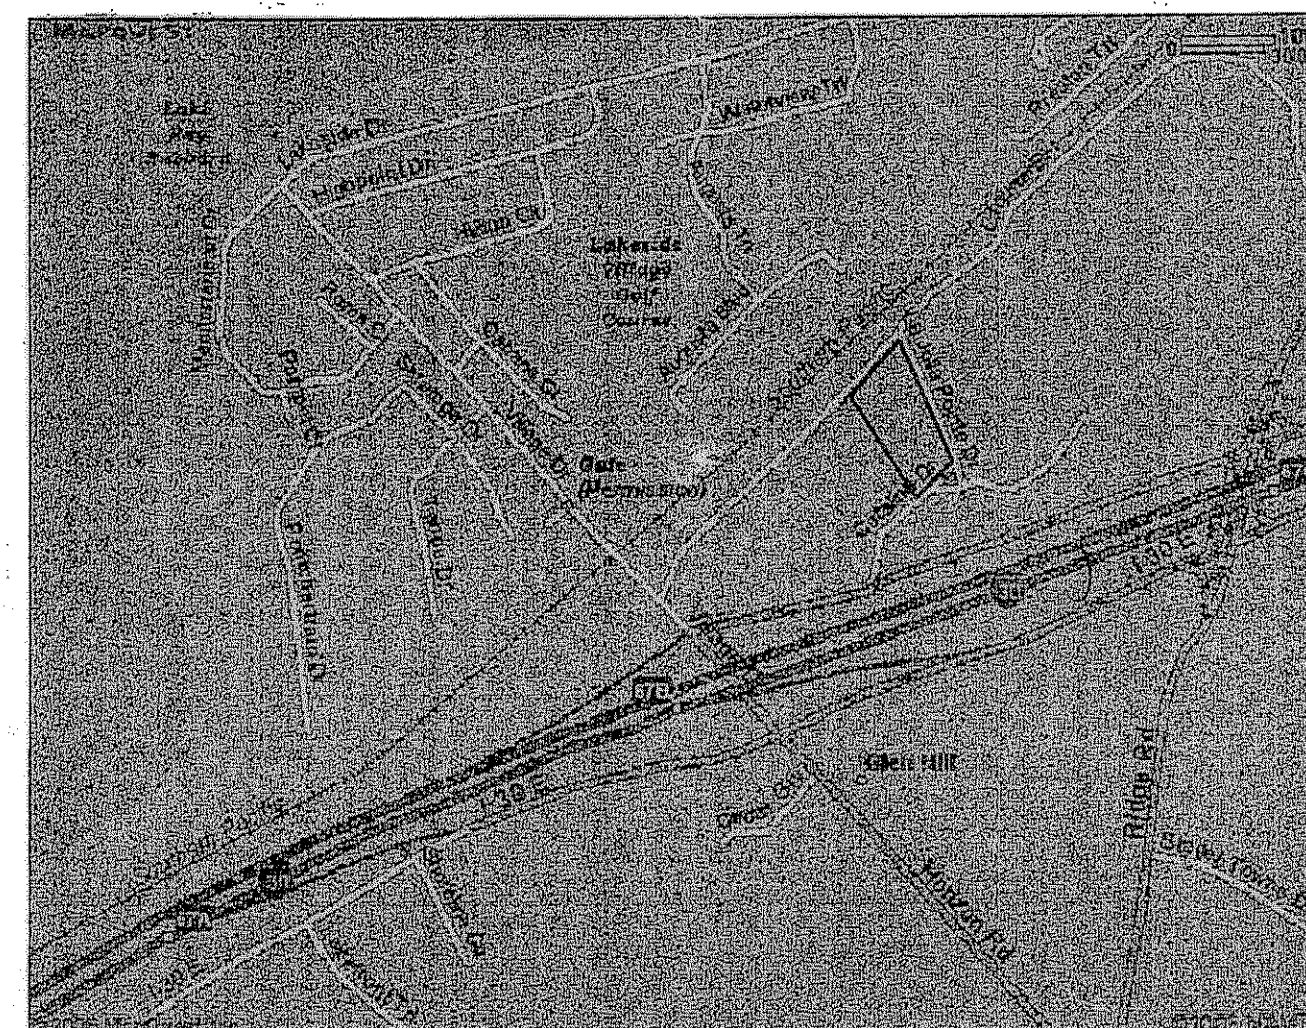

SITE MAP
 SCALE: NONE

EA 5-28-07
 REVISED 12-6-2006
 AND 1-8-2007
 PER CITY COMMENTS

APPROVED FOR CONSTRUCTION
 FEB 4 2007

City of Rockwall Engineering Dept.
 City Engineer

THE SEAL APPEARING ON THIS DOCUMENT WAS AUTHORIZED BY ED D. NOAKES, P.E. 24752 ON 09-30-06