


ENGINEERING PLANS

HARBOR HILL RESIDENCES

City of Rockwall, Texas

Index Of Drawings

| | |
|----------------------|-------------------------|
| | Cover Sheet |
| | Final Plat |
| GN | Rockwall General Notes |
| SP | Site Plan |
| G1.1 | Paving Plan |
| G2.1 | Grading Plan |
| G2.2 | Grading Plan |
| G3.1 | Existing Drainage Area |
| G3.2 | Drainage Area Map |
| G4.1 | Storm Sewer Plan |
| G4.2 | Storm Sewer Profiles |
| G5.1 | Utility Plan |
| G5.2 | Utility Profiles |
| G6.1 | Erosion Control Plan |
| G6.2 | Erosion Control Details |
| G7.1 | Construction Details |
| G7.2 | Construction Details |
| | |
| Landscape | |
| LPO.01 | Landscape Plan |
| TS-1 | Tree Survey/Mitigation |
| | |
| Structural | |
| Retaining Wall Plans | |
| | |
| TxDOT Details | |
| SETP-CD | Safety End Treatment |

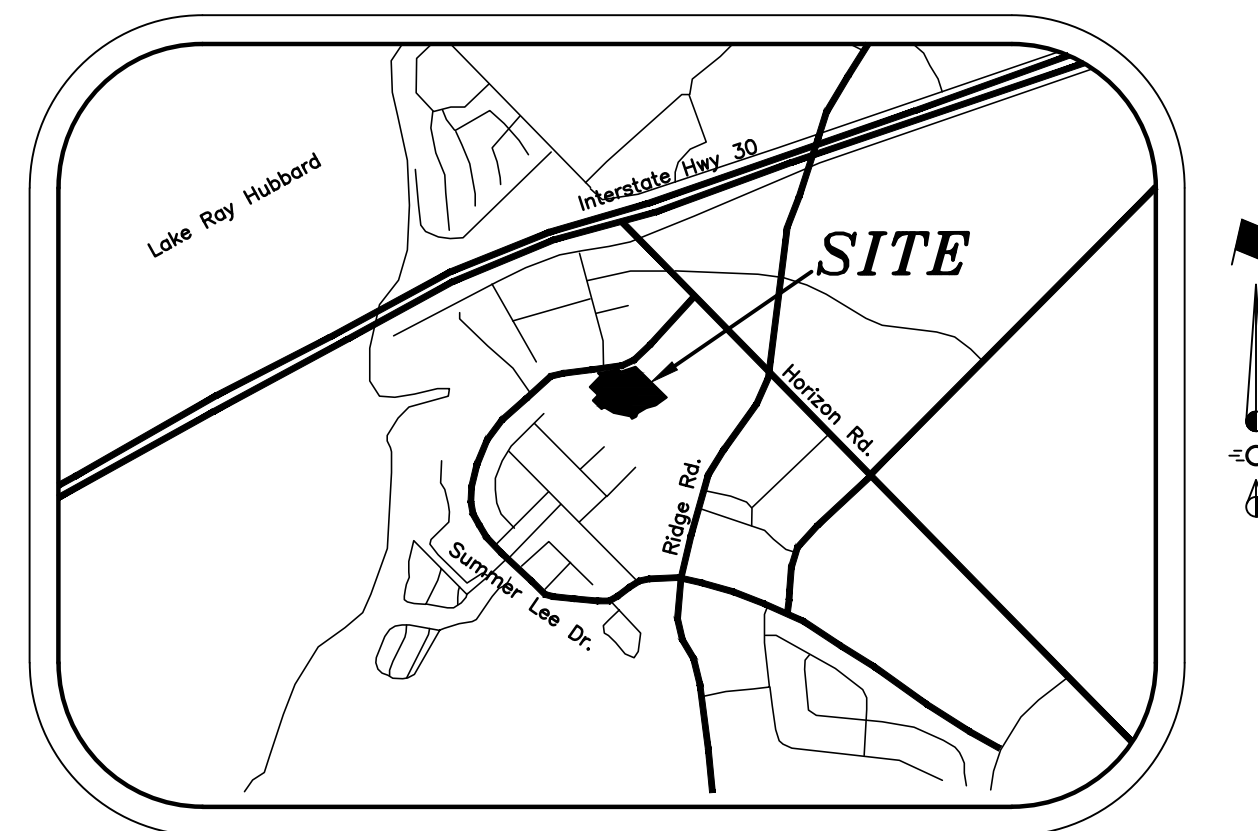

Vicinity Map
NTS

Prepared For
DBA Architects
 111 S. Kentucky Street, Suite 210
 McKinney, Texas 75069

Engineer

CROSS ENGINEERING CONSULTANTS

1720 W. Virginia Street McKinney, Texas 75069
 972.562.4409 Texas P.E. Firm No. F-5935

This Record Drawing is a combination of the sealed engineering contract drawings for this project, modified by revision, change order, field order and information furnished by the contractor. The information shown on the Record Drawings is believed to be accurate based on information furnished by the contractor. The original sealed drawings are on file at the office of:
 Cross Engineering Consultants
 1720 W. Virginia Street
 McKinney, Texas 75069
 (972) 562-4409
 Record Drawings Prepared On:
 12/22/2023

The seal that originally appeared on this document was authorized by T. Zachary Grimes, Texas No. 122013 on 5/17/2021. Alteration of a sealed document without proper notification of the responsible Engineer is an offense under the Texas Engineering Practice Act.

| ISSUE DATES: | REVISIONS: | DATE | BY |
|--------------|------------------------------|------|----|
| 9/17/2020 | Issued for Permit Addendum 2 | | |
| 11/30/2020 | Issued for Permit Addendum 3 | | |
| 12/23/2020 | Issued for Permit Addendum 4 | | |
| 1/22/2021 | Issued for Pricing II | | |
| 1/29/2021 | Issued for Permit Addendum 5 | | |
| 4/19/2021 | Issued for Construction | | |
| 5/17/2021 | Revision 1 | | |
| 12/22/2023 | Record Drawings | | |