

ENGINEERING PLANS

HARBOR HILL RESIDENCES

City of Rockwall, Texas


Index Of Drawings

- Cover Sheet
- Final Plat
- GN Rockwall General Notes
- SP Site Plan
- G1.1 Paving Plan
- G2.1 Grading Plan
- G2.2 Grading Plan
- G3.1 Existing Drainage Area
- G3.2 Drainage Area Map
- G4.1 Storm Sewer Plan
- G4.2 Storm Sewer Profiles
- G5.1 Utility Plan
- G5.2 Utility Profiles
- G6.1 Erosion Control Plan
- G6.2 Erosion Control Details
- G7.1 Construction Details
- G7.2 Construction Details

- Landscape
- LPO.01 Landscape Plan
- TS-1 Tree Survey/Mitigation

- Structural
- Retaining Wall Plans

- TxDOT Details
- SETP-CD Safety End Treatment

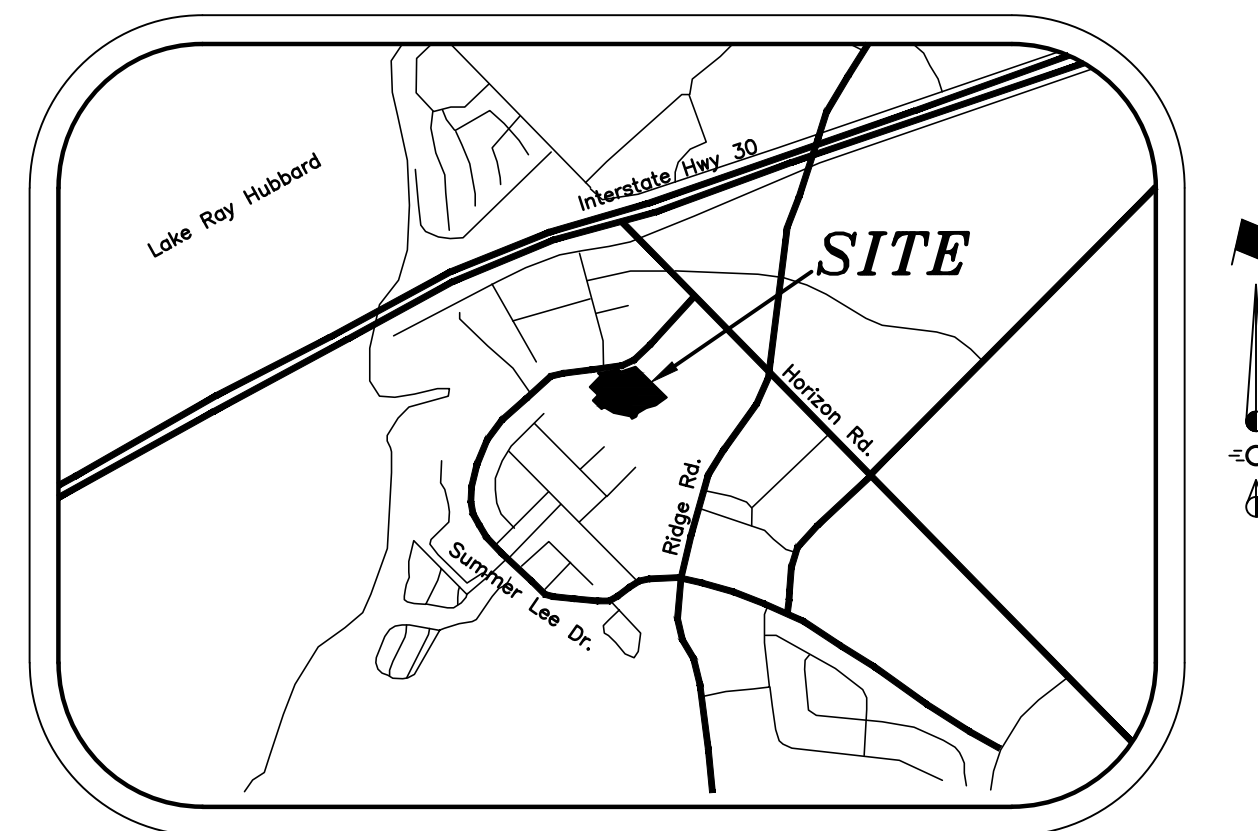

Vicinity Map
NTS

Prepared For
DBA Architects
 111 S. Kentucky Street, Suite 210
 McKinney, Texas 75069

Engineer

CROSS ENGINEERING CONSULTANTS


1720 W. Virginia Street McKinney, Texas 75069
 972.562.4409 Texas P.E. Firm No. F-5935

This Record Drawing is a combination of the sealed engineering contract drawings for this project, modified by revision, change order, field order and information furnished by the contractor. The information shown on the Record Drawings is believed to be accurate based on information furnished by the contractor. The original sealed drawings are on file at the office of:
 Cross Engineering Consultants
 1720 W. Virginia Street
 McKinney, Texas 75069
 (972) 562-4409
 Record Drawings Prepared On:
 12/22/2023

The seal that originally appeared on this document was authorized by T. Zachary Grimes, Texas No. 122013 on 5/17/2021. Alteration of a sealed document without proper notification of the responsible Engineer is an offense under the Texas Engineering Practice Act.

ISSUE DATES:	REVISIONS:	DATE	BY
9/17/2020	Issued for Permit Addendum 2		
11/30/2020	Issued for Permit Addendum 3		
12/23/2020	Issued for Permit Addendum 4		
1/22/2021	Issued for Pricing II		
1/29/2021	Issued for Permit Addendum 5		
4/19/2021	Issued for Construction		
5/17/2021	Revision 1		
12/22/2023	Record Drawings		

Drawing: L:\Projects\H11 18363 Harbor Hill Multi Family\Acad\Deliverables\Final_Plat\2020 10 20 H11 18363 Harbor Hills Final Plat.dwg at Oct 27, 2020 8:30am by jmadcox

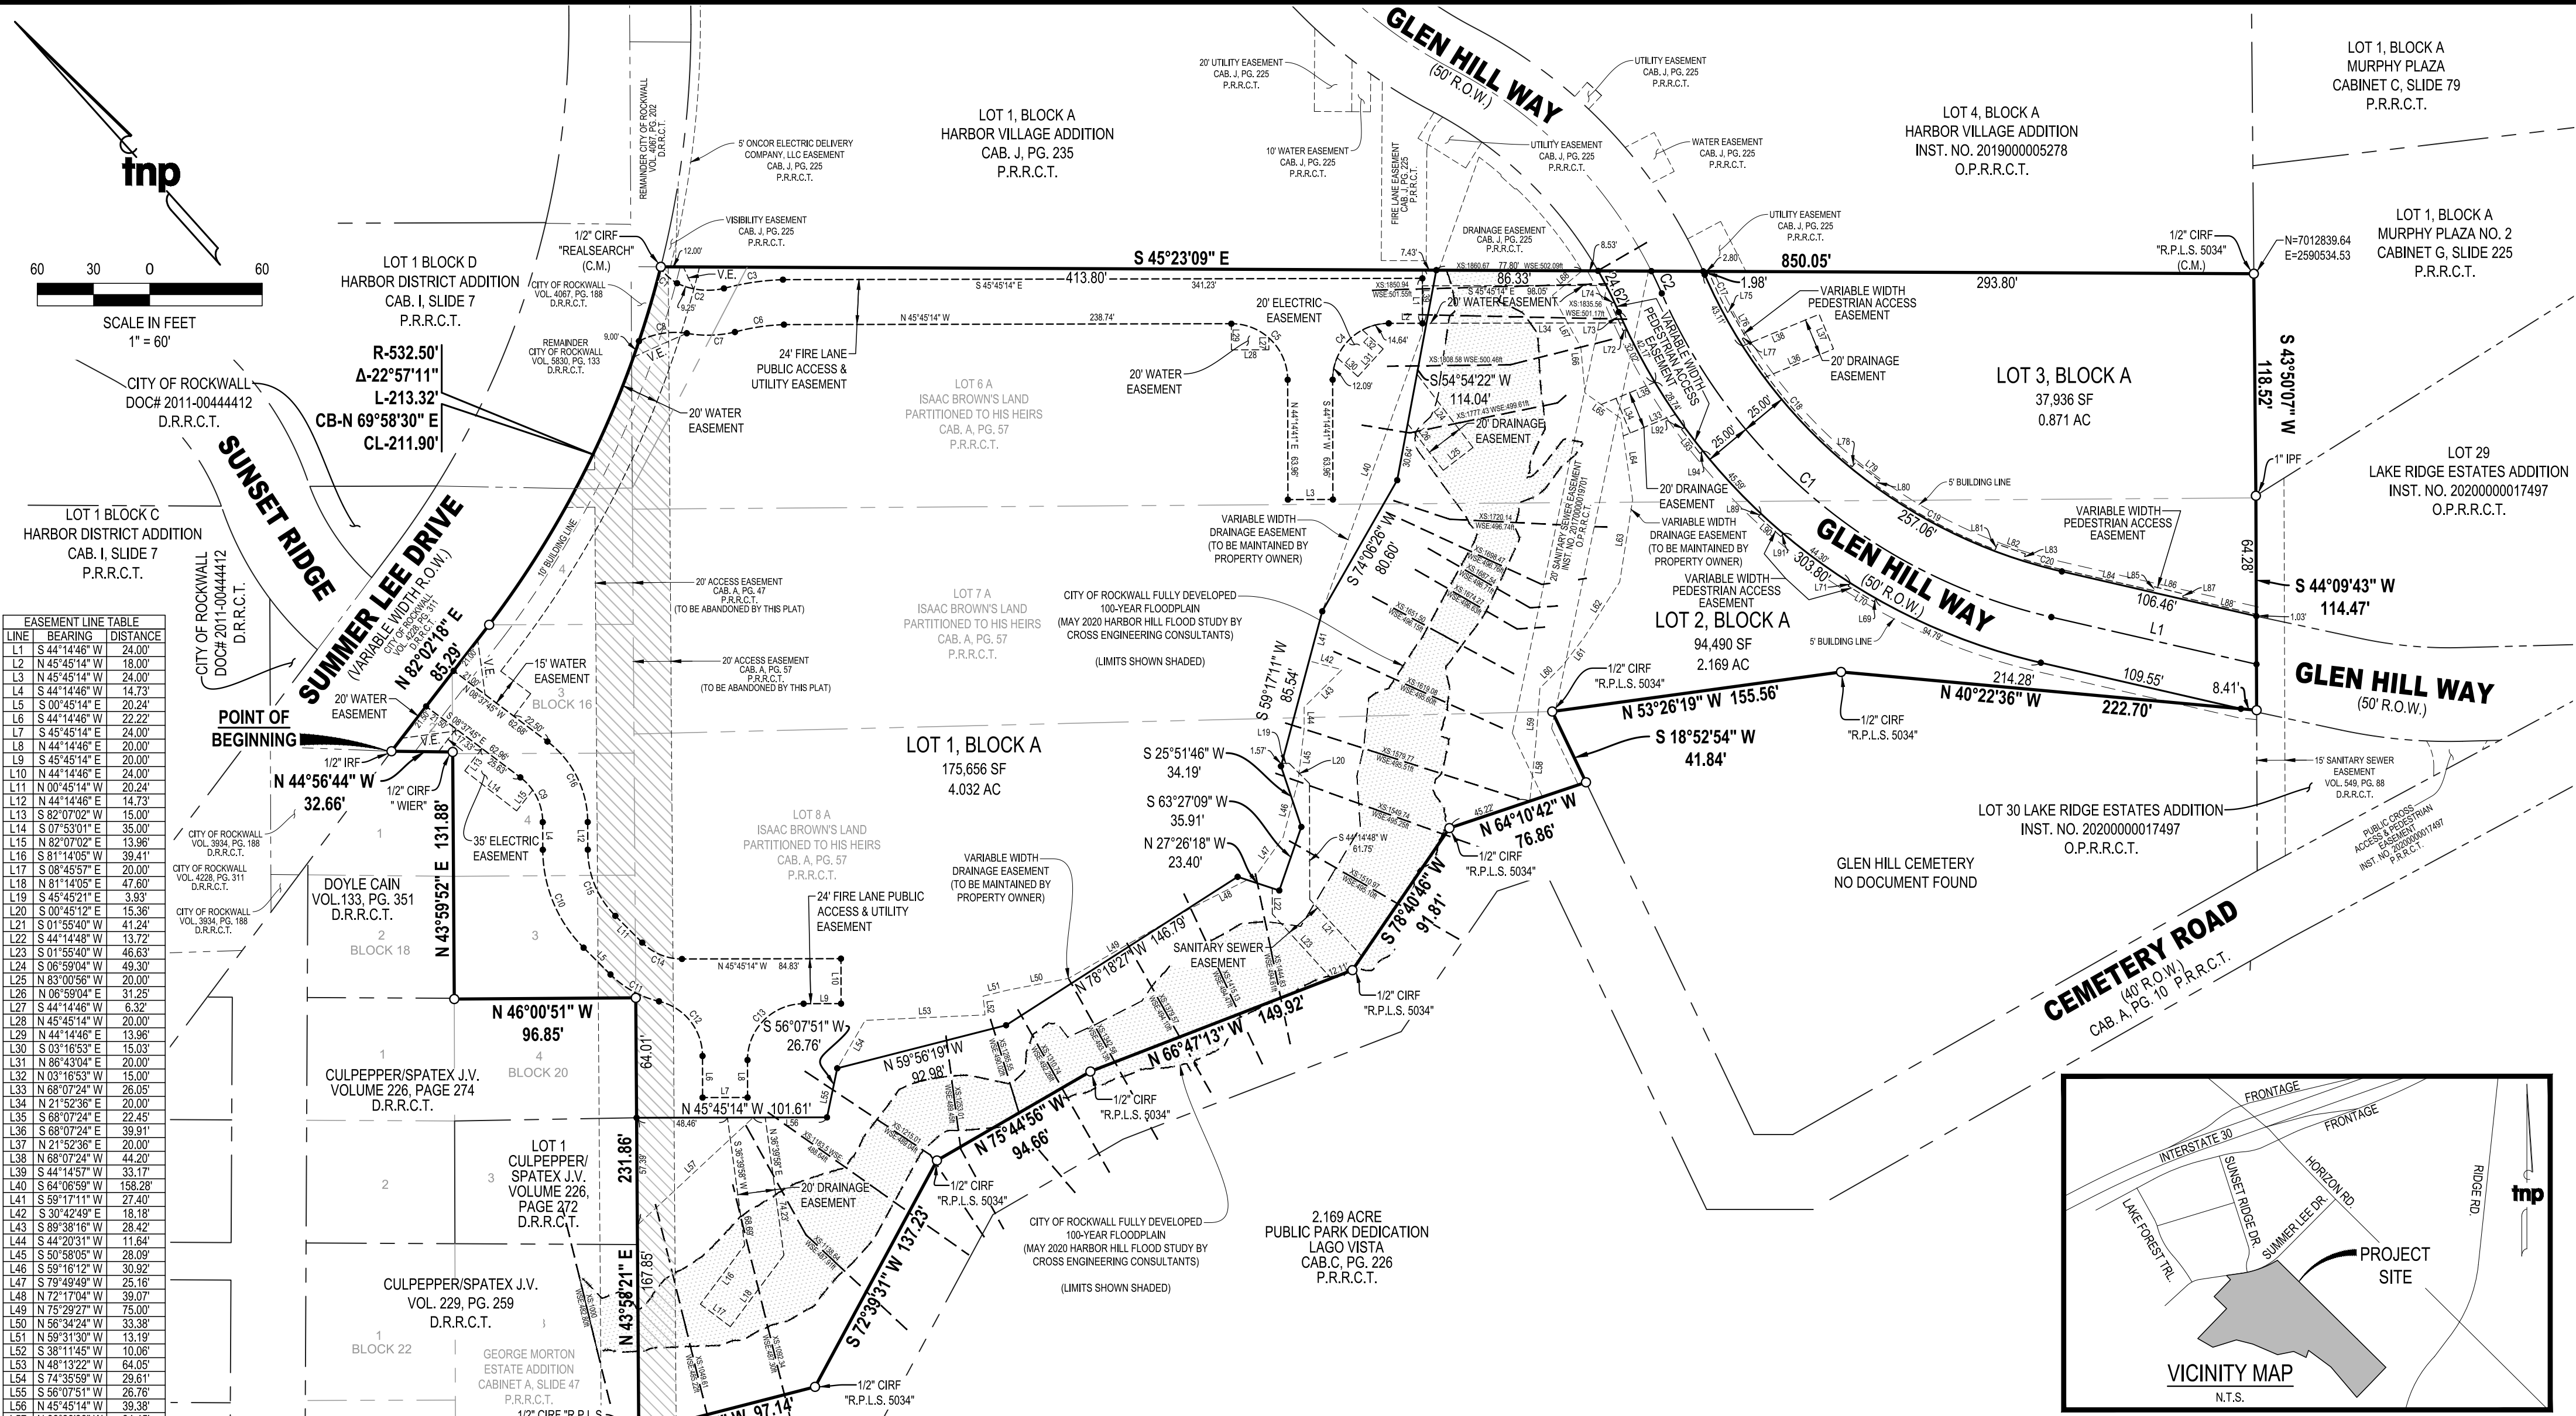

EASEMENT LINE TABLE

LINE	BEARING	DISTANCE
L1	S 44°14'46" W	24.00'
L2	N 45°45'14" W	18.00'
L3	N 44°14'46" W	24.00'
L4	S 00°45'14" E	14.73'
L5	S 00°45'14" E	20.24'
L6	S 44°14'46" W	22.22'
L7	S 45°45'14" W	24.00'
L8	N 44°14'46" E	20.00'
L9	S 45°45'14" E	20.00'
L10	N 44°14'46" E	24.00'
L11	N 44°14'46" W	20.24'
L12	N 44°14'46" E	14.73'
L13	S 82°07'02" W	15.00'
L14	S 07°53'01" E	35.00'
L15	N 82°07'02" E	13.96'
L16	S 81°14'05" W	39.41'
L17	S 08°45'57" E	20.00'
L18	N 81°14'05" E	47.60'
L19	S 45°45'21" E	3.93'
L20	S 00°45'12" E	15.36'
L21	S 01°55'40" W	41.24'
L22	S 44°14'48" W	13.72'
L23	S 01°55'40" W	46.63'
L24	S 06°59'04" W	49.30'
L25	N 83°00'56" W	20.00'
L26	N 06°59'04" E	31.25'
L27	S 44°14'46" W	6.32'
L28	N 45°45'14" W	20.00'
L29	N 44°14'46" E	13.96'
L30	S 03°16'53" E	15.03'
L31	N 86°13'04" E	20.00'
L32	N 03°16'53" W	15.00'
L33	N 68°07'24" W	26.05'
L34	N 21°52'36" E	20.00'
L35	S 68°07'24" E	22.45'
L36	S 68°07'24" W	39.91'
L37	N 21°52'36" E	20.00'
L38	N 68°07'24" W	44.20'
L39	S 44°14'57" W	33.17'
L40	S 64°06'59" W	158.28'
L41	S 59°17'11" W	27.40'
L42	S 50°42'49" E	18.18'
L43	S 89°38'16" W	28.42'
L44	S 44°20'31" W	11.64'
L45	S 50°58'05" W	28.09'
L46	S 59°16'12" W	30.92'
L47	S 79°49'49" W	25.16'
L48	N 72°17'04" W	39.07'
L49	N 75°29'27" W	75.00'
L50	N 56°34'24" W	33.38'
L51	N 59°31'30" W	13.19'
L52	S 38°11'45" W	10.06'
L53	N 48°13'22" W	64.03'
L54	S 74°33'59" W	23.61'
L55	S 58°07'51" W	26.76'
L56	N 45°45'14" W	39.38'
L57	N 88°33'39" W	84.45'
L58	N 50°18'42" E	31.14'
L59	N 48°41'38" W	29.47'
L60	N 89°34'41" E	16.93'
L61	N 81°48'25" E	18.83'
L62	N 77°01'04" E	35.40'
L63	N 53°18'41" E	44.30'
L64	N 35°58'45" E	44.01'
L65	N 10°09'27" W	23.35'
L66	N 39°06'27" E	24.60'
L67	N 15°43'15" E	31.48'
L68	S 85°16'07" E	20.51'
L69	S 74°06'59" W	2.01'
L70	N 14°33'19" W	16.16'
L71	N 76°46'24" E	2.01'
L72	N 70°49'38" W	2.01'
L73	N 20°04'44" E	16.00'
L74	S 70°30'57" E	1.99'
L75	S 14°09'59" E	1.83'
L76	S 74°16'58" W	15.97'
L77	N 77°18'02" W	2.07'
L78	N 83°32'54" E	3.00'
L79	S 08°02'04" E	15.97'
L80	S 80°22'57" W	3.08'
L81	N 65°01'07" E	3.15'
L82	S 26°32'49" E	15.81'
L83	S 61°53'15" W	3.10'
L84	S 32°40'47" E	49.94'
L85	N 58°19'15" E	2.13'
L86	S 31°40'45" E	16.00'
L87	S 58°19'15" W	1.85'
L88	S 32°40'47" E	40.29'
L89	S 87°45'58" W	2.01'
L90	S 03°54'44" E	16.16'
L91	N 84°45'33" E	2.01'
L92	N 81°42'51" W	2.01'
L93	S 06°57'27" W	16.16'
L94	S 84°22'16" E	2.01'

STREET CL LINE TABLE

LINE	BEARING	DISTANCE
L1	N 32°40'47" W	112.31'

STREET CL CURVE TABLE

CURVE	RADIUS	DELTA ANGLE	ARC LENGTH	CHORD BEARING	CHORD LENGTH
C1	300.00'	53°33'28"	280.43'	N 05°54'15" W	270.33'
C2	240.00'	3°04'15"	13.13'	N 19°20'22" E	13.13'

EASEMENT CURVE TABLE

CURVE	RADIUS	DELTA ANGLE	ARC LENGTH	CHORD BEARING	CHORD LENGTH
C1	30.14'	22°47'08"	11.99'	S 03°33'19" E	11.91'
C2	38.04'	38°39'09"	25.66'	S 39°18'07" E	25.18'
C3	137.59'	13°16'58"	31.90'	S 54°04'39" E	31.83'
C4	30.00'	90°00'05"	47.12'	S 89°14'43" W	42.43'
C5	30.00'	89°59'55"	47.12'	N 00°45'17" W	42.43'
C6	113.11'	13°25'08"	26.49'	N 54°12'46" W	26.43'
C7	62.04'	23°55'33"	25.91'	N 47°08'16" W	25.72'
C8	41.84'	35°58'27"	26.27'	N 54°59'31" W	25.84'
C9	30.00'	52°52'31"	27.69'	S 17°48'30" W	26.71'
C10	74.00'	45°00'00"	58.12'	S 21°44'46" W	56.64'
C11	54.00'	31°48'25"	29.98'	S 16°39'27" E	29.59'
C12	30.00'	78°48'25"	40.22'	S 05°50'33" W	37.23'
C13	30.00'	90°00'00"	47.12'	N 89°14'48" E	42.43'
C14	30.00'	45°00'00"	23.56'	N 23°15'14" W	22.96'
C15	50.00'	45°00'00"	39.27'	N 21°44'46" E	38.27'
C16	54.00'	52°52'31"	49.83'	N 17°48'30" E	48.08'
C17	266.98'	5°11'30"	24.19'	S 19°27'38" W	24.18'
C18	266.98'	19°24'46"	90.46'	S 03°42'23" W	90.03'
C19	266.98'	15°33'47"	72.52'	S 17°14'45" E	72.30'
C20	266.98'	4°33'02"	21.36'	S 30°44'57" E	21.35'

LEGEND

(C.M.) - CONTROLLING MONUMENT
 IRF - IRON ROD FOUND
 CIRF - CAPPED IRON ROD FOUND
 NTS - NOT TO SCALE
 R.O.W. - RIGHT OF WAY
 INST. - INSTRUMENT
 CAB. - CABINET
 VOL. - VOLUME
 NO. - NUMBER
 PG. - PAGE
 SF - SQUARE FEET
 AC - ACRES
 XS - CROSS SECTION
 WSE - WATER SURFACE ELEVATION
 V.E. - VISIBILITY EASEMENT
 D.R.R.C.T. - DEED RECORDS ROCKWALL COUNTY, TEXAS
 P.R.R.C.T. - PLAT RECORDS ROCKWALL COUNTY TEXAS
 O.P.R.R.C.T. - OFFICIAL PUBLIC RECORDS ROCKWALL COUNTY TEXAS

EASEMENT TO BE ABANDONED BY THIS PLAT


NOTES:

- BEARINGS ARE REFERENCED TO GRID NORTH OF THE TEXAS COORDINATE SYSTEM OF 1983 (NORTH CENTRAL ZONE 4202;NAD83(2011)EPOCH 2010) AND TIED TO THE CITY OF ROCKWALL GPS MONUMENT NETWORK
- UNLESS OTHERWISE NOTED ALL CORNERS ARE A 5/8 INCH IRON ROD SET WITH CAP STAMPED "tnp"
- BY GRAPHIC SCALE ONLY THE SUBJECT PROPERTY APPEARS TO LIE WITHIN ZONE X (AREAS DETERMINED TO BE OUTSIDE THE 0.2% ANNUAL CHANCE FLOODPLAIN, ACCORDING TO THE FLOOD INSURANCE RATE MAP (FIRM) NO. 48397C0040 DATED SEPTEMBER 26, 2008 OF THE NATIONAL INSURANCE RATE MAP PREPARED BY THE FEDERAL EMERGENCY MANAGEMENT AGENCY. THIS STATEMENT SHALL NOT CREATE LIABILITY ON THE PART OF THE SURVEYOR.
- THE SURVEYOR, AS REQUIRED BY STATE LAW, IS RESPONSIBLE FOR SURVEYING INFORMATION ONLY AND BEARS NO RESPONSIBILITY FOR THE ACCURACY OF THE ENGINEERING DATA ON THIS PLAT.
- IT SHALL BE THE POLICY OF THE CITY OF ROCKWALL TO WITHHOLD ISSUING BUILDING PERMITS UNTIL ALL STREETS, WATER, SEWER AND STORM DRAINAGE SYSTEMS HAVE BEEN ACCEPTED BY THE CITY. THE APPROVAL OF A PLAT BY THE CITY DOES NOT CONSTITUTE ANY REPRESENTATION, ASSURANCE OR GUARANTEE THAT ANY BUILDING WITHIN SUCH PLAT SHALL BE APPROVED, AUTHORIZED OR PERMIT THEREFORE ISSUED, NOR SHALL SUCH APPROVAL CONSTITUTE ANY REPRESENTATION, ASSURANCE OR GUARANTEE BY THE CITY OF THE ADEQUACY AND AVAILABILITY FOR WATER FOR PERSONAL USE AND FIRE PROTECTION WITHIN SUCH PLAT, AS REQUIRED UNDER ORDINANCE 83-54.
- MINIMUM FINISH FLOOR ELEVATION OF LIVABLE FLOORS SHALL BE TWO (2) FEET ABOVE THE HIGHEST ADJACENT FLOODPLAIN ELEVATION FOR THE LOT.
- ALL RETAINING WALLS FOR THE SIDEWALK ALONG GLEN HILL WAY SHALL BE REPAIRED, REPLACED AND MAINTAINED BY THE PROPERTY OWNER, WHERE THE WALL IS IN THE RIGHT OF WAY, THE ADJACENT PROPERTY OWNER SHALL MAINTAIN THE WALL.

OWNER
 CITY OF ROCKWALL
 385 S. Goliad Street
 Rockwall, TX 75087

OWNER
 HARBOR LAKE POINT INVESTORS, LLC.
 2701 Sunset Ridge Drive Suite 607
 Rockwall, TX 75032

CASE NO. P2020-036

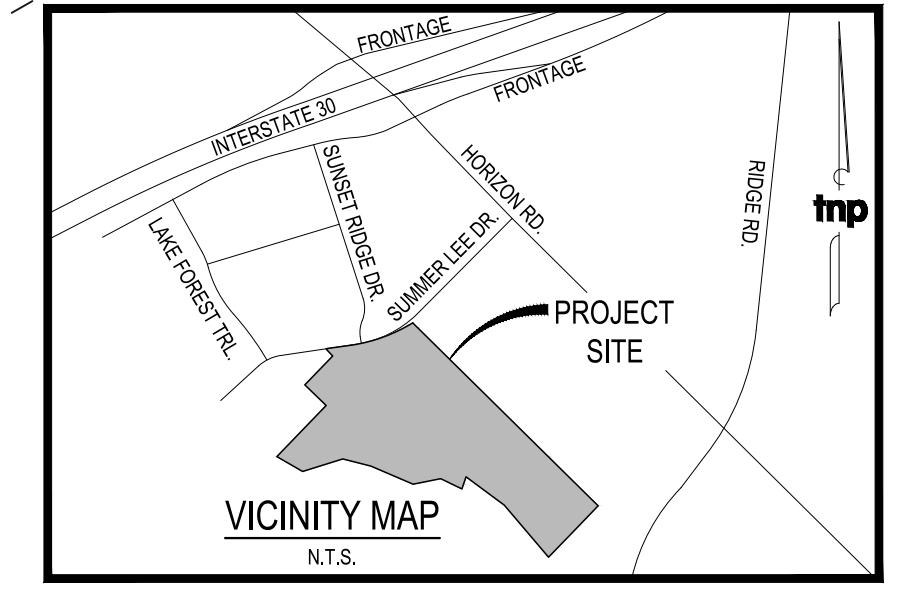

**FINAL PLAT OF
 LOTS 1, 2 & 3 BLOCK A,
 HARBOR HILLS ADDITION**

328,373 SQUARE FEET OR 7.538 ACRES

SITUATED IN THE EDWARD TEAL SURVEY, ABSTRACT 207
 IN THE CITY OF ROCKWALL, ROCKWALL COUNTY, TEXAS

BEING ALL OF A THREE TRACTS OF LAND DESCRIBED BY DEED TO HARBOR LAKE POINTE INVESTORS, LLC. AS RECORDED IN INSTRUMENT NUMBER 2017000002427, INSTRUMENT NUMBER 2017000003548, AND INSTRUMENT NUMBER 2015000011879 OF THE OFFICIAL PUBLIC RECORDS OF ROCKWALL COUNTY, TEXAS AND A PORTION OF TWO TRACTS OF LAND TO THE CITY OF ROCKWALL AS RECORDED IN VOLUME 4067, PAGE 188 AND VOLUME 5830, PAGE 133 OF THE DEED RECORDS OF ROCKWALL COUNTY, TEXAS

PROJECT INFORMATION
 Project No.: HHI 18363
 Date: October 20, 2020
 Drawn By: JM
 Scale: 1"=60'

SURVEYOR
 TEAGUE NALL AND PERKINS, INC.
 825 Watters Creek Boulevard, Suite M300
 Allen, Texas 75013
 214.461.9867 ph 214.461.9864 fx
 T.B.P.L.S. Registration No. 10194381
 www.tnpsc.com



OWNERS CERTIFICATION

STATE OF TEXAS}
COUNTY OF ROCKWALL}

WHEREAS Harbor Lake Pointe Investors, LLC., and the City of Rockwall are the owners a tract of land situated in the Edward Teal Survey, Abstract 207 and being all of three tracts of land described by deed to Harbor Lake Pointe Investors, LLC. as recorded in Instrument Number 20170000002427, Instrument Number 20170000003548 and Instrument Number 20150000011879 of the Official Public Records of Rockwall County, Texas, and a portion of two tracts of land to the City of Rockwall as recorded in Volume 4067, Page 188 and Volume 5830, Page 133 of the Deed Records of Rockwall County, Texas, also being all of Lot 3 and 4, Block 18 and a portion of Lot 2 and 4 and all of Lot 3, Block 16 of George Morton Estate as recorded in Cabinet A, slide 47 of the Plat Records of Rockwall County, Texas, also being a portion of Lot 6A, Lot 7A and Lot 8A of Isaac Brown's Land Partitioned to his Heirs as recorded in Cabinet A, Page 57 of the Plat Records of Rockwall County, Texas, and being more particularly described as follows:

BEGINNING at a 1/2 inch iron rod found the northwest corner of said Harbor Heights tract recorded in Instrument Number 20170000002427 also lying on the southerly line of Summer Lee Drive, a variable width right-of-way;

THENCE North 82 degrees 02 minutes 18 seconds East, along the southerly line of said Summer Lee Drive, a distance of 85.29 feet to a 5/8 inch iron rod with cap stamped "TNP" set for the beginning of a curve to the left;

THENCE along the southerly line of said Summer Lee Drive with said curve to the left having a radius of 532.50 feet, a central angle of 22 degrees 57 minutes 11 seconds, an arc length of 213.32 feet, a chord bearing of North 69 degrees 58 minutes 30 seconds East, a distance of 211.90 feet to a 5/8 inch iron rod with cap stamped "RESEARCH" found for the west corner of Lot 1, Block A, Harbor Village Addition, an addition to the City of Rockwall as recorded in Cabinet J, Page 225 of the Plat Records of Rockwall County, Texas;

THENCE South 45 degrees 23 minutes 09 seconds East, along the southwest line of said Lot 1, Block A, a distance of 850.05 feet to a 1/2 inch iron rod with cap stamped "R.P.L.S. 5034" found for the south corner of Lot 29, Lake Ridge Estates, an addition to the City of Rockwall as recorded in Instrument Number 20200000017497 of the Official Public Records of Rockwall County, Texas;

THENCE South 43 degrees 50 minutes 07 seconds West, along the northwest line of said Murphy Plaza, a distance of 118.52 feet to a 1 inch iron pipe found for the west corner of same, also for the north corner of Lot 29, Lake Ridge Estates, an addition to the City of Rockwall as recorded in Instrument Number 20200000017497 of the Official Public Records of Rockwall County, Texas;

THENCE South 44 degrees 09 minutes 43 seconds West, along the northwest line of said Lake Ridge Estates, a distance of 114.47 feet to a 5/8 inch iron rod with cap stamped "TNP" set for the southeast corner of the aforementioned Harbor Lake Pointe Investors, LLC. tract as recorded in Instrument Number 20150000011879;

THENCE along the southerly line of said Harbor Lake Point Investors tract recorded in Instrument Number 20150000011879 the following courses and distances:

North 40 degrees 22 minutes 36 seconds West, a distance of 222.70 feet to a 1/2 inch iron rod with cap stamped "R.P.L.S. 5034 found for corner;

North 53 degrees 26 minutes 19 seconds West, a distance of 155.56 feet to a 1/2 inch iron rod with cap stamped "R.P.L.S. 5034 found for corner;

South 18 degrees 52 minutes 54 seconds West, a distance of 41.84 feet to a 5/8 inch iron rod with cap stamped "TNP" set for corner;

North 64 degrees 10 minutes 42 seconds West, a distance of 76.86 feet to a 1/2 inch iron rod with cap stamped "R.P.L.S. 5034 found for corner;

South 78 degrees 40 minutes 46 seconds West, a distance of 91.81 feet to a 1/2 inch iron rod with cap stamped "R.P.L.S. 5034 found for corner;

North 66 degrees 47 minutes 13 seconds West, a distance of 149.92 feet to a 5/8 inch iron rod with cap stamped "TNP" set for corner;

North 75 degrees 44 minutes 56 seconds West, a distance of 94.66 feet to a 1/2 inch iron rod with cap stamped "R.P.L.S. 5034 found for corner;

South 72 degrees 39 minutes 31 seconds West, a distance of 137.23 feet to a 1/2 inch iron rod with cap stamped "R.P.L.S. 5034 found for corner;

North 60 degrees 03 minutes 55 seconds West, a distance of 97.14 feet to a 1/2 inch iron rod with cap stamped "R.P.L.S. 5034 found for corner lying on the southeast line of the aforementioned George Morton Estate;

THENCE North 43 degrees 58 minutes 21 seconds East along the southeast line of said George Morton Estate, a distance of 231.86 feet to 5/8 inch iron rod with cap stamped "TNP" set for corner for the south corner of the aforementioned Harbor Lake Point Investors tract recorded in Instrument Number 20170000003548;

THENCE North 46 degrees 00 minutes 51 seconds West, along the southwest line of last mentioned Harbor Lake Point Investors tract, a distance of 96.85 feet to 5/8 inch iron rod with cap stamped "TNP" set for corner at the west corner of same;

THENCE North 43 degrees 59 minutes 52 seconds East, a distance of 131.88 feet to a 1/2 inch iron rod with cap stamped "WIER" found for ell corner of the aforementioned Harbor Lake Point Investors tract recorded in Instrument Number 20170000002427;

THENCE North 44 degrees 56 minutes 44 seconds West, along a southwest line of last mentioned Harbor Lake Point Investors tract, a distance of 32.66 feet to the POINT OF BEGINNING containing 328,373 square feet, or 7.538 acres of land.

NOW, THEREFORE, KNOW ALL MEN BY THESE PRESENTS:

STATE OF TEXAS}
COUNTY OF ROCKWALL}

We the undersigned owner's of the land shown on this plat, and designated herein as HARBOR HILLS ADDITION subdivision to the City of Rockwall, Texas, and whose name is subscribed hereto, hereby dedicate to the use of the public forever all streets, alleys, parks, water courses, drains, easements and public places thereon shown on the purpose and consideration therein expressed. We further certify that all other parties who have a mortgage or lien interest in the [HARBOR HILLS ADDITION subdivision have been notified and signed this plat. We understand and do hereby reserve the easement strips shown on this plat for the purposes stated and for the mutual use and accommodation of all utilities desiring to use or using same. I also understand the following;

- 1. No buildings shall be constructed or placed upon, over, or across the utility easements as described herein.
2. Any public utility shall have the right to remove and keep removed all or part of any buildings, fences, trees, shrubs, or other growths or improvements which in any way endanger or interfere with construction, maintenance or efficiency of their respective system on any of these easement strips; and any public utility shall at all times have the right of ingress or egress to, from and upon the said easement strips for purpose of construction, reconstruction, inspecting, patrolling, maintaining, and either adding to or removing all or part of their respective system without the necessity of, at any time, procuring the permission of anyone.
3. The City of Rockwall will not be responsible for any claims of any nature resulting from or occasioned by the establishment of grade of streets in the subdivision.
4. The developer and subdivision engineer shall bear total responsibility for storm drain improvements.
5. The developer shall be responsible for the necessary facilities to provide drainage patterns and drainage controls such that properties within the drainage area are not adversely affected by storm drainage from the development.
6. No house dwelling unit, or other structure shall be constructed on any lot in this addition by the owner or any other person until the developer and/or owner has complied with all requirements of the Subdivision Regulations of the City of Rockwall regarding improvements with respect to the entire block on the street or streets on which property abuts, including the actual installation of streets with the required base and paving, curb and gutter, water and sewer, drainage structures, storm structures, storm sewers, and alleys, all according to the specifications of the City of Rockwall; or
7. Property owner shall be responsible for maintaining, repairing, and replacing all systems within the drainage and detention easements.

Until an escrow deposit, sufficient to pay for the cost of such improvements, as determined by the city's engineer and/or city administrator, computed on a private commercial rate basis, has been made with the city secretary, accompanied by an agreement signed by the developer and/or owner, authorizing the city to make such improvements at prevailing private commercial rates, or have the same made by a contractor and pay for the same out of the escrow deposit, should the developer and/or owner fail or refuse to install the required improvements within the time stated in such written agreement, but in no case shall the City be obligated to make such improvements itself. Such deposit may be used by the owner and/or developer as progress payments as the work progresses in making such improvements by making certified requisitions to the city secretary, supported by evidence of work done; or

Until the developer and/or owner files a corporate surety bond with the city secretary in a sum equal to the cost of such improvements for the designated area, guaranteeing the installation thereof within the time stated in the bond, which time shall be fixed by the city council of the City of Rockwall.

We further acknowledge that the dedications and/or exaction's made herein are proportional to the impact of the Subdivision upon the public services required in order that the development will comport with the present and future growth needs of the City; I (we), my (our) successors and assigns hereby waive any claim, damage, or cause of action that I (we) may have as a result of the dedication of exactions made herein.

HARBOR HILLS POINTE INVESTORS, LLC.

Representative:

STATE OF TEXAS}
COUNTY OF ROCKWALL}

Before me, the undersigned authority, on this day personally appeared _____, known to me to be the person whose name is subscribed to the foregoing instrument, and acknowledged to me that he executed the same for the purpose and consideration therein stated.

Given upon my hand and seal of office this _____ day of _____, 2020.

Notary Public in and for the State of Texas

My Commission Expires: _____

SURVEYOR'S CERTIFICATE

NOW, THEREFORE KNOW ALL MEN BY THESE PRESENTS:

THAT I, Brian J. Maddox, do hereby certify that I prepared this plat from an actual and accurate survey of the land, and that the corner monuments shown thereon were properly placed under my personal supervision.

GIVEN UNDER MY HAND AND SEAL OF OFFICE THIS THE _____ DAY OF _____, 2020

BRIAN J. MADDOX, R.P.L.S. NO. 5430

RECOMMENDED FOR FINAL APPROVAL

Planning and Zoning Commission _____ Date _____

APPROVED
I hereby certify that the above and foregoing plat of HARBOR HILLS ADDITION, an addition to the City of Rockwall, Texas, was

approved by the City Council of the City of Rockwall on the _____ day of _____, 2020.

This approval shall be invalid unless the approved plat for such addition is recorded in the office of the County Clerk of Rockwall County, Texas, within one hundred eighty (180) days from said date of final approval.

WITNESS OUR HANDS, this _____ day of _____, 2020.

Mayor, City of Rockwall _____ City Secretary _____ City Engineer _____

FINAL PLAT OF
LOTS 1, 2 & 3 BLOCK A,
HARBOR HILLS ADDITION

328,373 SQUARE FEET OR 7.538 ACRES

SITUATED IN THE EDWARD TEAL SURVEY, ABSTRACT 207
IN THE CITY OF ROCKWALL, ROCKWALL COUNTY, TEXAS

BEING ALL OF A THREE TRACTS OF LAND DESCRIBED BY DEED TO HARBOR LAKE POINTE INVESTORS, LLC. AS RECORDED IN INSTRUMENT NUMBER 20170000002427, INSTRUMENT NUMBER 20170000003548, AND INSTRUMENT NUMBER 20150000011879 OF THE OFFICIAL PUBLIC RECORDS OF ROCKWALL COUNTY, TEXAS AND A PORTION OF TWO TRACTS OF LAND TO THE CITY OF ROCKWALL AS RECORDED IN VOLUME 4067, PAGE 188 AND VOLUME 5830, PAGE 133 OF THE DEED RECORDS OF ROCKWALL COUNTY, TEXAS

OWNER

CITY OF ROCKWALL
385 S. Goliad Street
Rockwall, TX 75087

OWNER

HARBOR LAKE POINTE INVESTORS, LLC.
2701 Sunset Ridge Drive Suite 607
Rockwall, TX 75032

PROJECT INFORMATION

Project No.: HHI 18363
Date: October 20, 2020
Drawn By: JM
Scale: 1"=60'
SHEET 2 of 2

SURVEYOR

TEAGUE NALL AND PERKINS, INC.
825 Watters Creek Boulevard, Suite M300
Allen, Texas 75013
214.461.9867 ph 214.461.9864 fx
T.B.P.L.S. Registration No. 10194381
www.tnpsc.com



CASE NO. P2020-036

GENERAL ITEMS

1. All construction shall conform to the requirements set forth in the City of Rockwall's Engineering Department's "Standards of Design and Construction" and the "Standard Specifications for Public Works Construction" by the North Texas Central Council of Governments, 5th edition amended by the City of Rockwall. The CONTRACTOR shall reference the latest City of Rockwall standard details provided in the Rockwall Engineering Departments "Standards of Design and Construction" manual for details not provided in these plans. The CONTRACTOR shall possess one set of the NCTCOG Standard Specifications and Details and the City of Rockwall's "Standards of Design and Construction" manual on the project site at all times
2. Where any conflicting notes, details or specifications occur in the plans the City of Rockwall General Construction Notes, Standards, Details and Specifications shall govern unless detail or specification is more strict.
3. The City of Rockwall Engineering Departments "Standards of Design and Construction" can be found online at: <http://www.rockwall.com/engr.asp>
4. All communication between the City and the CONTRACTOR shall be through the Engineering Construction Inspector and City Engineer or designated representative only. It is the responsibility of the CONTRACTOR to contact the appropriate department for inspections that do not fall under this approved engineering plan set.
5. Prior to construction, CONTRACTOR shall have in their possession all necessary permits, plans, licenses, etc.
6. The CONTRACTOR shall have at least one original stamped and signed set of approved engineering plans and specifications on-site and in their possession at all times. A stop work order will be issued if items are not on-site. Copies of the approved plans will not be substituted for the required original "approved plans to be on-site".
7. All material submittals, concrete batch designs and shop drawings required for City review and approval shall be submitted by the CONTRACTOR to the City sufficiently in advance of scheduled construction to allow no less than 10 business days for review and response by the City.
8. All site dimensions are referenced to the face of curb or edge of pavement unless otherwise noted.
9. The City requires ten (10%) percent-two (2) year maintenance bond for paving, paving improvements, water systems, wastewater systems, storm sewer systems including detention systems, and associated fixtures and structures which are located within the right-of-ways or defined easements. The two (2) year maintenance bond is to state "from date of City acceptance" as the starting time.
10. A review of the site shall be conducted at twenty (20) months into the two (2) year maintenance period. The design engineer or their designated representative and the CONTRACTOR shall be present to walk the site with the City of Rockwall Engineering Inspection personnel.

EROSION CONTROL & VEGETATION

1. The CONTRACTOR or developer shall be responsible, as the entity exercising operational control, for all permitting as required by the Environmental Protection Agency (EPA) and the Texas Commission on Environmental Quality (TCEQ). This includes, but is not limited to, preparation of the Storm Water Pollution Prevention Plan (SWPPP), the Construction Site Notice (CSN), the Notice of Intent (NOI), the Notice of Termination (NOT) and any Notice of Change (NOC) and is required to pay all associated fees
2. Erosion control devices as shown on the erosion control plan for the project shall be installed prior to the start of land disturbing activities.
3. All erosion control devices are to be installed in accordance with the approved plans, specifications and Storm Water Pollution Prevention Plan (SWPPP) for the project. Erosion control devices shall be placed and in working order prior to start of construction. Changes are to be reviewed and approved by the design engineer and the City of Rockwall prior to implementation.
4. If the Erosion Control Plans and Storm Water Pollution Prevention Plan (SWPPP) as approved cannot appropriately control erosion and off-site sedimentation from the project, the erosion control plan and/or the SWPPP is required to be revised and any changes reported to the Texas Commission on Environmental Quality (TCEQ), when applicable.
5. All erosion control devices shall be inspected weekly by the CONTRACTOR and after all major rain events, or more frequently as dictated in the project Storm Water Pollution Prevention Plan (SWPPP). CONTRACTOR shall provide copies of inspection's reports to the engineering inspection after each inspection.
6. The CONTRACTOR shall not dispose of waste and any materials into streams, waterways or floodplains. The CONTRACTOR shall secure all excavation at the end of each day and dispose of all excess materials.
7. CONTRACTOR shall take all available precautions to control dust. CONTRACTOR shall control dust by sprinkling water or other means as approved by the City Engineer.
8. CONTRACTOR shall establish grass and maintain the seeded area, including watering, until a "Permanent Stand of Grass" is obtained at which time the project will be accepted by the City. A "Stand of Grass" (not winter rye or weeds) shall consist of 75% to 80% coverage of all disturbed areas and a minimum of one-inch (1") in height as determined by the City. No bare spots will be allowed. Re-seeding will be required in all washed areas and areas that don't grow.
9. All City right-of-ways shall be sodded if disturbed. No artificial grass is allowed in any City right-of-way and/or easements.
10. All adjacent streets/alleys shall be kept clean at all times
11. CONTRACTOR shall keep construction site clean at all times, immediately contain all debris and trash, all debris and trash shall be removed at the end of each work day, and all vegetation on the construction site 10-inches or taller in height must be cut immediately.
12. Suspension of all construction activities for the project will be enforced by the City if any erosion control requirements are not met. Work may commence after deficiency has been rectified.
13. During construction of the project, all soil stockpiles and borrow areas shall be stabilized or protected with sediment trapping measures. The CONTRACTOR is responsible for the temporary protection and permanent stabilization of all soil stockpiles on-site as well as borrow areas and soil intentionally transported from the project site.
14. Where construction vehicles access routes intersect paved or public roads/alleys, construction entrances shall be installed to minimize the transport of sediment by vehicular tracking onto paved surfaces. Where sediment is transferred onto paved or public surfaces, the surface shall be immediately cleaned. Sediment shall be

removed from the surface by shoveling or sweeping and transported to a sediment disposal area. Pavement washing shall be allowed only after sediment is removed in this manner.

15. All drainage inlets shall be protected from siltation, ineffective or unmaintained protection devices shall be immediately replaced and the inlet and storm system cleaned. Flushing is not an acceptable method of cleaning.
16. During all dewatering operations, water shall be pumped into an approved filtering device prior to discharge into a receiving outlet.

TRAFFIC CONTROL

1. All new Detouring or Traffic Control Plans are required to be submitted to the City for review and approval a minimum of 21 calendar days prior to planned day of implementation.
2. When the normal function of the roadway is suspended through closure of any portion of the right-of-way, temporary construction work zone traffic control devices shall be installed to effectively guide the motoring public through the area. Consideration for road user safety, worker safety, and the efficiency of road user flow is an integral element of every traffic control zone.
3. All traffic control plans shall be prepared and submitted to the Engineering Department in accordance with the standards identified in Part VI of the most recent edition of the TMUTCD. Lane closures will not occur on roadways without an approval from the Rockwall Engineering Department and an approved traffic control plan. Traffic control plans shall be required on all roadways as determined by the City Engineer or the designated representative.
4. All traffic control plans must be prepared, signed, and sealed by an individual that is licensed as a professional engineer in the State of Texas. All traffic control plans and copies of work zone certification must be submitted for review and approval a minimum of three (3) weeks prior to the anticipated temporary traffic control.
5. The CONTRACTOR executing the traffic control plan shall notify all affected property owners two (2) weeks prior to any the closures in writing and verbally.
6. Any deviation from an approved traffic control plan must be reviewed by the City Engineer or the designated representative. If an approved traffic control plan is not adhered to, the CONTRACTOR will first receive a verbal warning and be required to correct the problem immediately. If the deviation is not corrected, all construction work will be suspended, the lane closure will be removed, and the roadway opened to traffic.
7. All temporary traffic control devices shall be removed as soon as practical when they are no longer needed. When work is suspended for short periods of time at the end of the workday, all temporary traffic control devices that are no longer appropriate shall be removed or covered. The first violation of this provision will result in a verbal warning to the construction foreman. Subsequent violations will result in suspension of all work at the job site for a minimum of 48 hours. All contractors working on City funded projects will be charged one working day for each 24 hour closure.
8. Lane closures on any major or minor arterial will not be permitted between the hours of 6:00 am to 9:00 am and 3:30 pm to 7:00 pm. Where lane closures are needed in a school area, they will not be permitted during peak hours of 7:00 am – 9:00 am and 3:00 pm to 5:00 pm. Closures may be adjusted according to the actual start-finish times of the actual school with approval by the City Engineer. The first violation of this provision will result in a verbal warning to the construction foreman. Subsequent violations will result in suspension of all work at the job site for a minimum of 48 hours. All contractors working on City funded projects will be charged one working day for each 24 hour closure of a roadway whether they are working or not.
9. No traffic signs shall be taken down without permission from the City.
10. No street/roadway will be allowed to be fully closed.

UTILITY LINE LOCATES


1. It is the CONTRACTOR's responsibility to notify utility companies to arrange for utility locates at least 48 hours prior to beginning construction. The completeness and accuracy of the utility data shown on the plans is not guaranteed by the design engineer or the City. The CONTRACTOR is responsible for verifying the depth and location of existing underground utilities proper to excavating, trenching, or drilling and shall be required to take any precautionary measures to protect all lines shown and .or any other underground utilities not on record or not shown on the plans.
2. The CONTRACTOR shall be responsible for damages to utilities
3. CONTRACTOR shall adjust all City of Rockwall utilities to the final grades.
4. All utilities shall be placed underground.
5. CONTRACTOR shall be responsible for the protection of all existing main lines and service lines crossed or exposed by construction operations. Where existing mains or service lines are cut, broken or damaged, the CONTRACTOR shall immediately make repairs to or replace the entire service line with same type of original construction or better. The City of Rockwall can and will intervene to restore service if deemed necessary and charge the CONTRACTOR for labor, equipment, material and loss of water if repairs aren't made in a timely manner by the CONTRACTOR.
6. The City of Rockwall (City utilities) is not part of the Dig Tess or Texas one Call – 811 – line locate system. All City of Rockwall utility line locates are to be scheduled with the City of Rockwall Service Center. 972-771-7730. A 48-hour advance notice is required for all non-emergency line locates.
7. Underground utility lines shall be installed in accordance with the following standards in addition to other applicable criteria:
 - a. No more than 500 linear feet of trench may be opened at one time.
 - b. Material used for backfilling trenches shall be properly compacted to 95% standard density in order to minimize erosion, settlement, and promote stabilization that the geotechnical engineer recommends.
 - c. Applicable safety regulations shall be complied with.
11. This plan details pipes up to 5 feet from the building. Refer to the building plans for building connections. CONTRACTOR shall supply and install pipe adapters as necessary.
12. All underground lines shall be installed, inspected, and approved prior to backfilling.
13. All concrete encasement shall have a minimum of 28 days compressive strength at 3,000 psi (min. 5.5 sack mix).

WATER LINE NOTES

1. The CONTRACTOR shall maintain existing water service at all times during construction.
2. Proposed water lines shall be AWWA C900-16 PVC Pipe (blue in color) for all sizes, DR 14 (PC 305) for pipeline sizes 12-inch and smaller, and DR 18 (PC 235) for 14-inch and larger water pipelines unless otherwise shown on water plan and profiles sheets. Proposed water lines shall be constructed with minimum cover of 4 feet for 6-inch through 8-inch, 5 feet for 12-inch through 18-inch and 6 feet for 20-inch and larger.
3. Proposed water line embedment shall be NCTCOG Class 'B-3' as amended by the City of Rockwall's engineering standards of design and construction manual.
4. CONTRACTOR shall coordinate the shutting down of all water lines with the City of Rockwall Engineering Inspector and Water Department. The City shall operate all water valves. Allow 5 business days from the date of notice to allow City personnel time to schedule a shut down. Two additional days are required for the CONTRACTOR to notify residents in writing of the shut down after the impacted area has been identified. Water shut downs impacting businesses during their normal operation hours is not allowed. CONTRACTOR is required to coordinate with the Rockwall Fire Department regarding any fire watch requirements as well as any costs incurred when the loss of fire protection to a structure occurs.
5. CONTRACTOR shall furnish and install gaskets on water lines between all dissimilar metals and at valves (both existing and proposed).
6. All fire hydrants and valves removed and salvaged shall be returned to the City of Rockwall Municipal Service Center.
7. Blue EMS pads shall be installed at every change in direction, valve, curb stop and service tap on the proposed water line and every 250'.
8. All water valve hardware and valve extensions, bolts, nuts and washers shall be 316 stainless steel.
9. All fire hydrants bolts, nuts and washers that are buried shall be 316 stainless steel.
10. Abandoned water lines to remain in place shall be cut and plugged and all void spaces within the abandoned line shall be filled with grout, flowable fill or an expandable permanent foam product. Valves to be abandoned in place shall have any extensions and the valve box removed and shall be capped in concrete.
11. All fire hydrants will have a minimum of 5 feet of clearance around the appurtenance including but not limited to parking spaces and landscaping.
12. All joints are to be megalug joints with thrust blocking.
13. Water and sewer mains shall be kept 10 feet apart (parallel) or when crossing 2 feet vertical clearance.
14. CONTRACTOR shall maintain a minimum of 4 feet of cover on all water lines.
15. All domestic and irrigation services are required to have a testable backflow device with a double check valve installed per the City of Rockwall regulations at the property line and shown on plans.

WASTEWATER LINE NOTES

1. The CONTRACTOR shall maintain existing wastewater service at all times during construction.
2. Wastewater line for 4-inch through 15-inch shall be Green PVC – SDR 35 (ASTM D3034) [less 10 ft cover] and SDR 26 (ASTM D3034) [10 ft or more cover]. For 18-inch and larger wastewater line shall be Green PVC – PS 46 (ASTM F679) [less 10 ft cover] and PS 115 (ASTM F679) [10 ft or more cover]. No services will be allowed on a sanitary sewer line deeper than 10 feet.
3. Proposed wastewater line embedment shall be NCTCOG Class 'H' as amended by the City of Rockwall's public works standard design and construction manual.
4. Green EMS pads shall be installed at every 250', manhole, clean out and service lateral on proposed wastewater lines.
5. CONTRACTOR shall CCTV all existing wastewater lines that are to be abandoned to ensure that all laterals are accounted for and transferred to proposed wastewater lines prior to abandonment.
6. All abandoned wastewater and force main lines shall be cut and plugged and all void spaces within the abandoned line shall be filled with grout, flowable fill or an expandable permanent foam product.
7. Existing manholes and cleanouts not specifically called to be relocated shall be adjusted to match final grades.
8. All wastewater pipes and public services shall be inspected by photographic means (television and DVD) prior to final acceptance and after franchise utilities are installed. The CONTRACTOR shall furnish a DVD to the Engineering Construction Inspector for review. Any sags, open joints, cracked pipes, etc. shall be repaired or removed by the CONTRACTOR at the CONTRACTOR's expense. A television survey will be performed as part of the final testing in the twentieth (20th) month of the maintenance period.
9. All manholes (public or private) shall be fitted with inflow prevention. The inflow prevention shall conform to the measures called out in standard detail R-5031.
10. All new or existing manholes being modified shall have corrosion protection being Raven Liner 405 epoxy coating, ConShield, or approved equal. Conshield must have terracotta color dye mixed in the precast and cast-in-place concrete. Where connections to existing manholes are made the CONTRACTOR shall rehab manhole as necessary and install a 125 mil thick coating of Raven Liner 405 or approved equal.
11. If an existing wastewater main or trunk line is called out to be replaced in place a wastewater bypassing pump plan shall be required and submitted to the Engineering Construction Inspector and City Engineer for approval prior to implementation. Bypass pump shall be fitted with an auto dialer and conform to the City's Noise Ordinance. Plan shall be to the City sufficiently in advance of scheduled construction to allow no less than 10 business days for review and response by the City.
12. CONTRACTOR shall maintain a minimum of 4 feet of cover on all wastewater lines.

	GENERAL CONSTRUCTION NOTES Sheet 1 of 2 June 2020	
	CITY OF ROCKWALL ENGINEERING DEPARTMENT 385 S. Goliad Rockwall, Texas 75087 P (972) 771-7746 F (972) 771-7748	

DEMOLITION, REMOVAL, DISPOSAL AND EXCAVATION NOTES

1. All pavements to be removed and replaced shall be saw cut to full depth along neat squared lines shown in the plans.
2. Proposed concrete pavement shall be constructed with longitudinal butt construction joints at all connections to existing concrete pavement.
3. All public concrete pavement to be removed and replaced shall be full panel replacement, 1-inch thicker and on top of 6-inch thick compacted flexbase.
4. No excess excavated material shall be deposited in low areas or along natural drainage ways without written permission from the affected property owner and the City of Rockwall. No excess excavation shall be deposited in the City Limits without a permit from the City of Rockwall. If the CONTRACTOR places excess materials in these areas without written permission, the CONTRACTOR will be responsible for all damages resulting from such fill and shall remove the material at their own cost.

PAVING AND GRADING

1. All detention systems are to be installed and verified for design compliance along with the associated storm sewer and outflow structures, prior to the start of any paving operations (including building foundations). Erosion protection shall be placed at the pond outflow structures, silt fence along the perimeter of the pond along with any of the associated erosion BMPs noted on the erosion control plan, and the sides and bottom of the detention system shall have either sod or anchored seeded curlex installed prior to any concrete placement.
2. All paving roadway, driveways, fire lanes, drive-isles, parking, dumpster pads, etc. sections shall have a minimum thickness, strength, reinforcement, joint type, joint spacing and subgrade treatment shall at a minimum conform to the City standards of Design and Construction and table below.

Street/Pavement Type	Minimum Thickness (inches)	Strength 28-Day (psi)	Minimum Cement (sacks / CY)		Steel Reinforcement	
			Machine placed	Hand Placed	Bar #	Spacing (O.C.E.W.)
Arterial	10"	3,600	6.0	6.5	#4 bars	18"
Collector	8"	3,600	6.0	6.5	#4 bars	18"
Residential	6"	3,600	6.0	6.5	#3 bars	24"
Alley	7"-5"-7"	3,600	6.0	6.5	#3 bars	24"
Fire Lane	6"	3,600	6.0	6.5	#3 bars	24"
Driveways	6"	3,600	6.0	6.5	#3 bars	24"
Barrier Free Ramps	6"	3,600	N/A	6.5	#3 bars	24"
Sidewalks	4"	3,000	N/A	5.5	#3 bars	24"
Parking Lot/Drive Aisles	5"	3,000	5.0	5.5	#3 bars	24"
Dumpster Pads	7"	3,600	6.0	6.5	#3 bars	24"

3. Reinforcing steel shall be tied (100%). Reinforcing steel shall be set on plastic chairs. Bar laps shall be minimum 30 diameters. Sawed transverse dummy joints shall be spaced every 15 feet or 1.25 time longitudinal butt joint spacing whichever is less. Sawing shall occur within 5 to 12 hours after the pour, including sealing. Otherwise, the section shall be removed and longitudinal butt joint constructed.
4. No sand shall be allowed under any paving.
5. All concrete mix design shall be submitted to the City for review and approval prior to placement.
6. Fly ash may be used in concrete pavement locations provided that the maximum cement reduction does not exceed 20% by weight per C.Y. of concrete. The fly ash replacement shall be 1.25 lbs. per 1.0 lb. cement reduction.
7. All curb and gutter shall be integral (monolithic) with the pavement.
8. All fill shall be compacted by sheep's foot roller to a minimum 95% standard proctor. Maximum loose lift for compaction shall be 8 inches. All lifts shall be tested for density by an independent laboratory. All laboratory compaction reports shall be submitted to the City Engineering Construction Inspector once results are received. All reports will be required prior to final acceptance.
9. All concrete compression tests and soil compaction/density tests are required to be submitted to the City's Engineering Inspector immediately upon results.
10. All proposed sidewalks shall include barrier free ramps at intersecting streets, alleys, etc. Barrier free ramps (truncated dome plate in Colonial or brick red color) shall meet current City and ADA requirements and be approved by the Texas Department of Licensing and Regulation (TDLR).
11. All public sidewalks shall be doweled into pavement where it abuts curbs and driveways. Expansion joint material shall be used at these locations.
12. All connection of proposed concrete pavement to existing concrete pavement shall include a longitudinal butt joint as the load transfer device. All longitudinal butt joints shall be clean, straight and smooth (not jagged in appearance)
13. Cracks formed in concrete pavement shall be repaired or removed by the CONTRACTOR at the City's discretion. CONTRACTOR shall replace existing concrete curbs, sidewalk, paving, a gutters as indicated on the plans and as necessary to connect to the existing infrastructure, including any damage caused by the CONTRACTOR.
14. All residential lots will require individual grading plans submitted during the building permit process that correspond with the engineered grading and drainage area plans.
15. Approval of this plan is not an authorization to grade adjacent properties when the plans or field conditions warrant off-site grading. Written permission must be obtained and signed from the affected property owner(s) and temporary construction easements may be required. The written permission shall be provided to the City as verification of approval by the adjacent property owner(s). Violation of this requirement will result in suspension of all work at the job site until issue has been rectified.
16. All cut or fill slopes of non-paved areas shall be a maximum of 4:1 and minimum of 1%.
17. CONTRACTOR agrees to repair any damage to property and the public right-of-way in accordance with the City Standards of Design and Construction.
18. CONTRACTOR shall protect all monuments, iron pins/rods, and property corners during construction.
19. CONTRACTOR shall ensure positive drainage so that runoff will drain by gravity flow to new or existing drainage inlets or sheet flow per these approved plans.

DRAINAGE / STORM SEWER NOTES


1. The CONTRACTOR shall maintain drainage at all times during construction. Ponding of water in streets, drives, trenches, etc. will not be allowed. Existing drainage ways shall not be blocked or removed unless explicitly stated in the plans or written approval is given by the City.
2. All structural concrete shall be 4200 psi compressive strength at 28 days minimum 7.0 sack mix, air entrained, unless noted otherwise. Fly ash shall not be allowed in any structural concrete.
3. Proposed storm sewer embedment shall be NCTCOG Class 'B' as amended by the City of Rockwall's Engineering Department Standards of Design and Construction Manual.
4. All public storm pipe shall be a minimum of 18-inch reinforced concrete pipe (RCP), Class III, unless otherwise noted.
5. All storm pipe entering structures shall be grouted to assure connection at the structure is watertight.
6. All storm structures shall have a smooth uniform poured mortar invert from invert in to invert out.
7. All storm sewer manholes in paved areas shall be flush with the paving grade, and shall have traffic bearing ring and covers.

RETAINING WALLS

1. All retaining walls, regardless of height, will be reviewed and approved by the City Engineering Department
2. All retaining walls (including foundation stem walls), regardless of height, will be constructed of rock/stone/brick or rock/stone/brick faced. No smooth concrete walls are allowed. Wall materials shall be the same for all walls on the project.
3. All portions, including footings, tie-backs, and drainage backfill, of the wall shall be on-site and not encroach into any public easements or right-of-way. The entire wall shall be in one lot and shall not be installed along a lot line.
4. All walls 3 feet and taller will be designed and signed/sealed by a registered professional engineer in the State of Texas. The wall design engineer is required to inspect the wall construction and supply a signed/sealed letter of wall construction compliance to the City of Rockwall along with wall as-builts prior to City Engineering acceptance.
5. No walls are allowed in detention easements. A variance to allow retaining walls in a detention easement will require approval by the Planning and Zoning Commission with appeals being heard by the City Council.

FINAL ACCEPTANCE AND RECORD DRWINGS/AS-BUILTS


1. Final Acceptance shall occur when all the items on the Checklist for Final Acceptance have been completed and signed-off by the City. An example of the checklist for final acceptance has been included in the Appendix of the Standards of Design and Construction. Items on the checklist for final acceptance will vary per project and additional items not shown on the check list may be required.
2. After improvements have been constructed, the developer shall be responsible for providing to the City "As Built" or "Record Drawings". The Design Engineer shall furnish all digital files of the project formatted in Auto Cad 14, or 2000 format or newer and Adobe Acrobat (.pdf) format with a CD-ROM disk or flash drive. The disk or drive shall include a full set of plans along with any landscaping, wall plans, and details sheets.
3. Submit 1-set of printed drawings of the "Record Drawings" containing copies of all sheets to the Engineering Construction Inspector for the project. The printed sheets will be reviewed by the inspector PRIOR to producing the "Record Drawing" digital files on disk or flash drive. This will allow any revisions to be addressed prior to producing the digital files.
4. Record Drawing Disk drawings shall have the Design Engineers seal, signature and must be stamped and dated as "Record Drawings" or "As Built Drawings" on all sheets.
5. The City of Rockwall will not accept any Record Drawing disk drawings which include a disclaimer. A disclaimer shall not directly or indirectly state or indicate that the design engineer or the design engineer's surveyor/surveyors did not verify grades after construction, or that the Record Drawings were based solely on information provided by the construction contractor/contractors. Any Record Drawings which include like or similar disclaimer verbiage will not be accepted by the City of Rockwall.
6. Example of Acceptable Disclaimer: "To the best of our knowledge ABC Engineering, Inc., hereby states that this plan is As-Built. This information provided is based on surveying at the site and information provided by the contractor."

	GENERAL CONSTRUCTION NOTES Sheet 2 of 2 June 2020
	CITY OF ROCKWALL ENGINEERING DEPARTMENT 385 S. Goliad Rockwall, Texas 75087

P (972) 771-7746
 F (972) 771-7748

LOT 1
0.952 AC
41,452.049 SF
BLOCK C


LOT 1
0.454 AC
19,785.301 SF
BLOCK D

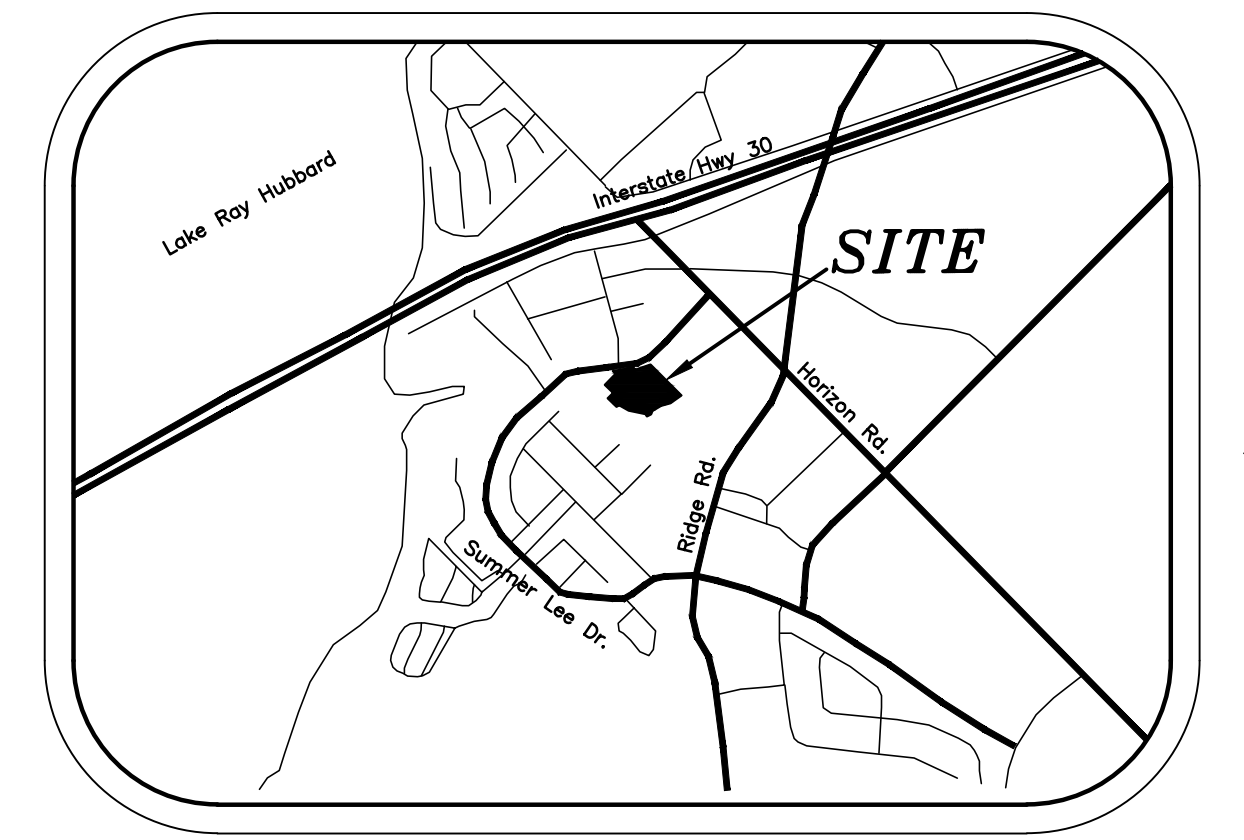

Vicinity Map
NTS


LEGEND

- Firelane, Public Access & Utility Esmt.
- Proposed Sidewalk
- Ex. Concrete
- Proposed Retaining Wall
- Proposed Wheel Stop Typical
- Existing Fire Hydrant
- Proposed Fire Hydrant
- Barrier Free Ramp

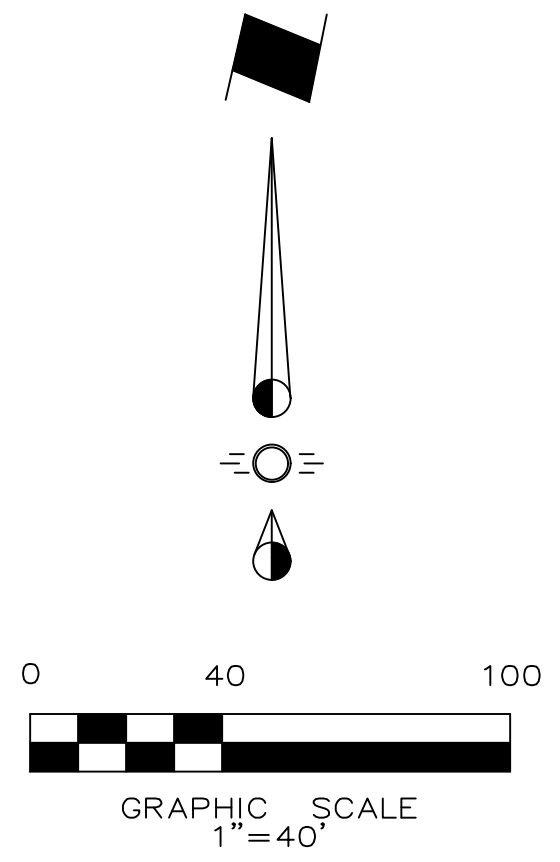

SYNOPSIS

Address: 2400 Summer Lee Drive
Rockwall, Texas 75032
PD-32
Zoning: PD-32
Proposed Use: Multifamily
Lot Area: 4.032 Acres (175,656 sf)
Building Areas:
Garage Lower Level 96,539 sf
Garage Upper Level 96,627 sf
Building Level 1 77,352 sf
Building Level 2 77,419 sf
Building Level 3 77,459 sf
Building Level 4 77,459 sf
Total Bldg Area: 502,855 sf
Lot Coverage: 44.04% (Level 1 Area 77,352 sf)
Floor Area Ratio: 2.86 : 1

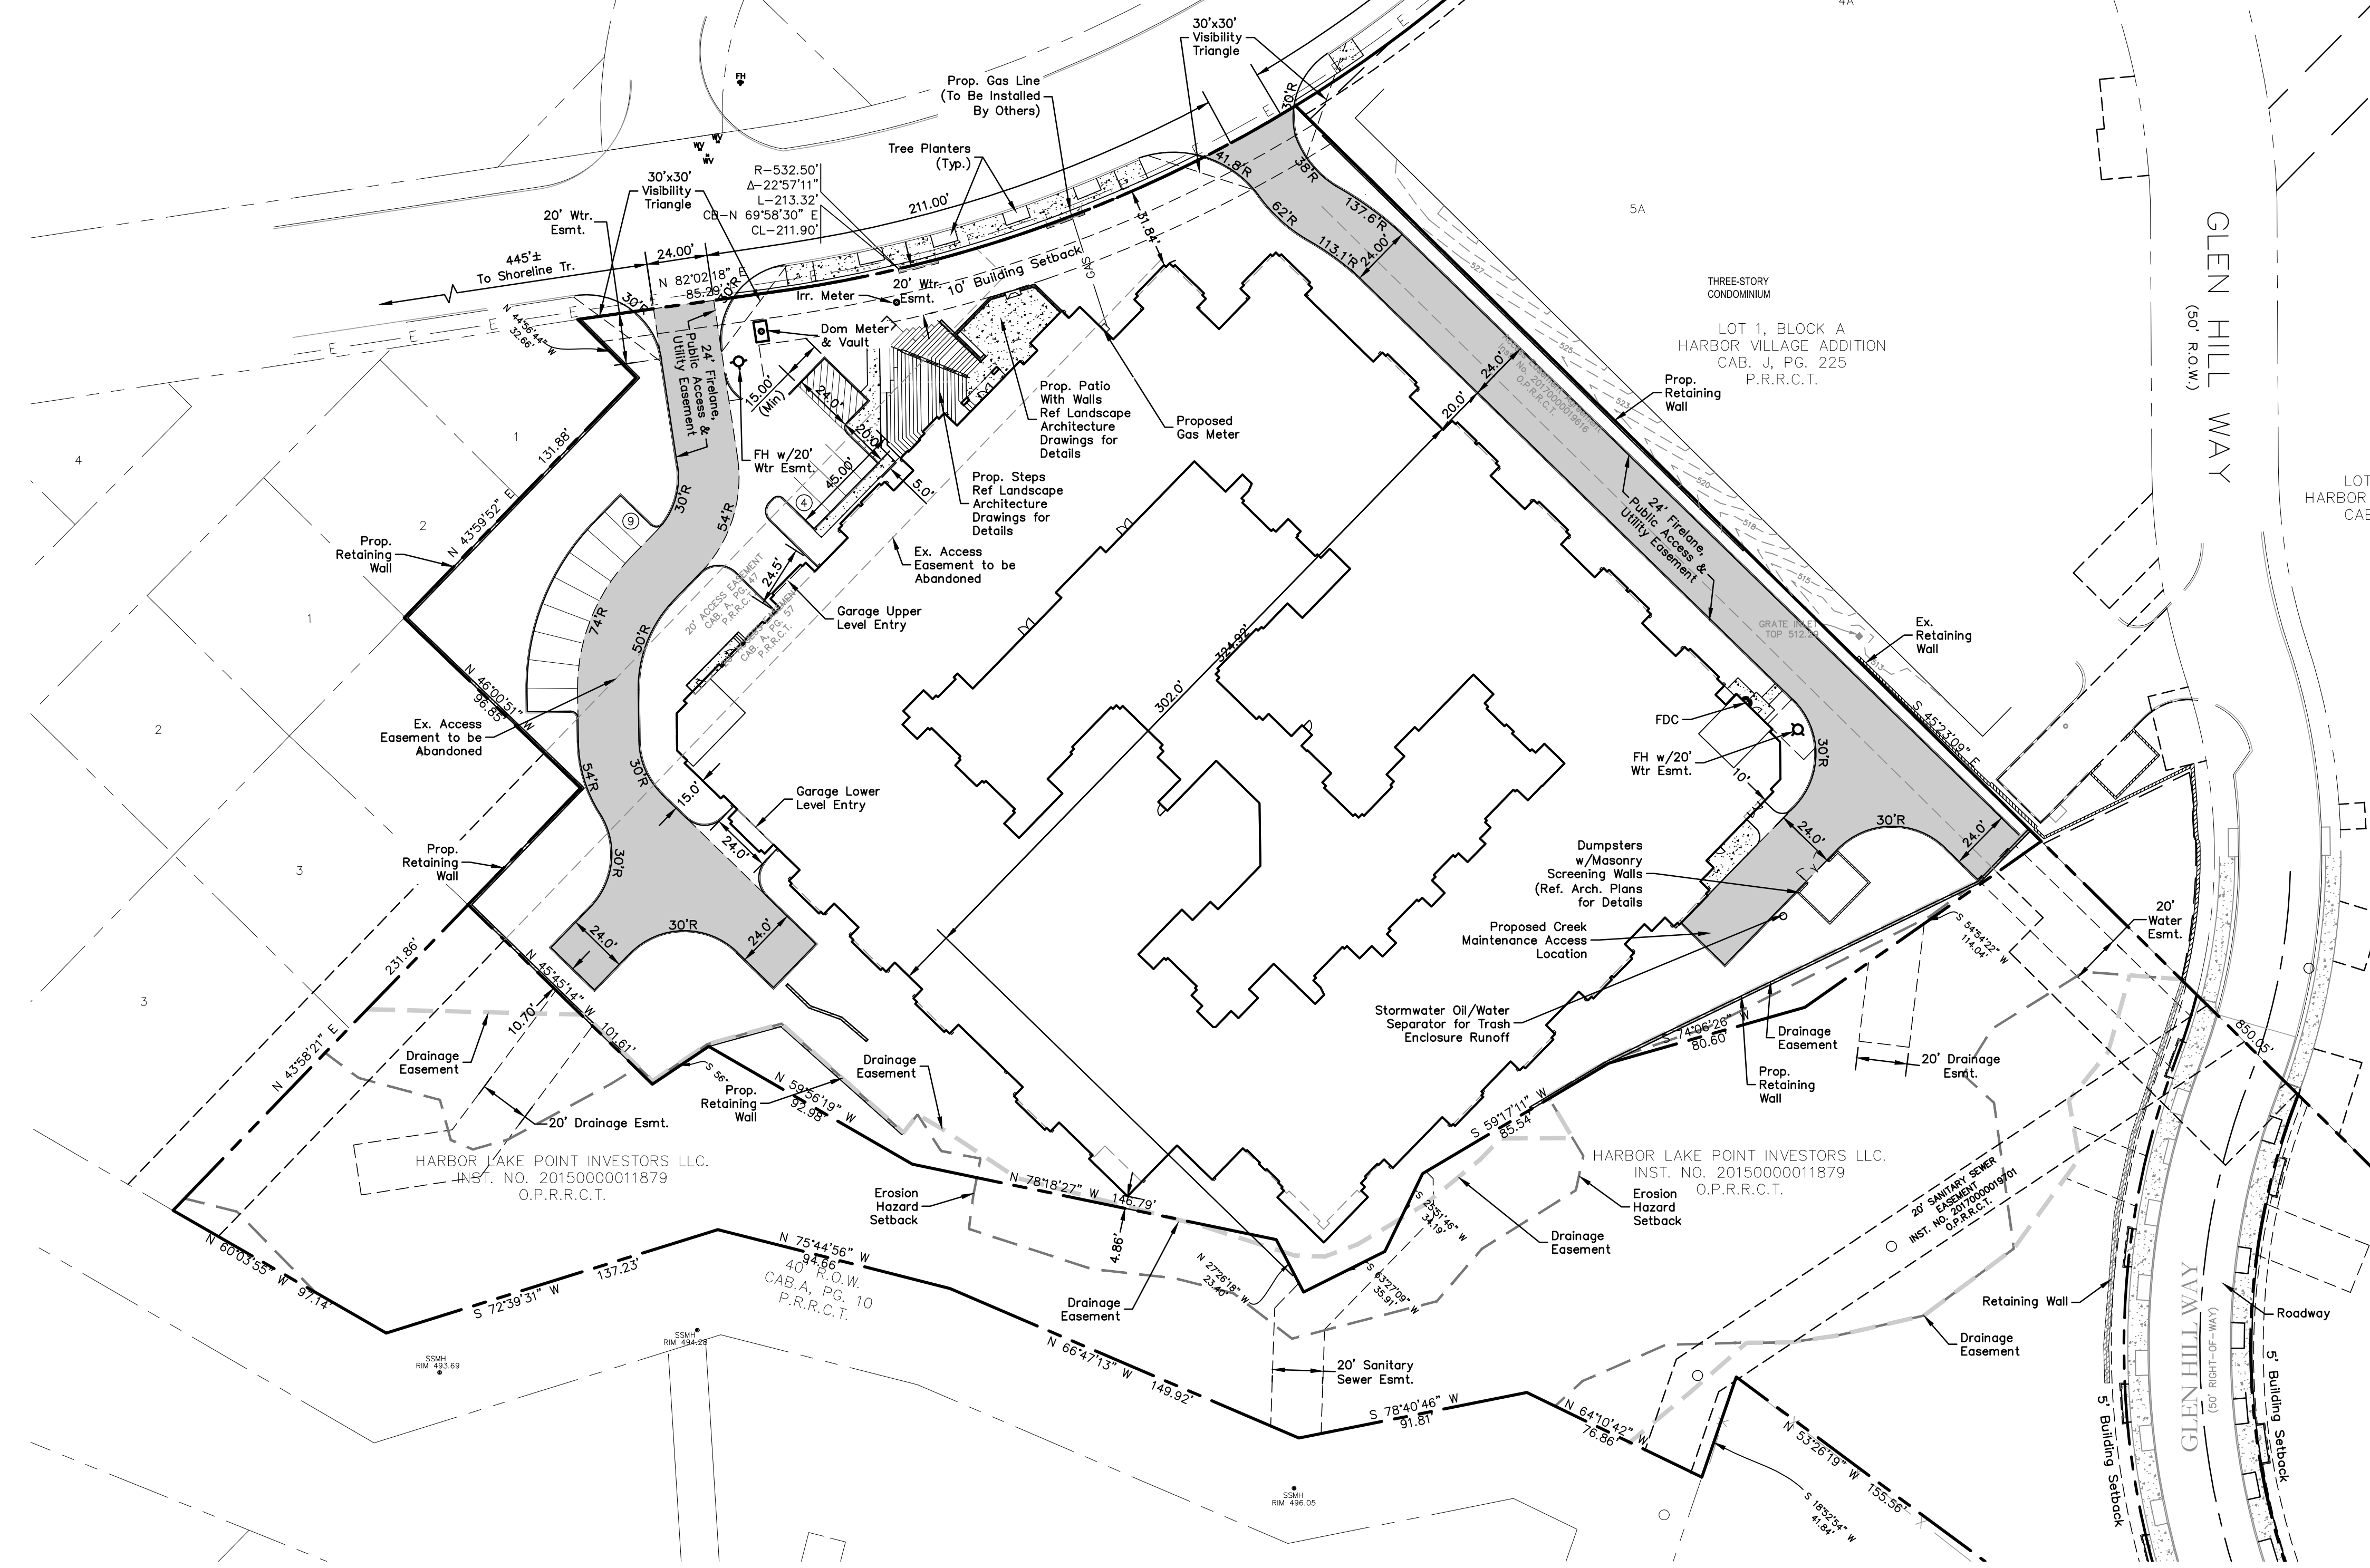

HARBOR LAKE POINT INVESTORS LLC.
INST. NO. 20150000011879
O.P.R.R.C.T.

HARBOR LAKE POINT INVESTORS LLC.
INST. NO. 20150000011879
O.P.R.R.C.T.

This Record Drawing is a combination of the sealed engineering contract drawings for this project, modified by revision, change order, field order and information furnished by the contractor. The information shown on the Record Drawings is believed to be accurate based on information furnished by the contractor. The original sealed drawings are on file at the office of:
Cross Engineering Consultants
1720 W. Virginia Street
McKinney, Texas 75069
(972) 562-4409
Record Drawings Prepared On:
12/22/2023

ENGINEER:
Cross Engineering Consultants, Inc.
131 S. Tennessee St.
McKinney, Texas 75069
Phone (972) 562-4409
Fax (972) 562-4471
Contact: Jon David Cross, P.E.

ARCHITECT:
DBA Architects
111 S. Kentucky Street, Suite 210
McKinney, Texas 75069
Phone (888) 900-4905
Contact: Bryan Moore

SURVEYOR:
Teague Nall and Perkins, Inc.
825 Watters Creek Blvd., Suite M300
Allen, Texas 75013
Phone (214) 461-9867
Fax (214) 461-9864
Contact: Brian Maddox, RPLS

NOTE: THIS IS NOT A CONSTRUCTION DOCUMENT.
THIS DOCUMENT IS FOR CONCEPTUAL PLANNING PURPOSES ONLY.

Issued for Construction: 04-19-2021

Issue Dates:	Revisions:	Date:
5	11/30/2020	1 05/17/2021
6	12/23/2020	2 01/28/2022
7	01/22/2021	3 02/25/2022
8	01/29/2021	4 10/31/2023
9	04/19/2021	5
10	12/22/2023	6

CROSS ENGINEERING CONSULTANTS
1720 W. Virginia Street
McKinney, Texas 75069
972.562.4409
McKinney, Texas 75069
Texas P.E. Firm No. F-5935

Drawn By: C.E.C.I. Checked By: C.E.C.I. Scale: 1"=40'

The seal that originally appeared on this document was authorized by T. Zachary Grimes, Texas No. 122013 on 4/19/2021. Alteration of a sealed document without proper notification of the responsible Engineer is an offense under the Texas Engineering Practice Act.



SITE PLAN
HARBOR HILL RESIDENCES
SUMMER LEE DRIVE
ROCKWALL, TEXAS

Sheet No.
SP
Project No.
18090

HARBOR HILL RESIDENCES - ROCKWALL

LOT 1
0.952 AC
41,452.049 SF
BLOCK C

LOT 1
0.454 AC
19,785.301 SF
BLOCK D

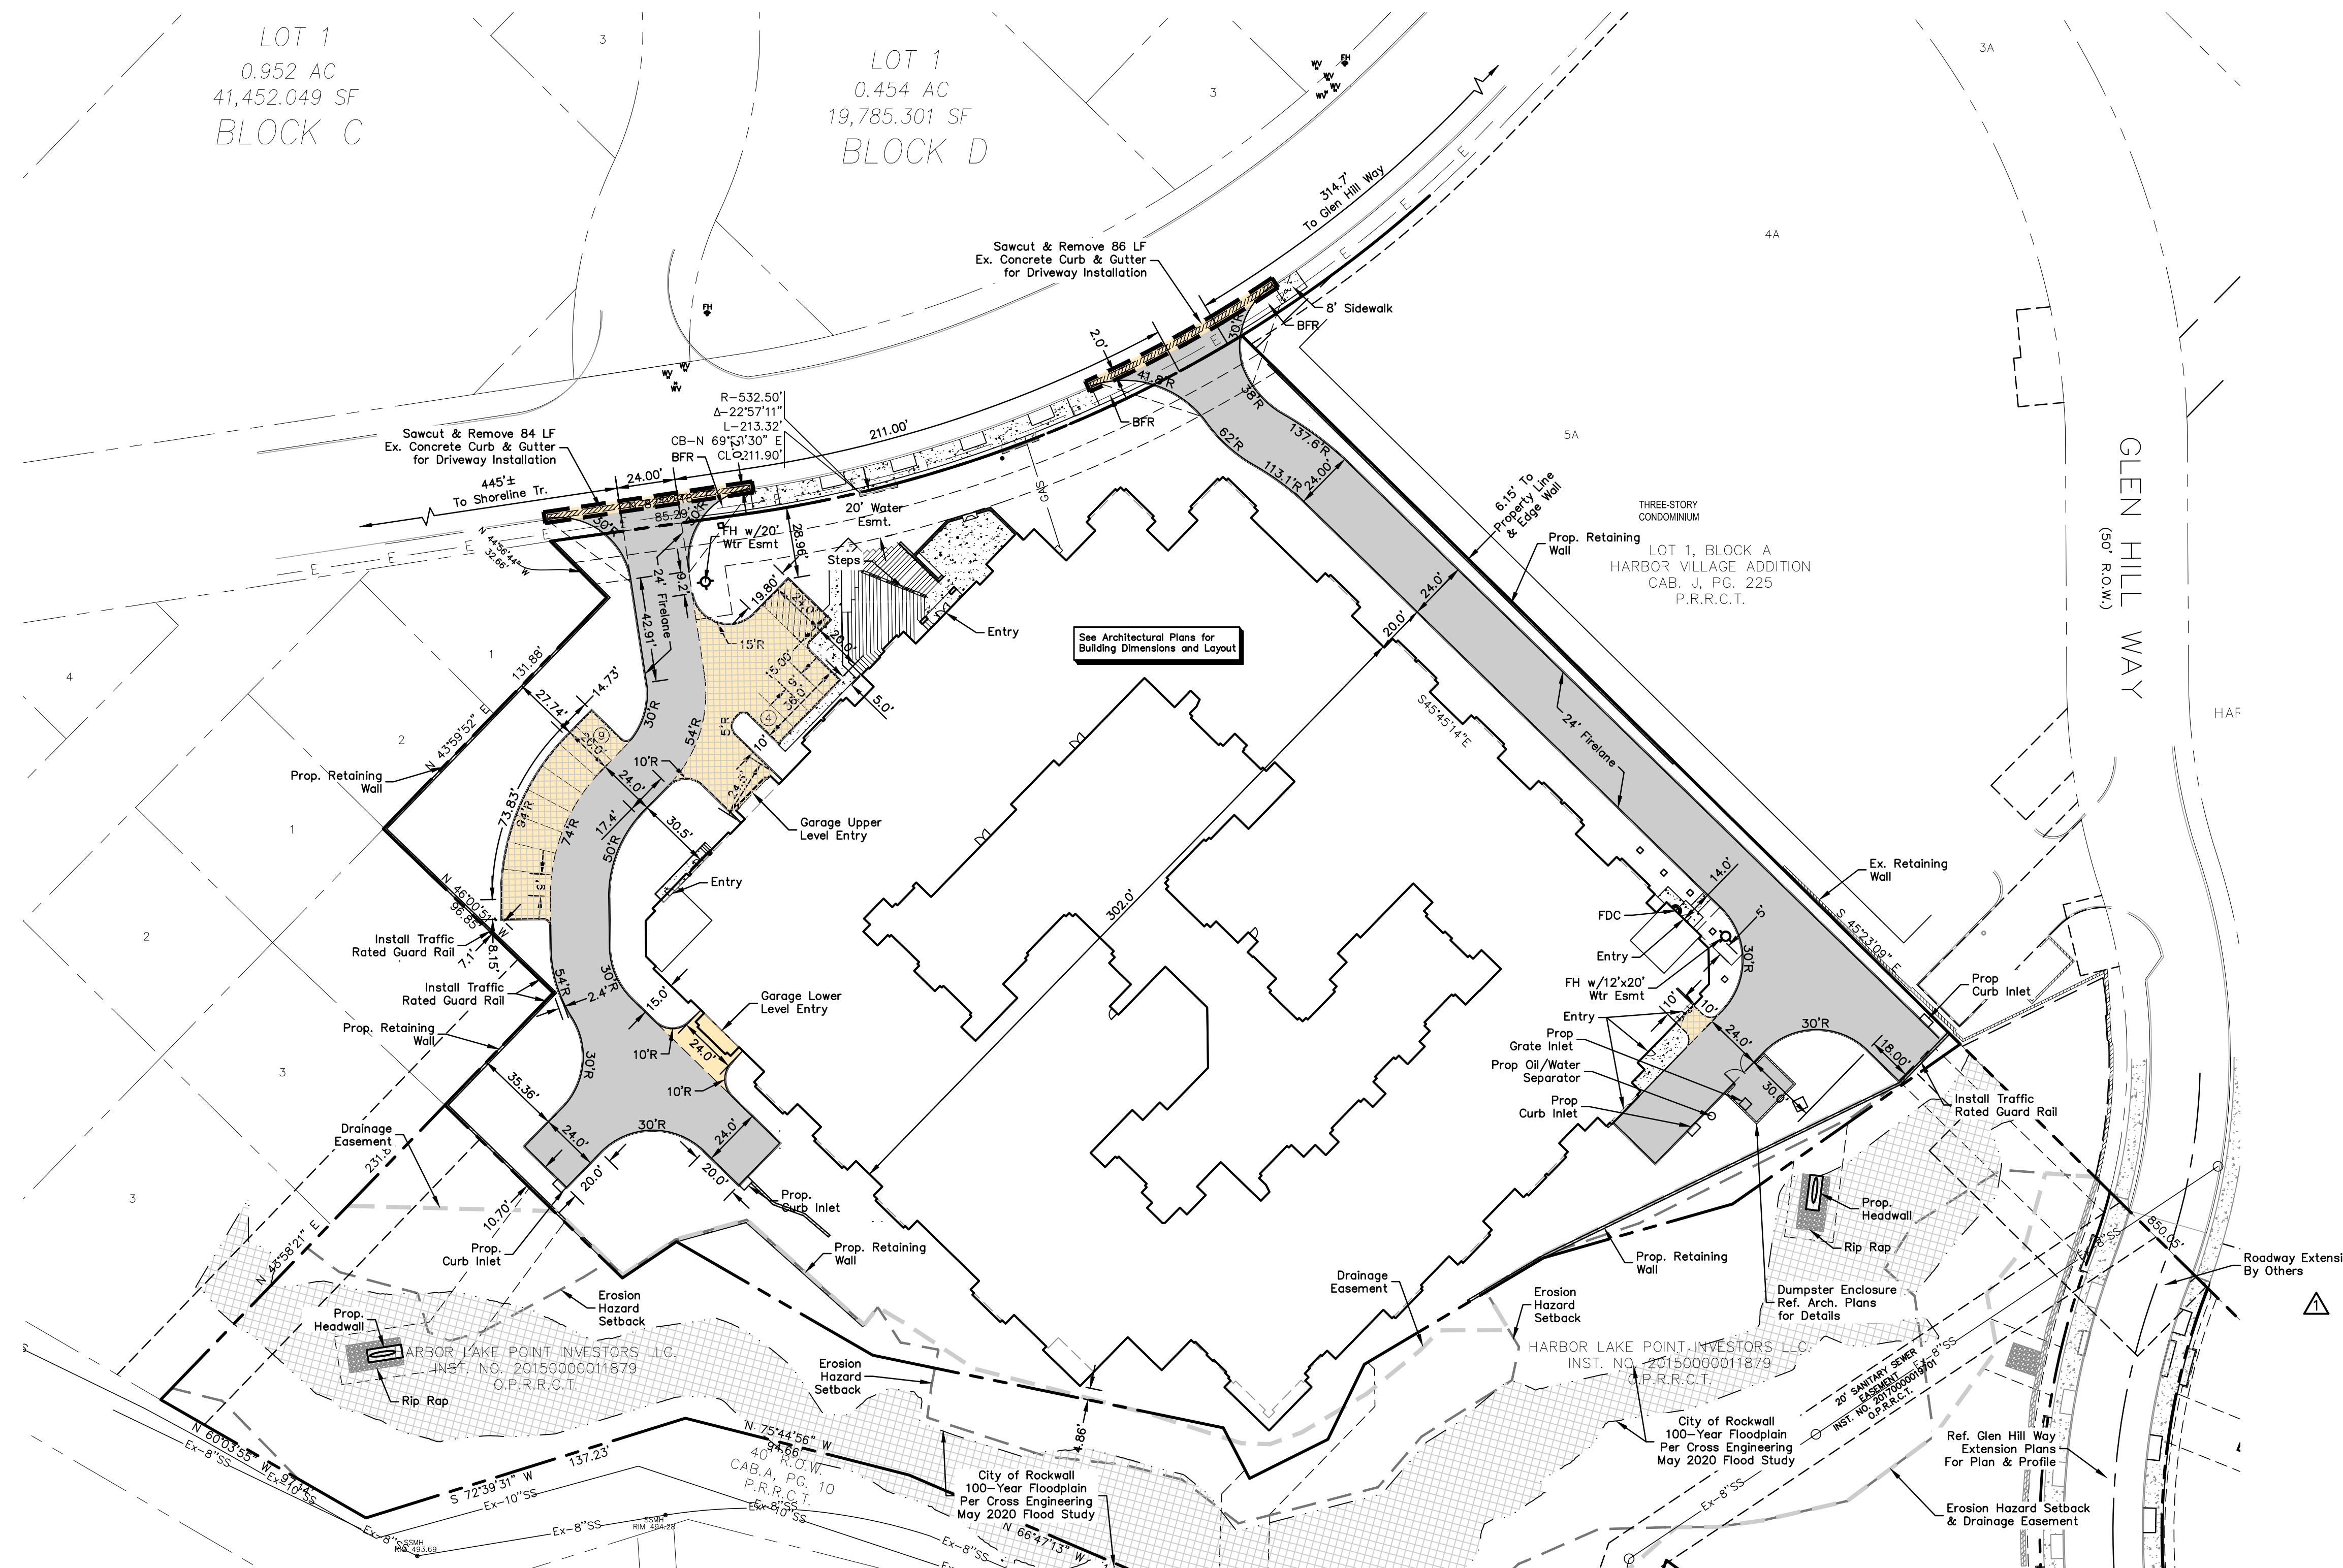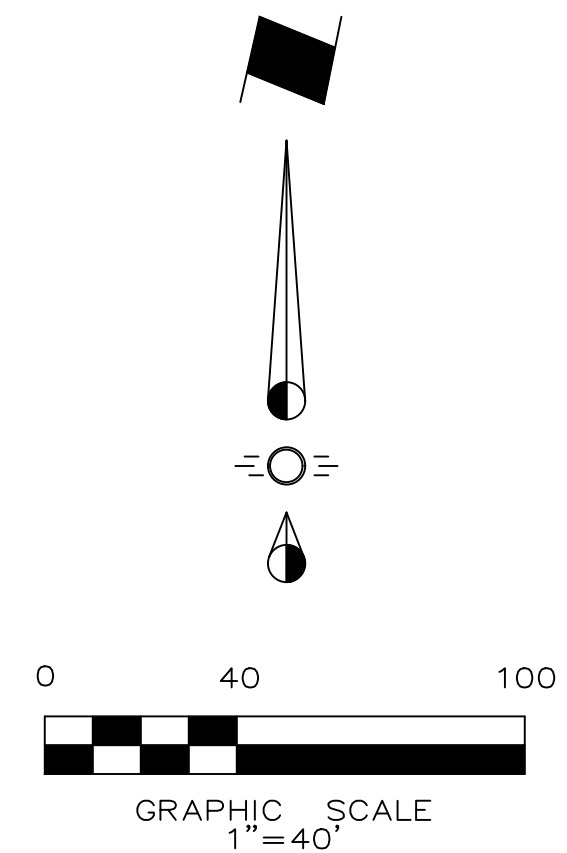

GENERAL NOTES

1. All materials and construction shall be in accordance with the City of Rockwall Standard Specifications and Construction Standards, and Standard Specifications for Public Works Construction prepared by the North Central Texas Council of Governments (5th Edition).
2. Existing utilities are shown schematically and are for the Contractor's guidance only. The location and/or elevation of existing utilities as shown on these plans are based on records of the various utility companies, and, where possible, measurements taken in the field. The Contractor must call the appropriate utility company at least 72 hours prior to any excavation to request exact field location of utilities.
3. Contractor shall be responsible for protecting all existing improvements in the construction of this project. The Contractor is responsible for repairs of damage to any existing improvements during construction. Repairs shall be equal to or better than condition prior to construction. Contractor is responsible to adjust grade of all proposed and existing utilities to final grade.
4. All onsite paving dimensions are to the FACE of curb, where applicable, unless noted otherwise.
5. All curb radii are 3' unless noted otherwise.
6. All parking spaces are 9' x 20', unless noted otherwise.
7. Firelanes shall be striped in accordance with the City of Rockwall Standards.
8. Parking stripes shall be 4" wide, spray applied white vinyl acrylic paint. Paint shall be applied in two coats to a clean, dry surface using template or striping machine.
9. All paving and earthwork operations shall conform to the Geotechnical Report.
10. All concrete pavement shall be sawcut @ 15' OCEW.
11. All mix designs are to be approved by Rockwall staff prior to paving operations.

LEGEND

- 4" 3,000 psi Reinforced Concrete Sidewalk with #3 rebar @ 24" O.C.E.W. (5.5 sack mix)
- Heavy Duty Concrete - Firelane
7" 3,600 psi Reinforced Concrete Pavement with #3 rebar @ 18" O.C.E.W. (6.5 sack mix)
- Light Duty Concrete
6" 3,600 psi Reinforced Concrete Pavement with #3 rebar @ 18" O.C.E.W. (6.5 sack mix)
- AREA OF DEMOLITION, REMOVE ALL CONCRETE, CURB & GUTTER

Subgrade:
6" Lime Stabilized Subgrade
Compacted to 95% Standard Proctor
at ±2% Optimum Moisture Content.


- Existing Fire Hydrant
- Proposed Fire Hydrant
- Barrier Free Ramp
- Property Line
- Proposed Retaining Wall

NOTE: ANY RETAINING WALLS 3' OR TALLER MUST BE SIGNED AND SEALED BY A LICENSED ENGINEER. WALLS MUST BE ROCK OR STONE FACE.

DUST CONTROL:
Description
Dust control includes those measures necessary to prevent wind transport of dust from disturbed soil surfaces onto roadways, drainage ways, and surface waters.
Primary Use
Dust control is applied in areas (including roadways) subject to surface and air movement to dust where on-site and off-site impacts to roadways, drainage ways, or surface waters are likely.
Design Criteria
-Vegetate or mulch areas that will not receive vehicle traffic. In areas where planting, mulching, or paving is impractical, apply gravel or landscaping rock.
-Limit dust generation by clearing only those areas where immediate activity will take place, leaving the remaining area(s) in the original condition, if stable. Maintain the original cover as long as practical.
-Construct natural or artificial windbreaks or windscreens. These may be designed as enclosures for small dust sources.
-Sprinkle the site with water until dampened sufficiently to prevent dust and repeat as needed. Do not apply water in quantities to cause runoff.
-Irrigation water can be used for dust control. Irrigation systems should be installed as a first step on sites where dust control is a concern.

NOTE:
EROSION CONTROL TO BE IN PLACE PRIOR TO DEMOLITION COMMENCING. MAKE EXISTING DRIVEWAY CUTS AND PLACE SILT FENCE ACROSS OPENINGS PRIOR TO INTERIOR DEMOLITION. SEE EROSION CONTROL PLAN FOR EROSION CONTROL PLACEMENT LOCATION.

This Record Drawing is a combination of the sealed engineering contract drawings for this project, modified by revision, change order, field order and information furnished by the contractor. The information shown on the Record Drawings is believed to be accurate based on information furnished by the contractor. The original sealed drawings are on file at the office of:
Cross Engineering Consultants
1720 W. Virginia Street
McKinney, Texas 75069
(972) 562-4409
Record Drawings Prepared On:
12/22/2023

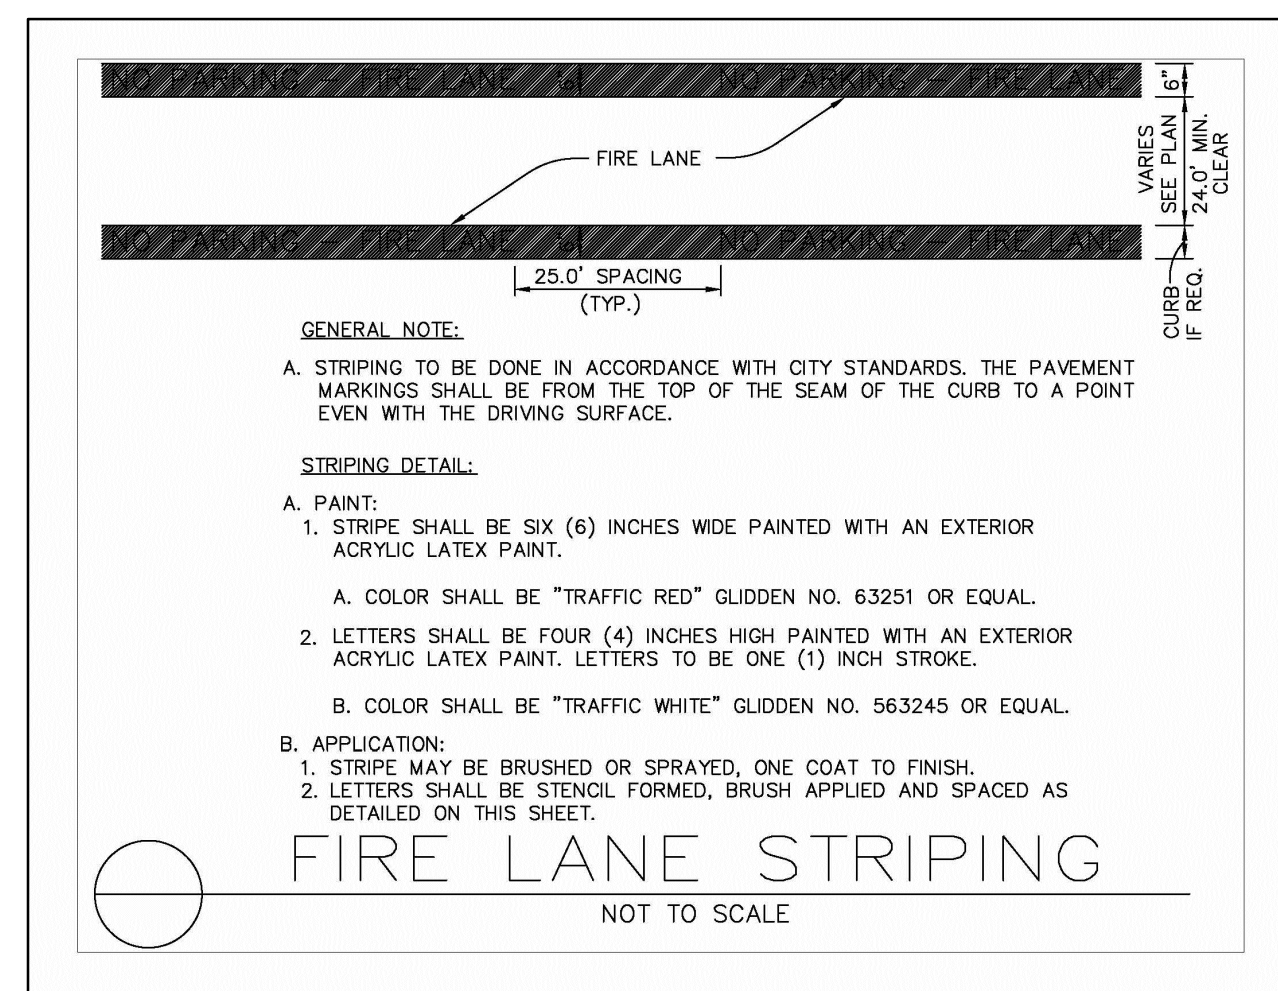

BENCHMARK:

City Benchmark:
COR-7-Aluminum Disk Stamped "City of Rockwall Survey Monument" Located on the south side of Summer Lee Dr. ±275 feet west of intersection of Summer Lee Dr and Ridge Road, ±1 foot south of curb line.
ELEVATION: 567.52

Site Benchmark:
No. 1-"X" Cut on rim of water valve located on the north side of Summer Lee Dr. approx. 915 feet easterly from the intersection of Sunset Ridge Dr.
ELEVATION: 548.55

No. 2-"X" Cut on southeast corner of curb inlet located on the east side of Shoreline Tr. approx. 480 feet northerly from the north side of Summer Lee Dr.
ELEVATION: 474.56

Revised Sidewalk Details

Issue Dates:	Revisions:	Date:
5 11/30/2020	1	05/17/2021
6 12/23/2020	2	01/28/2022
7 01/22/2021	3	02/25/2022
8 01/29/2021	4	10/31/2023
9 04/19/2021	5	
10 12/22/2023	6	

CROSS ENGINEERING CONSULTANTS
1720 W. Virginia Street
972.562.4409
McKinney, Texas 75069
Texas P.E. Firm No. F-9395

Drawn By: C.E.C.I.
Checked By: C.E.C.I.
Scale: 1"=40'

The seal that originally appeared on this document was authorized by T. Zachary Grimes, Texas No. 122013 on 5/17/2021. Alteration of a sealed document without proper notification of the responsible Engineer is an offense under the Texas Engineering Practice Act.

Issued for Construction: 04-19-2021

PAVING PLAN


HARBOR HILL RESIDENCES

SUMMER LEE DRIVE
ROCKWALL, TEXAS



Sheet No.
C1.1

Project No.
18090

HARBOR HILL RESIDENCES - ROCKWALL

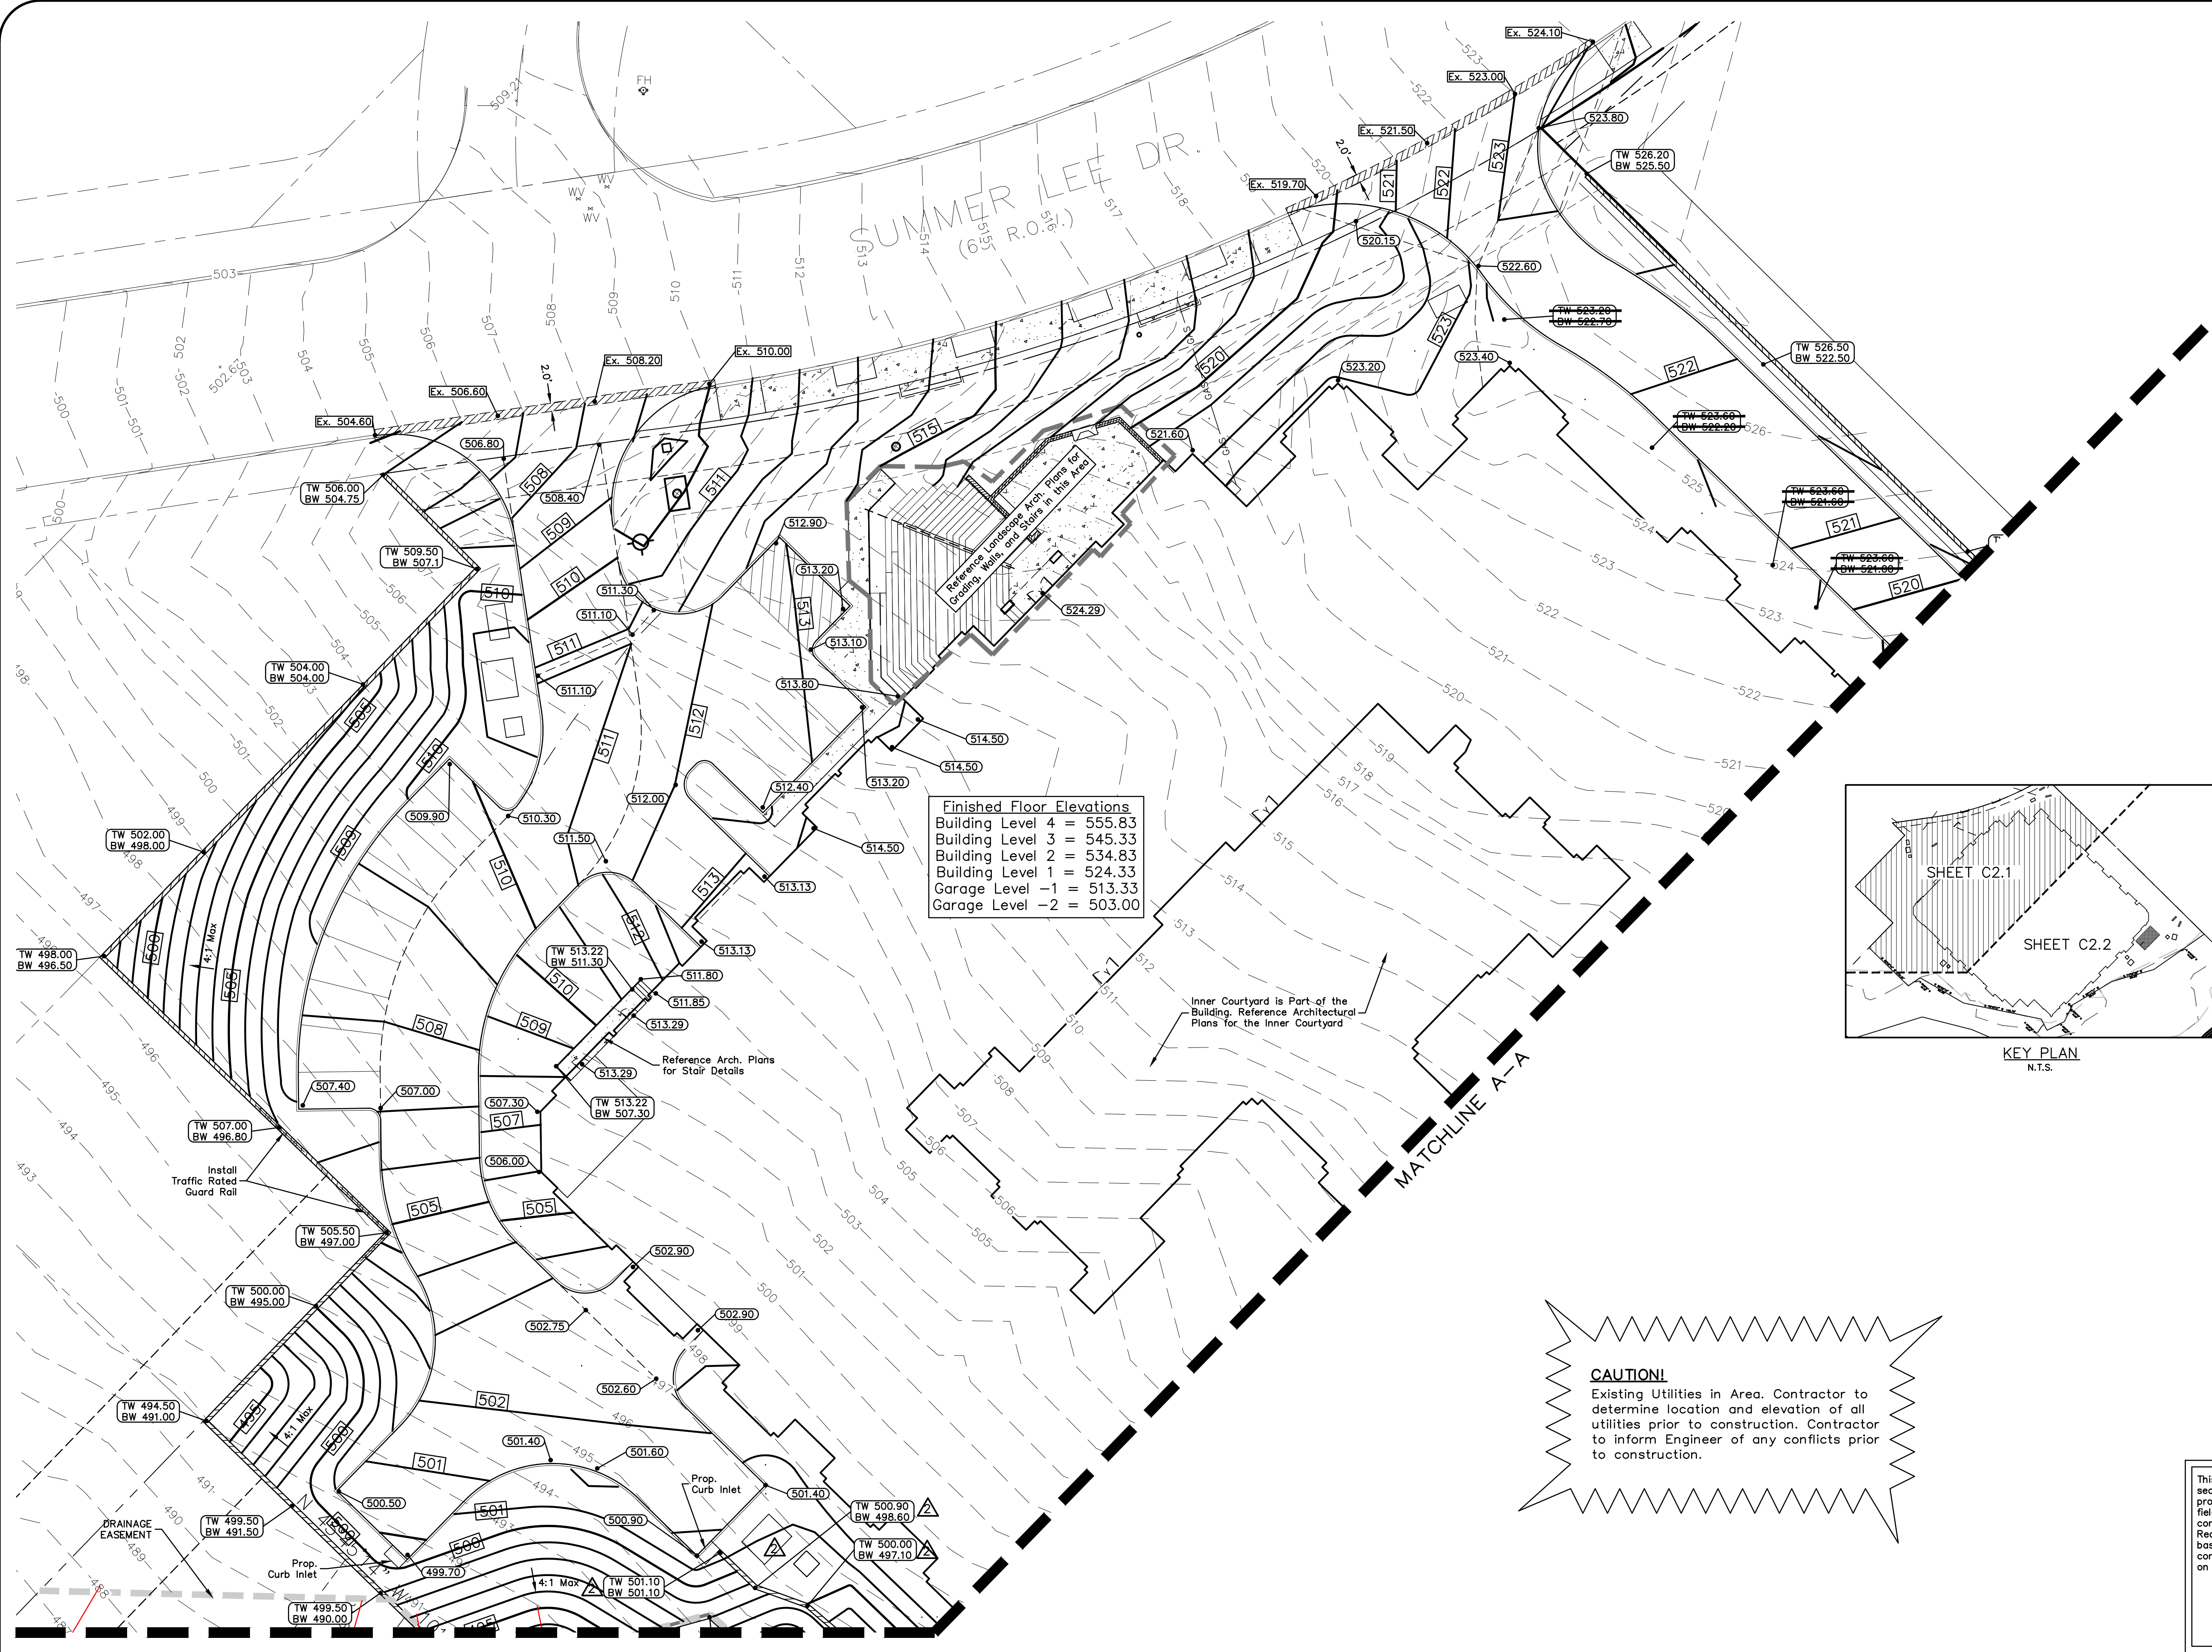

Finished Floor Elevations	
Building Level 4	= 555.83
Building Level 3	= 545.33
Building Level 2	= 534.83
Building Level 1	= 524.33
Garage Level -1	= 513.33
Garage Level -2	= 503.00

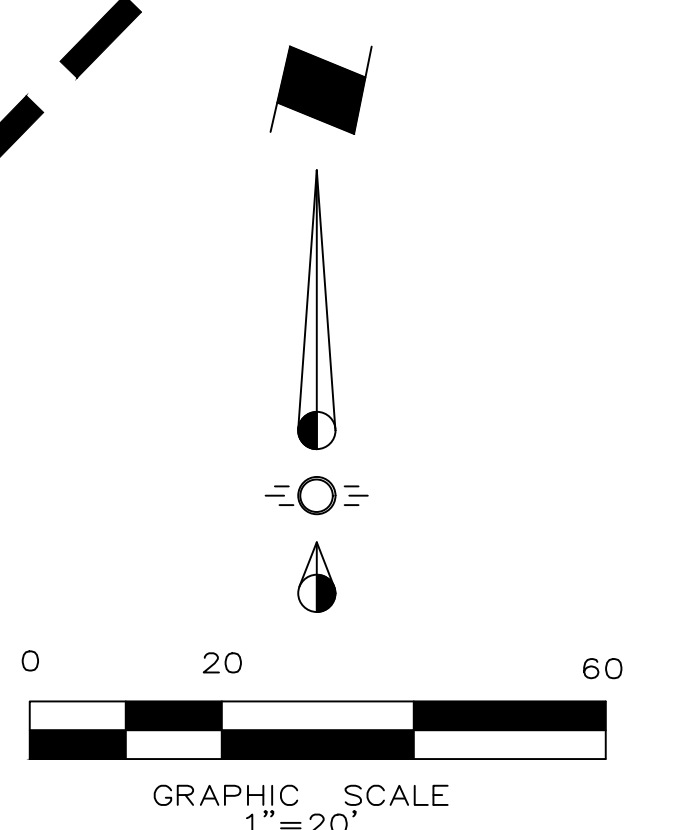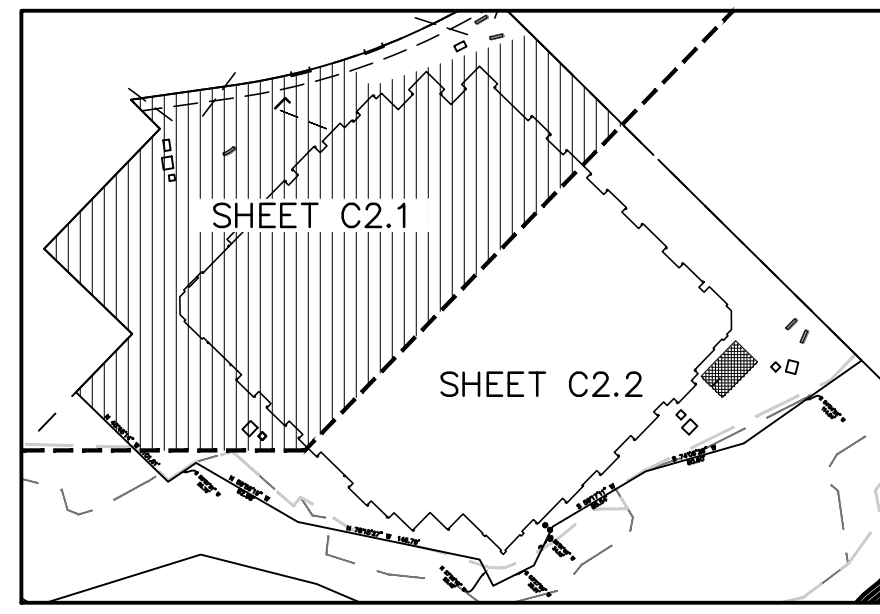

GENERAL/DRAINAGE NOTES

1. All materials and construction shall be in accordance with the City of Rockwall Standard Specifications and Construction Standards, and Standard Specifications for Public Works Construction prepared by North Central Texas Council of Governments (5th Edition).
2. Existing utilities are shown schematically and are for the contractor's guidance only. The location and/or elevation of existing utilities as shown on these plans are based on records of the various utility companies, and, where possible, measurements taken in the field. The contractor must call the appropriate utility company at least 72 hours prior to any excavation to request exact field location of utilities.
3. The contractor shall be responsible for protecting all existing improvements in the construction of this project. The contractor is responsible for repairs of damage to any existing improvements during construction. Repairs shall be equal to or better than condition prior to construction.
4. All storm sewer pipe 18" and larger shall be Class III RCP. All storm sewer pipe 15" and smaller shall be PVC drainage pipe or approved equal (and be private).
5. Contractor shall be responsible for maintaining trench safety requirements in accordance with the latest standards of O.S.H.A. or any other agency having jurisdiction for excavation and trenching procedures. Contractor shall provide and implement a trench safety plan complying with O.S.H.A.
6. All RCP pipe joints shall have Ram-Neck joint sealer, in the absence of a City Standard for joint sealant.
7. All roof drain laterals shall be 0.50% min. slope.
8. All fill to be compacted to 95% standard density using a sheep's foot roller.
9. No portion of the wall including footing or tie backs to be offsite or in any easement. All walls to be rock or stone or smooth concrete.
10. Contractor is responsible for adjusting all utilities and drainage to final grade.
11. All retaining walls to be rock or stone compatible design to the building and PD-32 design standards.
12. Maximum ground slope is 4:1 without a retaining wall.

LEGEND

- Proposed Spot Elevation
- Existing Spot Elevation
- Proposed Contour
- Existing Contour
- Valley
- Highpoint
- Property Line
- Proposed Retaining Wall

CAUTION!
Existing Utilities in Area. Contractor to determine location and elevation of all utilities prior to construction. Contractor to inform Engineer of any conflicts prior to construction.

This Record Drawing is a combination of the sealed engineering contract drawings for this project, modified by revision, change order, field order and information furnished by the contractor. The information shown on the Record Drawings is believed to be accurate based on information furnished by the contractor. The original sealed drawings are on file at the office of:
 Cross Engineering Consultants
 1720 W. Virginia Street
 McKinney, Texas 75069
 (972) 562-4409
 Record Drawings Prepared On:
 12/22/2023

STOP!
CALL BEFORE YOU DIG



(@ least 72 hours prior to digging)

Revised Grading & Added Wall		
Issue Dates:	Revisions:	Date:
5	11/30/2020	1 05/17/2021
6	12/23/2020	2 01/28/2022
7	01/22/2021	3 02/25/2022
8	01/29/2021	4 10/31/2023
9	04/19/2021	5
10	12/22/2023	6

CROSS ENGINEERING CONSULTANTS
 1720 W. Virginia Street McKinney, Texas 75069
 972.562.4409 Texas P.E. Firm No. F-5935

Drawn By: C.E.C.I. Checked By: C.E.C.I. Scale: 1"=20'

The seal that originally appeared on this document was authorized by T. Zachary Grimes, Texas No. 122013 on 1/28/2022. Alteration of a sealed document without proper notification of the responsible Engineer is an offense under the Texas Engineering Practice Act.

Issued for Construction: 04-19-2021


GRADING PLAN

HARBOR HILL RESIDENCES

SUMMER LEE DRIVE
ROCKWALL, TEXAS


Sheet No. **C2.1**
Project No. 18090

HARBOR HILL RESIDENCES - ROCKWALL

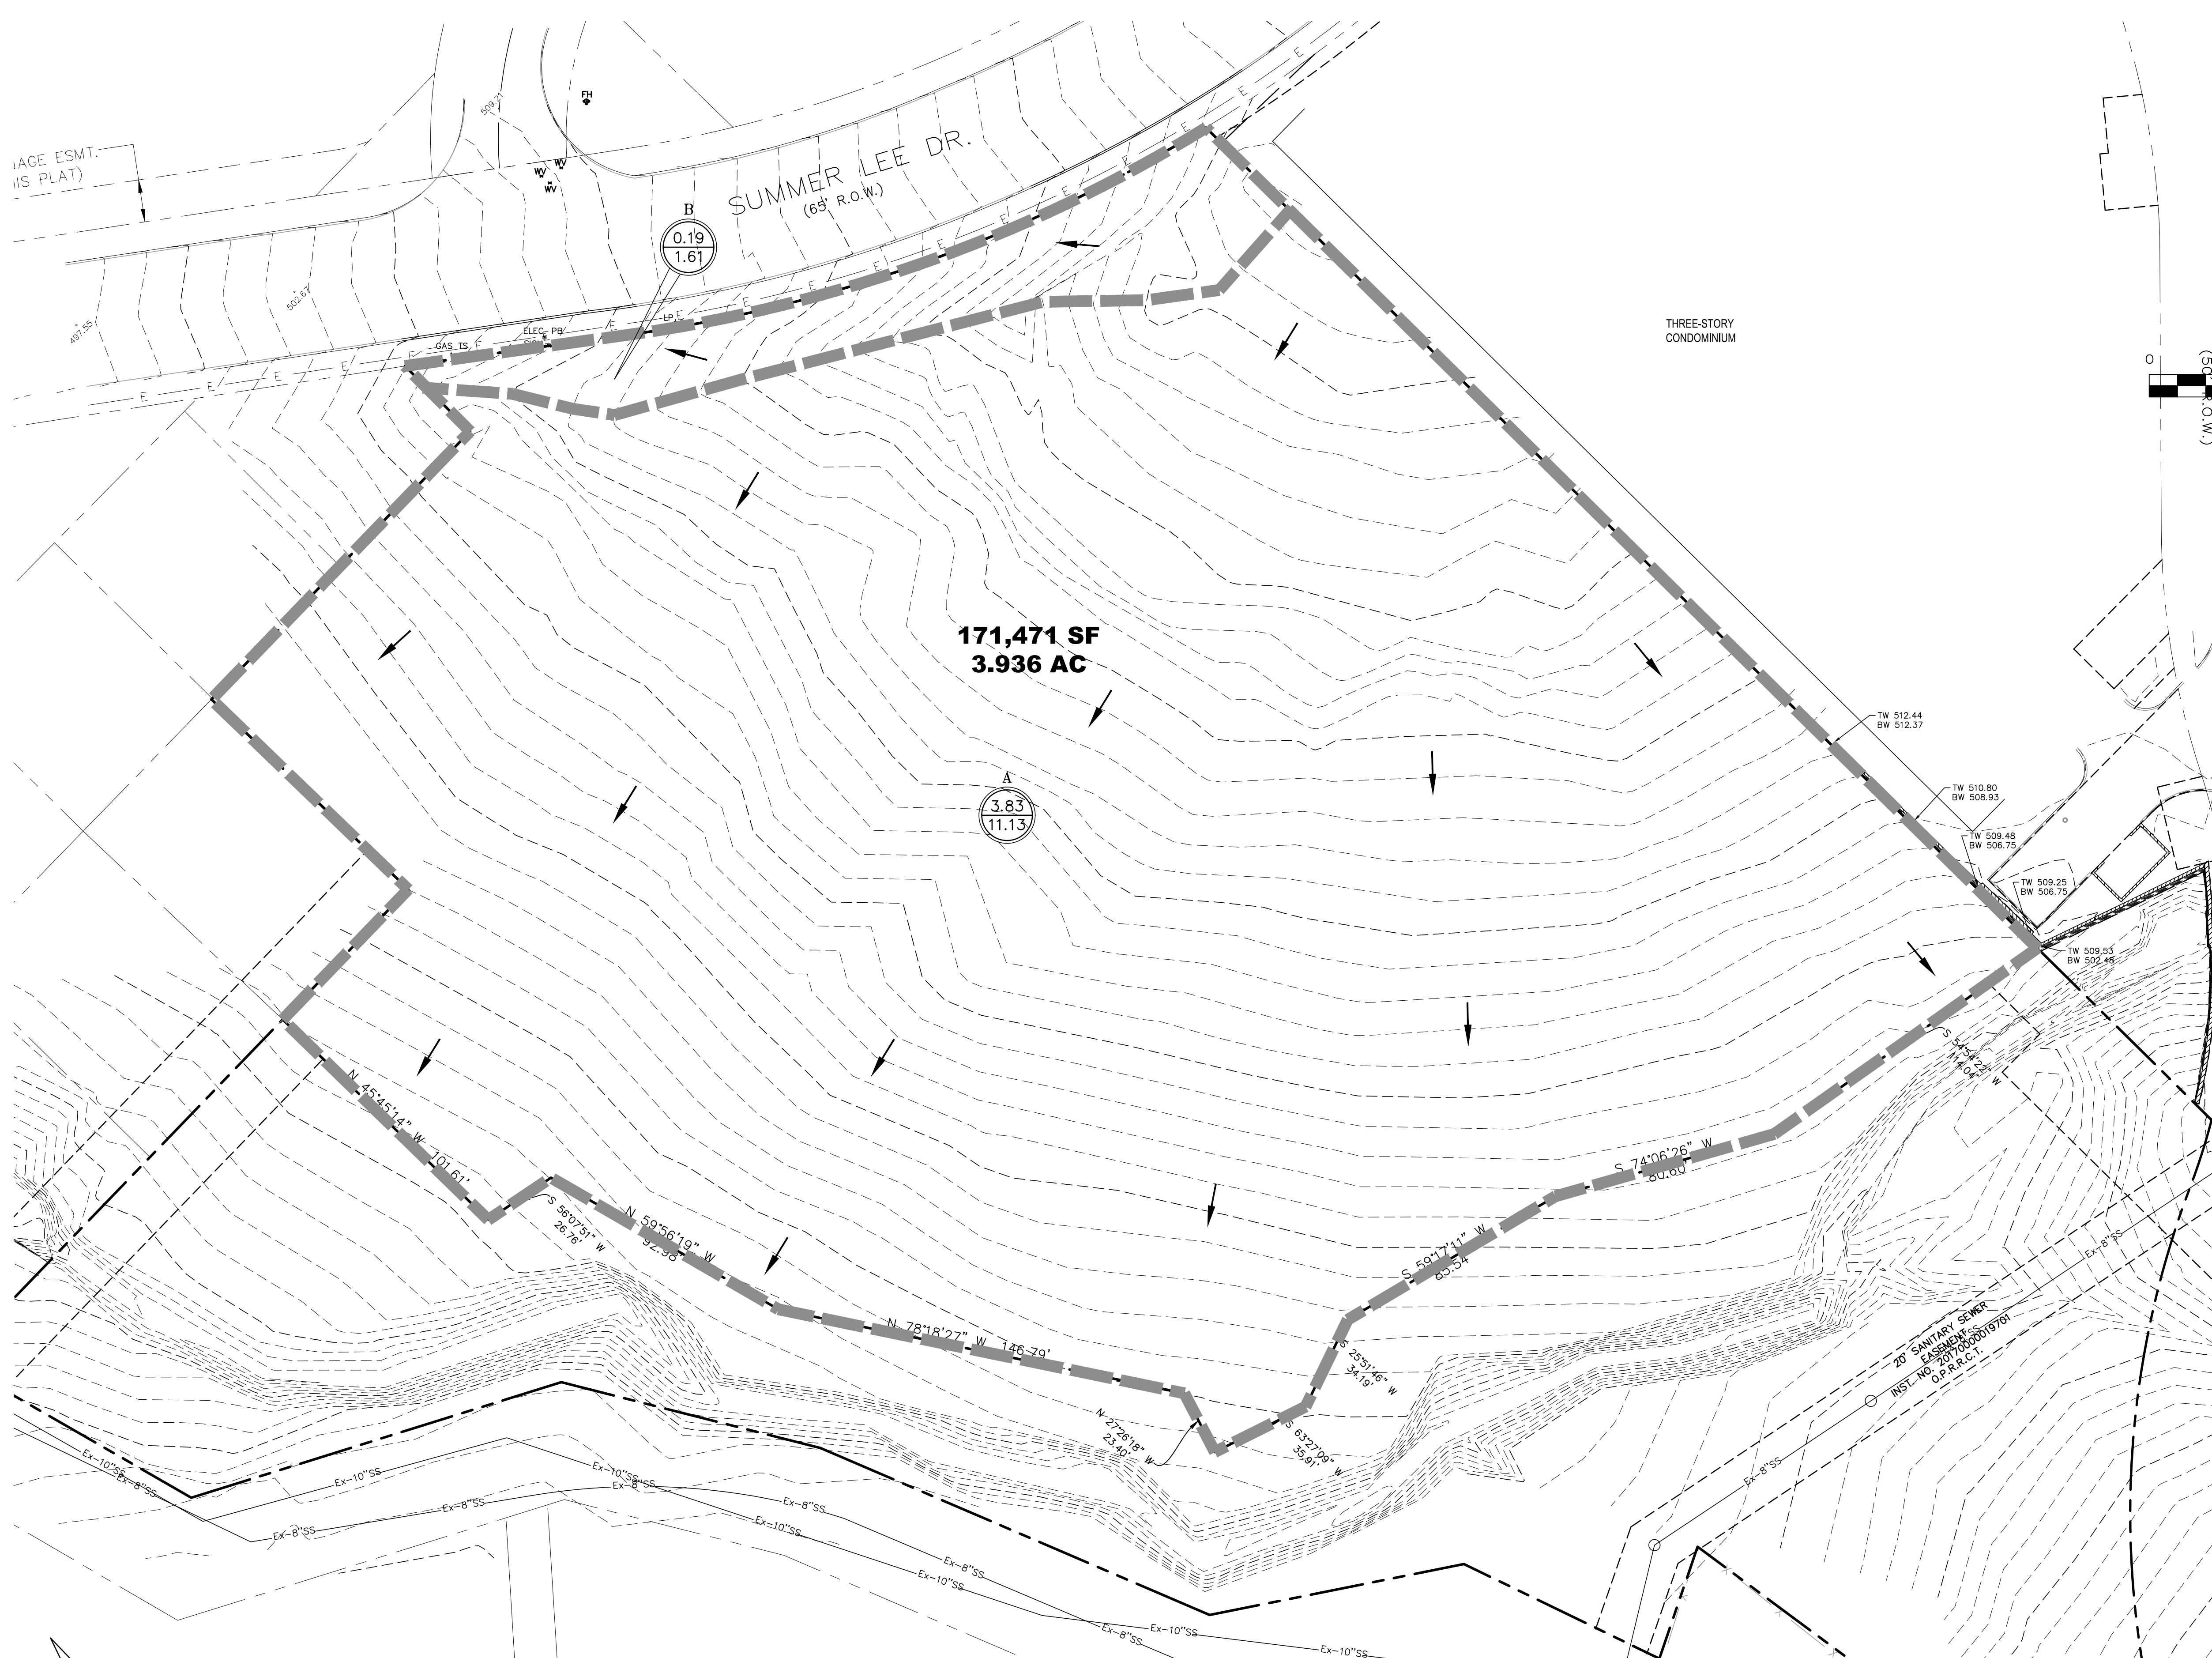

GENERAL/DRAINAGE NOTES

1. All materials and construction shall be in accordance with the City of Rockwall Standard Specifications and Construction Standards, and Standard Specifications for Public Works Construction prepared by North Central Texas Council of Governments (5th Edition).
2. Existing utilities are shown schematically and are for the contractor's guidance only. The location and/or elevation of existing utilities as shown on these plans are based on records of the various utility companies, and, where possible, measurements taken in the field. The contractor must call the appropriate utility company at least 72 hours prior to any excavation to request exact field location of utilities.
3. The contractor shall be responsible for protecting all existing improvements in the construction of this project. The contractor is responsible for repairs of damage to any existing improvements during construction. Repairs shall be equal to or better than condition prior to construction.
4. All storm sewer pipe 18" and larger shall be Class III RCP. All storm sewer pipe 15" and smaller shall be PVC drainage pipe or approved equal (and be private).
5. Contractor shall be responsible for maintaining trench safety requirements in accordance with the latest standards of O.S.H.A. or any other agency having jurisdiction for excavation and trenching procedures. Contractor shall provide and implement a trench safety plan complying with O.S.H.A.
6. All RCP pipe joints shall have Ram-Neck joint sealer, in the absence of a City Standard for joint sealant.
7. All roof drain laterals shall be 0.50% min. slope.

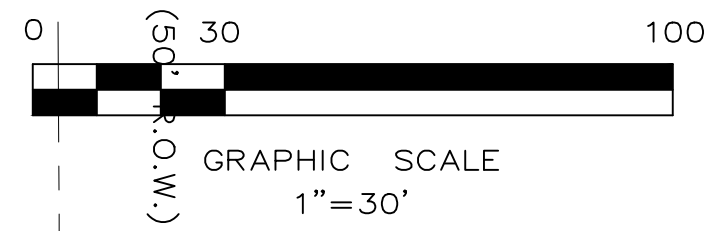

Drainage Area No.	Drainage Area (Acres)	Time of Concentration (minutes)	K_{100} Coefficient	Runoff Coefficient C	100-Year Event I_{100} (in/hr)	100-Year Event Q_{100} (cfs)	Remarks
A	3.83	20	1.00	0.35	8.30	11.13	Drains to Creek
B	0.19	20	1.00	0.35	8.30	1.61	Drains to Summer Lee

DRAINAGE LEGEND

- A Drainage Area Number
- X.XX Acres
- X.XX Q_{100}
- Drainage Divide Line
- Direction of Flow

DRAINAGE CRITERIA

- Q = C I A
- C = 0.70
- I_{100} = 9.80
- tc = 10 min.

This Record Drawing is a combination of the sealed engineering contract drawings for this project, modified by revision, change order, field order and information furnished by the contractor. The information shown on the Record Drawings is believed to be accurate based on information furnished by the contractor. The original sealed drawings are on file at the office of:
 Cross Engineering Consultants
 1720 W. Virginia Street
 McKinney, Texas 75069
 (972) 562-4409
 Record Drawings Prepared On:
 12/22/2023

STOP!
CALL BEFORE YOU DIG



(@ least 72 hours prior to digging)

Issued for Construction: 04-19-2021

CAUTION!
 Existing Utilities in Area. Contractor to determine location and elevation of all utilities prior to construction. Contractor to inform Engineer of any conflicts prior to construction.

BENCHMARK:
 City Benchmark: COR-7-Aluminum Disk Stamped "City of Rockwall Survey Monument" Located on the south side of Summer Lee Dr. ±275 feet west of intersection of Summer Lee Dr. and Ridge Road, ±1 foot south of curb line. ELEVATION: 567.52
 Site Benchmark: No. 1-"X" Cut on rim of water valve located on the north side of Summer Lee Dr. approx. 915 feet easterly from the intersection of Sunset Ridge Dr. ELEVATION: 548.55
 No. 2-"X" Cut on southeast corner of curb inlet located on the east side of Shoreline Tr. approx. 480 feet northerly from the north side of Summer Lee Dr. ELEVATION: 474.56

Issue Dates:	Revisions:	Date:
5	11/30/2020	1 05/17/2021
6	12/23/2020	2 01/28/2022
7	01/22/2021	3 02/25/2022
8	01/29/2021	4 10/31/2023
9	04/19/2021	5
10	12/22/2023	6

CROSS ENGINEERING CONSULTANTS
 1720 W. Virginia Street McKinney, Texas 75069 972.562.4409 Texas P.E. Firm No. F-5935


Drawn By: C.E.C.I. Checked By: C.E.C.I. Scale: 1"=30'

The seal that originally appeared on this document was authorized by T. Zachary Grimes, Texas No. 122013 on 4/19/2021. Alteration of a sealed document without proper notification of the responsible Engineer is an offense under the Texas Engineering Practice Act.

EXISTING DRAINAGE AREA
HARBOR HILL RESIDENCES
 SUMMER LEE DRIVE
 ROCKWALL, TEXAS


Sheet No. **C3.1**
 Project No. 18090

HARBOR HILL RESIDENCES - ROCKWALL

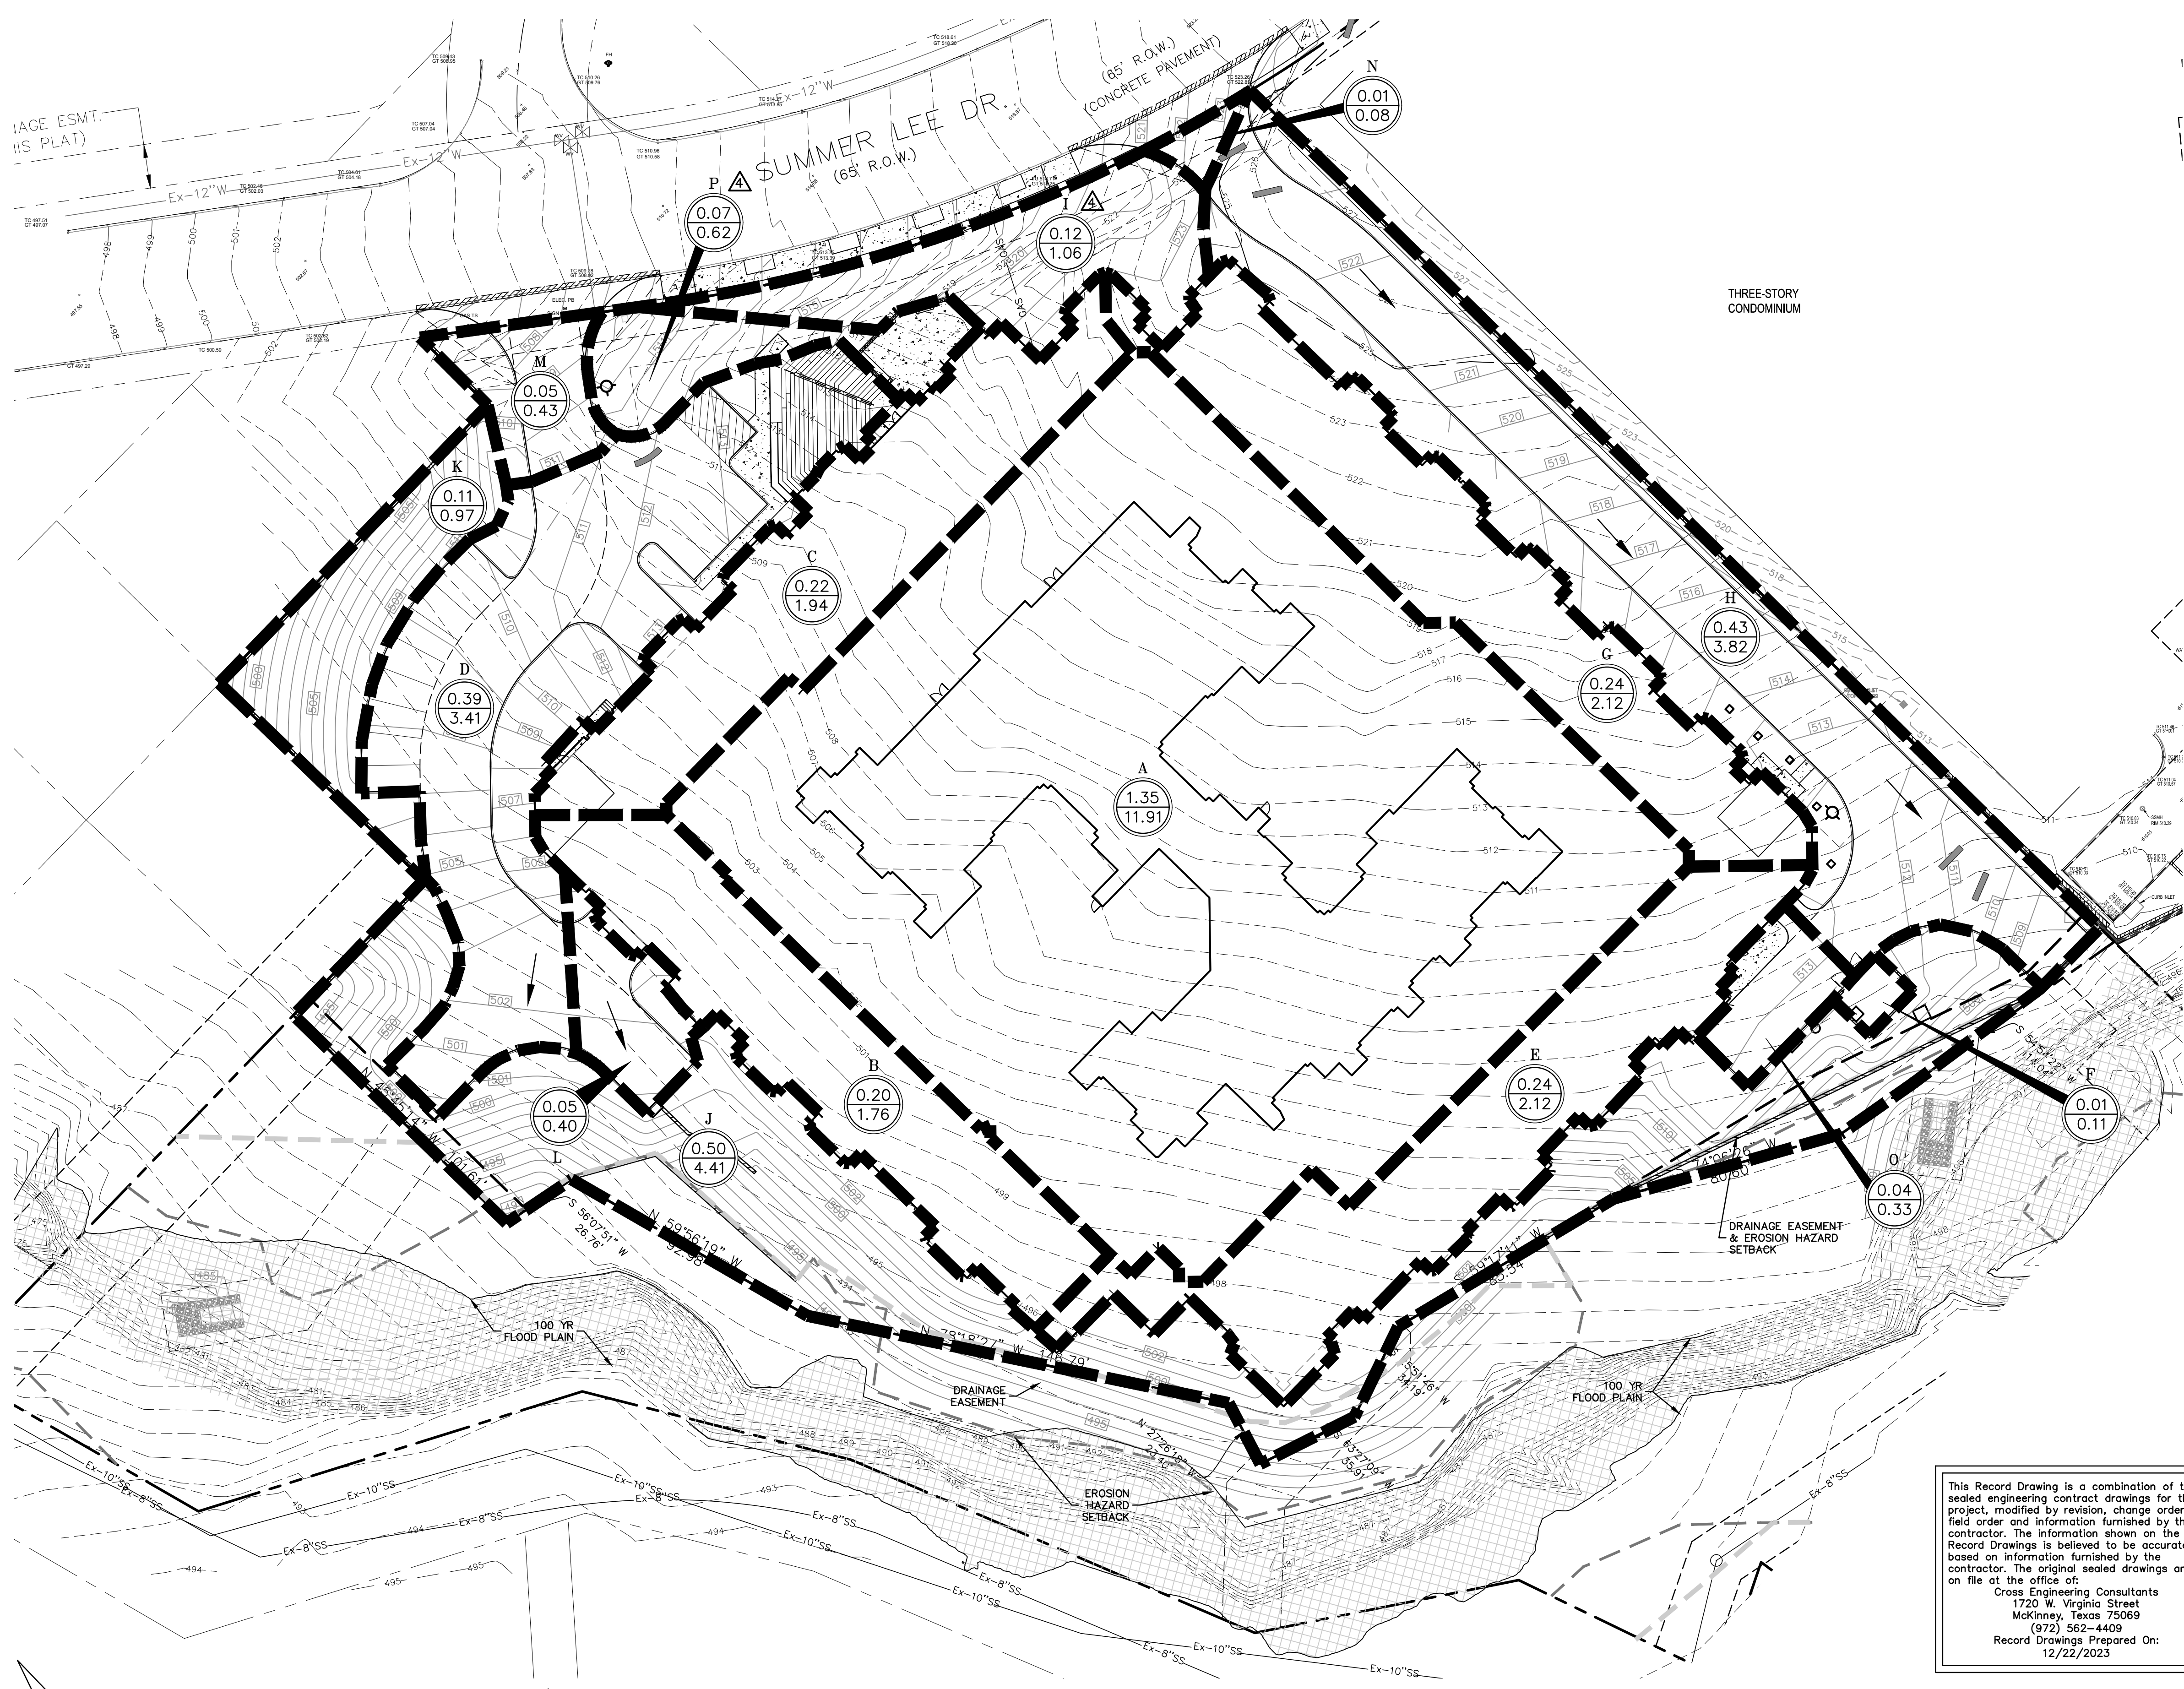

GENERAL / DRAINAGE NOTES

1. All materials and construction shall be in accordance with the City of Rockwall Standard Specifications and Construction Standards, and Standard Specifications for Public Works Construction prepared by North Central Texas Council of Governments (5th Edition).
2. Existing utilities are shown schematically and are for the contractor's guidance only. The location and/or elevation of existing utilities as shown on these plans are based on records of the various utility companies, and, where possible, measurements taken in the field. The contractor must call the appropriate utility company at least 72 hours prior to any excavation to request exact field location of utilities.
3. The contractor shall be responsible for protecting all existing improvements in the construction of this project. The contractor is responsible for repairs of damage to any existing improvements during construction. Repairs shall be equal to or better than condition prior to construction.
4. All storm sewer pipe 18" and larger shall be Class III RCP. All storm sewer pipe 15" and smaller shall be PVC drainage pipe or approved equal (and be private).
5. Contractor shall be responsible for maintaining trench safety requirements in accordance with the latest standards of O.S.H.A. or any other agency having jurisdiction for excavation and trenching procedures. Contractor shall provide and implement a trench safety plan complying with O.S.H.A.
6. All RCP pipe joints shall have Ram-Neck joint sealer, in the absence of a City Standard for joint sealant.
7. All roof drain laterals shall be 0.50% min. slope.

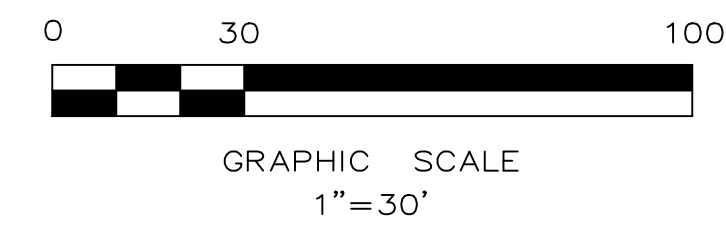

▲ Drainage Area Runoff Calculations

Drainage Area No.	Drainage Area (Acres)	Time of Concentration (minutes)	K ₁₀₀ Coefficient	Runoff C	100-Year Event		Remarks
					I ₁₀₀ (in/hr)	Q ₁₀₀ (cfs)	
A	1.35	10	1.00	0.90	9.80	11.91	Courtyard & Roof Drainage
B	0.20	10	1.00	0.90	9.80	1.76	Roof Drains
C	0.22	10	1.00	0.90	9.80	1.94	Roof Drains
D	0.39	10	1.00	0.90	9.80	3.41	5' Curb Inlet
E	0.24	10	1.00	0.90	9.80	2.12	Roof Drains
F	0.01	10	1.00	0.90	9.80	0.11	Drains to 5' Inlet & Contech CDS1515-3-C separator
G	0.24	10	1.00	0.90	9.80	2.12	Roof Drains
H	0.43	10	1.00	0.90	9.80	3.82	5' Curb Inlet
I	0.19	10	1.00	0.90	9.80	1.68	Landscape Drains
J	0.50	10	1.00	0.90	9.80	4.41	Sheet Flow to Creek
K	0.11	10	1.00	0.90	9.80	0.97	Sheet Flow to the West
L	0.05	10	1.00	0.90	9.80	0.40	5' Curb Inlet
M	0.05	10	1.00	0.90	9.80	0.43	Sheet Flow to Summer Lee Drive
N	0.01	10	1.00	0.90	9.80	0.08	Sheet Flow to Summer Lee Drive
O	0.04	10	1.00	0.90	9.80	0.33	5' Curb Inlet

Post-Project Flow to Summer Lee Drive from Drainage Areas I, M, & N (1.06+0.43+0.08 = 1.57cfs) is lower than Pre-Project flow to Summer Lee Drive (1.68 cfs).

Curb Inlet Calculations

Drainage Area No.	Drainage Area (Acres)	Time of Concentration (minutes)	Runoff Coefficient	100-Year Event I ₁₀₀ (in/hr)	100-Year Event Q ₁₀₀ (cfs)	Inlet Length (ft)	Inlet Type	On-Grad/Sag	Inlet Capacity* cfs
D	0.39	10	0.90	9.80	3.41	5.00	Curb	Sag	6.99
F	0.01	10	0.90	9.80	0.11	5.00	Curb	Sag	6.99
H	0.47	10	0.90	9.80	4.15	5.00	Curb	Sag	6.99
L	0.05	10	0.90	9.80	0.40	5.00	Curb	Sag	6.99
O	0.04	10	0.90	9.80	0.33	5.00	Curb	Sag	6.99

*Capacities per Figure 3.10: Standard Curb Inlet Capacity Sag/Low Point from City of Rockwall Standards of Design & Construction & assuming a depth of 0.5 feet.

DRAINAGE LEGEND

- ▲ Drainage Area Number
- (X.XX) Acres
- (X.XX) Q₁₀₀
- Drainage Divide Line
- Direction of Flow

DRAINAGE CRITERIA

- Q = CIA
- C = 0.90
- I₁₀₀ = 9.80
- tc = 10 min.

This Record Drawing is a combination of the sealed engineering contract drawings for this project, modified by revision, change order, field order and information furnished by the contractor. The information shown on the Record Drawings is believed to be accurate based on information furnished by the contractor. The original sealed drawings are on file at the office of:
 Cross Engineering Consultants
 1720 W. Virginia Street
 McKinney, Texas 75069
 (972) 562-4409
 Record Drawings Prepared On: 12/22/2023

CAUTION!
 Existing Utilities in Area. Contractor to determine location and elevation of all utilities prior to construction. Contractor to inform Engineer of any conflicts prior to construction.

BENCHMARK:
 City Benchmark: COR-7-Aluminum Disk Stamped "City of Rockwall Survey Monument" Located on the south side of Summer Lee Dr. ±275 feet west of intersection of Summer Lee Dr and Ridge Road, ±1 foot south of curb line. ELEVATION: 567.52
 Site Benchmark: No. 1-"X" Out on rim of water valve located on the north side of Summer Lee Dr. approx. 915 feet easterly from the intersection of Sunset Ridge Dr. ELEVATION: 548.55
 No. 2-"X" Cut on southeast corner of curb inlet located on the east side of Shoreline Tr. approx. 480 feet northerly from the north side of Summer Lee Dr. ELEVATION: 474.56

▲ Updated Drainage Area I based on adjusted grading per site visit observations.

Issue Dates:	Revisions:	Date:	
5	11/30/2020	1	05/17/2021
6	12/23/2020	2	01/28/2022
7	01/22/2021	3	02/25/2022
8	01/29/2021	4	10/31/2023
9	04/19/2021	5	
10	12/22/2023	6	

CROSS ENGINEERING CONSULTANTS
 1720 W. Virginia Street
 McKinney, Texas 75069
 972.562.4409
 Texas P.E. Firm No. F-5935

Drawn By: C.E.C.I. Checked By: C.E.C.I. Scale: 1"=30'

The seal that originally appeared on this document was authorized by T. Zachary Grimes, Texas No. 122013 on 10/31/2023. Alteration of a sealed document without proper notification of the responsible Engineer is an offense under the Texas Engineering Practice Act.

DRAINAGE AREA MAP
HARBOR HILL RESIDENCES
 SUMMER LEE DRIVE
 ROCKWALL, TEXAS

Sheet No. **C3.2**
 Project No. 18090

STOP!
CALL BEFORE YOU DIG




(@ least 72 hours prior to digging)


HARBOR HILL RESIDENCES - ROCKWALL

GENERAL / DRAINAGE NOTES

1. All materials and construction shall be in accordance with the City of Rockwall Standard Specifications and Construction Standards, and Standard Specifications for Public Works Construction prepared by North Central Texas Council of Governments (5th Edition).
2. Existing utilities are shown schematically and are for the contractor's guidance only. The location and/or elevation of existing utilities as shown on these plans are based on records of the various utility companies, and, where possible, measurements taken in the field. The contractor must call the appropriate utility company at least 72 hours prior to any excavation to request exact field location of utilities.
3. The contractor shall be responsible for protecting all existing improvements in the construction of this project. The contractor is responsible for repairs of damage to any existing improvements during construction. Repairs shall be equal to or better than condition prior to construction.
4. All storm sewer pipe 18" and larger shall be Class III RCP. All storm sewer pipe 15" and smaller shall be private PVC drainage pipe or approved equal (and be private).
5. Contractor shall be responsible for maintaining trench safety requirements in accordance with the latest standards of O.S.H.A. or any other agency having jurisdiction for excavation and trenching procedures. Contractor shall provide and implement a trench safety plan complying with O.S.H.A.
6. All RCP pipe joints shall have Ram-Neck joint sealer, in the absence of a City Standard for joint sealer.
7. All roof drain laterals shall be 0.50% min. slope.
8. All landscape inlets in areas in or near mulched areas shall use 12 inch nyooplast domes. All landscape inlets in grassed areas shall be nyooplast 15 inch drop in grates.

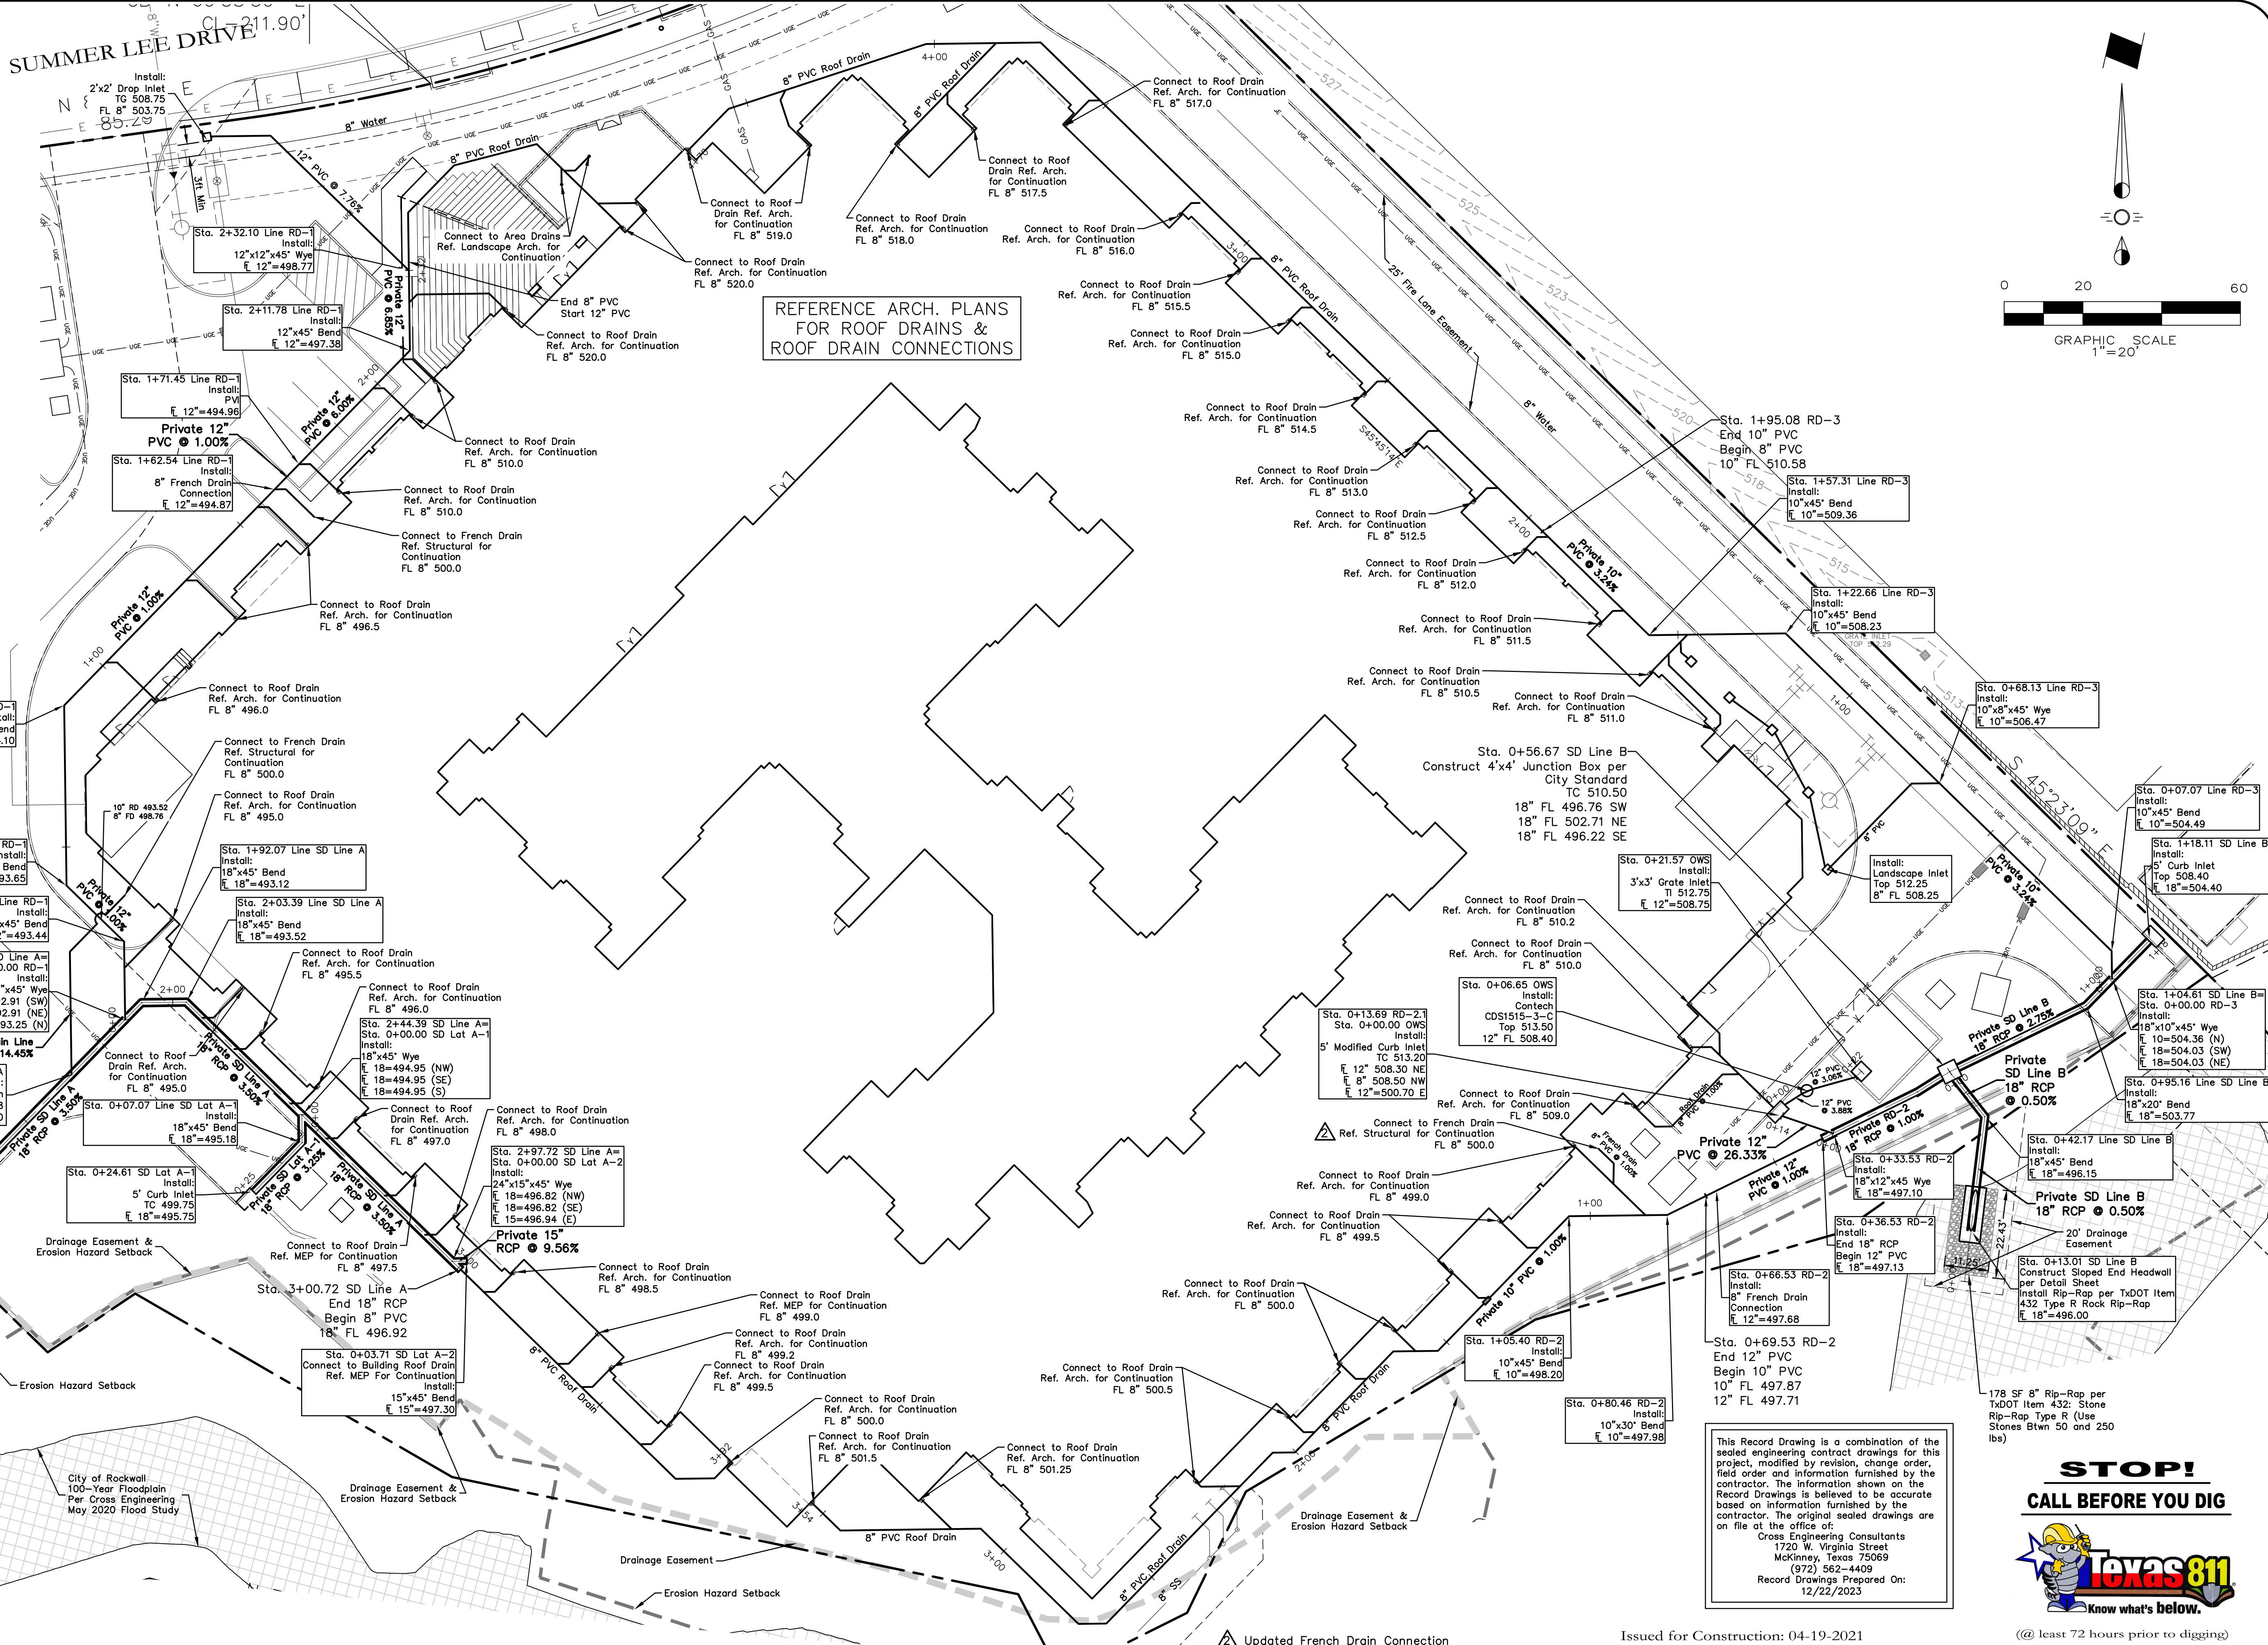

REFERENCE ARCH. PLANS FOR ROOF DRAINS & ROOF DRAIN CONNECTIONS

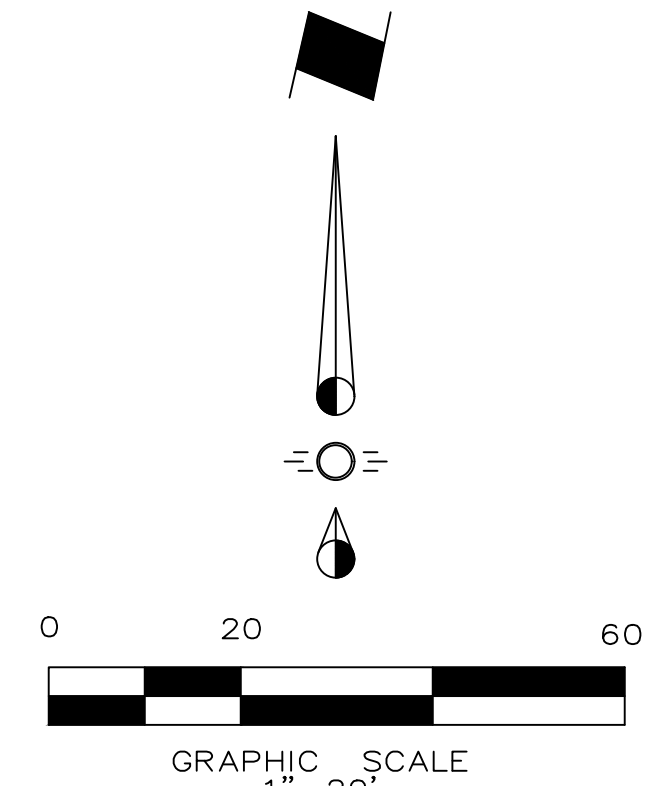

BENCHMARK:

City Benchmark:
COR-7—Aluminum Disk Stamped "City of Rockwall Survey Monument" Located on the south side of Summer Lee Dr. ±275 feet west of intersection of Summer Lee Dr and Ridge Road, ±1 foot south of curb line.
ELEVATION: 567.52

Site Benchmark:
No. 1—"X" Cut on rim of water valve located on the north side of Summer Lee Dr. approx. 915 feet easterly from the intersection of Sunset Ridge Dr. ELEVATION: 548.55
No. 2—"X" Cut on southeast corner of curb inlet located on the east side of Shoreline Tr. approx. 480 feet northerly from the north side of Summer Lee Dr. ELEVATION: 474.56

Issue Dates:	Revisions:	Date:
5 11/30/2020	1	05/17/2021
6 12/23/2020	2	01/28/2022
7 01/22/2021	3	02/25/2022
8 01/29/2021	4	10/31/2023
9 04/19/2021	5	
10 12/22/2023	6	

CROSS ENGINEERING CONSULTANTS
1720 W. Virginia Street
972.562.4409
McKinney, Texas 75069
Texas P.E. Firm No. F-5935

Drawn By: C.E.C.I.
Checked By: C.E.C.I.
Scale: 1"=20'

The seal that originally appeared on this document was authorized by T. Zachary Grimes, Texas No. 122013 on 1/28/2022. Alteration of a sealed document without proper notification of the responsible Engineer is an offense under the Texas Engineering Practice Act.

STOP! CALL BEFORE YOU DIG




This Record Drawing is a combination of the sealed engineering contract drawings for this project, modified by revision, change order, field order and information furnished by the contractor. The information shown on the Record Drawings is believed to be accurate based on information furnished by the contractor. The original sealed drawings are on file at the office of:
Cross Engineering Consultants
1720 W. Virginia Street
McKinney, Texas 75069
(972) 562-4409
Record Drawings Prepared On: 12/22/2023

STORM SEWER PLAN
HARBOR HILL RESIDENCES
SUMMER LEE DRIVE
ROCKWALL, TEXAS

Sheet No. **C4.1**
Project No. 18090



HARBOR HILL RESIDENCES - ROCKWALL

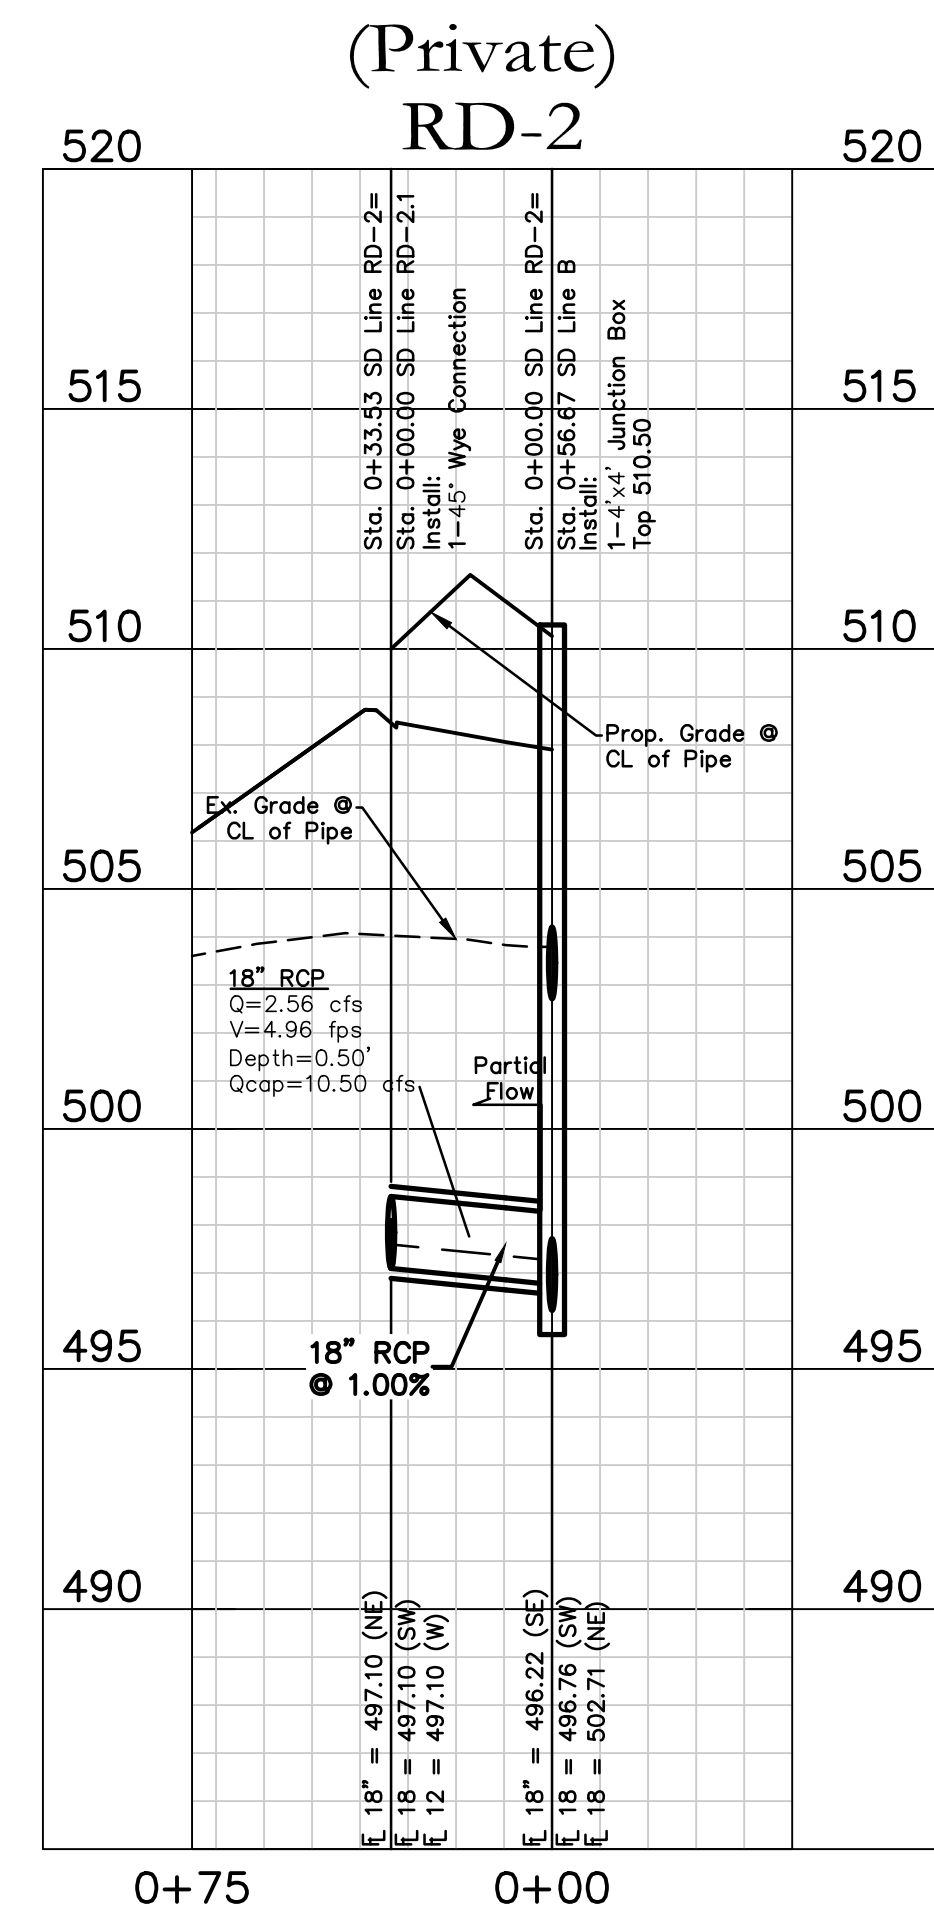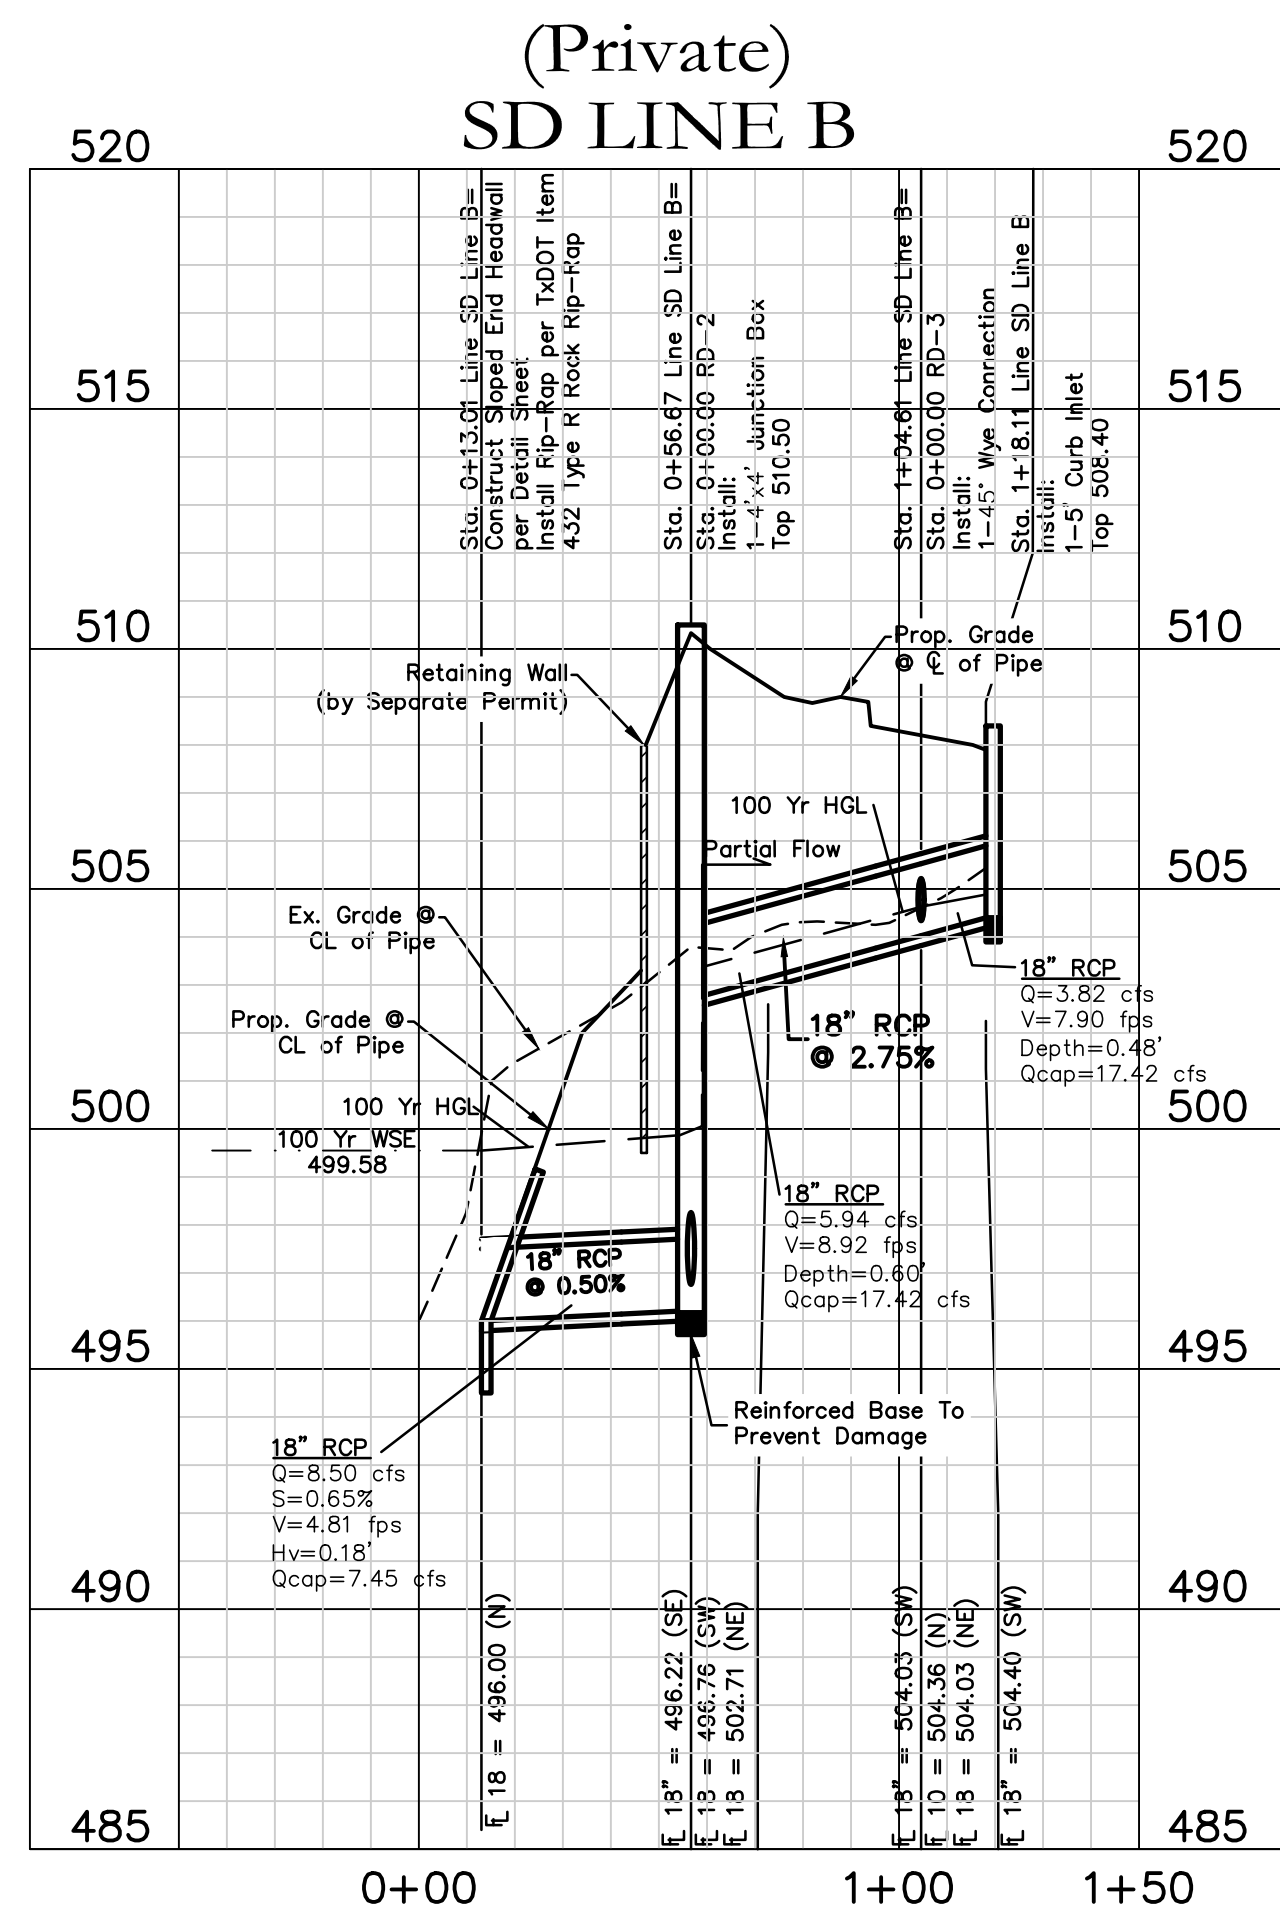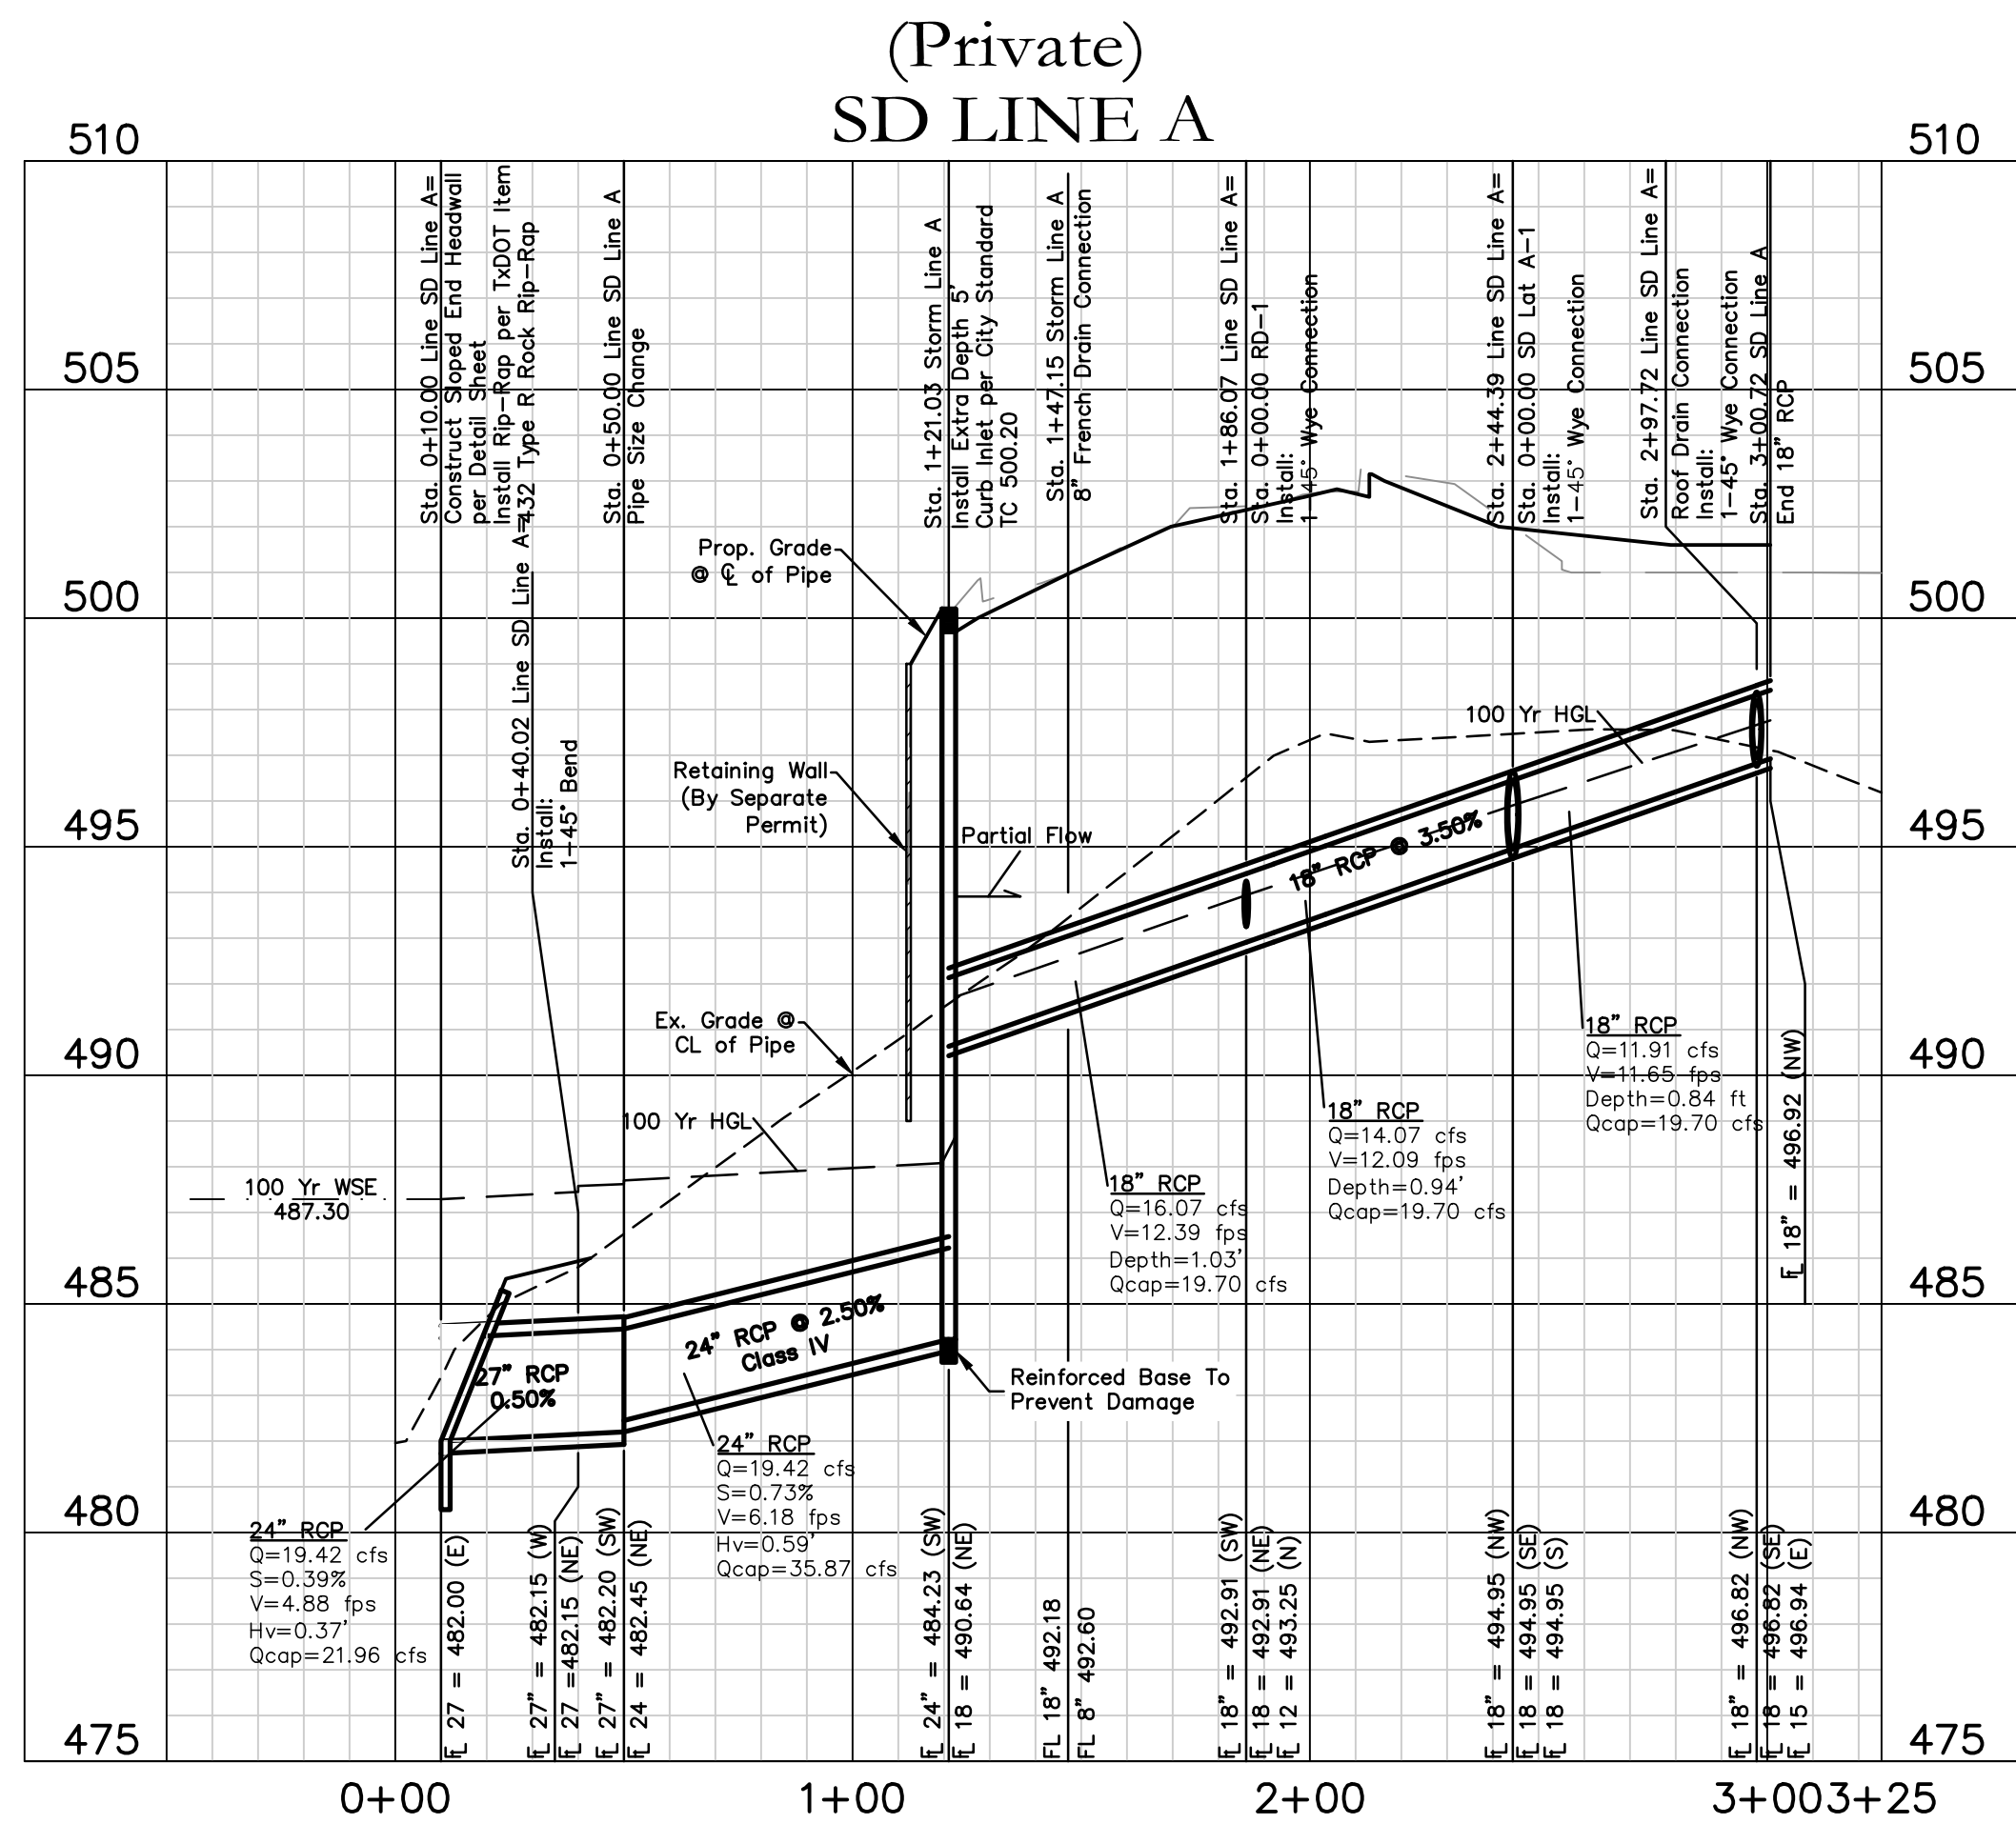

System	ID	DS Sta	US Sta	Length	Pipe Diameter	Area	Wetted Perimeter	Hydraulic Radius	Manning's n	DS Flowline	US Flowline	Slope	Drainage Areas	Runoff Coeff C	Area	CA	CA	CA	Tc	Rainfall Intensity	Q 100	Q Capacity	Partial Flow	Velocity	Friction Slope	Friction Loss	Hv	K	Head Loss	HGL DS	HGL US	Top of Curb	
A	121.03	121.03	-	-	-	-	-	-	-	-	-	-	A,B,C,D,L	0.90	2.21	1.98	1.98	10.00	9.80	19.42	-	Yes	-	-	-	-	-	-	-	-	-	488.78	500.20
O	50.00	121.03	71.03	24	3.14	6.28	0.5	0.013	482.45	484.23	0.025	-	0.90	0	0	1.98	10.00	9.80	19.42	35.87	No	6.18	0.0073	0.52	0.59	1.00	0.59	487.67	488.19	-			
A	40.02	50.00	9.98	27	3.98	7.07	0.5625	0.013	482.15	482.2	0.005	-	0.90	0	0	1.98	10.00	9.80	19.42	21.96	No	4.88	0.0039	0.04	0.37	0.21	0.08	487.55	487.59	-			
A	10.00	40.02	30.02	27	3.98	7.07	0.5625	0.013	482.15	482.15	0.005	-	0.90	0	0	1.98	10.00	9.80	19.42	21.96	No	4.88	0.0039	0.12	0.37	0.14	0.14	487.3	487.42	-			

System	ID	DS Sta	US Sta	Length	Pipe Diameter	Area	Wetted Perimeter	Hydraulic Radius	Manning's n	DS Flowline	US Flowline	Slope	Drainage Areas	Runoff Coeff C	Area	CA	CA	CA	Tc	Rainfall Intensity	Q 100	Q Capacity	Partial Flow	Velocity	Friction Slope	Friction Loss	Hv	K	Head Loss	HGL DS	HGL US	Top of Curb
B	56.67	56.67	0	18	-	-	-	-	-	-	-	-	E,F,G,H,O	0.90	0.96	0.87	0.87	10.00	9.80	8.50	-	Yes	-	-	-	-	-	-	-	-	500.04	-
B	13.01	56.67	43.66	18	1.77	4.71	0.375	0.013	496	496.2	0.005	-	0.90	0	0	0.87	10.00	9.80	8.50	7.45	No	4.81	0.0065	0.28	0.36	0.5	0.18	499.58	499.86	-		

System	ID	DS Sta	US Sta	Length	Pipe Diameter	Area	Wetted Perimeter	Hydraulic Radius	Manning's n	DS Flowline	US Flowline	Slope	Drainage Areas	Runoff Coeff C	Area	CA	CA	CA	Tc	Rainfall Intensity	Q 100	Q Capacity	Partial Flow	Velocity	Friction Slope	Friction Loss	Hv	K	Head Loss	HGL DS	HGL US	Top of Curb
RD-2	0	33.53	33.53	18	1.77	4.71	0.38	0.013	496.76	497.10	0.01	E, F, & O	0.90	0.29	0.26	0.26	10.00	9.80	2.56	10.50	Yes	1.45	0.01	0.22	0.36	0.50	0.18	504.36	504.58	-		

This Record Drawing is a combination of the sealed engineering contract drawings for this project, modified by revision, change order, field order and information furnished by the contractor. The information shown on the Record Drawings is believed to be accurate based on information furnished by the contractor. The original sealed drawings are on file at the office of:
 Cross Engineering Consultants
 1720 W. Virginia Street
 McKinney, Texas 75069
 (972) 562-4409
 Record Drawings Prepared On:
 12/22/2023



Issued for Construction: 04-19-2021

(@ least 72 hours prior to digging)

Issue Dates:	Revisions:	Date:
5	11/30/2020	1 05/17/2021
6	12/23/2020	2 01/28/2022
7	01/22/2021	3 02/25/2022
8	01/29/2021	4 10/31/2023
9	04/19/2021	5
10	12/22/2023	6


CROSS ENGINEERING CONSULTANTS		
1720 W. Virginia Street 972.562.4409		McKinney, Texas 75069 Texas P.E. Firm No. F-5935
Drawn By:	Checked By:	Scale:
C.E.C.I.	C.E.C.I.	1/1"=40' V:1"=4'

The seal that originally appeared on this document was authorized by T. Zachary Grimes, Texas No. 122013 on 4/19/2021. Alteration of a sealed document without proper notification of the responsible Engineer is an offense under the Texas Engineering Practice Act.

STORM SEWER PROFILES
HARBOR HILL RESIDENCES
 SUMMER LEE DRIVE
 ROCKWALL, TEXAS

Sheet No.
C4.2
 Project No.
 18090

HARBOR HILL RESIDENCES - ROCKWALL

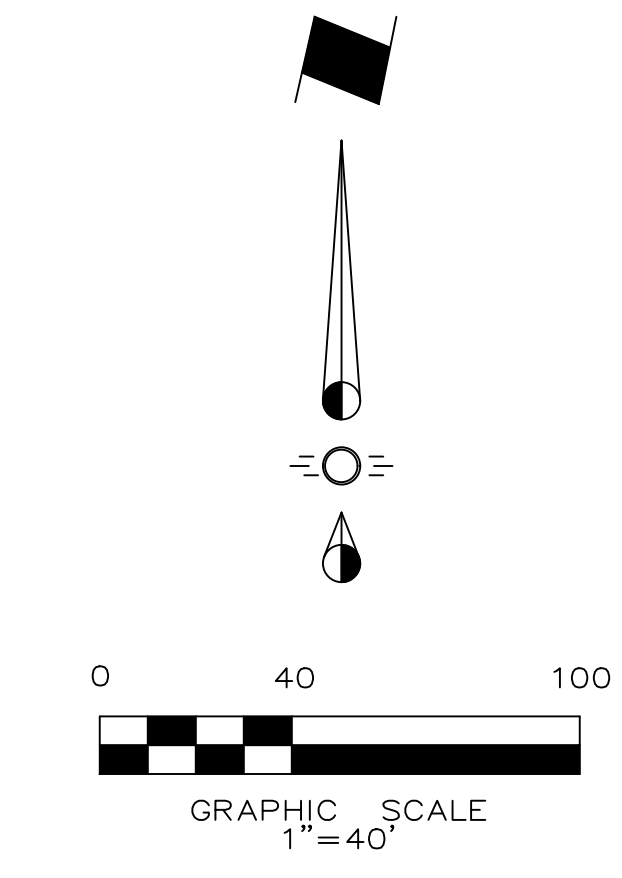

WATER & SANITARY SEWER NOTES

- All materials and construction shall be in accordance with the City of Rockwall Standard Specifications and Construction Standards, and Standard Specifications for Public Works Construction prepared by North Central Texas Council of Governments (5th Edition), and to the regulations of The Texas Commission on Environmental Quality.
- Existing utilities are shown schematically and are for the contractors guidance only. The location and/or elevation of existing utilities as shown on these plans are based on records of the various utility companies, and, where possible, measurements taken in the field. The contractor must call the appropriate utility company at least 72 hours prior to any excavation to request exact field location of utilities.
- The contractor shall be responsible for protecting all existing improvements in the construction of this project. The contractor is responsible for repairs of damage to any existing improvements during construction. Repairs shall be equal to or better than condition prior to construction.
- All sewer lines shall be PVC SDR-35.
- All manhole rim grades must match finished grade in paved areas. Manholes constructed in landscape areas must have a final rim grade six inches (6") above final grade.
- Proposed water lines shall be AWWA C900-16 PVC Pipe (blue in color) for all sizes, DR 14 (PC 305) for pipeline sizes 12-inch and smaller, and DR-18 (PC 235) for 14-inch and larger water pipelines unless otherwise shown on water plan and profile sheets. Proposed water lines shall be constructed with minimum cover of 4 feet for 6-inch through 8-inch, 5 feet for 12-inch through 18-inch and 6 feet for 20-inch and larger.
- Contractor shall be responsible for maintaining trench safety requirements in accordance with the latest standards of O.S.H.A. or any other agency having jurisdiction for excavation and trenching procedures. Contractor shall provide and implement a trench safety plan complying with O.S.H.A.
- Fire sprinkler line shall be sized and installed by a state licensed contractor. Fire Line shown for reference only.
- Fire protection rooms shall have no roof access, mopsinks, electrical panels, storage. Fire Protection rooms are for Fire Alarm and Control systems uses.
- Must install green EMS disks on all sewer changes (turns, sizes, etc), connections to main, manholes, and cleanouts.
- Must install blue EMS disks on all water line changes (turns, sizes, etc), every 250', valves, and service connections.
- All manholes to be Raven Lined or City approved equal, including existing manholes to be connected to.

Note:
Water Line B Must Be Connected to Prop 8" WL By Others To Complete the Water Loop Prior to TCO or CO Release

Install 66 LF 16" Steel Encasement Pipe For 8" WL. Maintain Min. 2" Vertical Clearance Btwn Top Encasement Pipe and Bottom of Retaining Wall. Steel Encasement Pipes Shall Extend Min 5' Past Wall & Footing.

LEGEND

	Property Line
	Proposed S.S. Line
	Proposed Water Line
	Proposed Fire Hydrant
	Proposed Water Tee
	Proposed Water Valve
	Proposed Water Bend
	Proposed Blow Off Valve
	Existing Fire Hydrant
	Existing S.S. Line
	Existing Water Line
	Existing Undergroud Elec
	Existing Gas Line
	Proposed Retaining Wall


Note:
Existing Utilities Shown Per As-Built Documents. Contractor to Field Verify Location and Depth of All Utilities Prior to Construction and Notify Engineer of any Discrepancies.

WATER METER CHART

No.	Proposed Meter	Size
1	Domestic Meter	4"
2	Irrigation Meter	2"



(@ least 72 hours prior to digging)

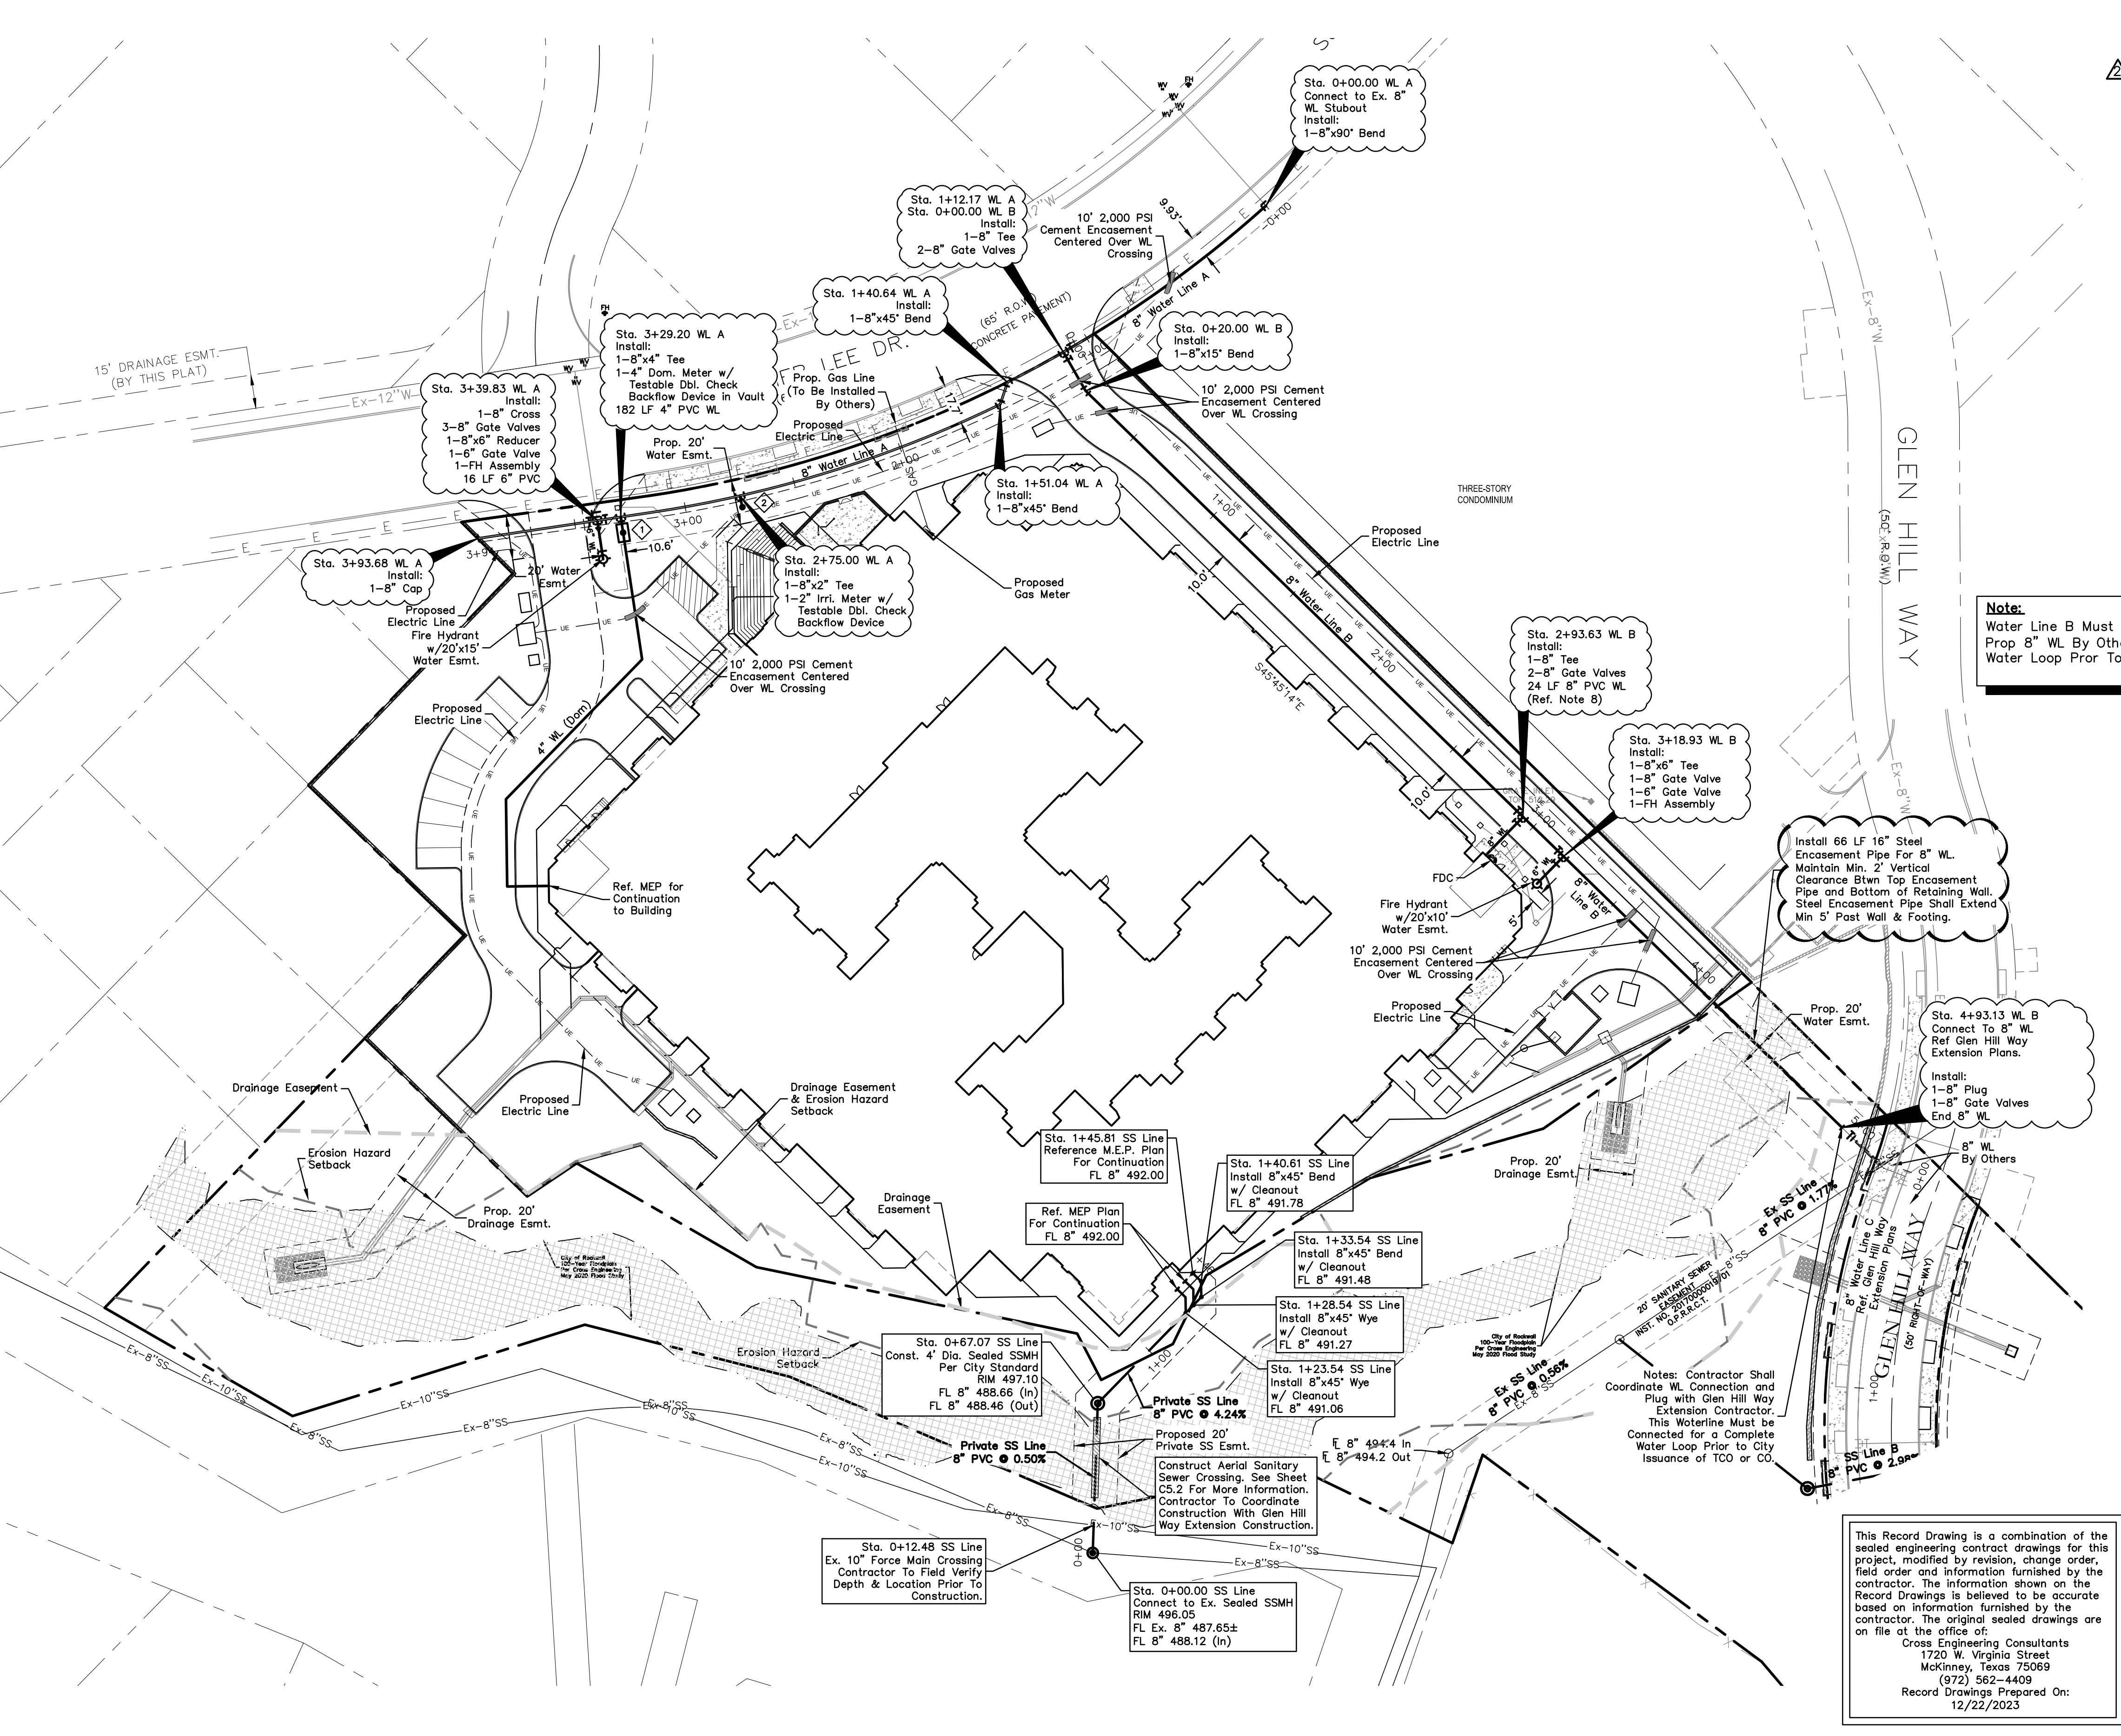

This Record Drawing is a combination of the sealed engineering contract drawings for this project, modified by revision, change order, field order and information furnished by the contractor. The information shown on the Record Drawings is believed to be accurate based on information furnished by the contractor. The original sealed drawings are on file at the office of:
Cross Engineering Consultants
1720 W. Virginia Street
McKinney, Texas 75069
(972) 562-4409
Record Drawings Prepared On:
12/22/2023

- Added Elec. Lines & Crossings
- Revised Water Line Notes

Issue Dates:	Revisions:	Date:
5 11/30/2020	1	05/17/2021
6 12/23/2020	2	01/28/2022
7 01/22/2021	3	02/25/2022
8 01/29/2021	4	10/31/2023
9 04/19/2021	5	
10 12/22/2023	6	

CROSS ENGINEERING CONSULTANTS
1720 W. Virginia Street
972.562.4409
McKinney, Texas 75069
Texas P.E. Firm No. F-5935

Drawn By: C.E.C.I. Checked By: C.E.C.I. Scale: 1"=40'

The seal that originally appeared on this document was authorized by T. Zachary Grimes, Texas No. 122013 on 1/28/2022. Alteration of a sealed document without proper notification of the responsible Engineer is an offense under the Texas Engineering Practice Act.

Issued for Construction: 04-19-2021

UTILITY PLAN

HARBOR HILL RESIDENCES

SUMMER LEE DRIVE
ROCKWALL, TEXAS

Sheet No.
C5.1
Project No.
18090







BENCHMARK:

City Benchmark:
COR-7-Aluminum Disk Stamped "City of Rockwall Survey Monument" Located on the south side of Summer Lee Dr. ±275 feet west of intersection of Summer Lee Dr and Ridge Road, ±1 foot south of curb line.
ELEVATION: 567.52

Site Benchmark:
No. 1-"X" Cut on rim of water valve located on the north side of Summer Lee Dr. approx. 915 feet easterly from the intersection of Sunset Ridge Dr. ELEVATION: 548.55

No. 2-"X" Cut on southeast corner of curb inlet located on the east side of Shoreline Tr. approx. 480 feet northerly from the north side of Summer Lee Dr.
ELEVATION: 474.56

HARBOR HILL RESIDENCES - ROCKWALL

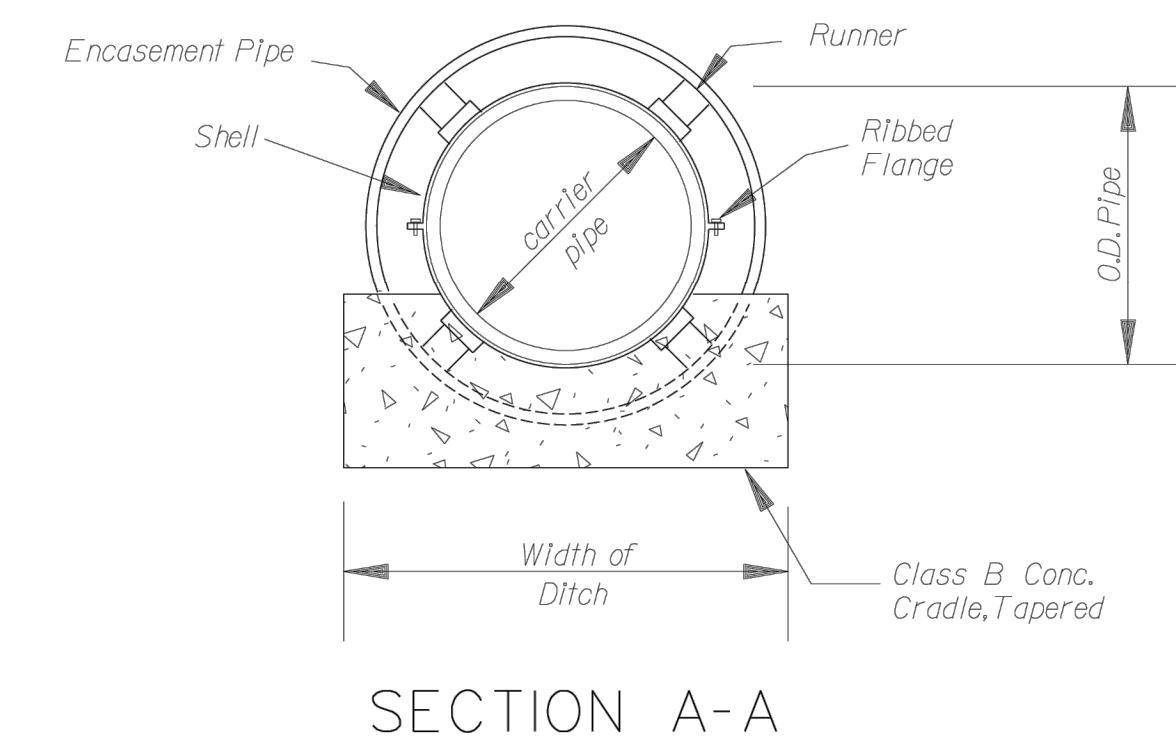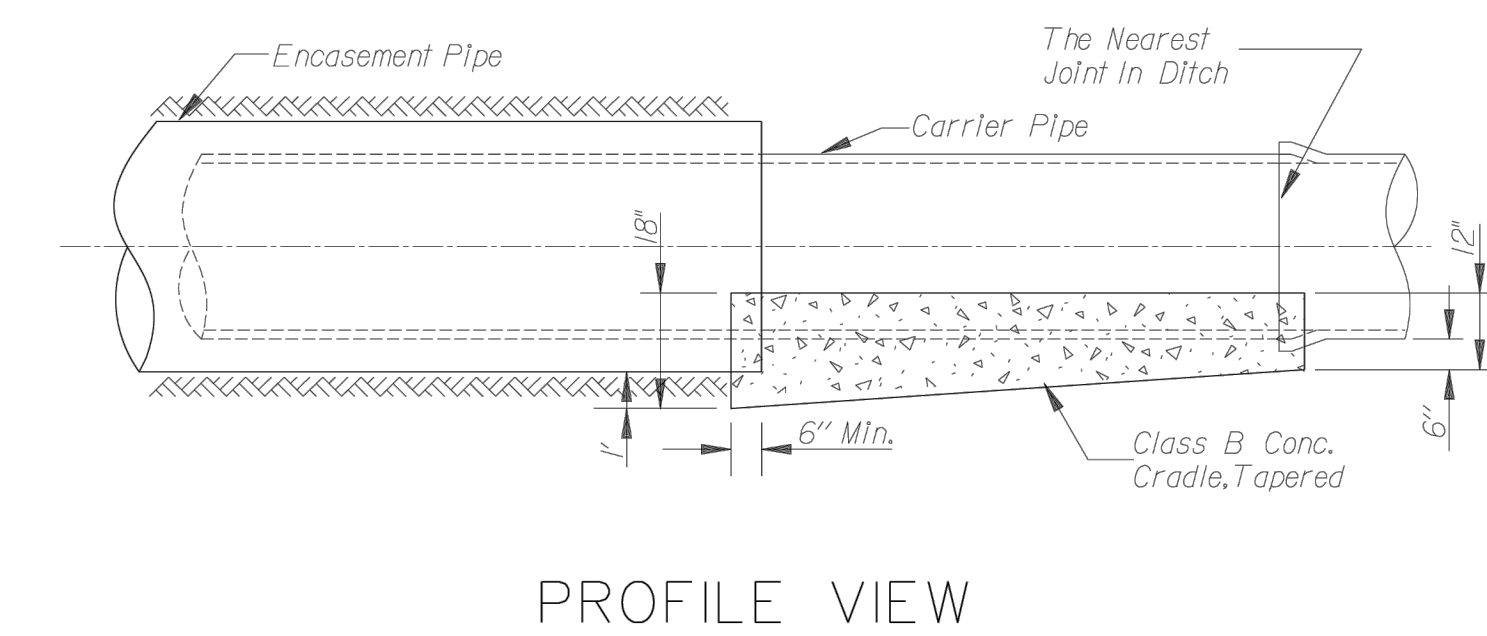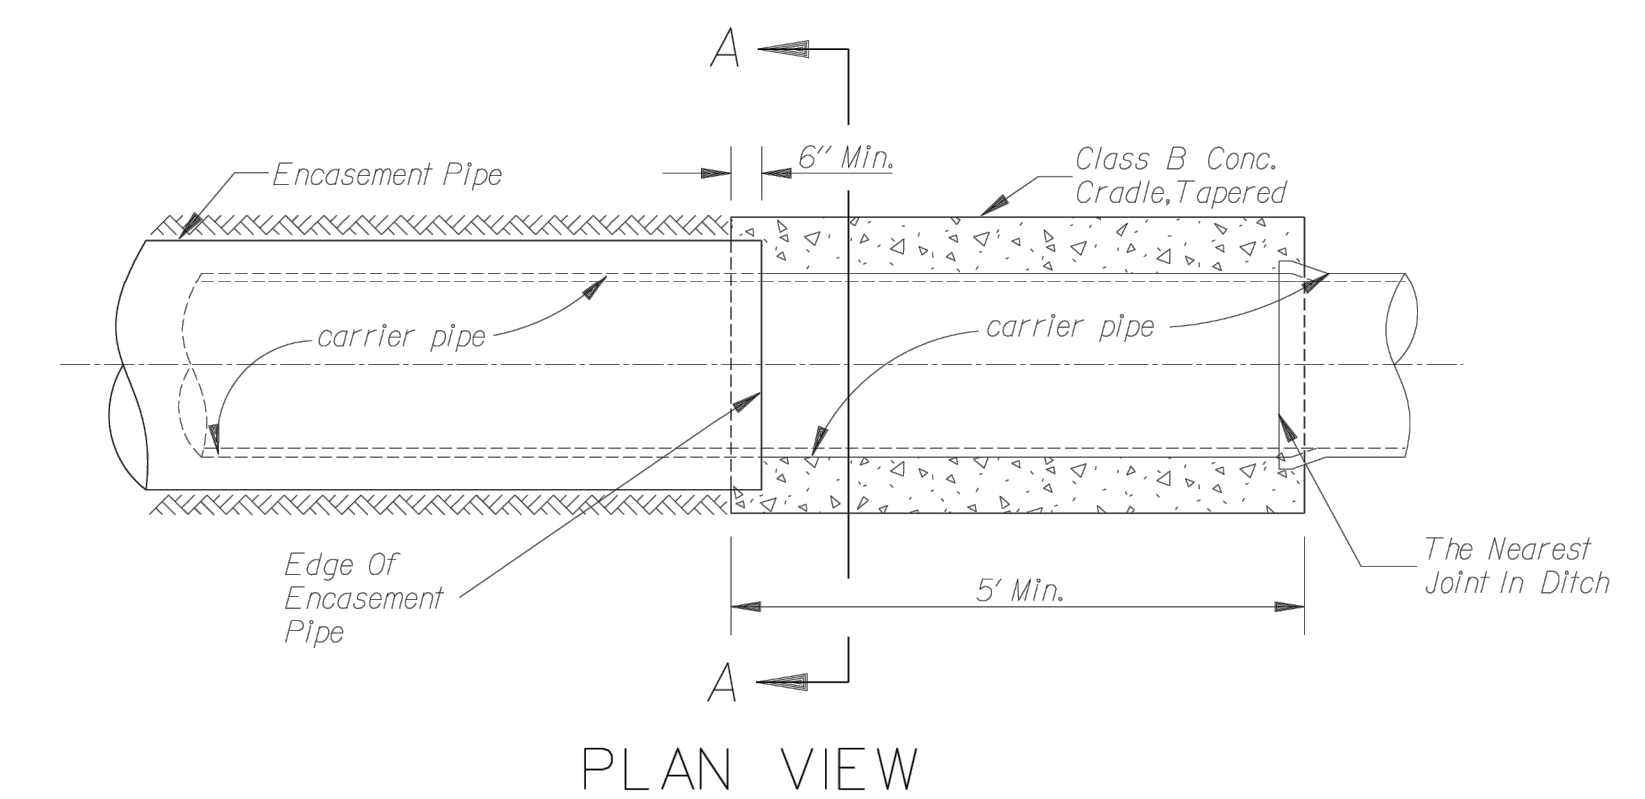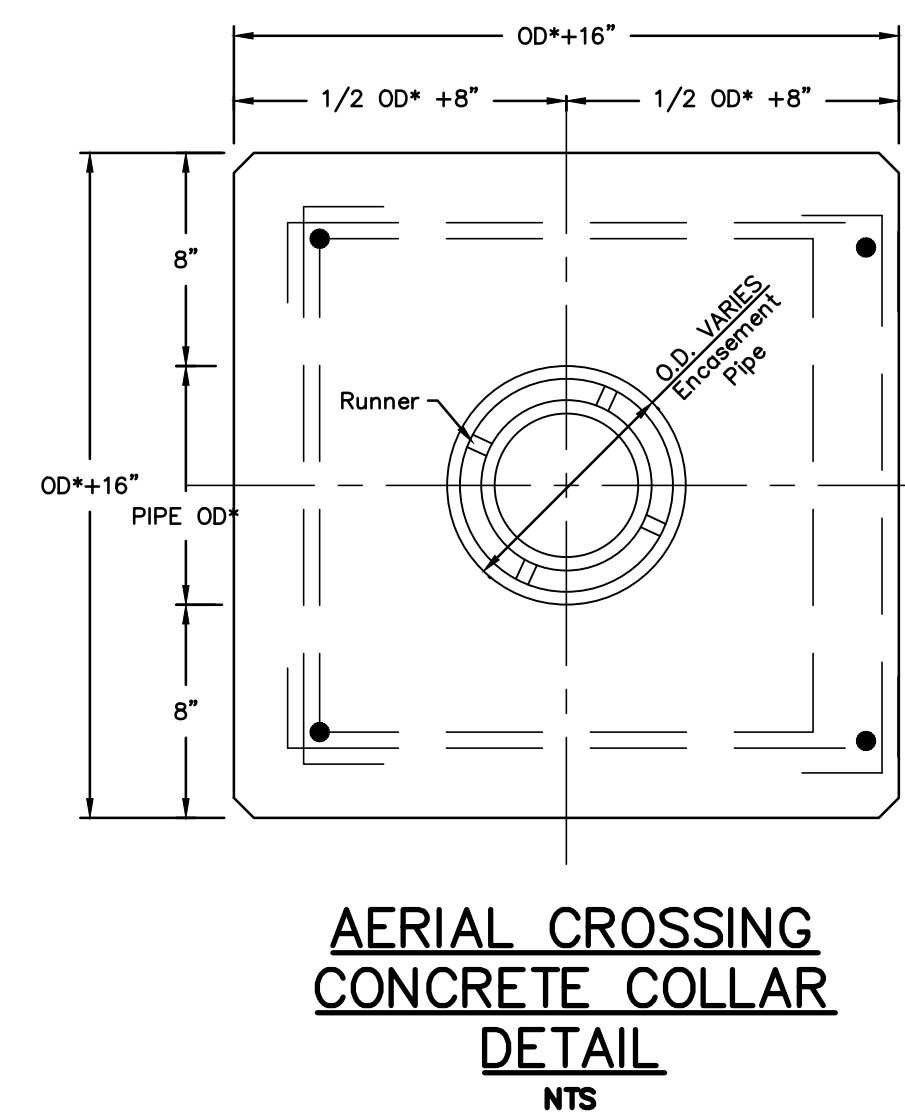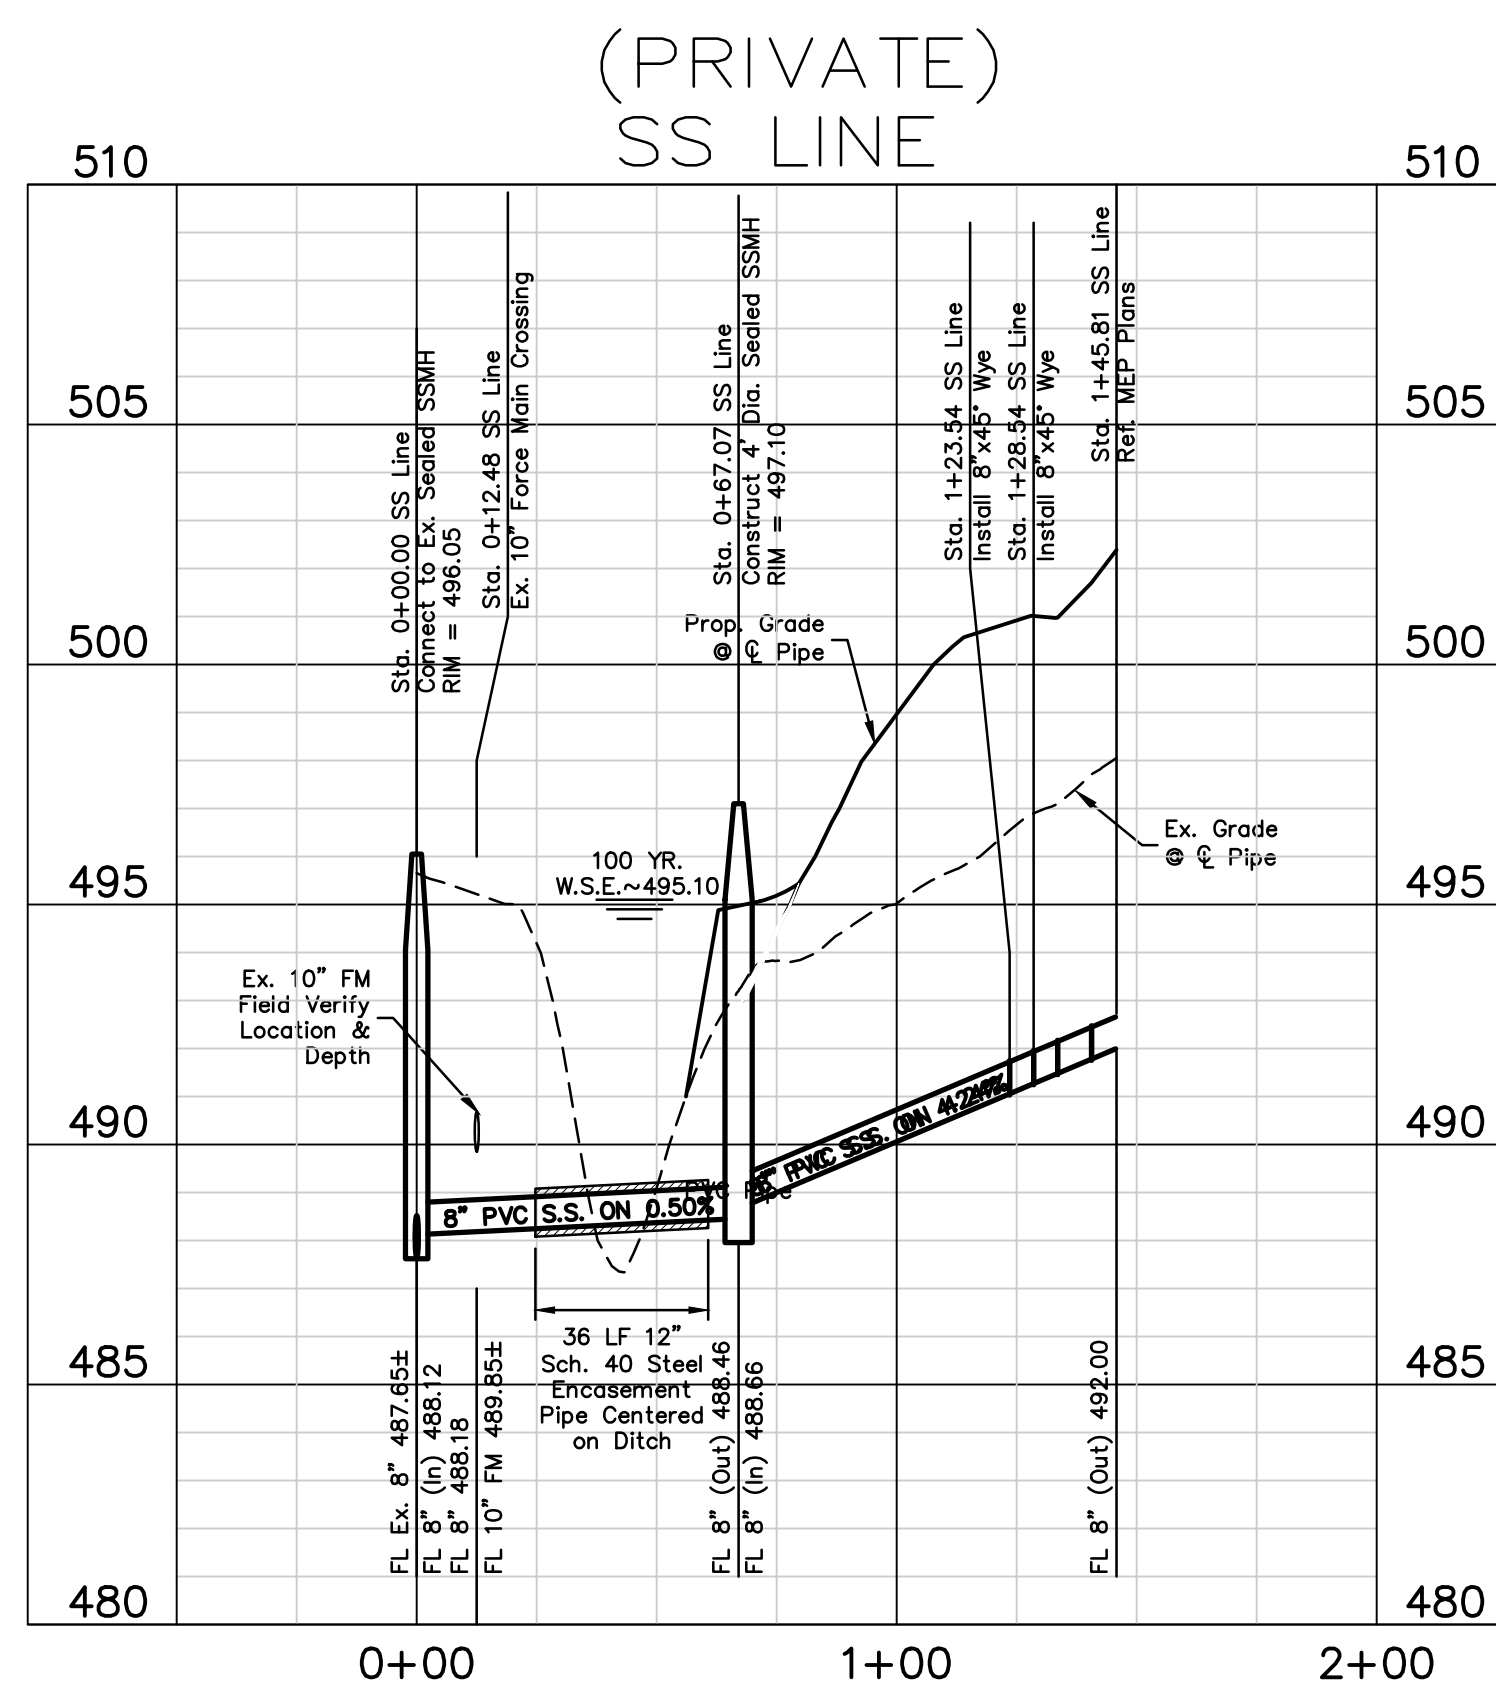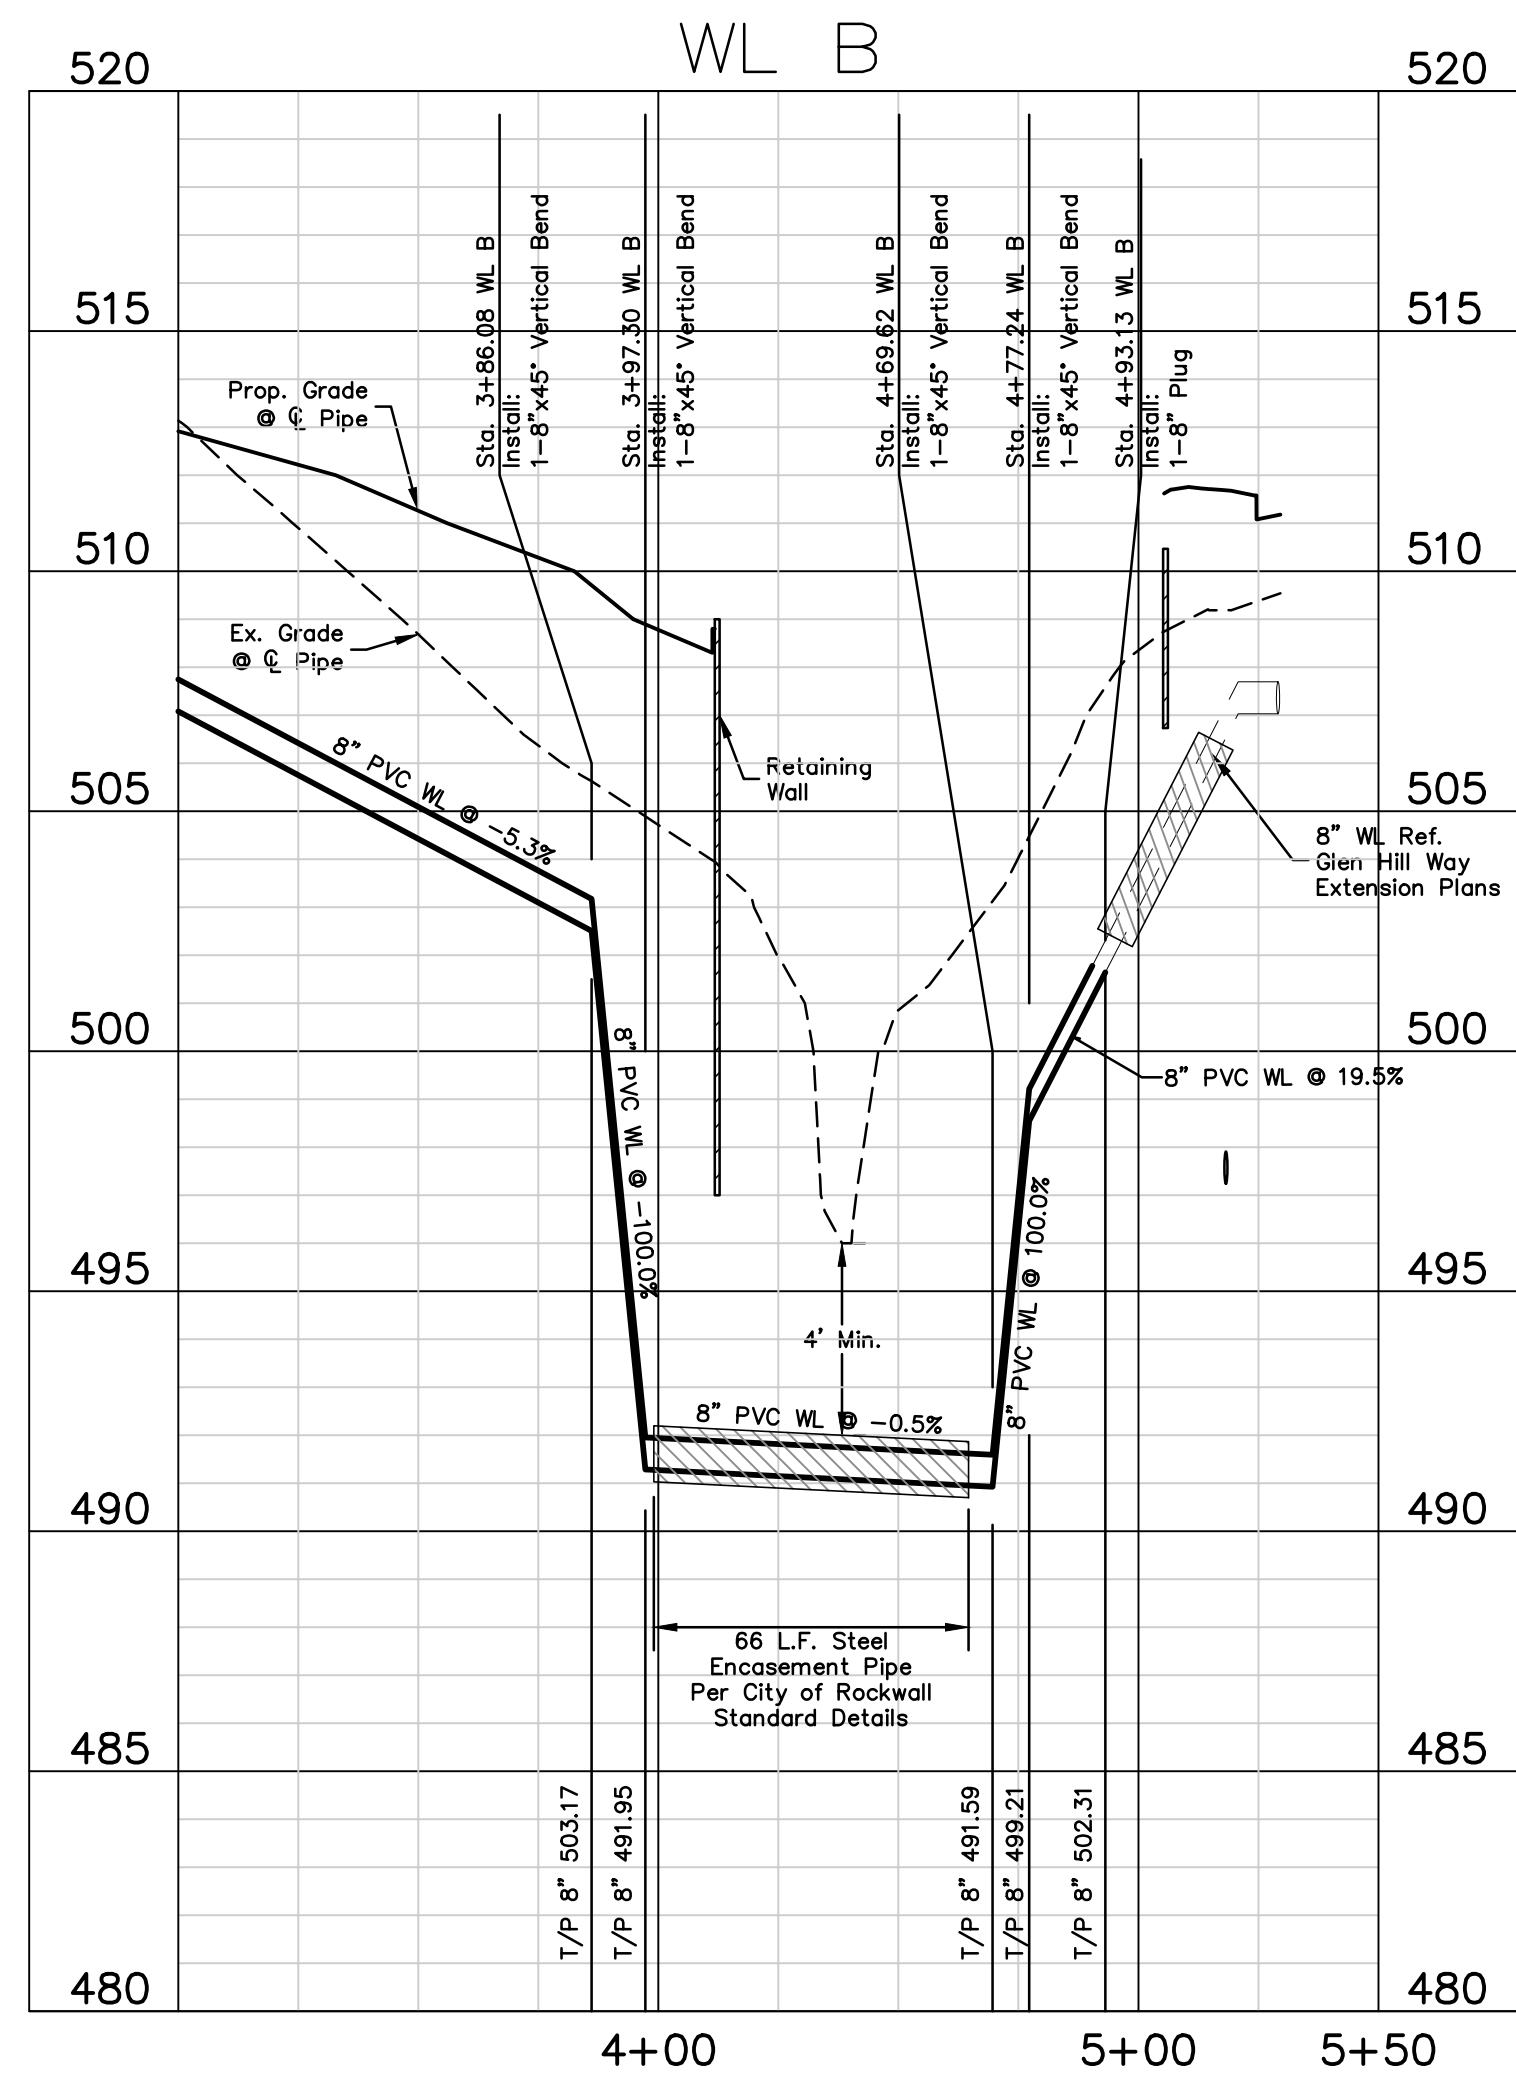

TUNNEL APPROACHES WITH CASING SPACERS
NTS

NOTE:
SANITARY SEWER AERIAL CROSSING DETAILS ON THIS SHEET PROVIDED FOR REFERENCE AND BIDDING PURPOSES ONLY. CONTRACTOR TO PROVIDE PLANS FOR THE AERIAL CROSSING SIGNED AND SEALED BY A STRUCTURAL ENGINEER LICENSED IN THE STATE OF TEXAS PRIOR TO CONSTRUCTION. STRUCTURAL ENGINEER AND CONTRACTOR TO COORDINATE DESIGN AND CONSTRUCTION OF AERIAL CROSSING WITH PROPOSED CREEK IMPROVEMENTS INCLUDED IN THE NEARBY GLEN HILL WAY EXTENSION PROJECT.

This Record Drawing is a combination of the sealed engineering contract drawings for this project, modified by revision, change order, field order and information furnished by the contractor. The information shown on the Record Drawings is believed to be accurate based on information furnished by the contractor. The original sealed drawings are on file at the office of:
Cross Engineering Consultants
1720 W. Virginia Street
McKinney, Texas 75069
(972) 562-4409
Record Drawings Prepared On:
12/22/2023

BENCHMARK:
City Benchmark: COR-7-Aluminum Disk Stamped " City of Rockwall Survey Monument" Located on the south side of Summer Lee Dr. ±275 feet west of intersection of Summer Lee Dr and Ridge Road, ±1 foot south of curb line. ELEVATION: 567.52
Site Benchmark: No. 1-"X" Cut on rim of water valve located on the north side of Summer Lee Dr. approx. 915 feet easterly from the intersection of Sunset Ridge Dr. ELEVATION: 548.55
No. 2-"X" Cut on southeast corner of curb inlet located on the east side of Shoreline Tr. approx. 480 feet northerly from the north side of Summer Lee Dr. ELEVATION: 474.56

Issue Dates:	Revisions:	Date:
5 11/30/2020	1	05/17/2021
6 12/23/2020	2	01/28/2022
7 01/22/2021	3	02/25/2022
8 01/29/2021	4	10/31/2023
9 04/19/2021	5	
10 12/22/2023	6	

CROSS ENGINEERING CONSULTANTS
1720 W. Virginia Street
972.562.4409
McKinney, Texas 75069
Texas P.E. Firm No. F-5935

Drawn By: C.E.C.I. Checked By: C.E.C.I. Scale: H: 1"=40' V: 1"=4'

The seal that originally appeared on this document was authorized by T. Zachary Grimes, Texas No. 122013 on 4/19/2021. Alteration of a sealed document without proper notification of the responsible Engineer is an offense under the Texas Engineering Practice Act.

UTILITY PROFILES
HARBOR HILL RESIDENCES
SUMMER LEE DRIVE
ROCKWALL, TEXAS

Sheet No.
C5.2
Project No.
18090

Issued for Construction: 04-19-2021

STOP!
CALL BEFORE YOU DIG





(@ least 72 hours prior to digging)

HARBOR HILL RESIDENCES - ROCKWALL

STORMWATER POLLUTION PREVENTION NOTES

- It is the intent of the information provided on this sheet to be used as the general guidelines of the storm water pollution prevention plan for this project to establish a minimum basis of compliance with federal regulations.
- The storm water pollution prevention plan shall meet the requirements for storm water discharges from construction sites published in the tpd's general permit no. Tsr 150000, dated March 5, 2013, issued pursuant to section 26.040 of the Texas water code and section 402 of the clean water act, by the Texas commission on environmental quality (tceq).
- The storm water pollution prevention plan should address three goals:
 - diversion of upslope water around disturbed areas of the site;
 - limit the exposure of disturbed areas to the shortest duration possible; and
 - removal of sediment from storm water before it leaves the site.
- The contractor shall have the storm water pollution prevention plan available onsite.
- The contractor must amend plans whenever there is a change in design, construction, operation, or maintenance of the plan, or when the existing plan proves ineffective. Modifications including design and all additional materials and work shall be accomplished by the contractor at no additional expense to the owner.
- Stabilization measures are to be inspected at a minimum of once every 7 days and within 24 hours after any storm event greater than .05 inches. Repairs and inadequacies revealed by the inspection must be implemented within 1 calendar day following the inspection. Rain gauge shall be placed on-site to measure and record.
- An inspection report that summarizes inspection activities and implementation of the storm water pollution prevention plan shall be retained and made part of the plan.
- All contractors and subcontractors identified in the plan must certify as to an understanding of the tpd's general permit before conducting any activity identified in the pollution prevention plan.
- The contractor shall adopt appropriate construction site management practices to prevent the discharge of oils, grease, paints, gasoline, and other pollutants to storm water. Appropriate practices can include: Designating areas for equipment maintenance and repair; regular collection of wastes; conveniently located waste receptacles; and designating and controlling equipment washdown.
- The contractor shall amend or modify this plan as required by construction means, methods, and sequence. Modifications shall not compromise the intent of the requirements of the law and this plan. Modifications shall not be basis for additional cost to the owner.
- Areas of construction elsewhere on the jobsite shall conform to the detail shown on the plans.
- Borrow areas, if excavated, shall be protected and stabilized utilizing the plan details. All work shall conform to governmental requirements and become part of the storm water pollution prevention plan (swp3). This work shall be done by the contractor at no additional expense to the owner.
- All non-paved areas shall be mulched and seeded with erosion protection immediately upon completion of final grading. This includes all ditches and embankments. The contractor shall maintain final grading and keep seeded areas watered until fully established and accepted by owner.
- The contractor shall construct a stabilized construction entrance/exit at designated traffic entrance/exit points prior to entering/exiting onto any paved roadway.
- The contractor shall construct a silt fence at all locations shown on plans. The silt fence shall be constructed as detailed this sheet.
- All disturbed ground areas shall be re-vegetated with a combination of perennial rye and bermuda, upon completion of final grading.
- 75%-80% of all disturbed areas to have a minimum 1" stand of grass (no rye or weeds) prior to engineering acceptance/co.
- All Right-of-ways to be sodded prior to acceptance.

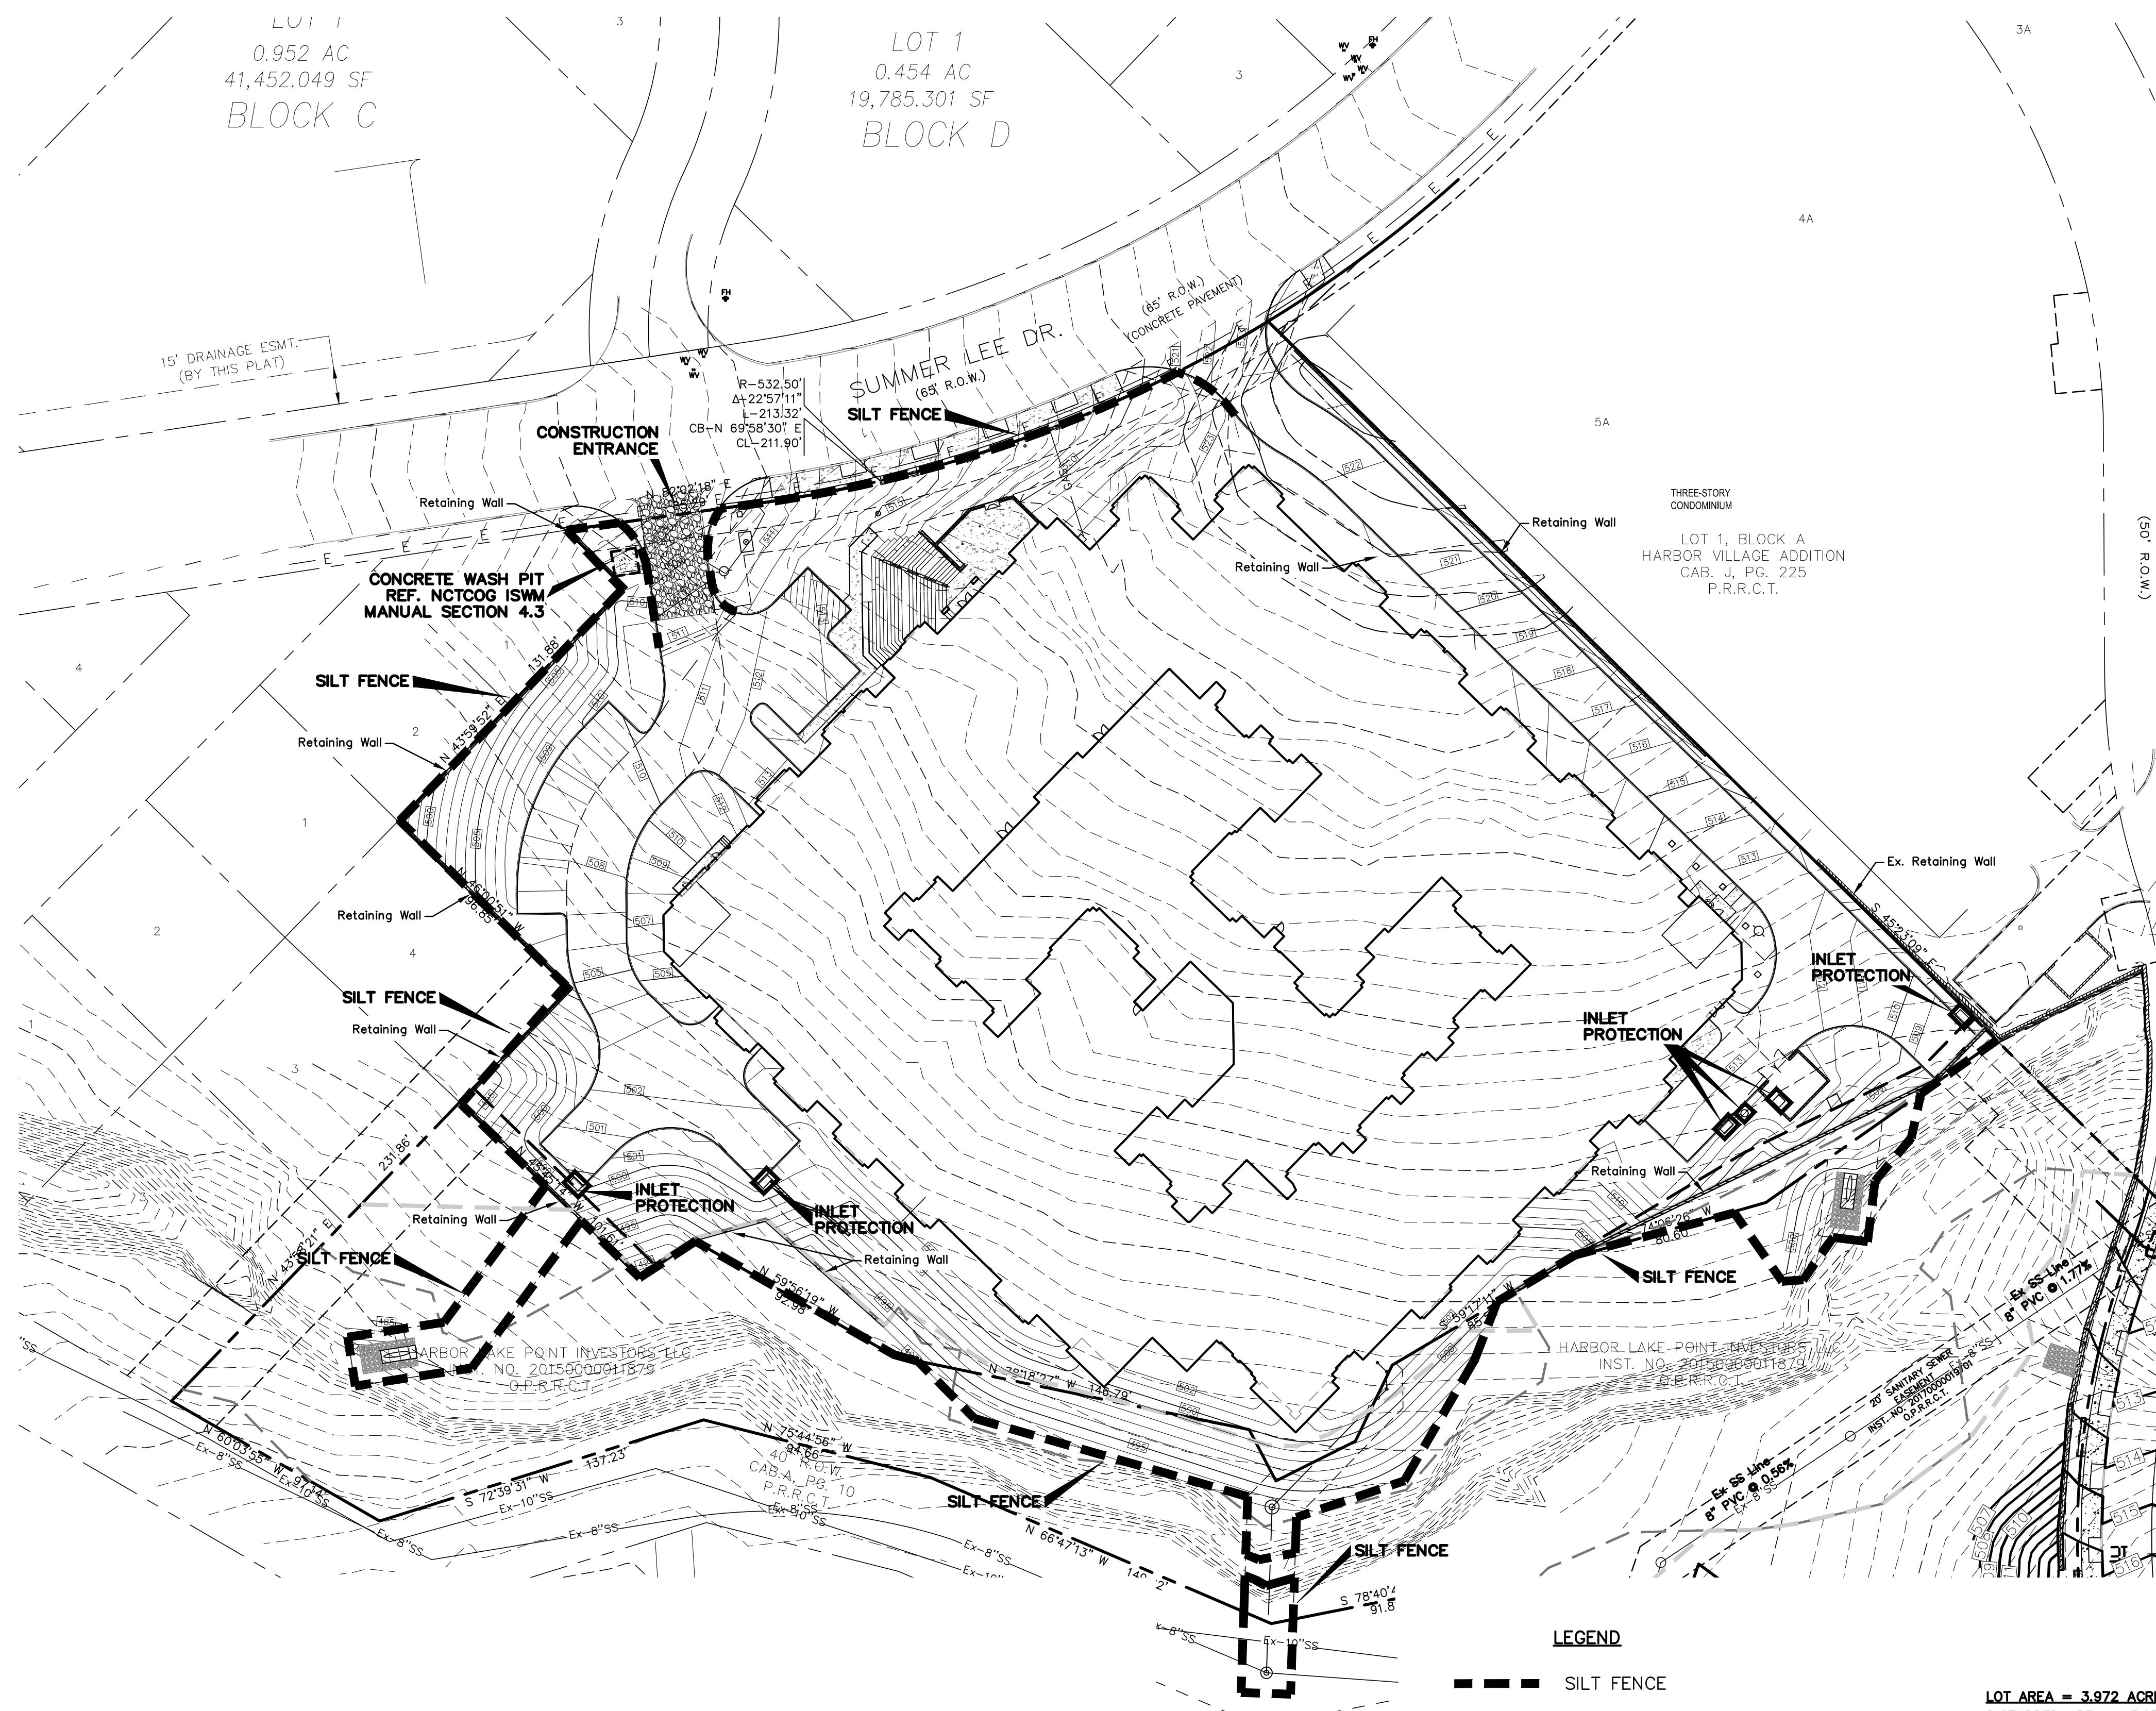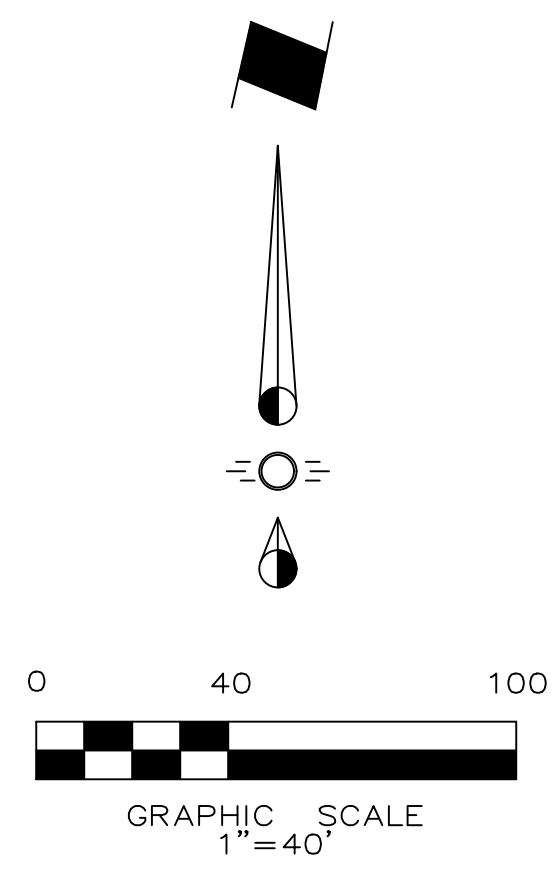

- LEGEND**
- SILT FENCE
 - INLET PROTECTION
 - TEMPORARY CONSTRUCTION ENTRANCE
 - CONCRETE WASH PIT
 - PROPERTY LINE

LOT AREA = 3.972 ACRES
DISTURBED AREA = 3.972 ACRES

PHASING

- INSTALL SILT FENCE AND CONSTRUCTION ENTRANCE
- INSTALL INLET PROTECTION WHEN INLET AND FRONT PAVING ARE COMPLETE.
- REMOVE SILT FENCE AT PAVING CONNECTION POINTS FOR DRIVE CONNECTIONS.
- REMOVE CONSTRUCTION ENTRANCE AFTER ALL INTERIOR CONSTRUCTION IS COMPLETE AND POUR ENTRY PAVING.
- REMOVE SILT FENCE AND INLET PROTECTION WHEN PERMANENT BMP'S ARE IN PLACE.

This Record Drawing is a combination of the sealed engineering contract drawings for this project, modified by revision, change order, field order and information furnished by the contractor. The information shown on the Record Drawings is believed to be accurate based on information furnished by the contractor. The original sealed drawings are on file at the office of:
Cross Engineering Consultants
1720 W. Virginia Street
McKinney, Texas 75069
(972) 562-4409
Record Drawings Prepared On:
12/22/2023

Issue Dates:	Revisions:	Date:
5 11/30/2020	1	05/17/2021
6 12/23/2020	2	01/28/2022
7 01/22/2021	3	02/25/2022
8 01/29/2021	4	10/31/2023
9 04/19/2021	5	
10 12/22/2023	6	

CROSS ENGINEERING CONSULTANTS
1720 W. Virginia Street McKinney, Texas 75069
972.562.4409 Texas P.E. Firm No. F-5935

Drawn By: C.E.C.I. Checked By: C.E.C.I. Scale: 1"=40'

The seal that originally appeared on this document was authorized by T. Zachary Grimes, Texas No. 122013 on 4/19/2021. Alteration of a sealed document without proper notification of the responsible Engineer is an offense under the Texas Engineering Practice Act.

Issued for Construction: 04-19-2021

EROSION CONTROL PLAN

HARBOR HILL RESIDENCES

SUMMER LEE DRIVE
ROCKWALL, TEXAS


Sheet No.
C6.1

Project No.
18090



(@ least 72 hours prior to digging)

HARBOR HILL RESIDENCES - ROCKWALL

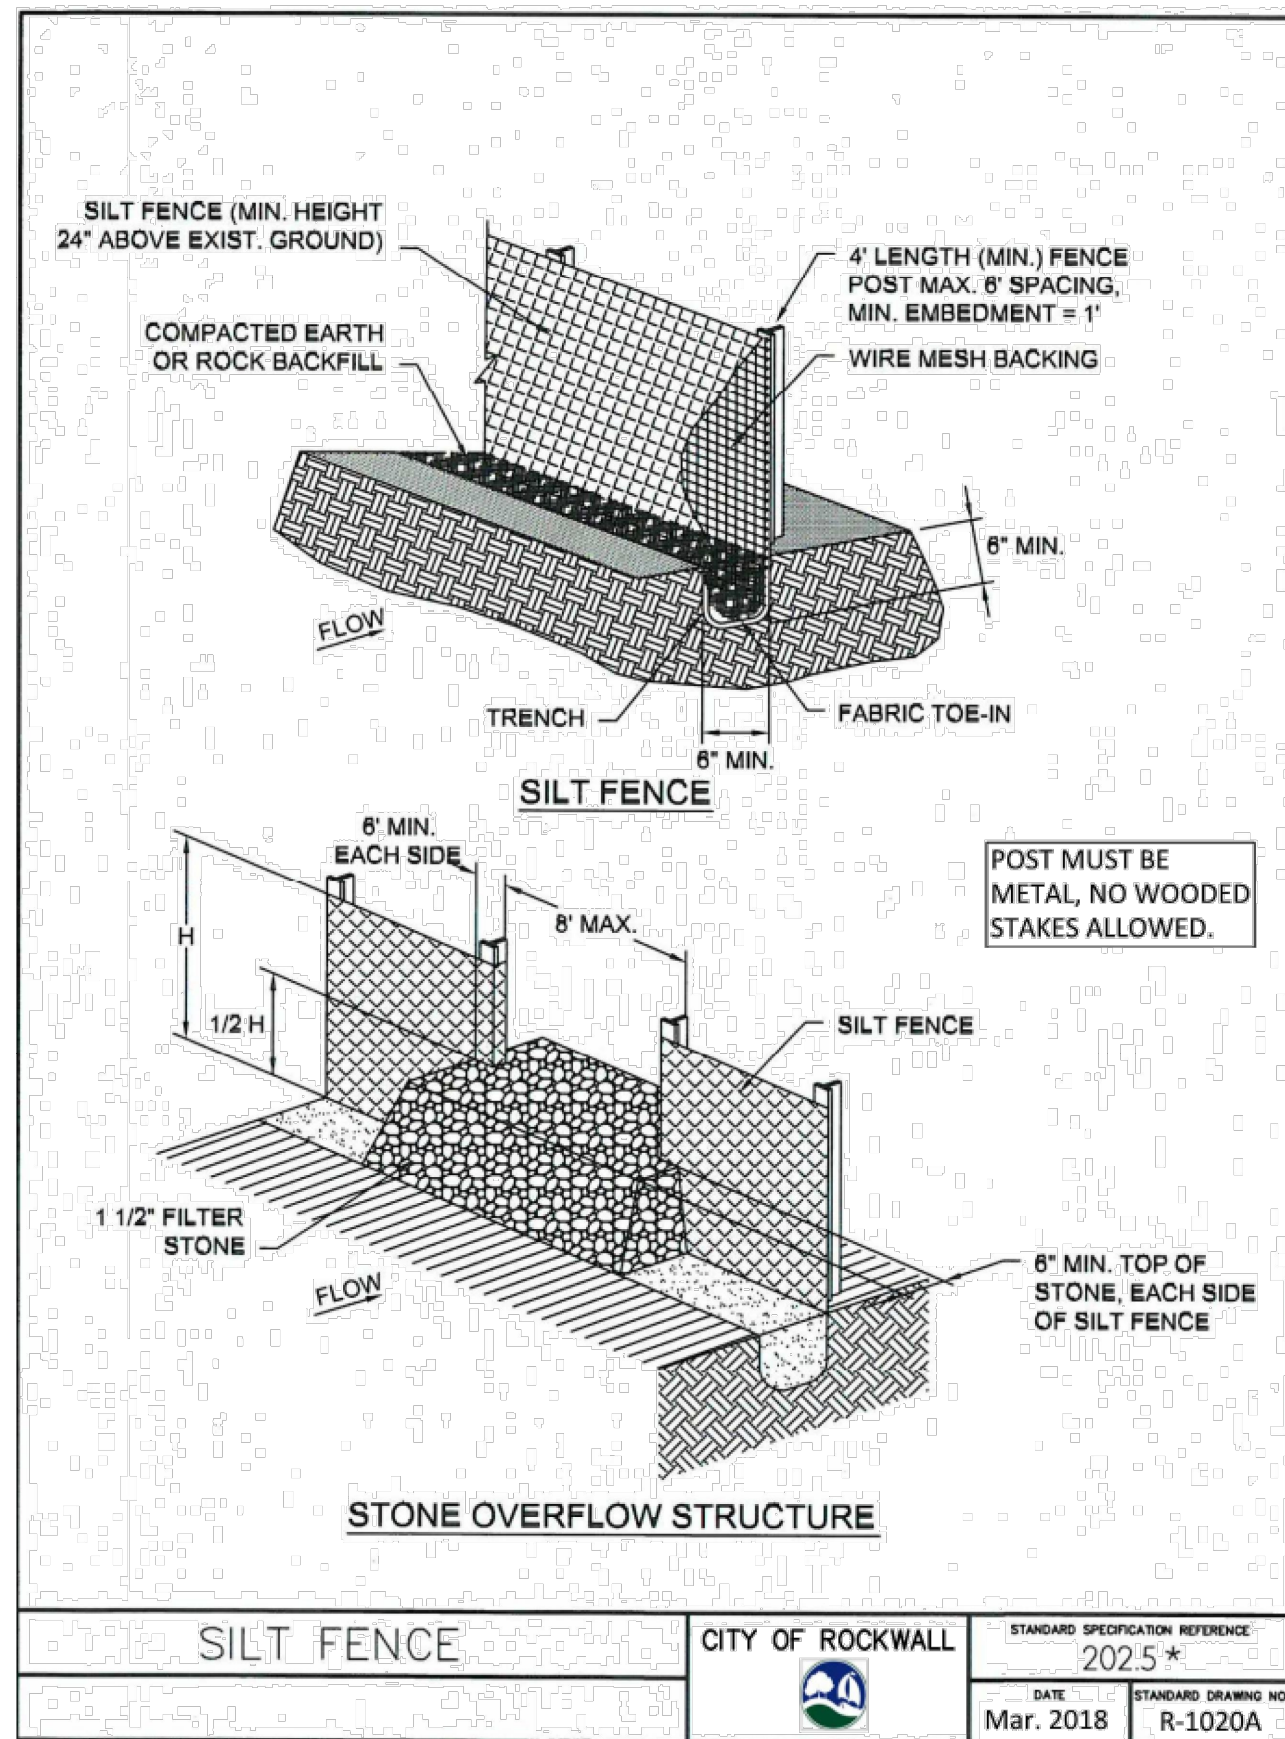

SILT FENCE GENERAL NOTES:

1. POSTS WHICH SUPPORT THE SILT FENCE SHALL BE INSTALLED ON A SLIGHT ANGLE TOWARD THE ANTICIPATED RUNOFF SOURCE. POST MUST BE EMBEDDED A MINIMUM OF ONE FOOT.
2. THE TOE OF THE SILT FENCE SHALL BE TRENCHED IN WITH A SPADE OR MECHANICAL TRENCHER, SO THAT THE DOWNSLOPE FACE OF THE TRENCH IS FLAT AND PERPENDICULAR TO THE LINE OF FLOW. WHERE FENCE CANNOT BE TRENCHED IN (E.G. PAVEMENT), WEIGHT FABRIC FLAP WITH ROCK ON UPHILL SIDE TO PREVENT FLOW FROM SEEPING UNDER FENCE.
3. THE TRENCH MUST BE A MINIMUM OF 6 INCHES DEEP AND 6 INCHES WIDE TO ALLOW FOR THE SILT FENCE FABRIC TO BE LAID IN THE GROUND AND BACKFILLED WITH COMPACTED MATERIAL.
4. SILT FENCE SHOULD BE SECURELY FASTENED TO EACH SUPPORT POST OR TO WIRE BACKING, WHICH IN TURN IS ATTACHED TO THE FENCE POST. THERE SHALL BE A 3 FOOT OVERLAP, SECURELY FASTENED WHERE ENDS OF FABRIC MEET.
5. INSPECTION SHALL BE AS SPECIFIED IN THE SWPPP. REPAIR OR REPLACEMENT SHALL BE MADE PROMPTLY AS NEEDED.
6. SILT FENCE SHALL BE REMOVED WHEN FINAL STABILIZATION IS ACHIEVED OR ANOTHER EROSION OR SEDIMENT CONTROL DEVICE IS EMPLOYED.
7. ACCUMULATED SILT SHALL BE REMOVED WHEN IT REACHES A DEPTH OF HALF THE HEIGHT OF THE FENCE. THE SILT SHALL BE DISPOSED OF AT AN APPROVED SITE AND IN SUCH A MANNER AS TO NOT CONTRIBUTE TO ADDITIONAL SILTATION.
8. FILTER STONE SHALL BE WRAPPED IN FILTER FABRIC AND BURIED SIX (6") INCHES MINIMUM.

SILT FENCE

CITY OF ROCKWALL

STANDARD SPECIFICATION REFERENCE: 202.5 *

DATE: Mar. 2018

STANDARD DRAWING NO: R-1020B

Page 250

ROCK CHECK DAM GENERAL NOTES:

1. STONE SHALL BE WELL GRADED WITH SIZE RANGE FROM 1 1/2" TO 3 1/2" INCHES IN DIAMETER DEPENDING ON EXPECTED FLOWS.
2. THE CHECK DAM SHALL BE INSPECTED AS SPECIFIED IN THE SWPPP AND SHALL BE REPLACED WHEN THE STRUCTURE CEASES TO FUNCTION AS INTENDED DUE TO SILT ACCUMULATION AMONG THE ROCKS, WASHOUT, CONSTRUCTION TRAFFIC DAMAGE, ETC.
3. WHEN SILT REACHES A DEPTH EQUAL TO ONE-THIRD OF THE HEIGHT OF THE CHECK DAM OR ONE FOOT, WHICHEVER IS LESS, THE SILT SHALL BE REMOVED AND DISPOSED OF PROPERLY.
4. WHEN THE SITE HAS ACHIEVED FINAL STABILIZATION OR ANOTHER EROSION OR SEDIMENT CONTROL DEVICE IS EMPLOYED, THE CHECK DAM AND ACCUMULATED SILT SHALL BE REMOVED AND DISPOSED OF IN AN APPROVED MANNER.
5. FILTER STONE SHALL BE WRAPPED IN APPROPRIATE SIZED WIRE MESH TO CONTAIN STONE AND BURIED SIX (6") INCHES MINIMUM.

ROCK CHECK DAM


CITY OF ROCKWALL

STANDARD SPECIFICATION REFERENCE: 202.9 *

DATE: Mar. 2018

STANDARD DRAWING NO: R-1060B

Page 251

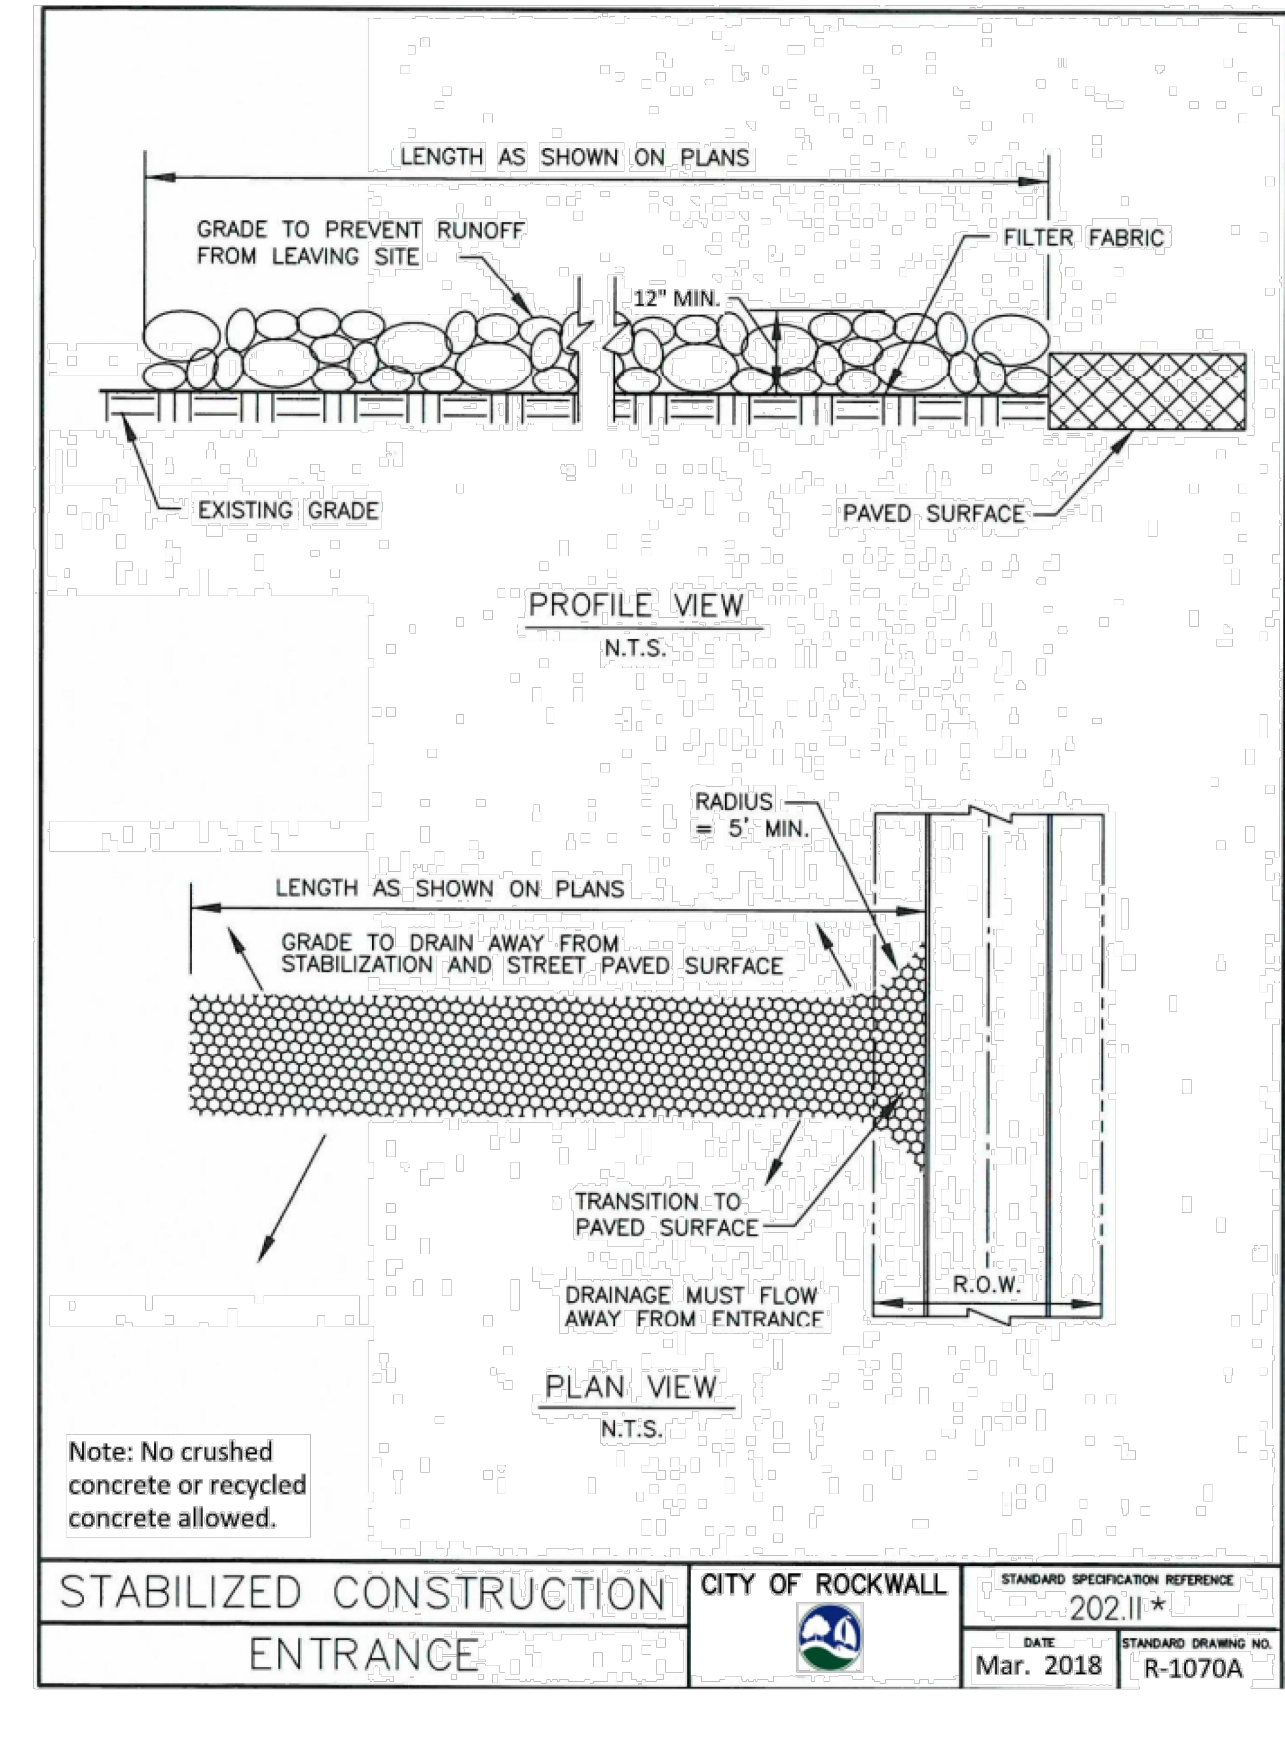

STABILIZED CONSTRUCTION ENTRANCE GENERAL NOTES:

1. STONE SHALL BE 4 TO 6 INCH DIAMETER COARSE AGGREGATE.
2. MINIMUM LENGTH SHALL BE 50 FEET AND WIDTH SHALL BE 20 FEET.
3. THE THICKNESS SHALL NOT BE LESS THAN 12 INCHES.
4. THE WIDTH SHALL BE NO LESS THAN THE FULL WIDTH OF ALL POINTS OF INGRESS OR EGRESS.
5. WHEN NECESSARY, VEHICLES SHALL BE CLEANED TO REMOVE SEDIMENT PRIOR TO ENTRANCE ONTO A PUBLIC ROADWAY. WHEN WASHING IS REQUIRED, IT SHALL BE DONE ON AN AREA STABILIZED WITH CRUSHED STONE WITH DRAINAGE FLOWING AWAY FROM BOTH THE STREET AND THE STABILIZED ENTRANCE. ALL SEDIMENT SHALL BE PREVENTED FROM ENTERING ANY STORM DRAIN, DITCH OR WATERCOURSE USING APPROVED METHODS.
6. THE ENTRANCE SHALL BE MAINTAINED IN A CONDITION WHICH WILL PREVENT TRACKING OR FLOWING OF SEDIMENT ONTO PAVED SURFACES. THIS MAY REQUIRE PERIODIC TOP DRESSING WITH ADDITIONAL STONE AS CONDITIONS DEMAND. ALL SEDIMENT SPILLED, DROPPED, WASHED, OR TRACKED ONTO PAVED SURFACES MUST BE REMOVED IMMEDIATELY.
7. THE ENTRANCE MUST BE PROPERLY GRADED OR INCORPORATE A DRAINAGE SWALE TO PREVENT RUNOFF FROM LEAVING THE CONSTRUCTION SITE.
8. PREVENT SHORTCUTTING OF THE FULL LENGTH OF THE CONSTRUCTION ENTRANCE BY INSTALLING BARRIERS AS NECESSARY.
9. INSPECTION SHALL BE AS SPECIFIED IN THE SWPPP.
10. NO CRUSHED OR RECYCLED CONCRETE ALLOWED.

STABILIZED CONSTRUCTION ENTRANCE



CITY OF ROCKWALL

STANDARD SPECIFICATION REFERENCE: 202.11 *

DATE: Mar. 2018

STANDARD DRAWING NO: R-1070B

Page 253

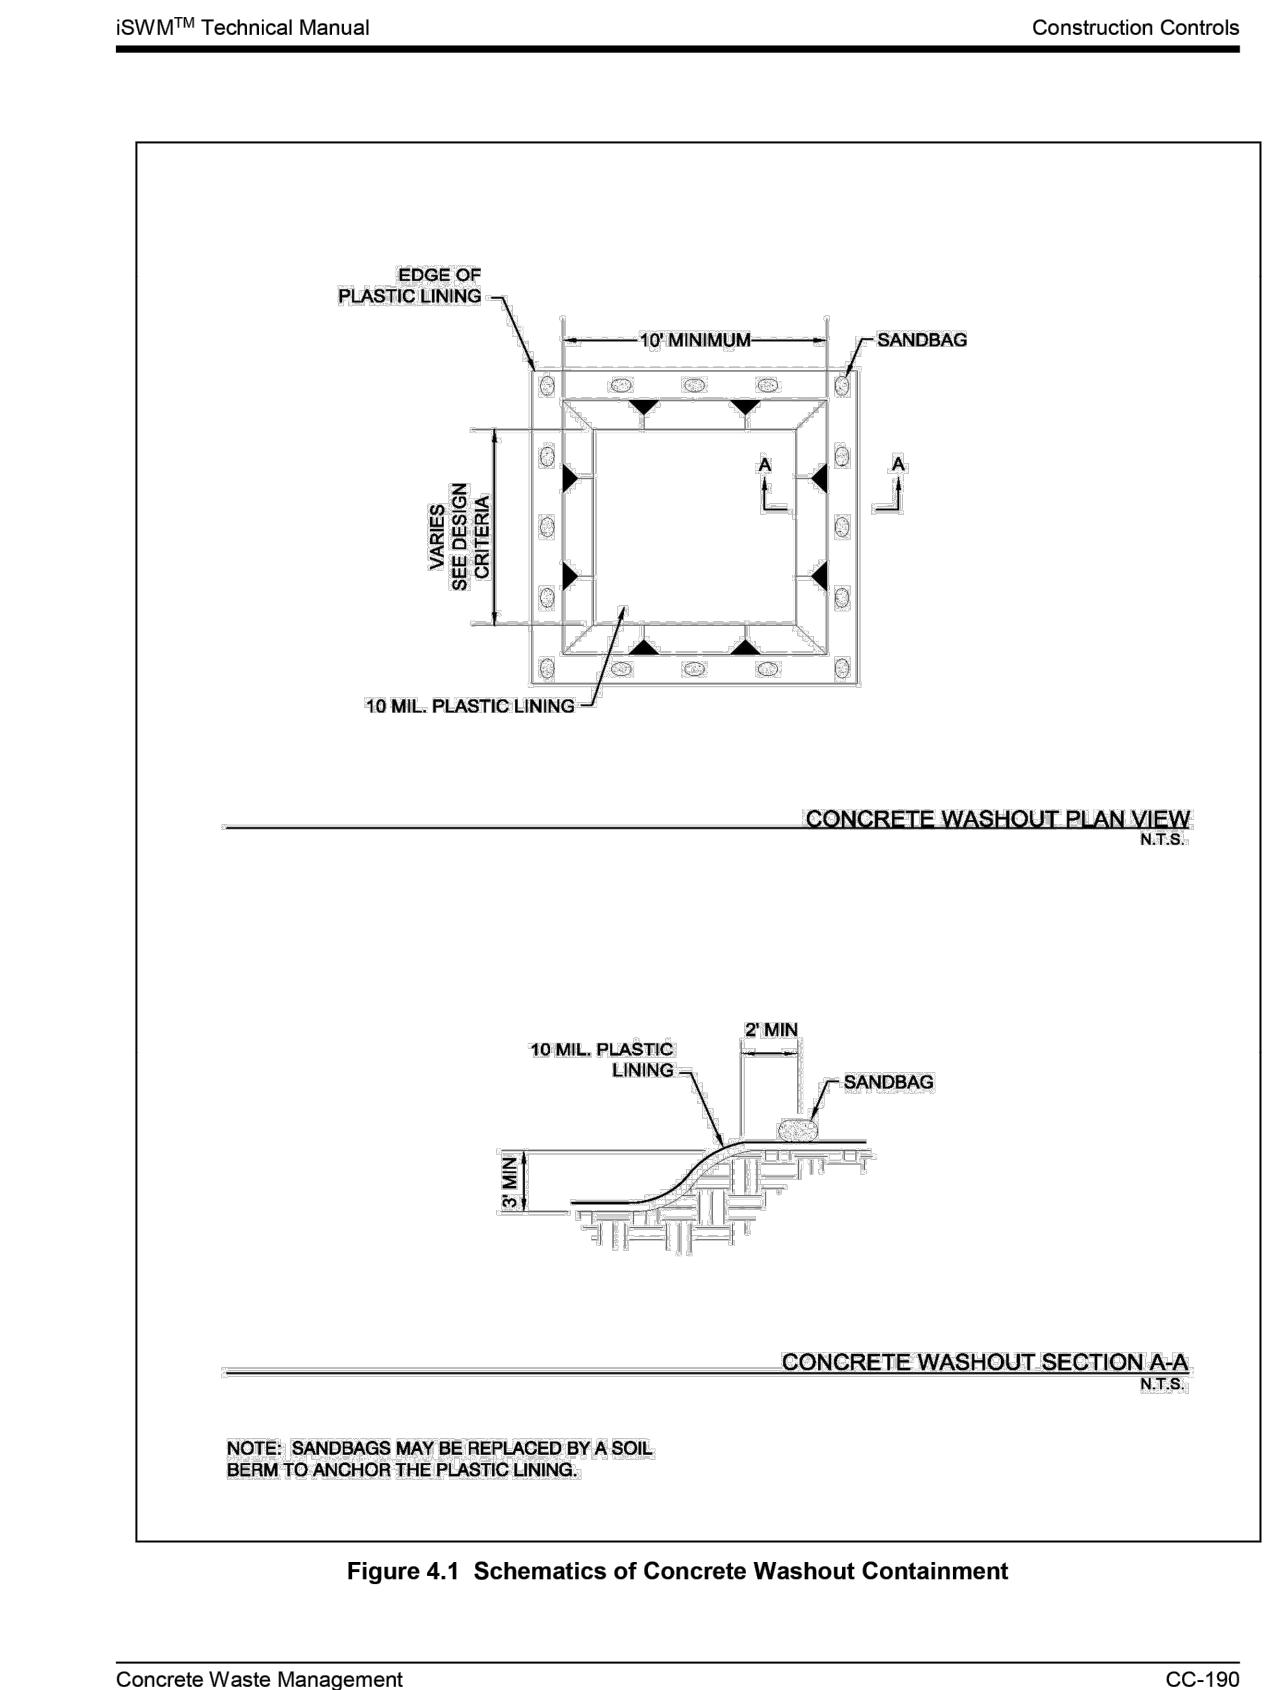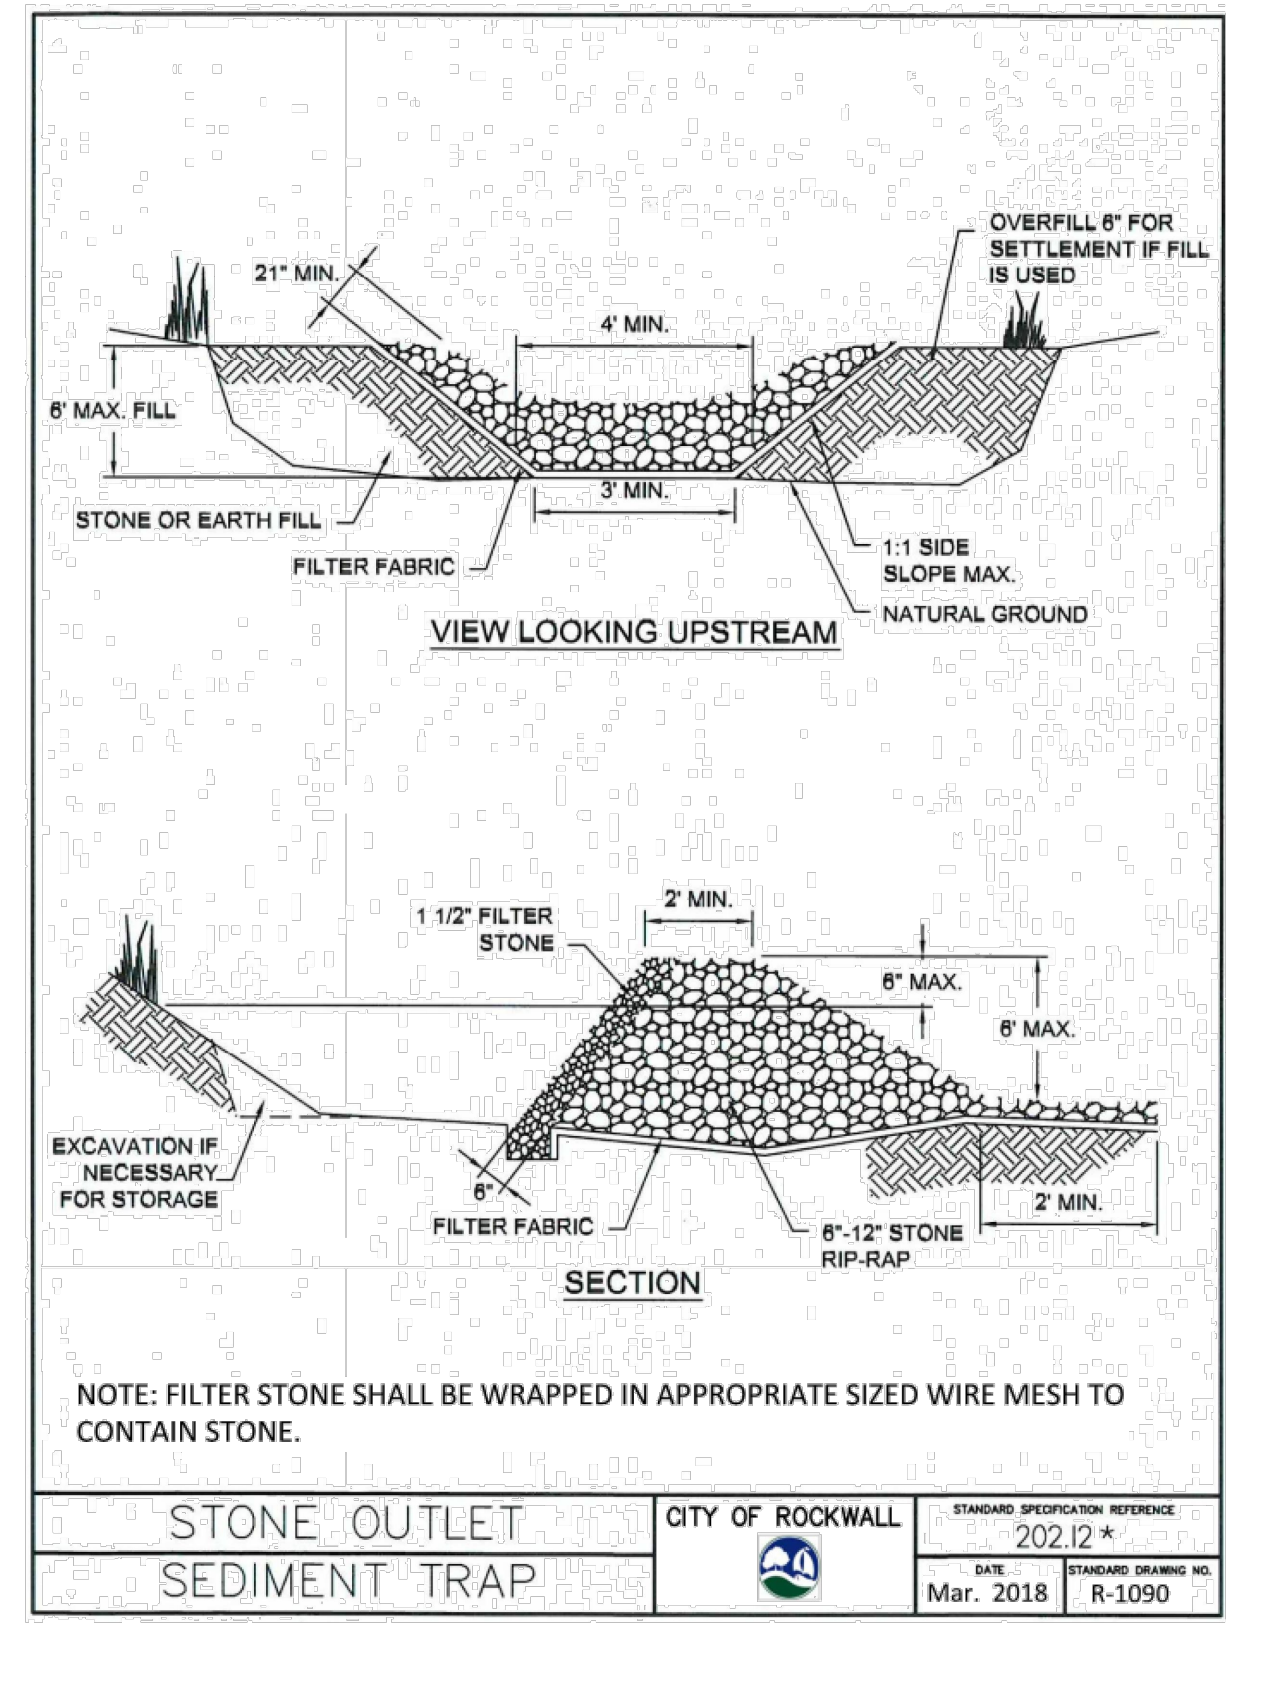

This Record Drawing is a combination of the sealed engineering contract drawings for this project, modified by revision, change order, field order and information furnished by the contractor. The information shown on the Record Drawings is believed to be accurate based on information furnished by the contractor. The original sealed drawings are on file at the office of:
 Cross Engineering Consultants
 1720 W. Virginia Street
 McKinney, Texas 75069
 (972) 562-4409
 Record Drawings Prepared On: 12/22/2023



Issued for Construction: 04-19-2021

(@ least 72 hours prior to digging)

Issue Dates:	Revisions:	Date:
5 11/30/2020	1	05/17/2021
6 12/23/2020	2	01/28/2022
7 01/22/2021	3	02/25/2022
8 01/29/2021	4	10/31/2023
9 04/19/2021	5	
10 12/22/2023	6	

CROSS ENGINEERING CONSULTANTS
 1720 W. Virginia Street
 McKinney, Texas 75069
 972.562.4409
 Texas P.E. Firm No. F-5935

Drawn By: C.E.C.I.
 Checked By: C.E.C.I.
 Scale: 1"=50'

The seal that originally appeared on this document was authorized by T. Zachary Grimes, Texas No. 122013 on 4/19/2021. Alteration of a sealed document without proper notification of the responsible Engineer is an offense under the Texas Engineering Practice Act.


EROSION CONTROL DETAILS

HARBOR HILL RESIDENCES

SUMMER LEE DRIVE
 ROCKWALL, TEXAS

Sheet No. C6.2
 Project No. 18090

HARBOR HILL RESIDENCES - ROCKWALL

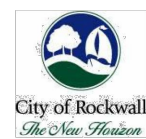


Note: Storm sewer headwalls, wingwalls, box culverts and safety pipe runners shall be per Texas Department of Transportation Standard Details and made part of the City of Rockwall Standard Details.


TxDOT Standard Drawings

Drawings shall be modified as follows:

1. All concrete for structures shall be Class F (4200 psi, minimum 7.0 sack cement).
2. No fly ash is allowed in concrete for structures.

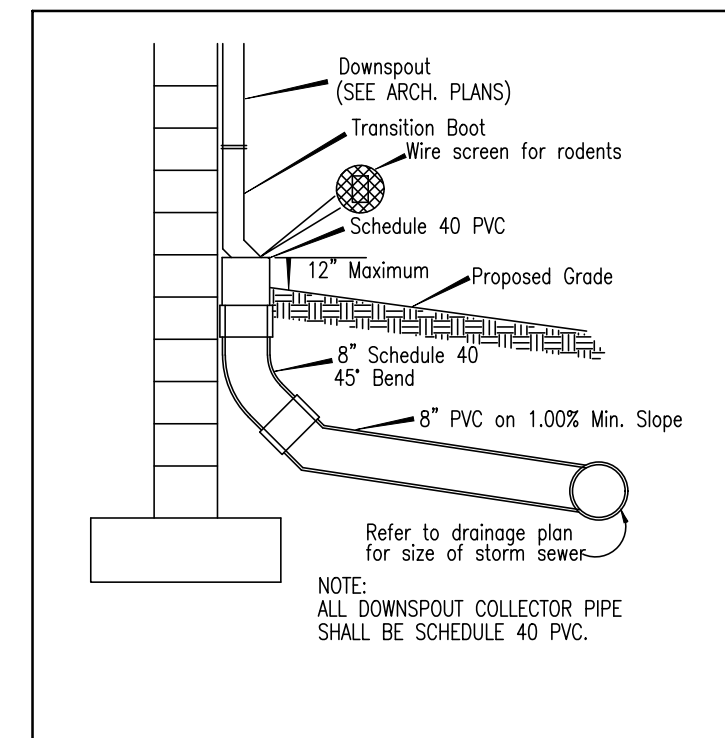


DOWNSPOUT DETAIL
NOT TO SCALE

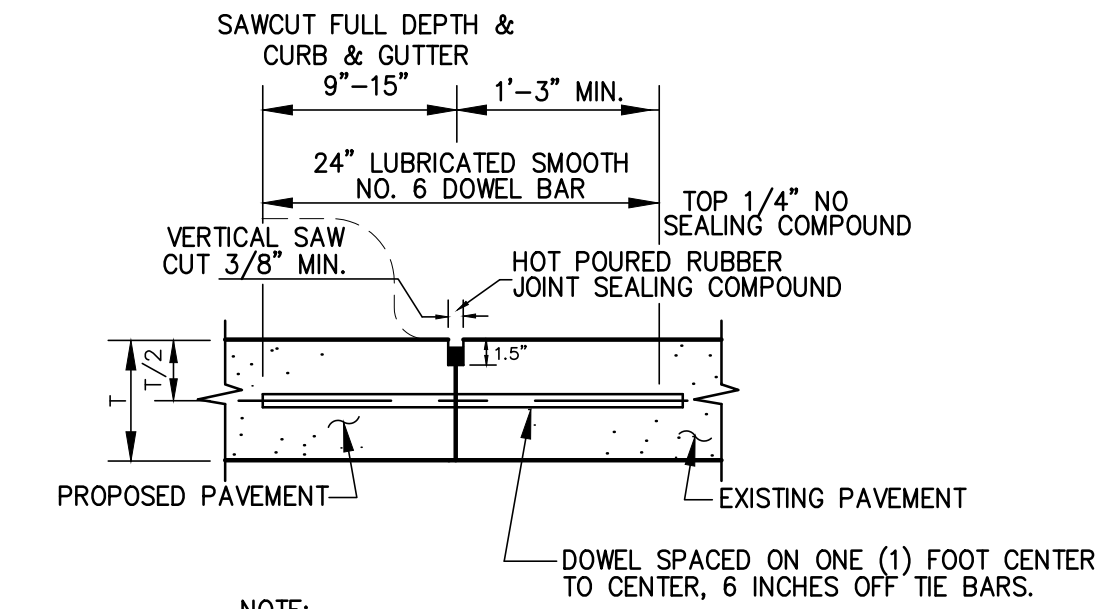


LONGITUDINAL BUTT JOINT

- NOTE: DOWELS AND REINFORCING BARS SHALL BE SUPPORTED BY AN APPROVED DEVICE.
- N.T.S.
1. NO. 5 SMOOTH DOWEL BAR MAY BE USED IN 5 INCH AND 6 INCH PAVEMENT THICKNESS.
 2. LONGITUDINAL BUTT CONSTRUCTION MAY BE UTILIZED IN PLACE OF LONGITUDINAL HINGED (KEYWAY) JOINT AT CONTRACTORS OPTION.
 3. DOWEL BARS SHALL BE DRILLED INTO PAVEMENT HORIZONTALLY BY USE OF A MECHANICAL RIG.
 4. DRILLED BY HAND IS NOT ACCEPTABLE. PUSHING DOWEL BARS INTO GREEN CONCRETE NOT ACCEPTABLE.

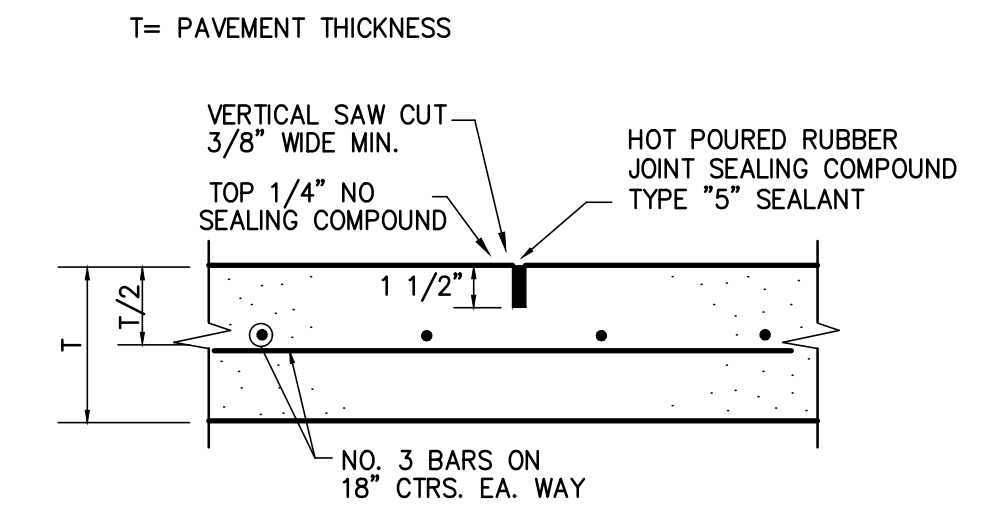


SAWED DUMMY (CONTROL) JOINT


MAXIMUM SPACING IS 15' CTRS. (TYP.)

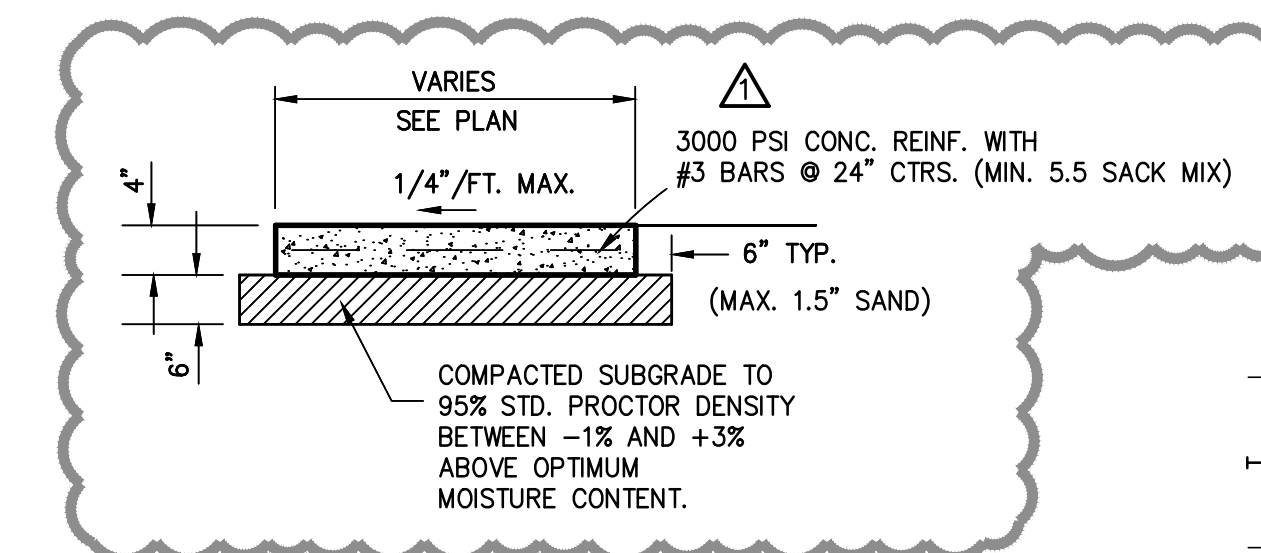


SIDEWALK DETAIL
N.T.S.

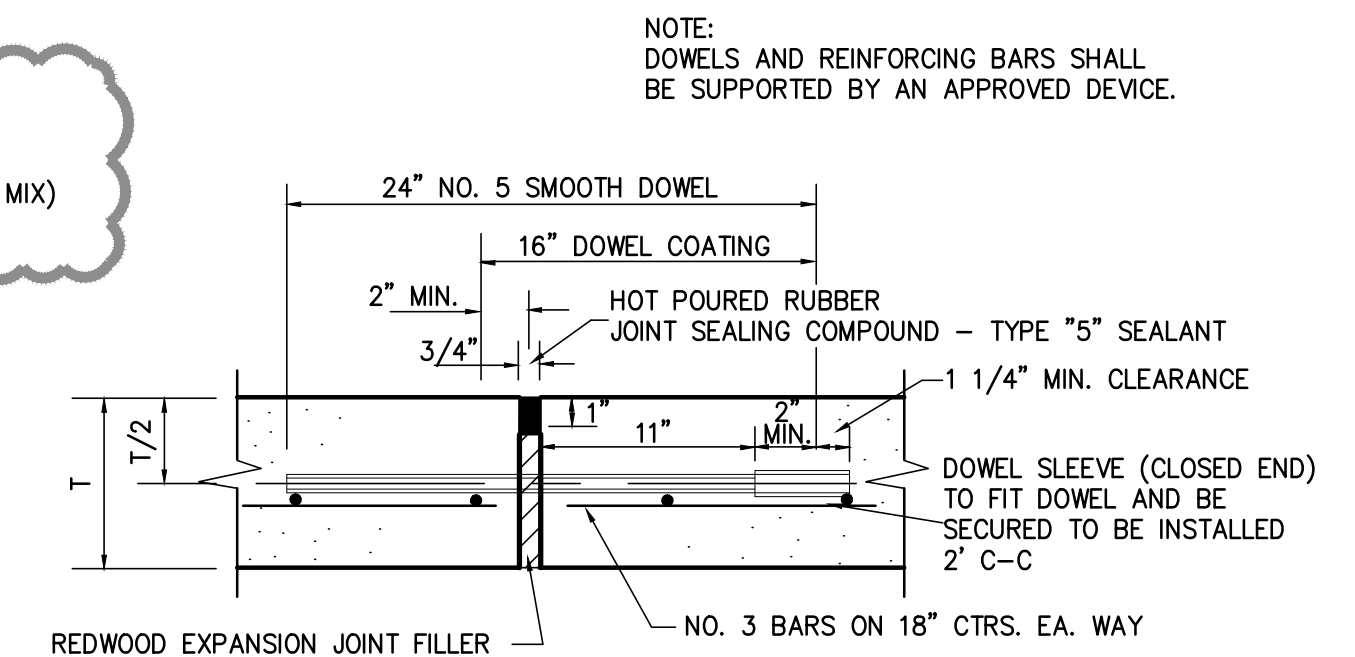

EXPANSION JOINT

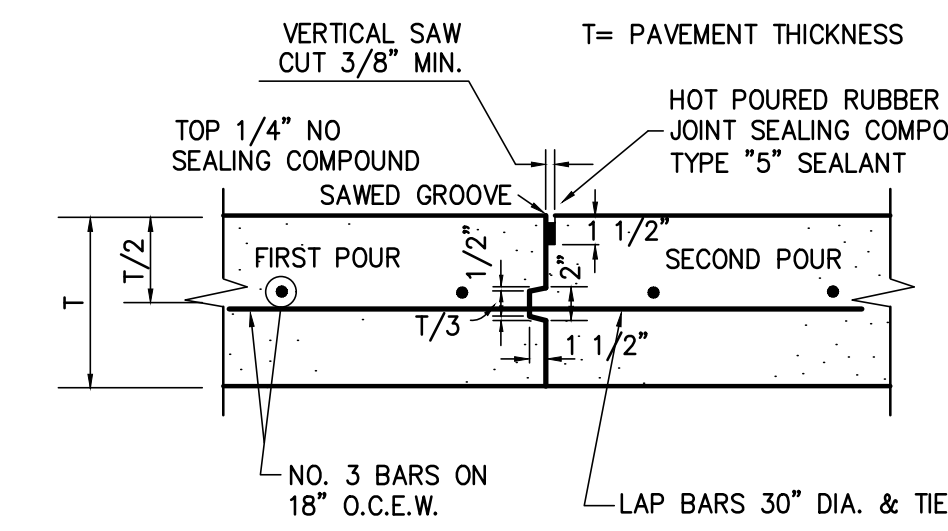

CONSTRUCTION JOINT

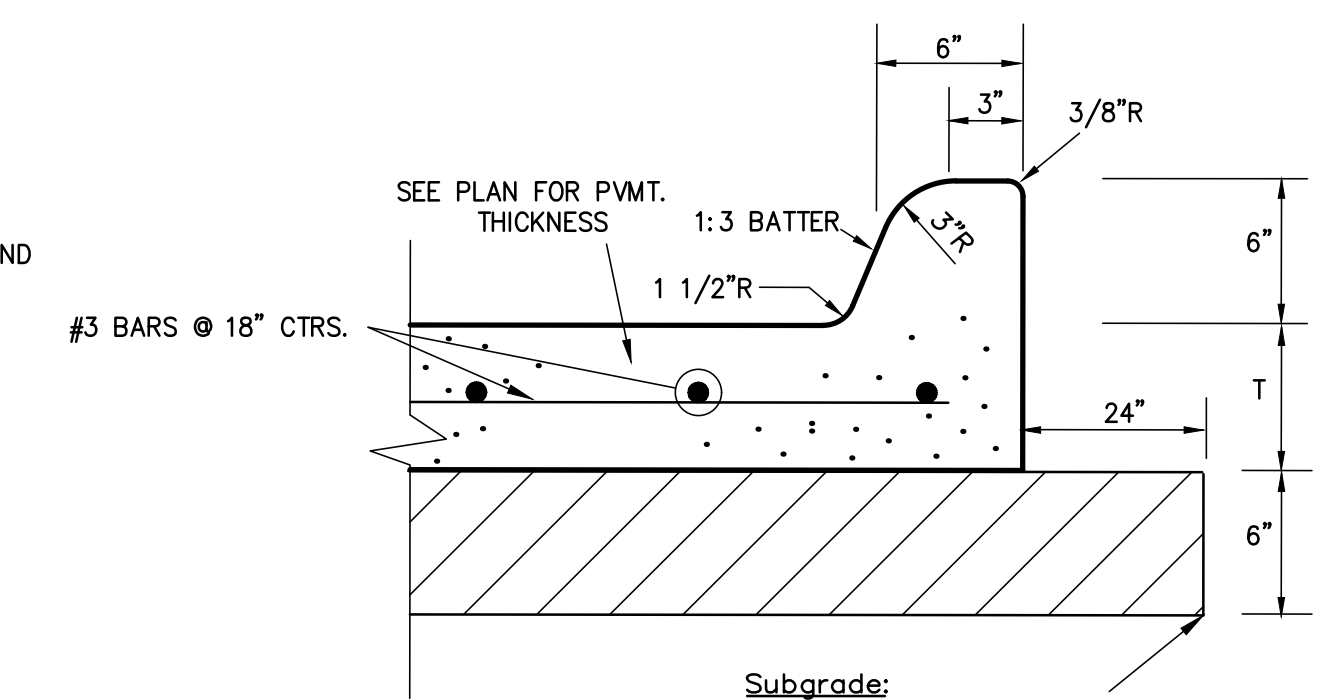

PAVEMENT SECTION WITH CURB

This Record Drawing is a combination of the sealed engineering contract drawings for this project, modified by revision, change order, field order and information furnished by the contractor. The information shown on the Record Drawings is believed to be accurate based on information furnished by the contractor. The original sealed drawings are on file at the office of:
Cross Engineering Consultants
 1720 W. Virginia Street
 McKinney, Texas 75069
 (972) 562-4409
 Record Drawings Prepared On:
 12/22/2023

Note: All materials and construction shall be in accordance with the City of Rockwall Standard Specifications and Construction Standards, and Standard Specifications for Public Works Construction prepared by North Central Texas Council of Governments (Latest Revision), and to the regulations of the Texas Commission on Environmental Quality.

Revised Sidewalk Details

Issue Dates:	Revisions:	Date:
5 11/30/2020	1	05/17/2021
6 12/23/2020	2	01/28/2022
7 01/22/2021	3	02/25/2022
8 01/29/2021	4	10/31/2023
9 04/19/2021	5	
10 12/22/2023	6	

CROSS ENGINEERING CONSULTANTS

1720 W. Virginia Street
 972.562.4409
 McKinney, Texas 75069
 Texas P.E. Firm No. F-5935







Drawn By: C.E.C.I.
 Checked By: C.E.C.I.
 Scale:

Issued for Construction: 04-19-2021

The seal that originally appeared on this document was authorized by T. Zachary Grimes, Texas No. 122013 on 5/17/2021. Alteration of a sealed document without proper notification of the responsible Engineer is an offense under the Texas Engineering Practice Act.

CONSTRUCTION DETAILS
HARBOR HILL RESIDENCES
 SUMMER LEE DRIVE
 ROCKWALL, TEXAS

Sheet No.
C7.1
 Project No.
 18090

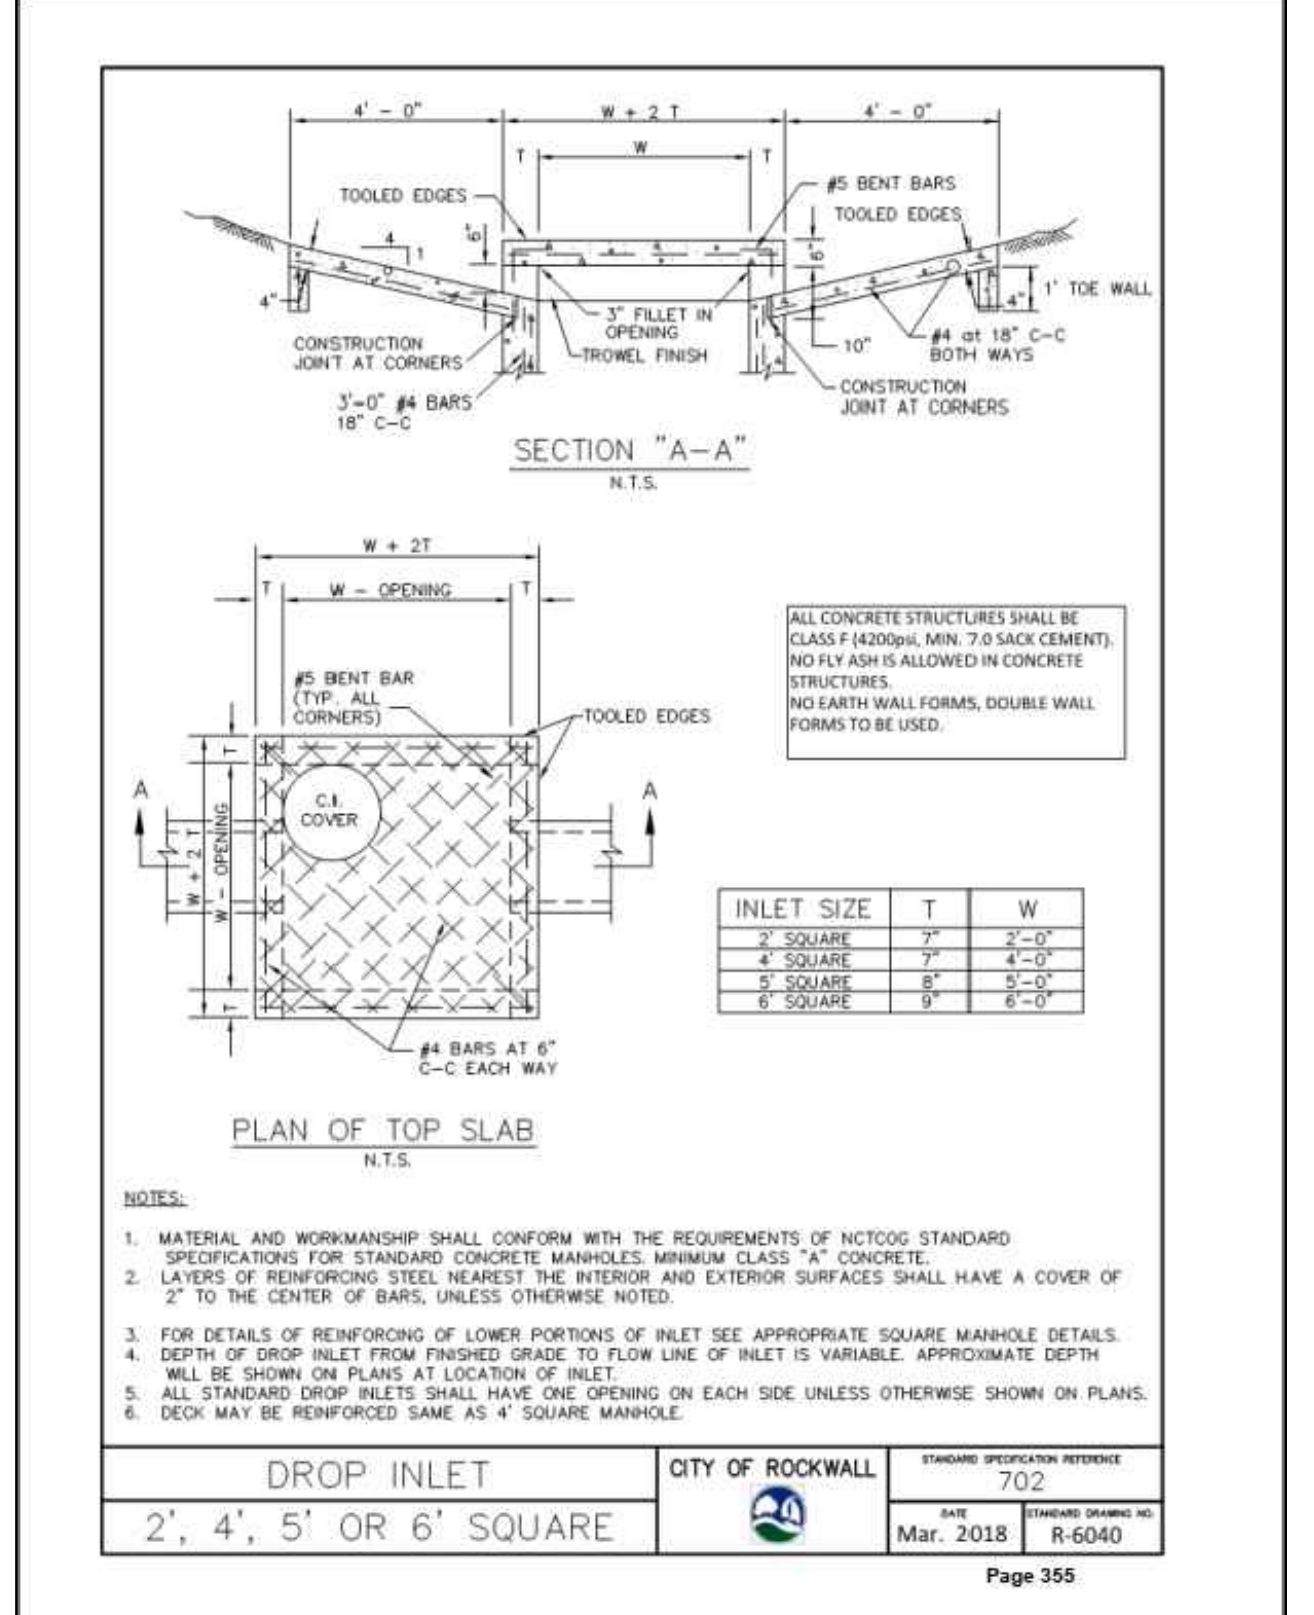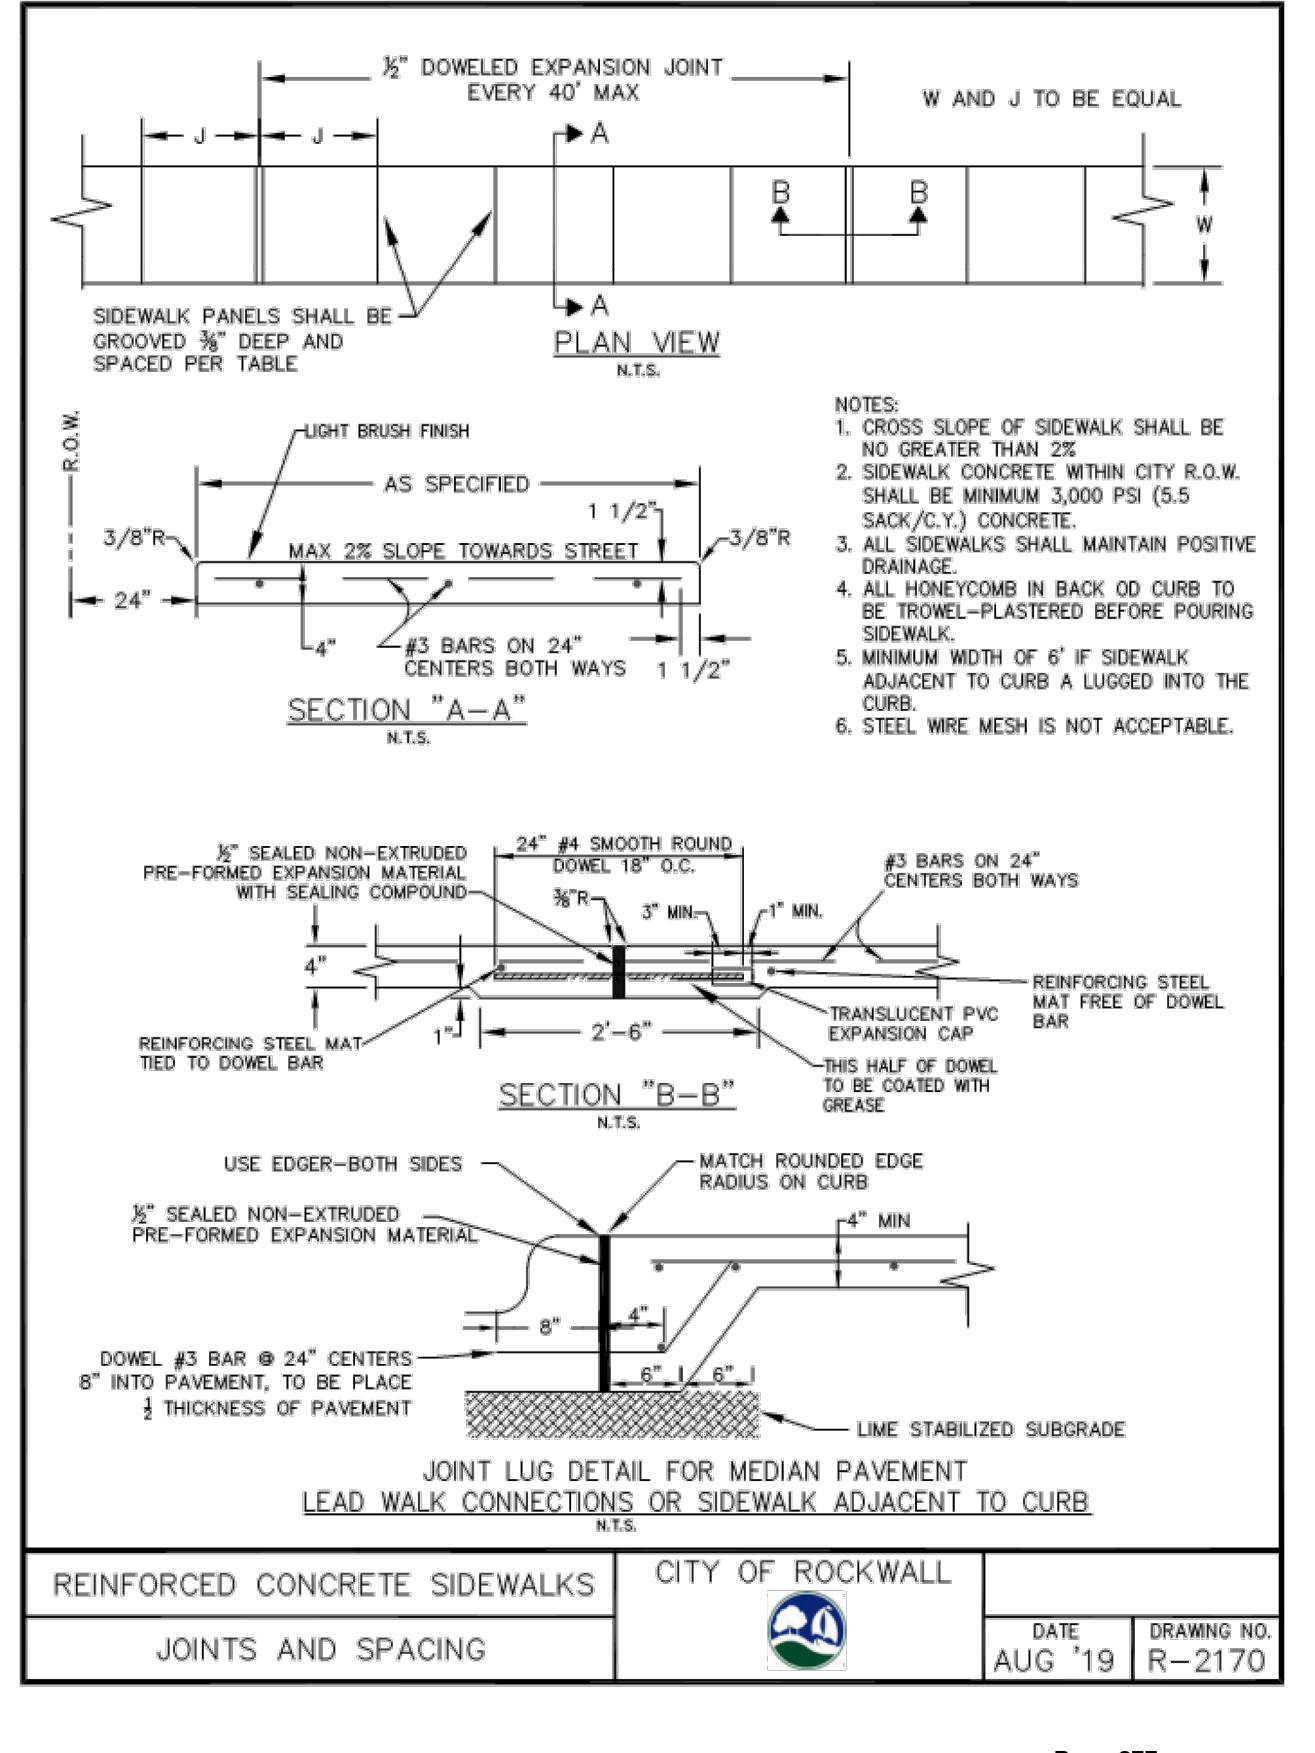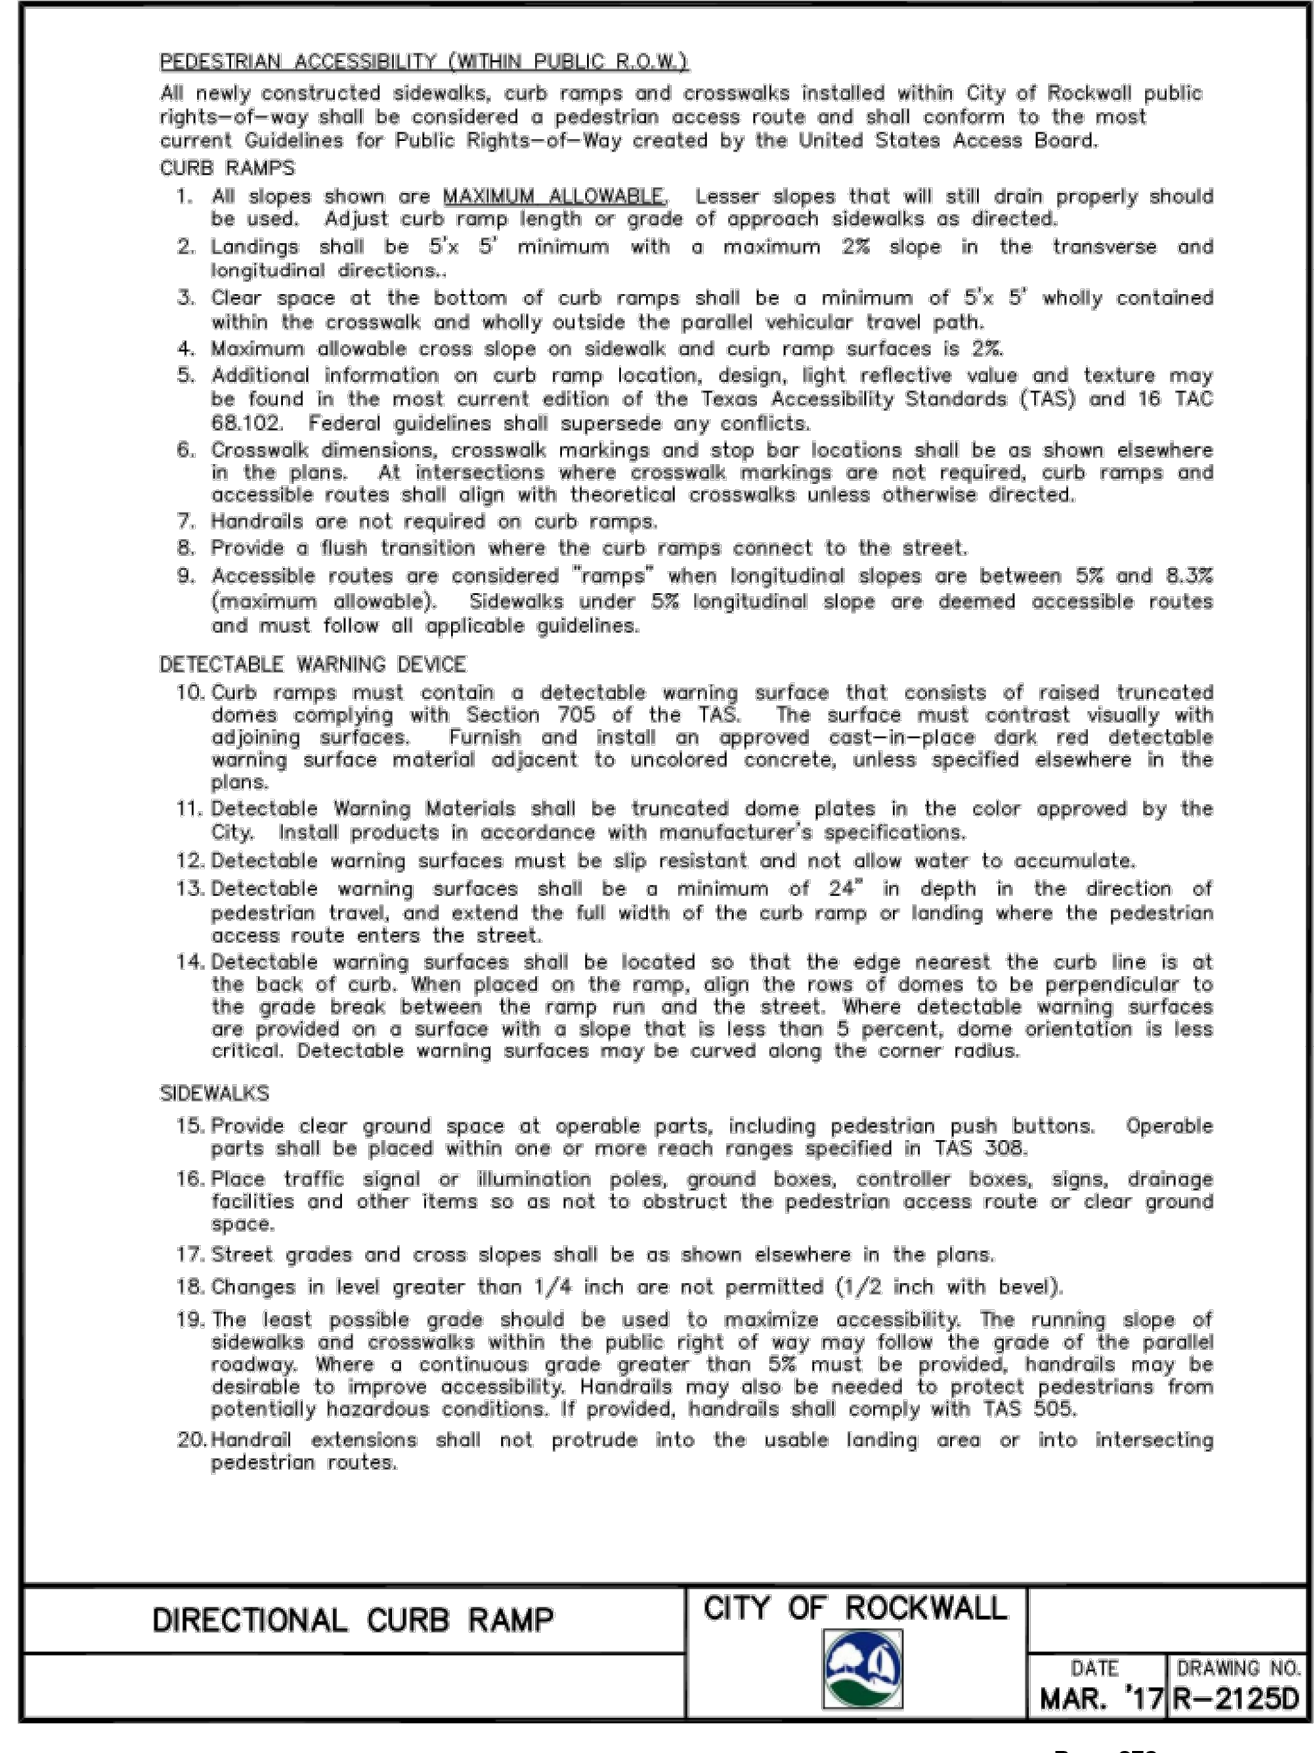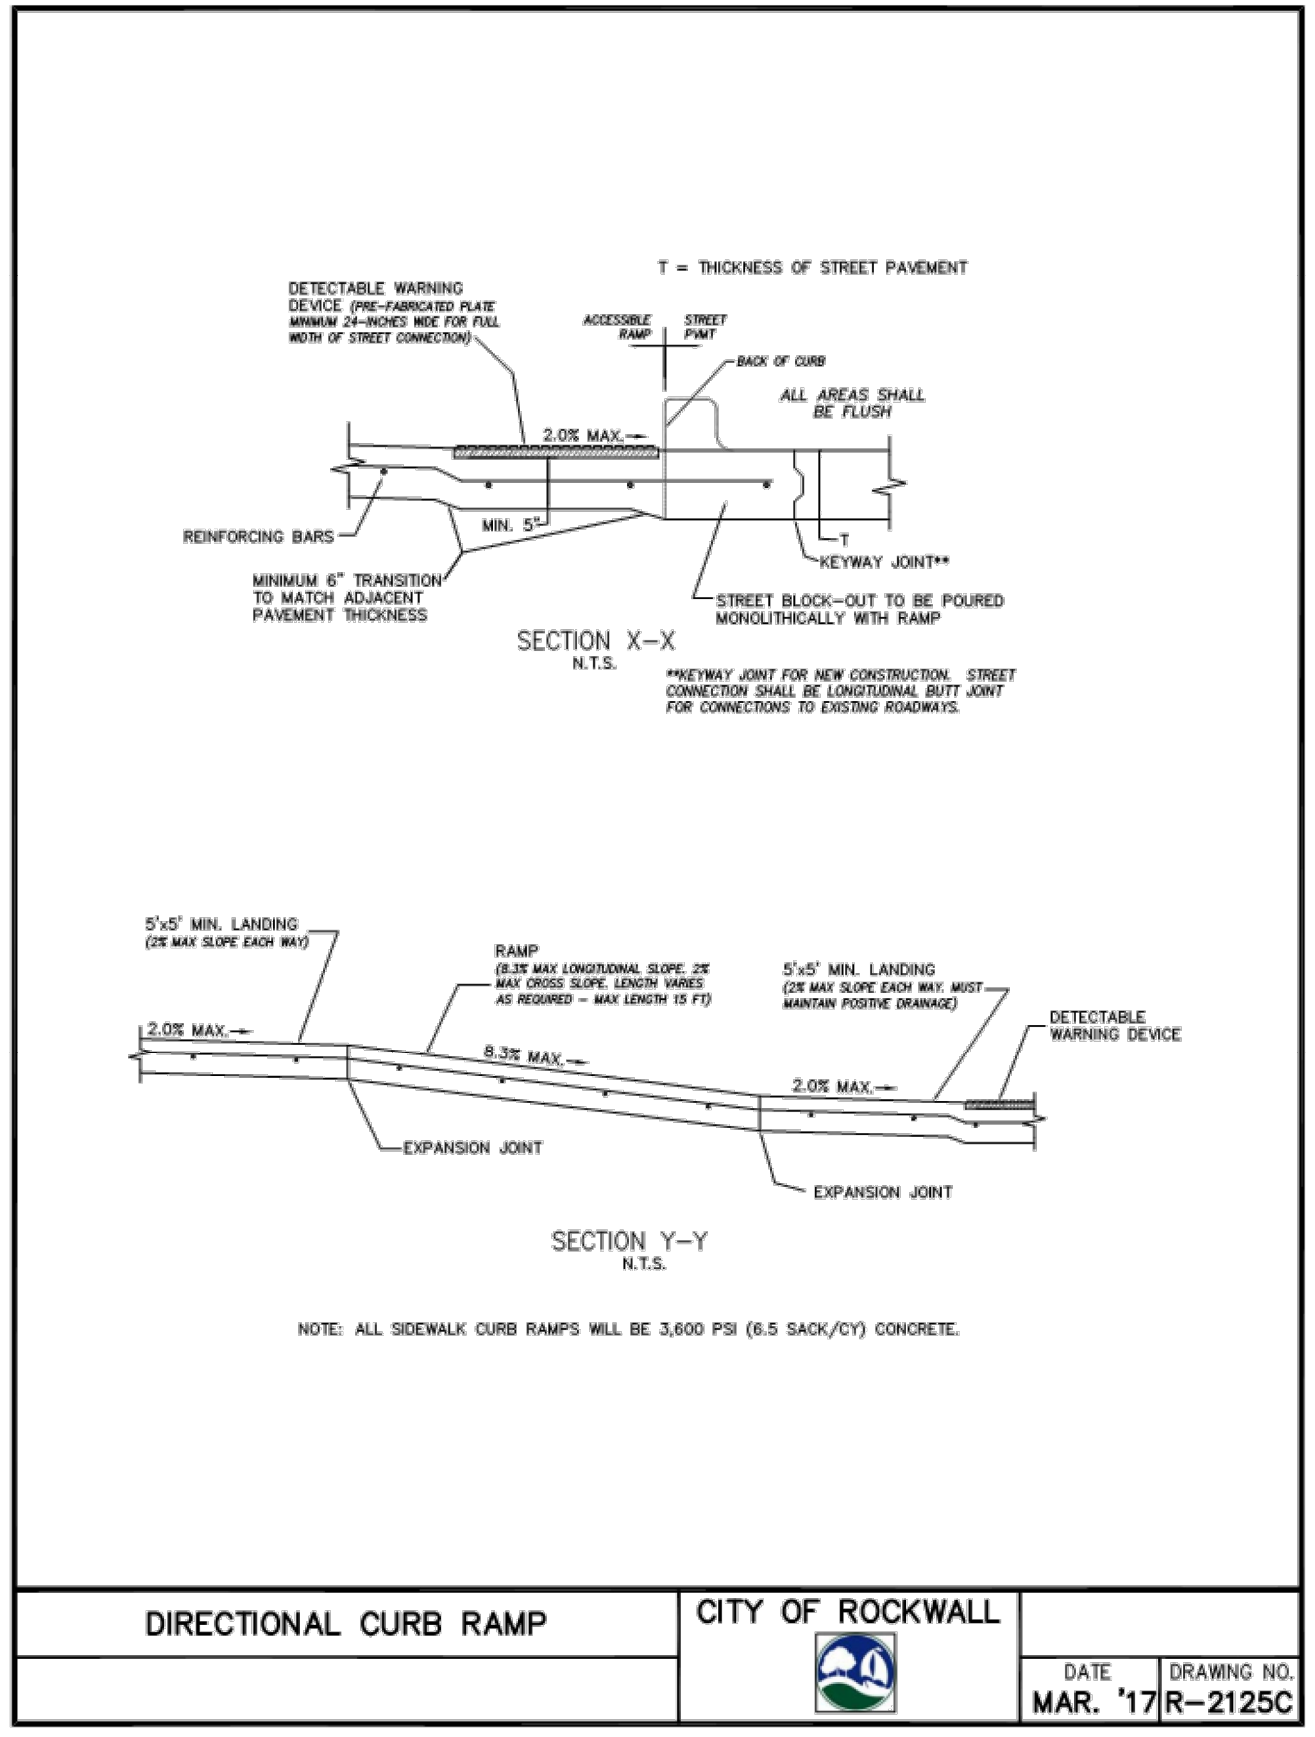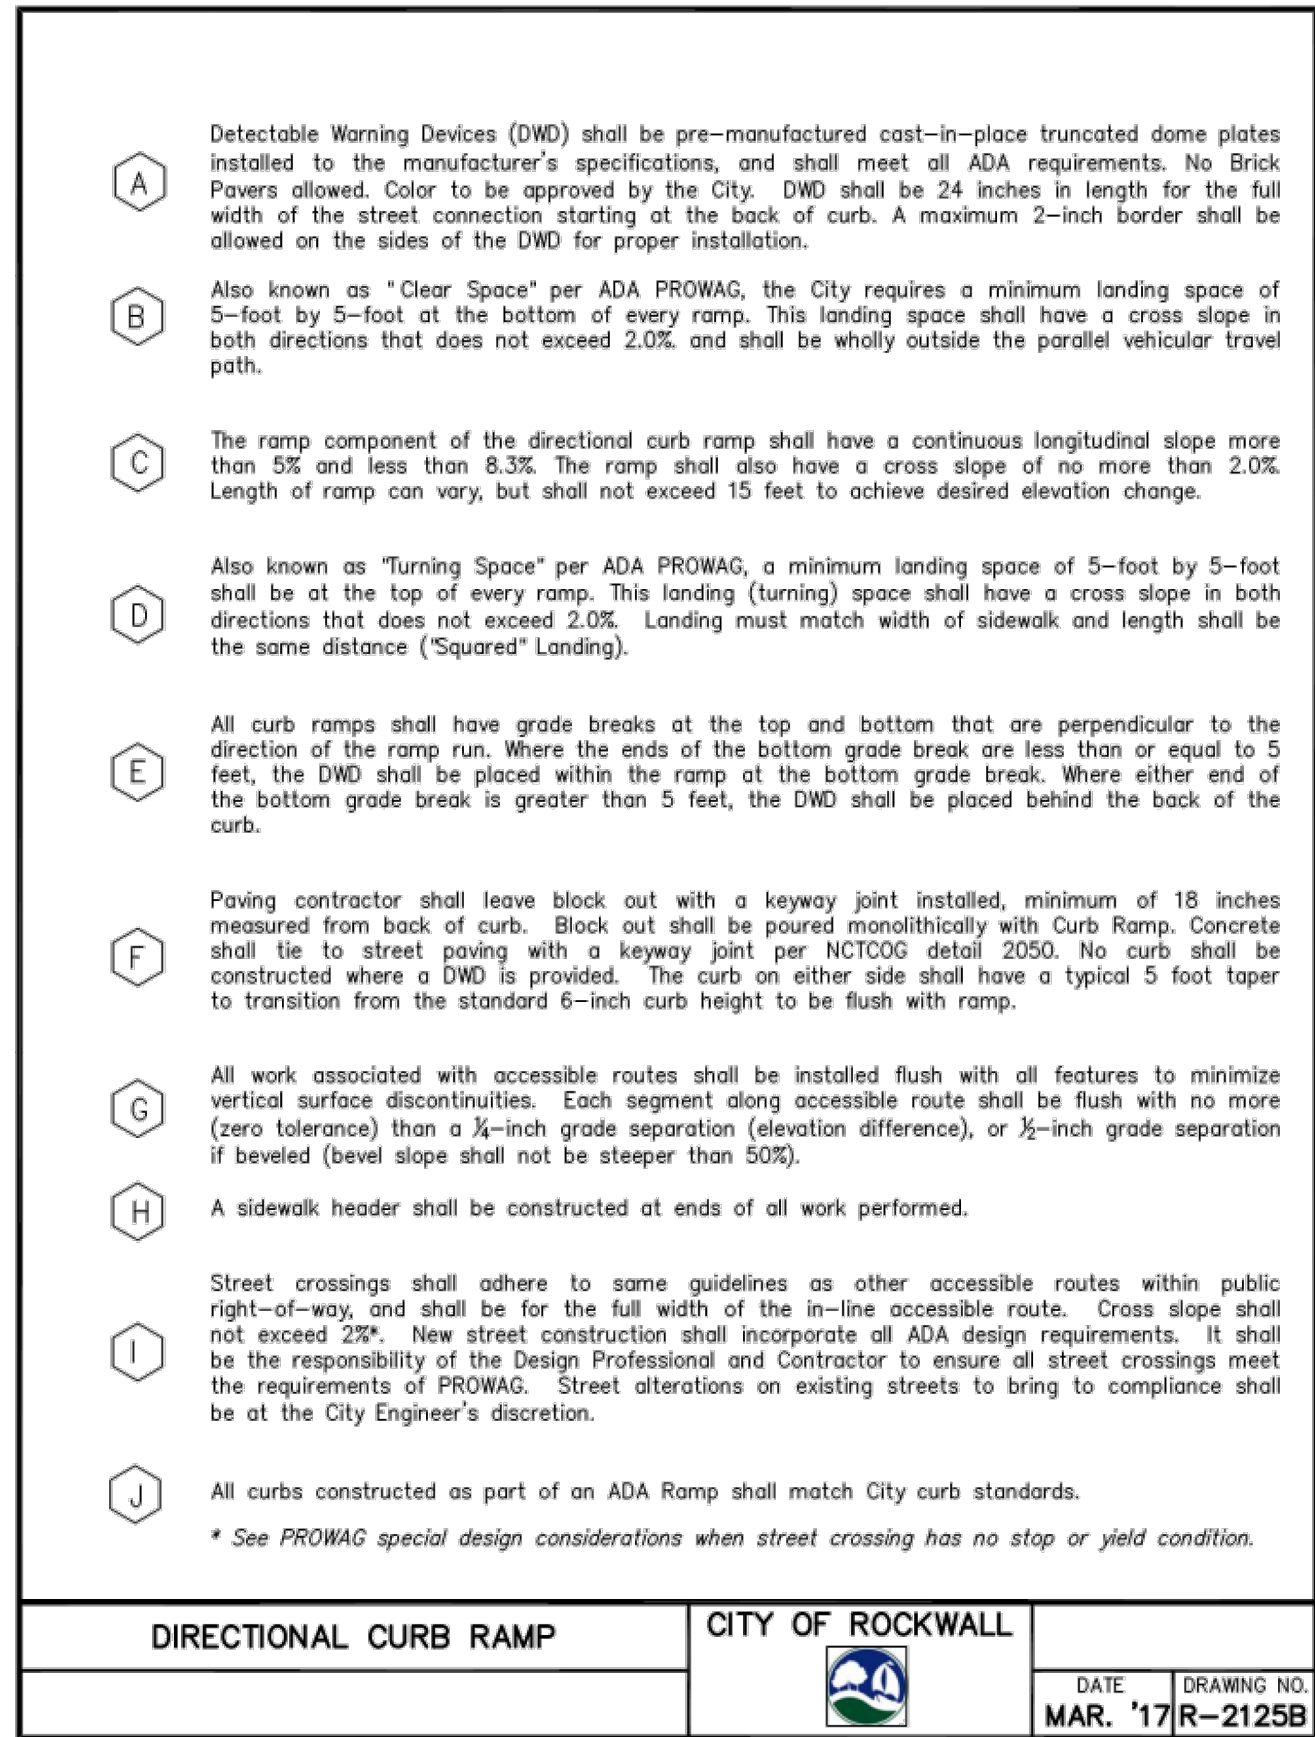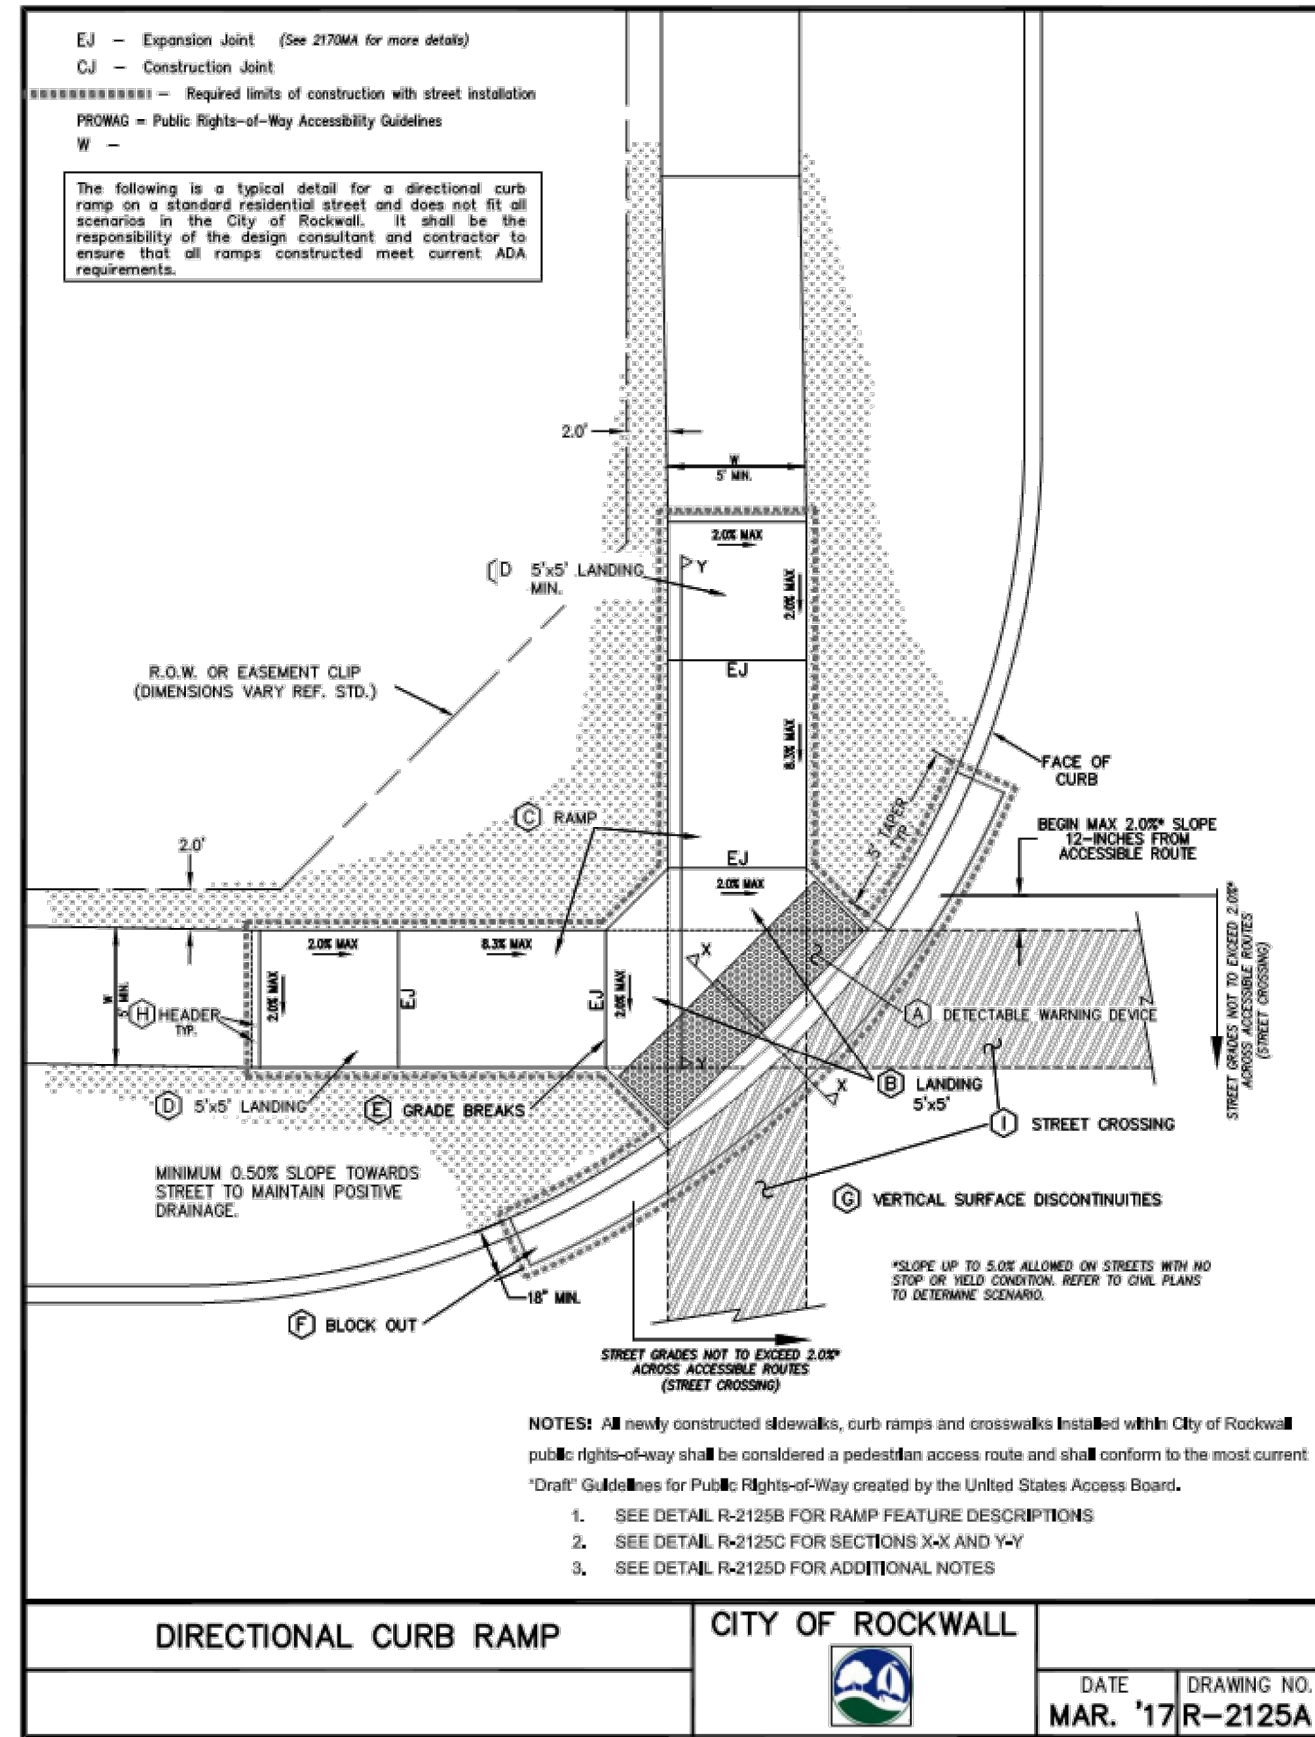

Note: All materials and construction shall be in accordance with the City of Rockwall Standard Specifications and Construction Standards, and Standard Specifications for Public Works Construction prepared by North Central Texas Council of Governments (Latest Revision), and to the regulations of the Texas Commission on Environmental Quality.

This Record Drawing is a combination of the sealed engineering contract drawings for this project, modified by revision, change order, field order and information furnished by the contractor. The information shown on the Record Drawings is believed to be accurate based on information furnished by the contractor. The original sealed drawings are on file at the office of:
Cross Engineering Consultants
1720 W. Virginia Street
McKinney, Texas 75069
(972) 562-4409
Record Drawings Prepared On:
12/22/2023

Issue Dates:	Revisions:	Date:
5 11/30/2020	1	05/17/2021
6 12/23/2020	2	01/28/2022
7 01/22/2021	3	02/25/2022
8 01/29/2021	4	10/31/2023
9 04/19/2021	5	
10 12/22/2023	6	

CROSS ENGINEERING CONSULTANTS
1720 W. Virginia Street
972.562.4409
McKinney, Texas 75069
Texas P.E. Firm No. F-5395

Drawn By: C.E.C.I.
Checked By: C.E.C.I.
Scale:

The seal that originally appeared on this document was authorized by Zachary Grimes, Texas No. 122013 on 4/19/2021. Alteration of a sealed document without proper notification of the responsible Engineer is an offense under the Texas Engineering Practice Act.

Issued for Construction: 04-19-2021

CONSTRUCTION DETAILS
HARBOR HILL RESIDENCES
SUMMER LEE DRIVE
ROCKWALL, TEXAS

Sheet No.
C7.2
Project No.
18090

HARBOR HILL RESIDENCES - ROCKWALL




LANDSCAPE REQUIREMENTS
THIS PLAN MEETS OR EXCEEDS THE FOLLOWING STANDARDS:
PD-32 HARBOR DISTRICT INTERIOR SUBDISTRICT
LOT INFO
TOTAL SITE AREA: 3.97 AC (173,010 S.F.) TOTAL DEVELOPED AREA: 3.97 AC (173,010 S.F.) TOTAL IMPERVIOUS SURFACE: 123,980 S.F. (72%) TOTAL PERVIOUS SURFACE: 49,030 S.F. (28%)
LANDSCAPE PERCENTAGE
REQUIRED: 25% LANDSCAPE PERCENTAGE 173,010 S.F. X 25% = 43,252 S.F. (0.99 AC) PROVIDED: 49,030 S.F. (28%)
PARKING LOT LANDSCAPE
REQUIRED: (1) TREE PER 8 SURFACE PARKING SPOTS 17 SURFACE PARKING / 8 = 2.1 TREES PROVIDED: (4) TREES
PARKING GARAGES
REQUIRED: A MINIMUM OF 25% OF EXPOSED GARAGE FACADE MUST BE SCREENED WITH VINES ON A GREENSCREEN OR CABLE TYPE SYSTEM PROVIDED: 25%+ EXPOSED GARAGE FACADE SCREENED WITH VINES
STREET FRONTAGE
REQUIRED: 8' SIDEWALK WITH 5' X 10' TREE LEAVE-OUTS 30' O.C. SUMMER LEE DR. TO USE CEDAR ELM TREES ALONG R.O.W. PROVIDED: (4) TREES IN 5' X 10' TREE LEAVEOUTS

IRRIGATION NOTES
THE OWNER SHALL BE RESPONSIBLE FOR THE HEALTH AND VITALITY OF PLANT MATERIAL THROUGH IRRIGATION OF ALL LANDSCAPED AREAS, TURF AND PLANT MATERIALS, AND SHALL:
1. PROVIDE A MOISTURE LEVEL IN AN AMOUNT AND FREQUENCY ADEQUATE TO SUSTAIN GROWTH OF THE PLANT MATERIALS ON A PERMANENT BASIS.
2. BE IN PLACE AND OPERATIONAL AT THE TIME OF THE LANDSCAPE INSPECTION FOR CERTIFICATE OF OCCUPANCY.
3. BE MAINTAINED AND KEPT OPERATIONAL AT ALL TIMES TO PROVIDE FOR EFFICIENT WATER DISTRIBUTION.
COMPLIANCE WITH STATE LAW: ALL IRRIGATION SYSTEMS SHALL COMPLY WITH THE IRRIGATION CODE OF CHAPTER 10, ARTICLE XVI OF THE CITY OF ROCKWALL CODE OF ORDINANCES, AND ALL APPLICABLE STATE LAWS, AS MAY BE AMENDED.

GENERAL NOTES
NO TREES WITHIN 5' OF UTILITIES.


FURNITURE SCHEDULE
6" BENCH
COLLECTION: SCARBOROUGH MODEL: 72" WITH CENTER ARM COLOR: BLACK QUANTITY: (2)
TRASH RECEPTACLE
COLLECTION: SCARBOROUGH MODEL: SIDE OPENING / VERTICAL STRAP COLOR: BLACK QUANTITY: (2)
*Surface mount all equipment per manufacturer's specifications
LANDSCAPE FORMS WWW.LANDSCAPEFORMS.COM

PLANT LIST					
SYM.	QTY.	BOTANICAL NAME	COMMON NAME	SIZE	REMARKS
SHADE TREES					
BC	13	Taxodium distichum	Bald Cypress	4"-4.5" Cal.	16'-18' Ht.
LO	21	Quercus virginiana	Live Oak	4"-4.5" Cal.	14'-16' Ht.
CE	21	Ulmus crassifolia	Cedar Elm	4"-4.5" Cal.	12'-14' Ht.
RO	17	Quercus shumardii	Red Oak	4"-4.5" Cal.	14'-16' Ht.

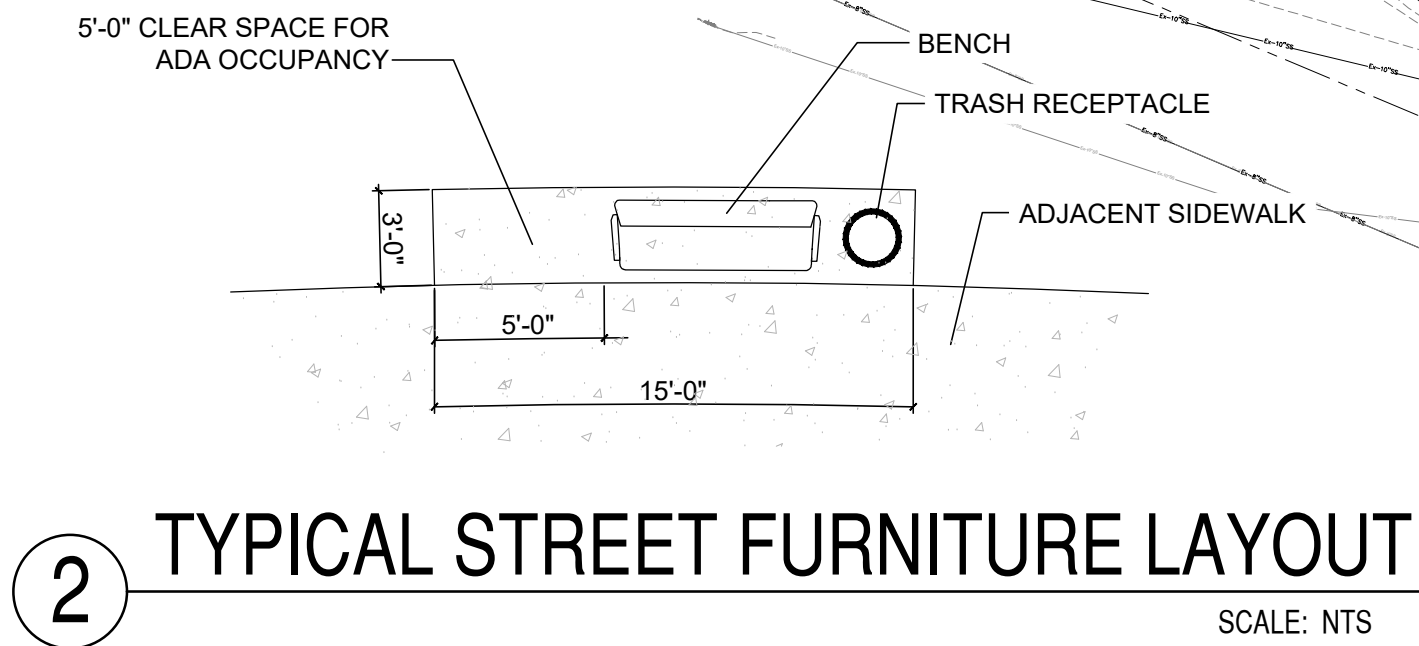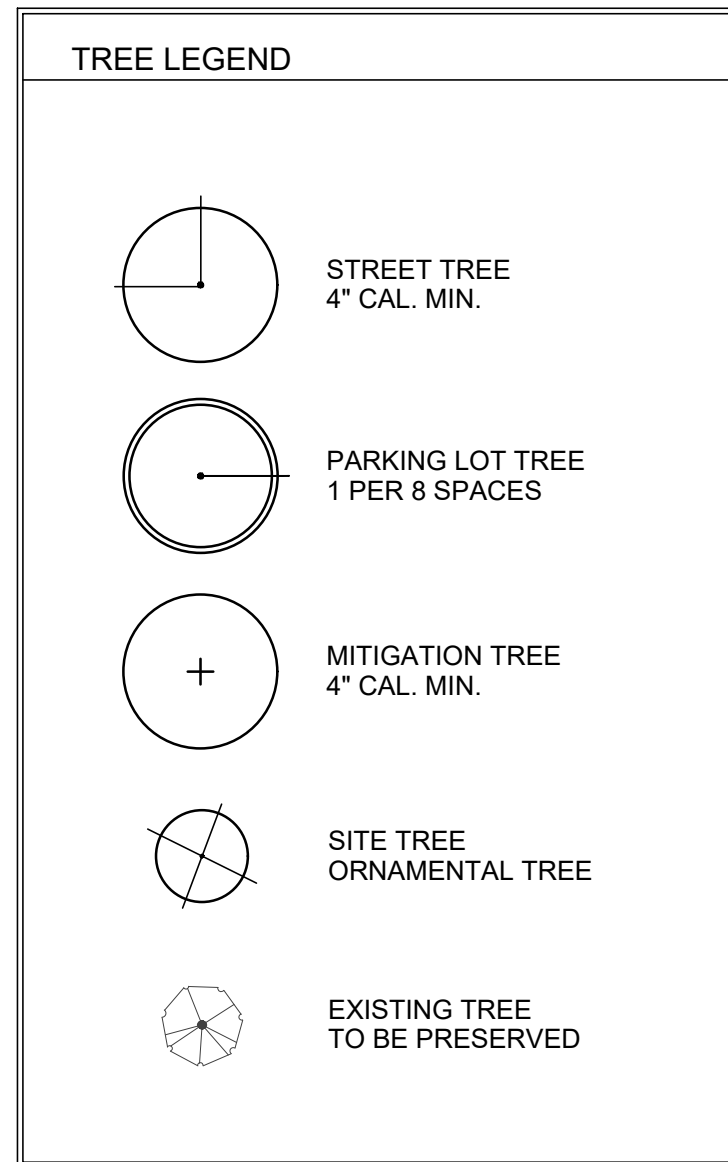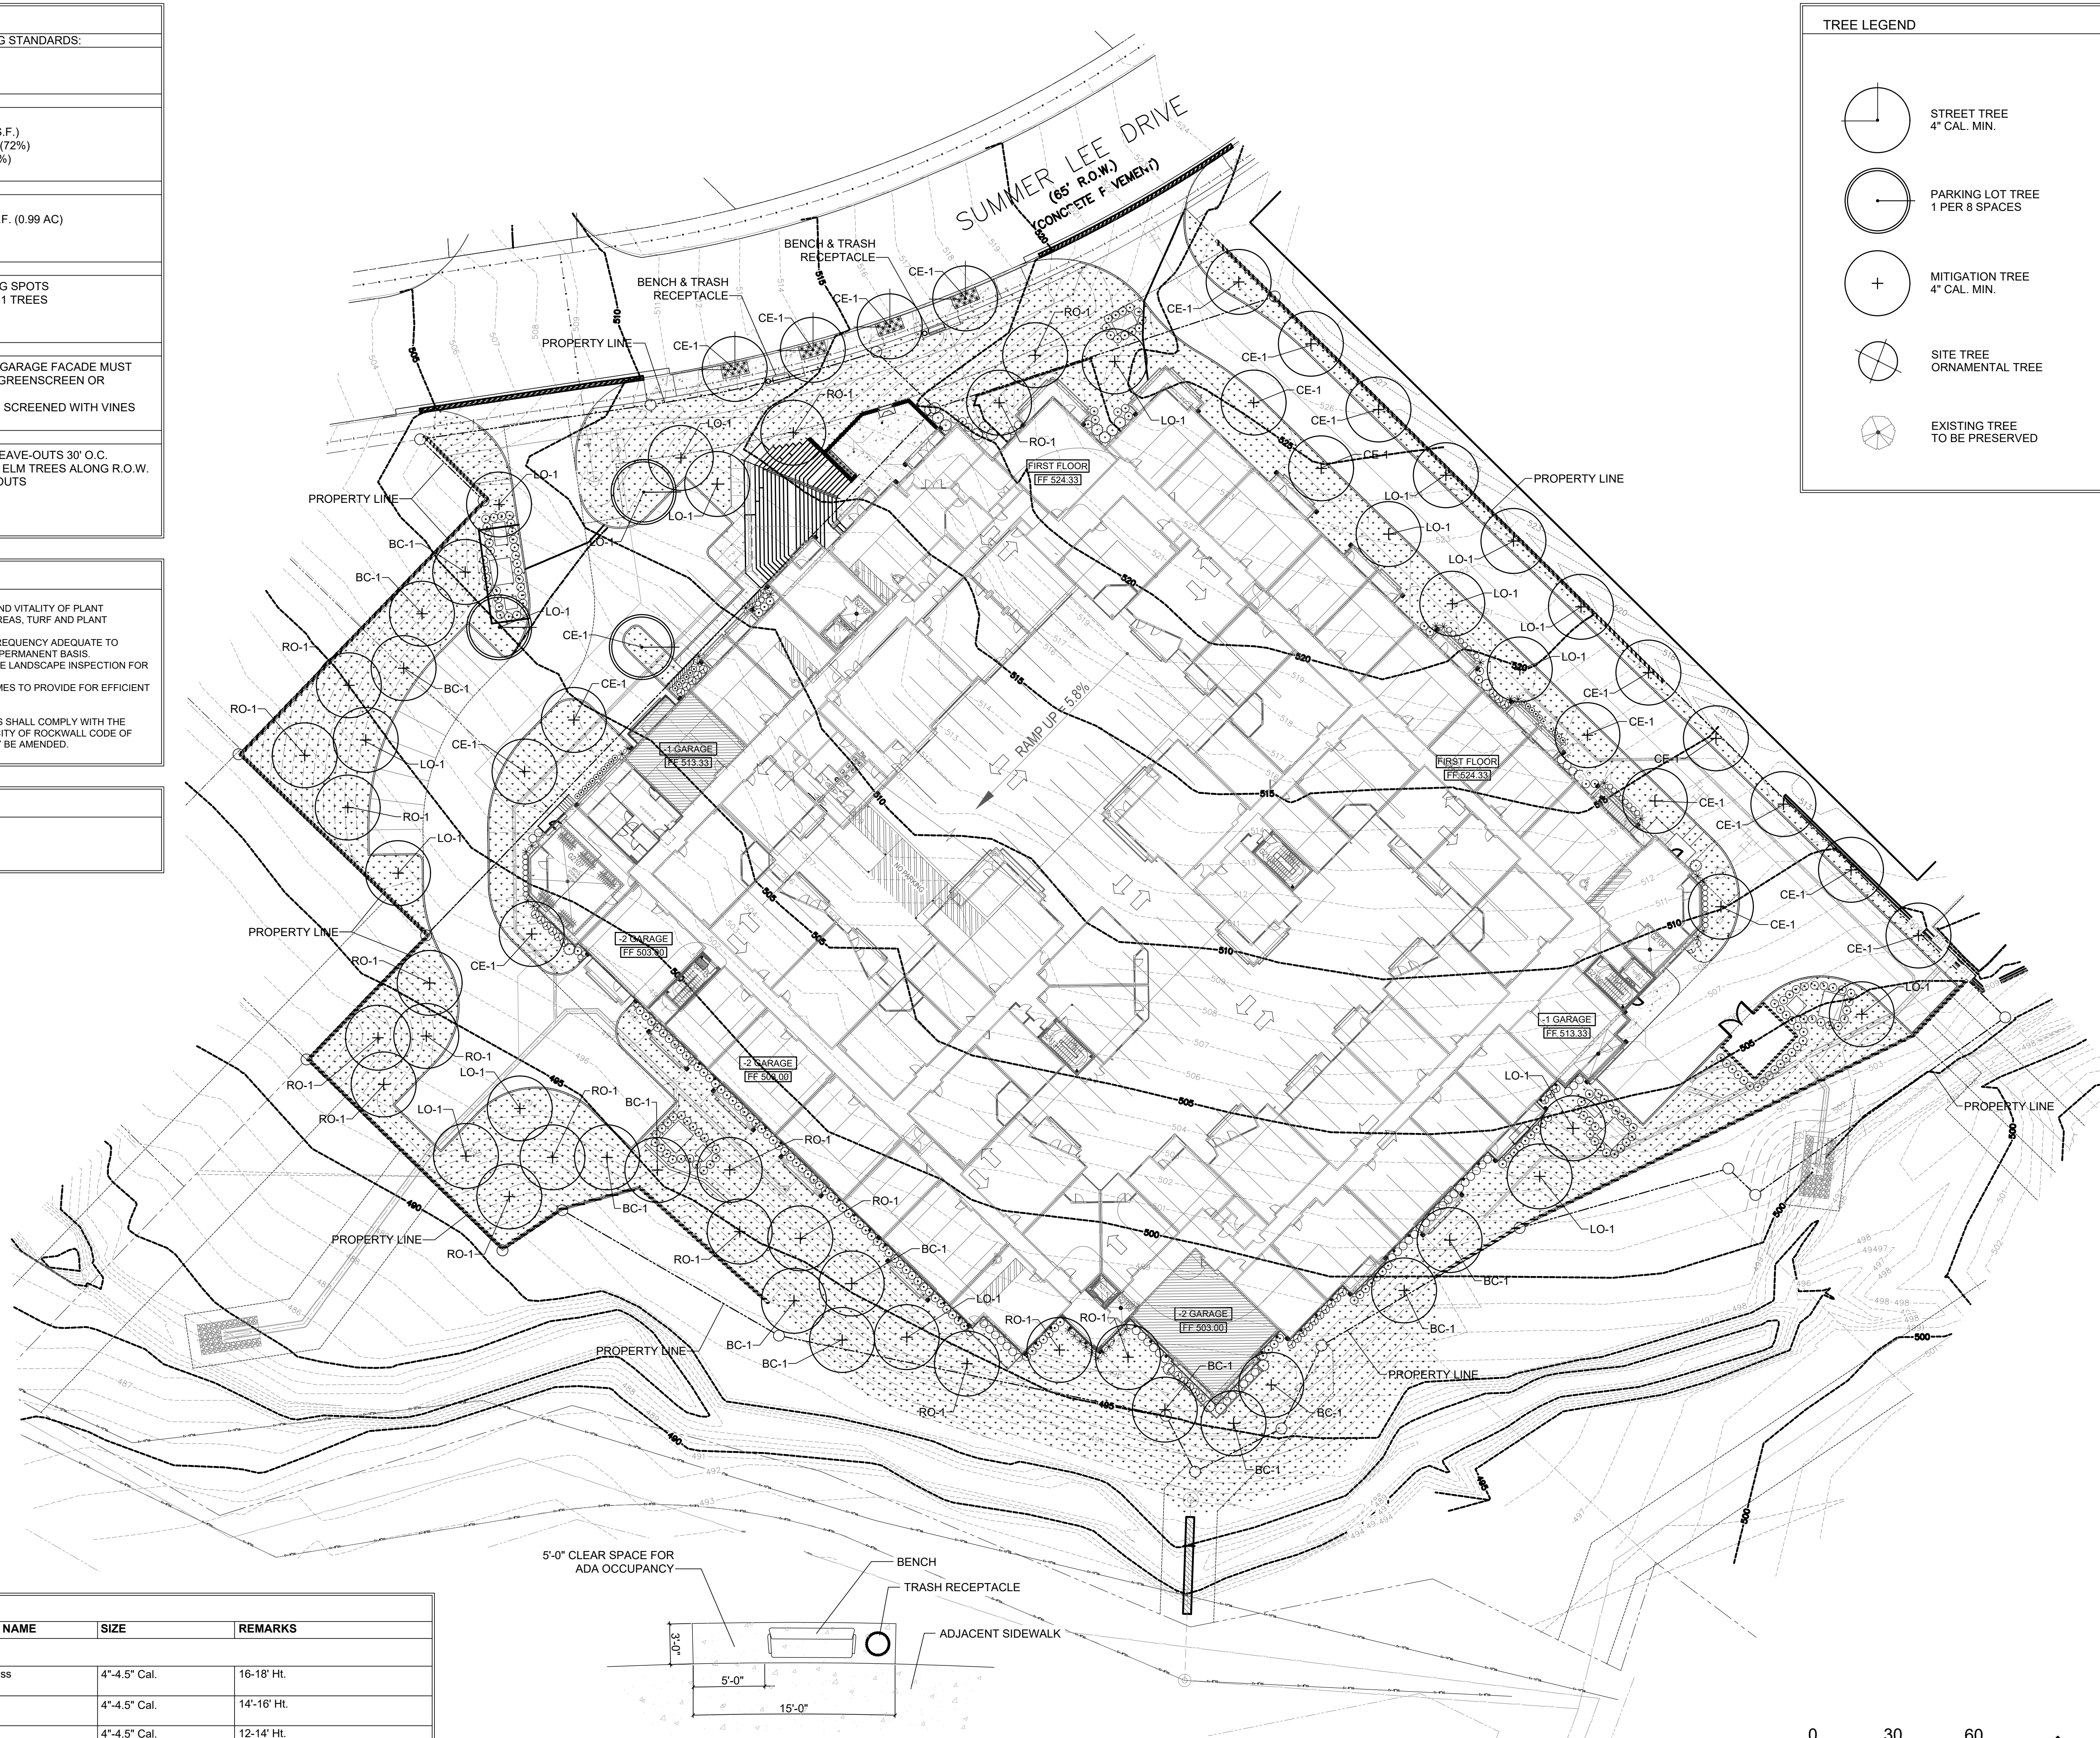

2 TYPICAL STREET FURNITURE LAYOUT
SCALE: NTS

1 LANDSCAPE PLAN
SCALE: 1" = 30'-0"

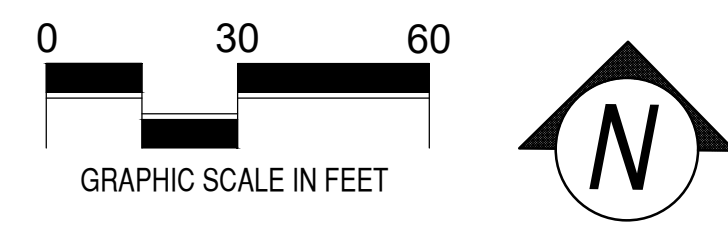

ISSUES:
① 11-15-18 ISSUE FOR PERMIT
② 11-22-19 ISSUE FOR PERMIT REVIEW
③ 12-22-23 AS-BUILT
REVISIONS:
▲ 12-04-18 PER CITY COMMENTS
▲ 05-27-20 PER CITY COMMENTS
▲ 10-02-20 GLENN HILL WAY REVISION

CLIENT:
DBA Architects
111 S. KENTUCKY
SUITE 210
MCKINNEY, TX 75069

CONTACT:
REUBEN MENDIOLA
(800) 900-4905
reuben@dba-architects.com

HARBOR HILL
ROCKWALL, TEXAS


mgt
landscape architects
MEEKS DESIGN GROUP, INC.
1755 N. COLLINS BLVD., SUITE 300
RICHARDSON, TX 75080
PH (972) 690-7474
F (972) 690-7878



AS-BUILT

HARBOR HILL LUXURY RESIDENCES
ROCKWALL, TEXAS
JOB NUMBER: DBA-1601

LANDSCAPE PLAN
LP0.01

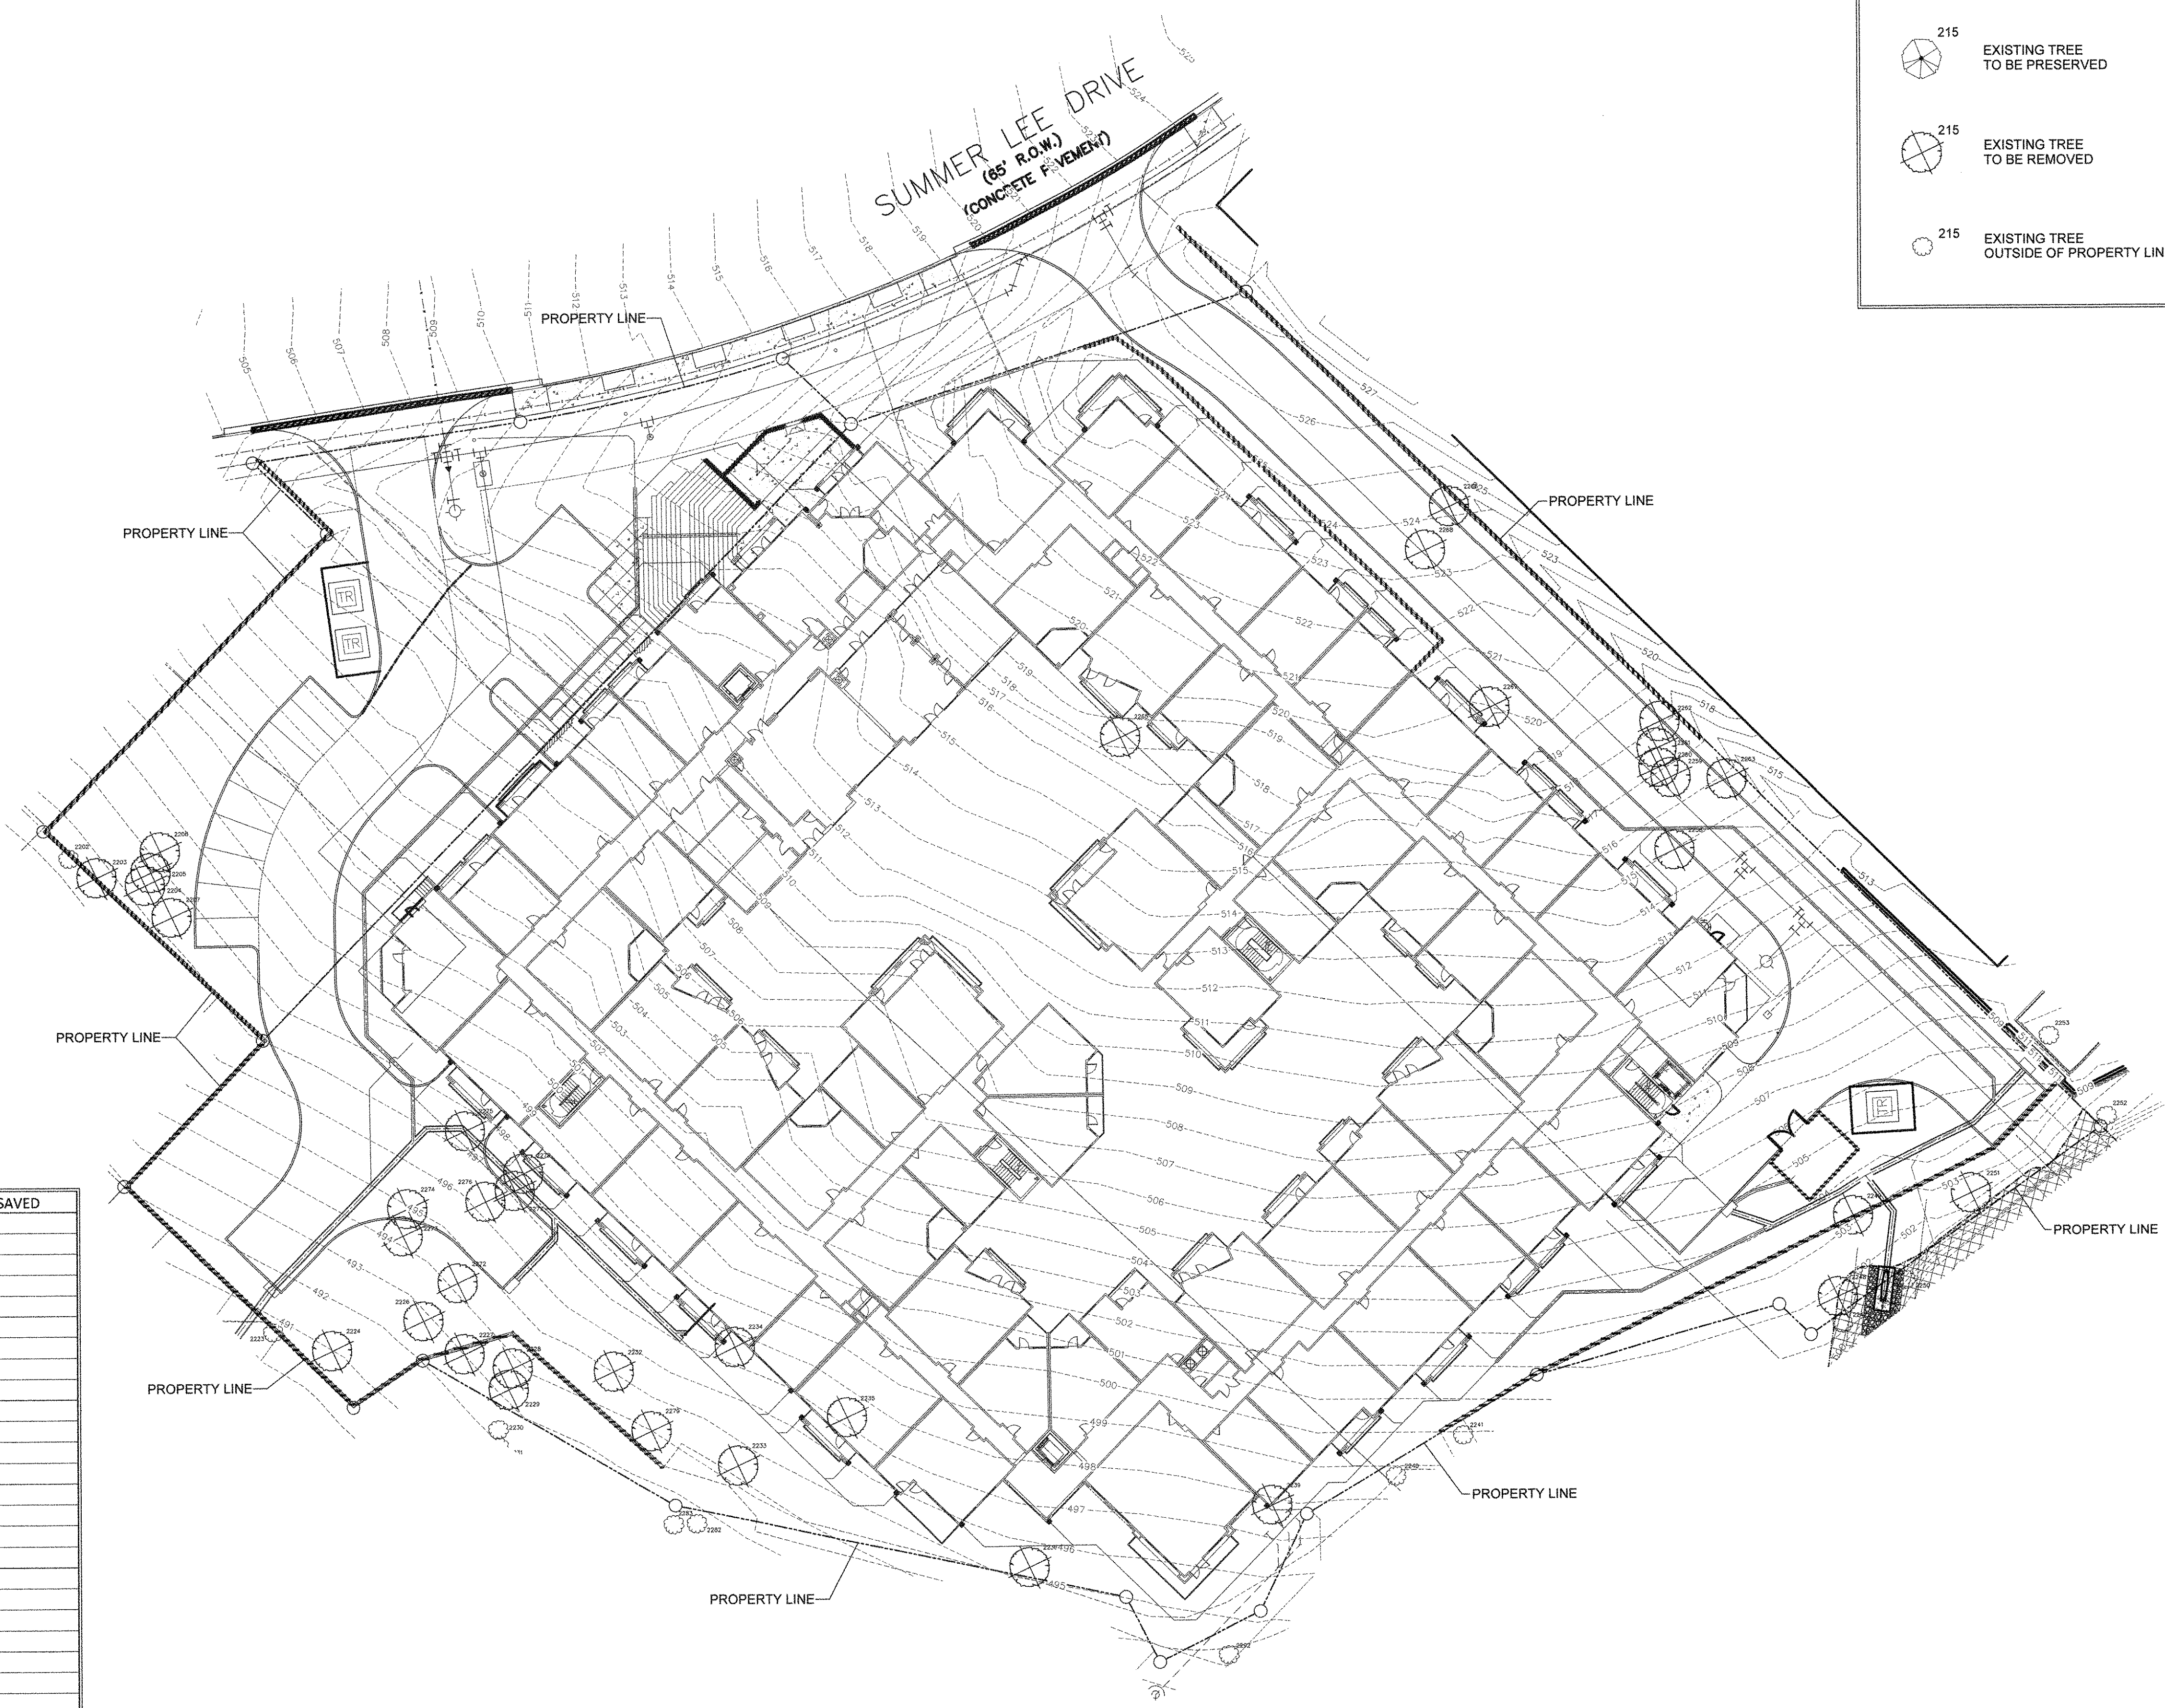

TREE LEGEND

- 215 EXISTING TREE TO BE PRESERVED
- 215 EXISTING TREE TO BE REMOVED
- 215 EXISTING TREE OUTSIDE OF PROPERTY LINE

ISSUES:

01-09-20	ISSUE FOR PERMIT

REVISIONS:

02-14-20	
09-17-20	ADDENDUM #2

CLIENT:
 DBA Architects
 111 S. KENTUCKY
 SUITE 210
 MCKINNEY, TX 75069

CONTACT:
 REUBEN MENDIOLA
 (800) 900-4605
 reuben@dba-architects.com

HARBOR HILL
LUXURY RESIDENCES
 ROCKWALL, TEXAS

TREE MITIGATION CALCULATIONS

TREE PRESERVATION	
TOTAL INCHES ON SITE:	499 INCHES
TOTAL INCHES TO BE REMOVED:	499 INCHES
TOTAL INCHES TO BE PRESERVED:	0 INCHES
TOTAL PRESERVATION CREDITS:	0 INCHES
USABLE CREDITS (MAX 20% OF MITIGATION):	(0 INCHES)

TREE MITIGATION REQUIRED:	398 INCHES TO BE MITIGATED
PROVIDED: (65) 4" CANOPY TREES =	260 INCHES PROVIDED
REMAINING INCHES TO BE PLANTED ON SITE OR PAID TO THE TREE FUND	

GENERAL NOTES

NO TREES WITHIN 5' OF UTILITIES.

TREE TAG #	DIAMETER (in)	TREE TYPE	SAVE/REMOVE	INCHES MITIGATED	INCHES SAVED
203	5	Elm	R	5	5
204	8	Elm	R	8	8
205	6	Elm	R	6	6
206	6	Elm	R	6	6
207	12	Cedar	R	6	6
224	12	Cedar	R	6	6
226	18	Pecan	R	18	18
227	24	Pecan	R	24	24
228	18	Pecan	R	18	18
229	12	Cedar	R	6	6
232	20	Pecan	R	20	20
233	16	Cedar	R	8	8
234	20	Cedar	R	10	10
235	20	Pecan	R	20	20
236	12	Cedar	R	6	6
239	16	Oak	R	16	16
248	12	Pecan	R	12	12
249	12	Cedar	R	6	6
251	16	Pecan	R	16	16
258	20	Cedar	R	10	10
259	18	Cedar	R	9	9
260	18	Cedar	R	9	9
261	12	Cedar	R	6	6
262	24	Cedar	R	12	12
263	30	Cedar	R	60	60
265	12	Cedar	R	6	6
266	12	Cedar	R	6	6
267	12	Cedar	R	6	6
268	12	Cedar	R	6	6
272	14	Cedar	R	7	7
273	8	Oak	R	8	8
274	10	Oak	R	10	10
275	12	Cedar	R	6	6
276	6	Oak	R	6	6
277	4	Oak	R	4	4
278	6	Oak	R	6	6
279	4	Oak	R	4	4
TOTAL:				398	0

1 TREE SURVEY/MITIGATION

SCALE: 1" = 30'-0"

0 30 60
GRAPHIC SCALE IN FEET

mg
 landscape architects

MEEKS DESIGN GROUP, INC.
 1755 N. COLLINS BLVD., SUITE 300
 RICHARDSON, TX 75080
 PH (972) 690-7474
 F (972) 690-7878



ISSUE FOR PERMIT


HARBOR HILL LUXURY RESIDENCES

ROCKWALL, TEXAS

JOB NUMBER: DBA-1804

TREE SURVEY/MITIGATION


TS-1

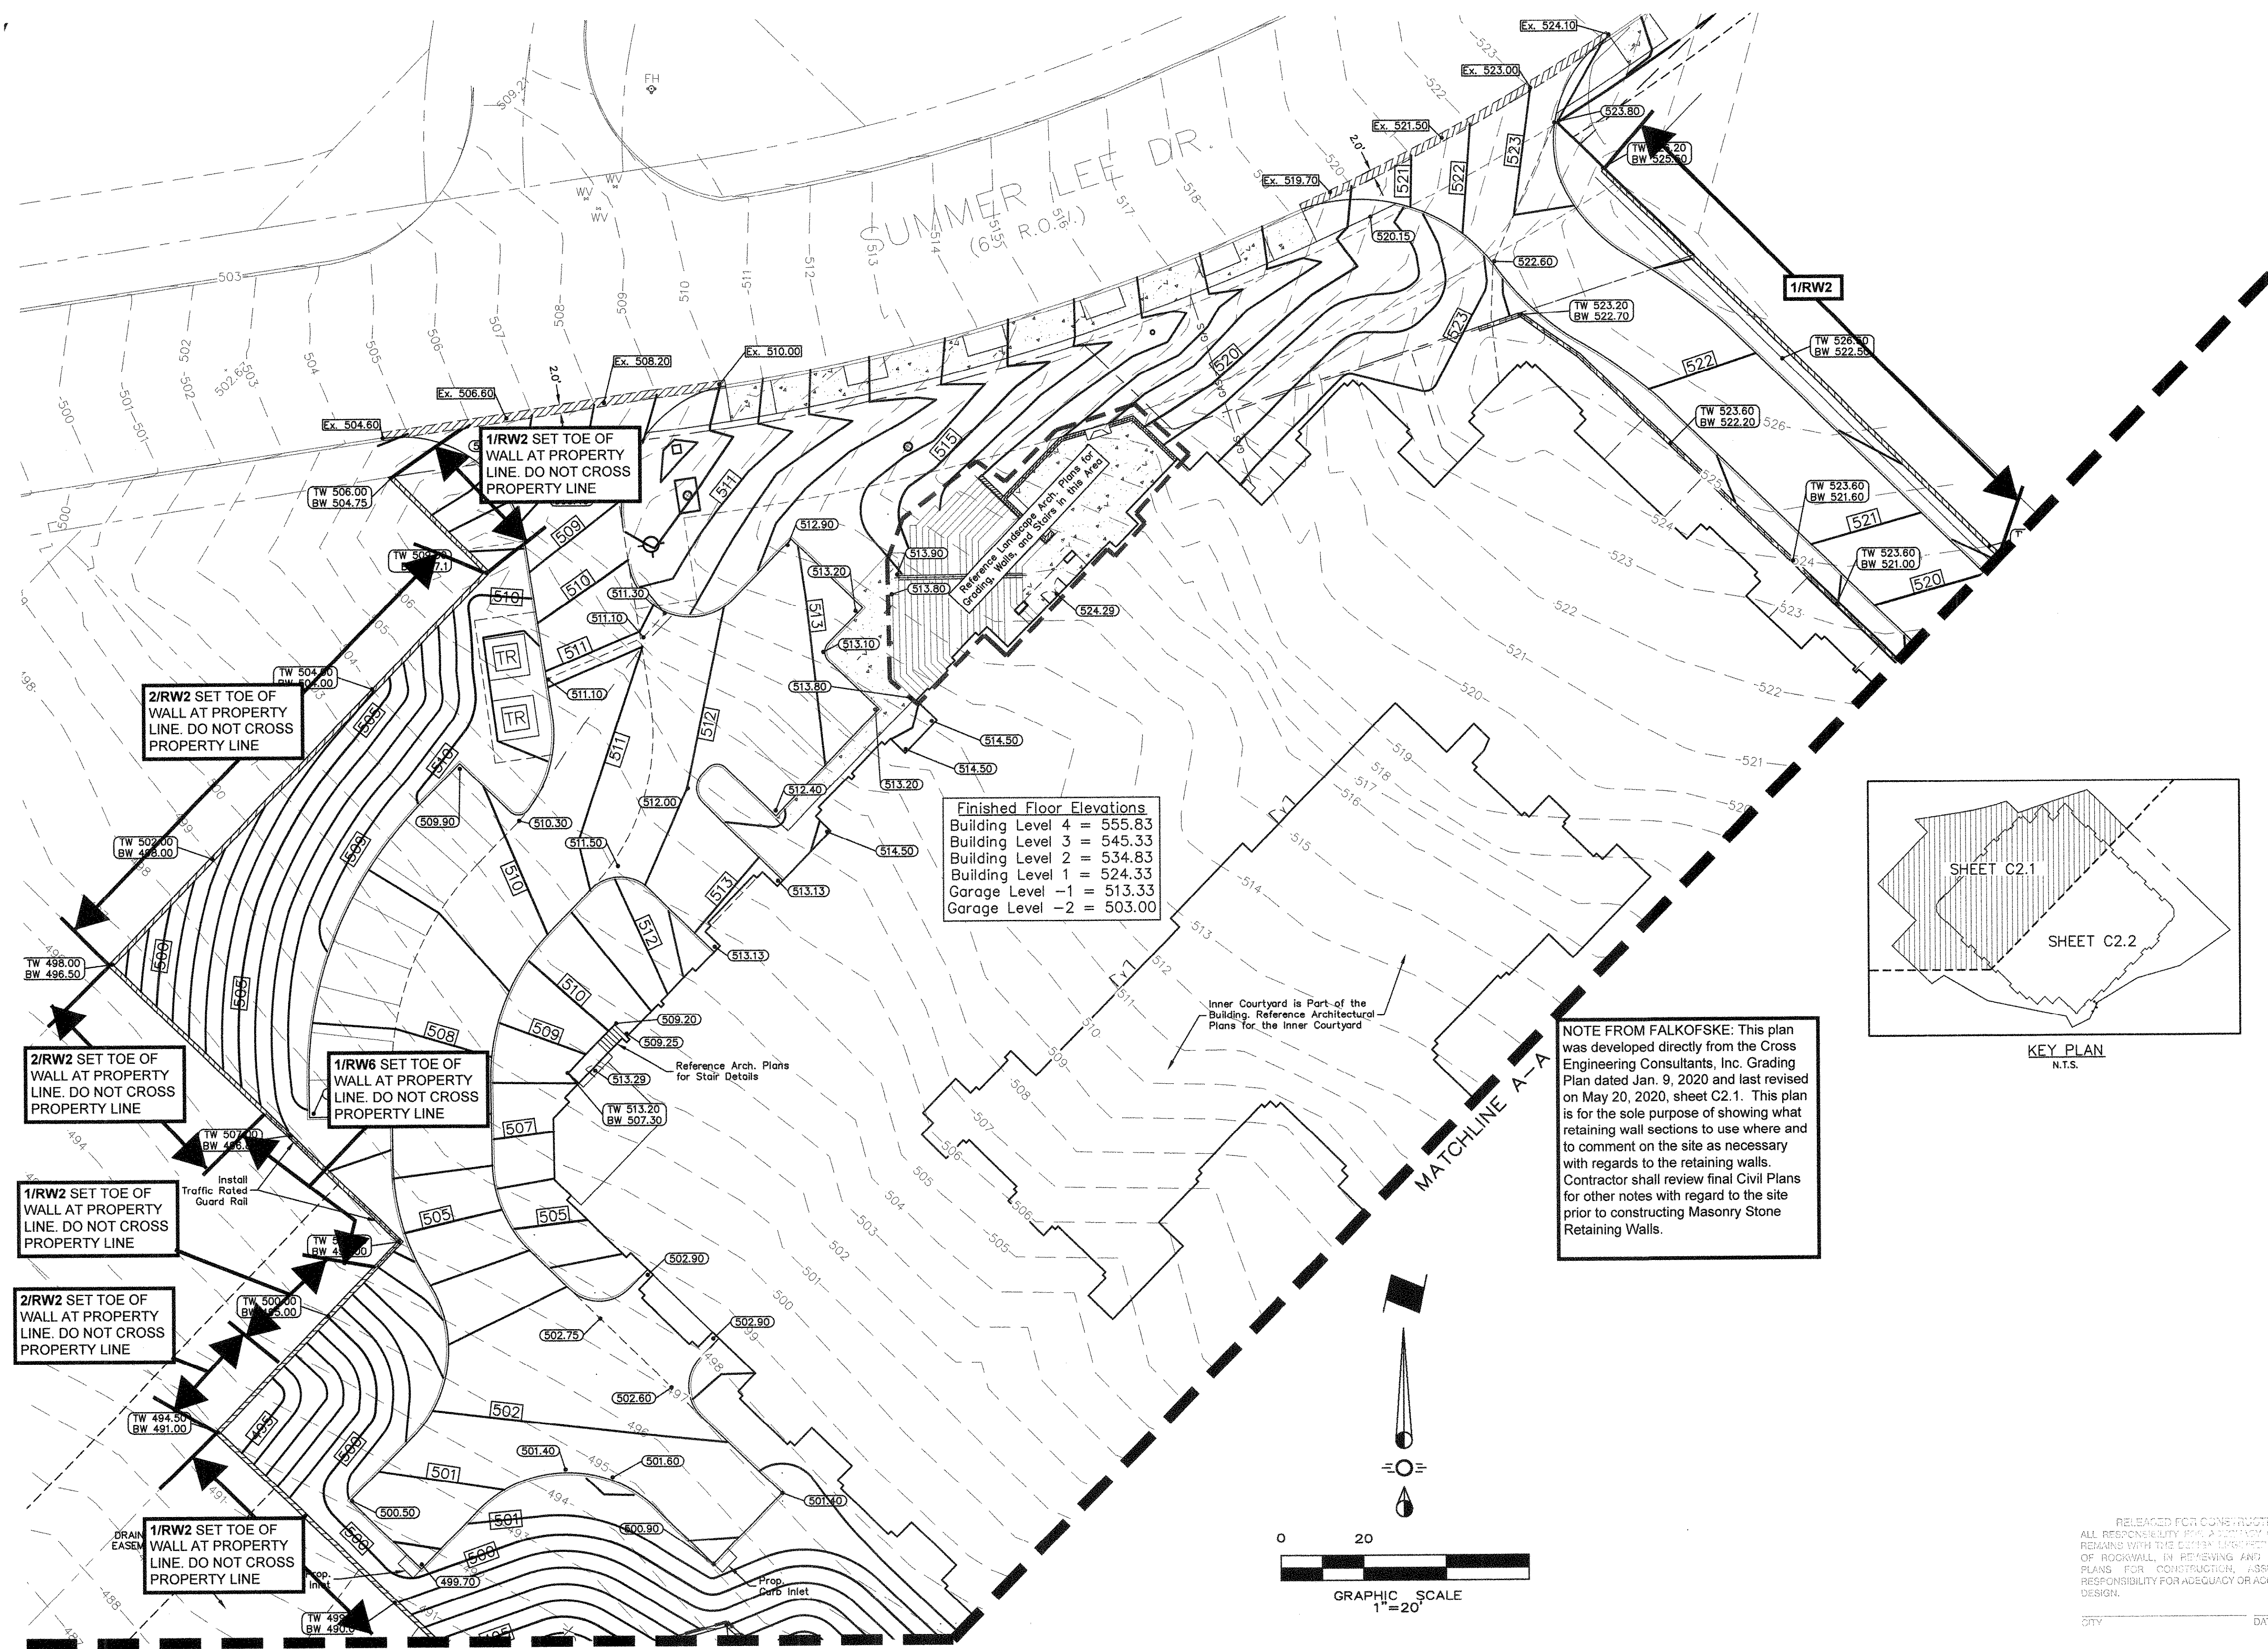

Finished Floor Elevations

Building Level 4	= 555.83
Building Level 3	= 545.33
Building Level 2	= 534.83
Building Level 1	= 524.33
Garage Level -1	= 513.33
Garage Level -2	= 503.00

NOTE FROM FALKOFSKE: This plan was developed directly from the Cross Engineering Consultants, Inc. Grading Plan dated Jan. 9, 2020 and last revised on May 20, 2020, sheet C2.1. This plan is for the sole purpose of showing what retaining wall sections to use where and to comment on the site as necessary with regards to the retaining walls. Contractor shall review final Civil Plans for other notes with regard to the site prior to constructing Masonry Stone Retaining Walls.

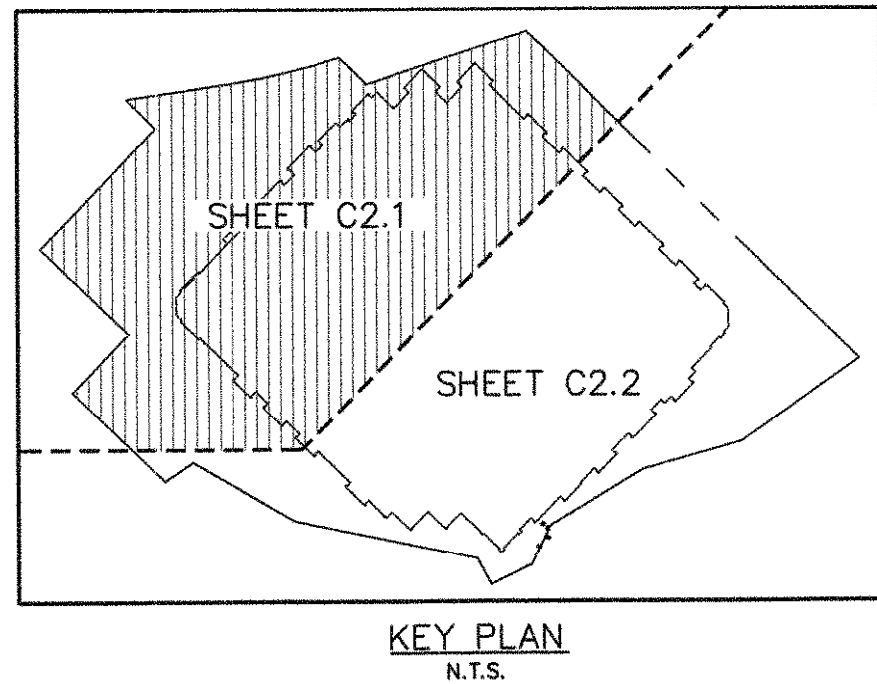


DATE	BY	NO.	DATE	REVISION
03-20-20	AMB	1	06-07-20	UPDATED CALL OUTS
03-20-20	RL	2	07-17-20	UPDATED CIVIL GRADING PLAN CALLOUTS
03-20-20	AMB	3	08-26-20	UPDATED CIVIL GRADING PLAN

Falkofske Engineering, Inc.
Structural Engineering Consultants
TX Reg. Engineering Firm F-4038
722 North Fielder Road
Arlington, Texas 76012
(817) 261-8300


This plan and the information contained herein are the property of Falkofske Engineering, Inc. and are not to be reproduced, copied, or distributed in any form without the written consent of Falkofske Engineering, Inc. Any other reproduction, even if partial, is prohibited. This plan is for informational purposes only and does not constitute a contract. The user assumes all responsibility for the accuracy and completeness of the information provided herein.

MASONRY RETAINING WALLS - SITE PLAN MARKUP
HARBOR HILLS
SUMMER LEE DRIVE
ROCKWALL, TEXAS

WALCO RETAINING WALLS, INC.
4800 S.E. LOOP 820
FORT WORTH, TEXAS 76140

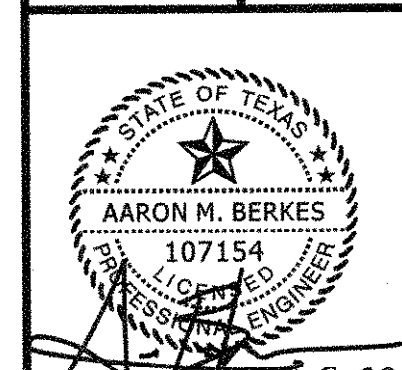


JOB NO. 151.20
SP1

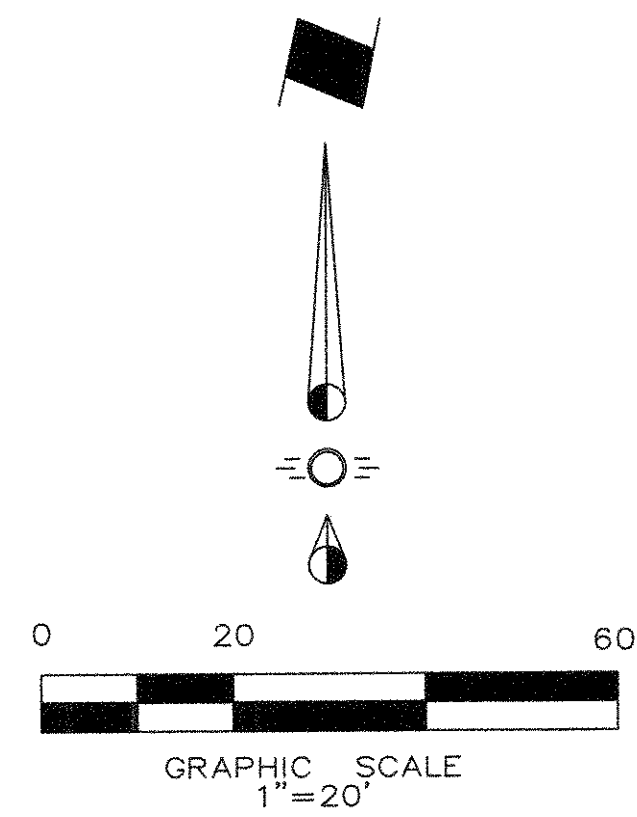


NOTE FROM FALKOFSKE: This plan was developed directly from the Cross Engineering Consultants, Inc. Grading Plan dated Jan. 9, 2020 and last revised on May 20, 2020, sheet C2.2. This plan is for the sole purpose of showing what retaining wall sections to use where and to comment on the site as necessary with regards to the retaining walls. Contractor shall review final Civil Plans for other notes with regard to the site prior to constructing Masonry Stone Retaining Walls.

Finished Floor Elevations	
Building Level 4 =	555.83
Building Level 3 =	545.33
Building Level 2 =	534.83
Building Level 1 =	524.33
Garage Level -1 =	513.33
Garage Level -2 =	503.00

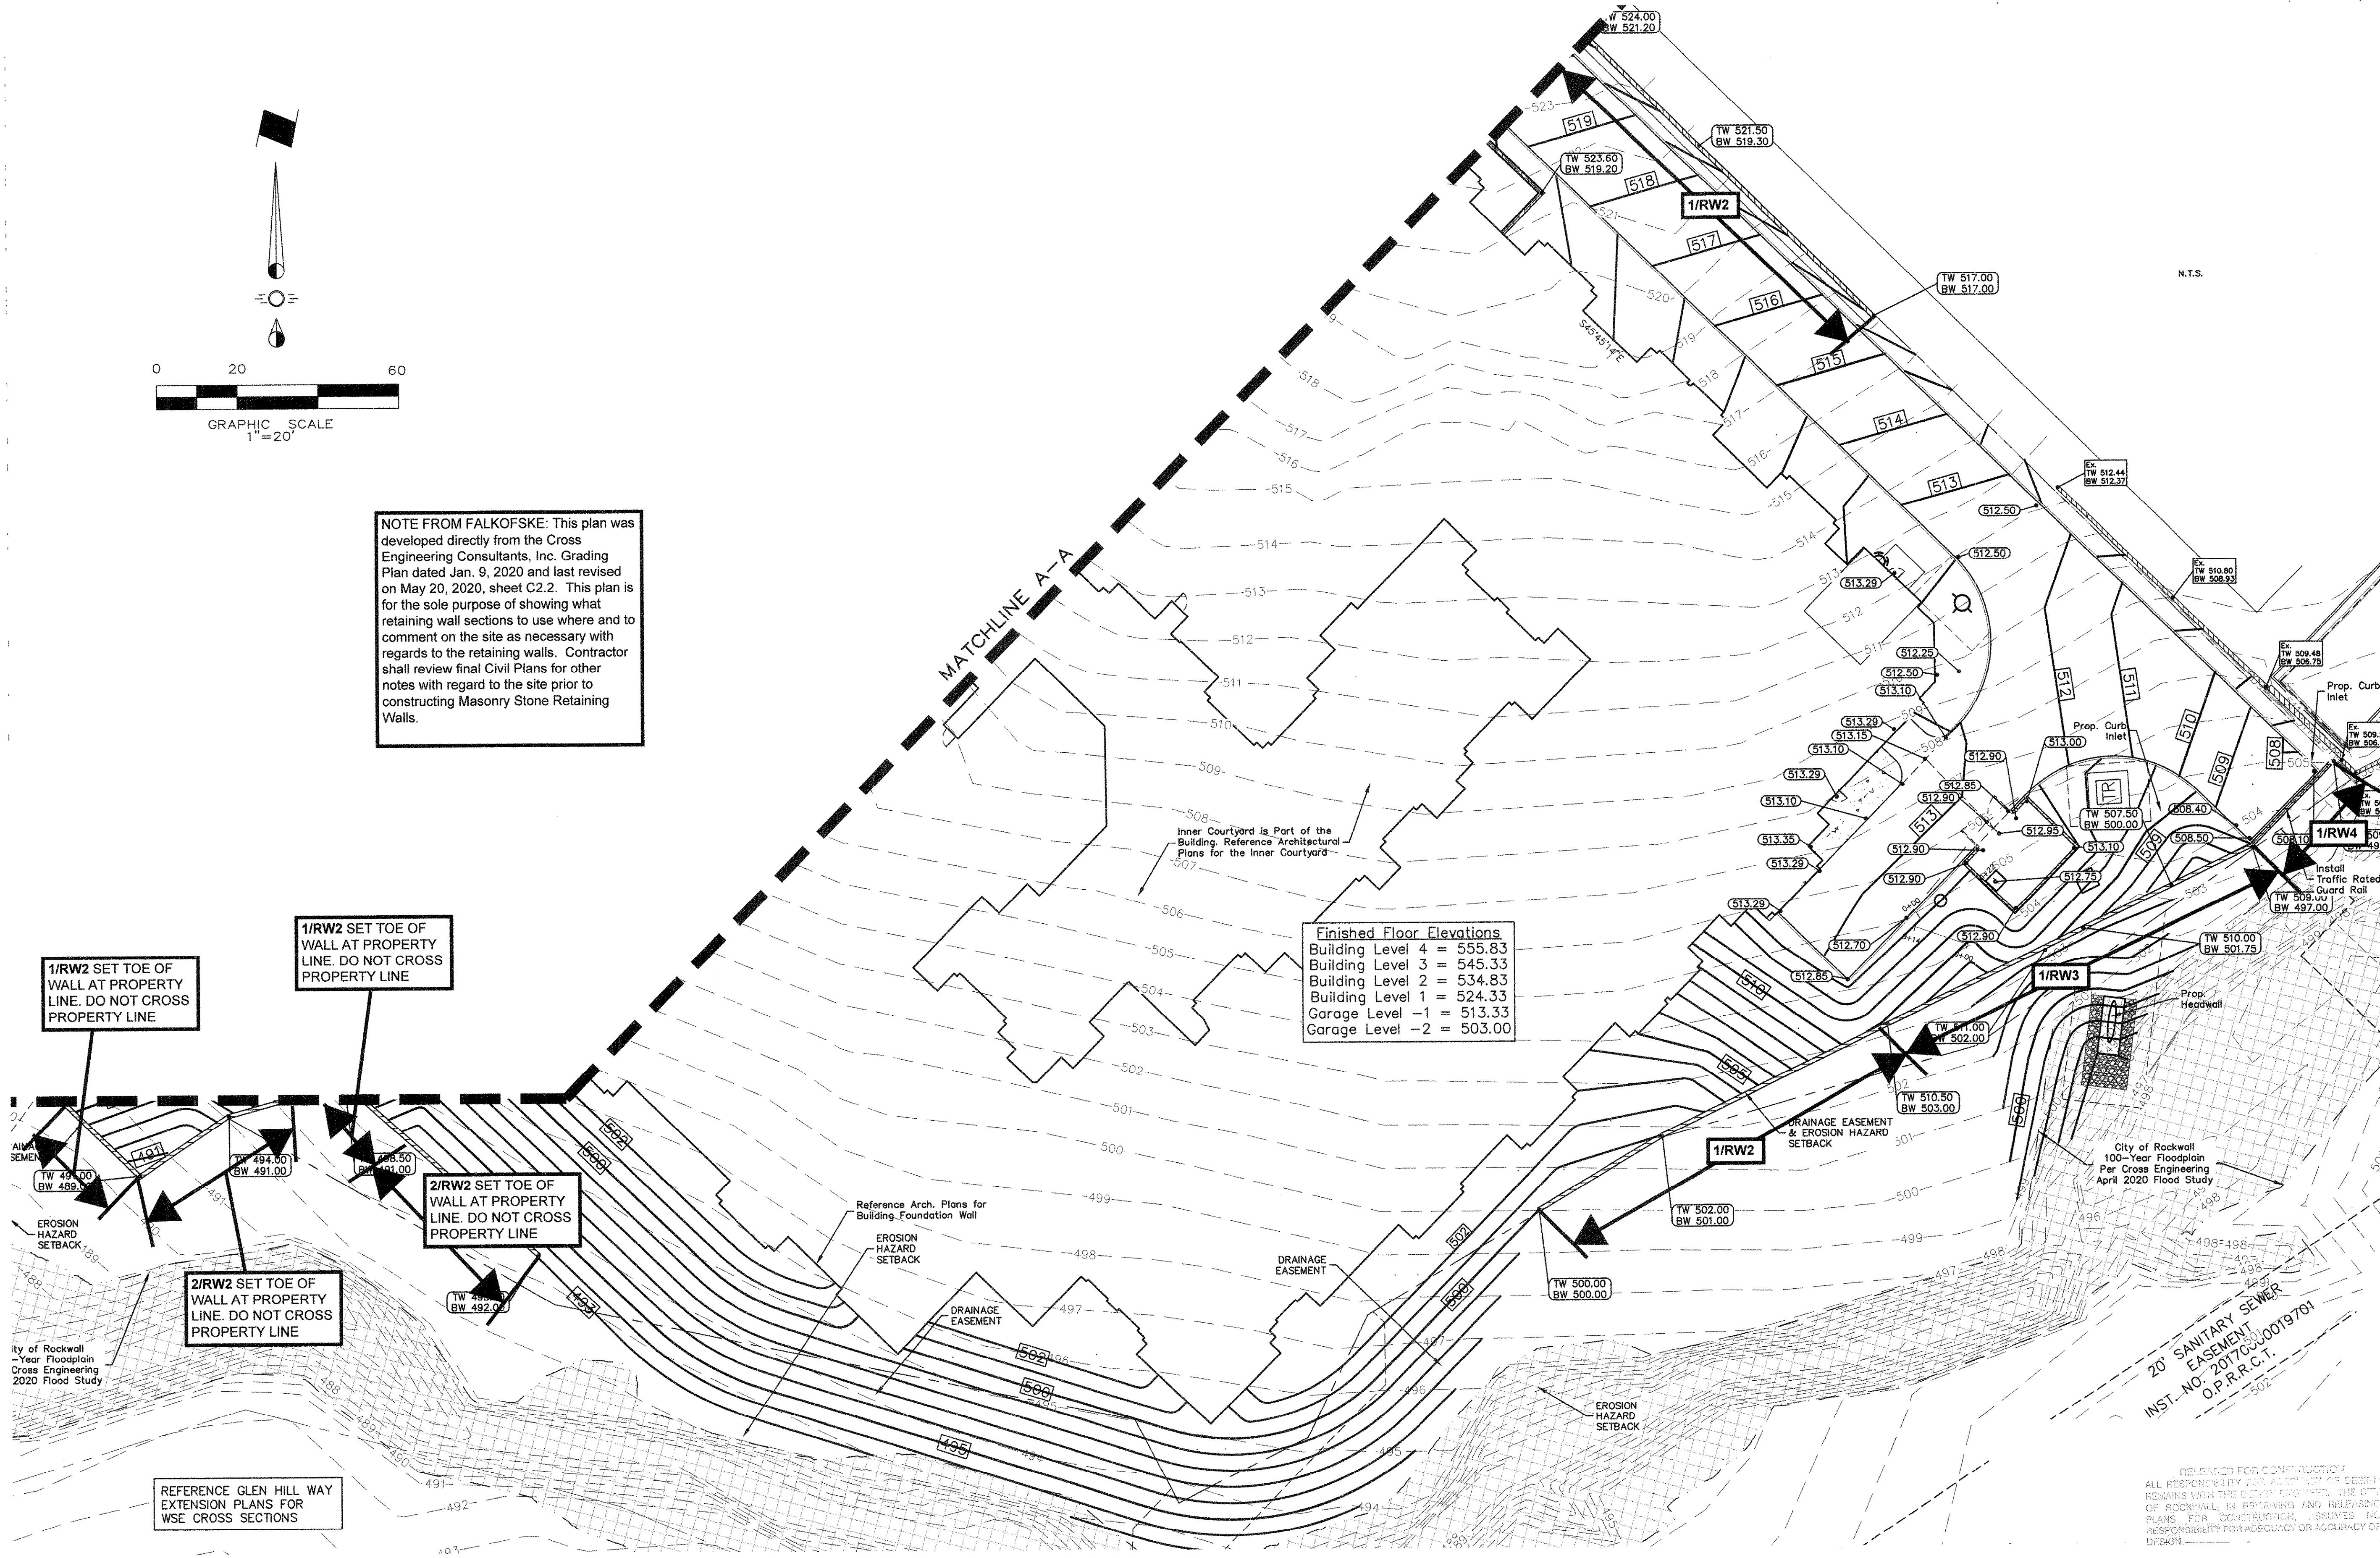


DATE	BY	NO.	DATE	NO.	DATE	BY
03-20-20	AMB	1	06-09-20	2	06-09-20	RLB
03-20-20	RL	2	07-17-20	3	07-17-20	EG
03-20-20	AMB	3	08-26-20	4	08-26-20	RL

Falkofske Engineering, Inc.
Structural Engineering Consultants
TX Reg. Engineering Firm F-4038
722 North Fielder Road
Arlington, Texas 76012
(817) 261-8300




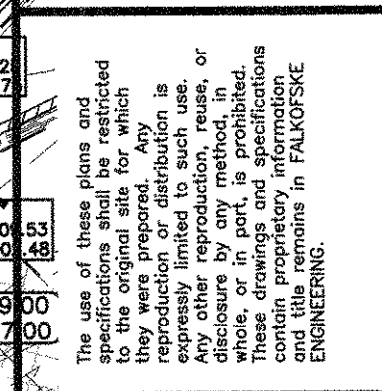


REPRODUCTION OF THIS PLAN WITHOUT THE WRITTEN PERMISSION OF FALKOFSKE ENGINEERING IS PROHIBITED. ANY REPRODUCTION, IN WHOLE OR IN PART, IS PROHIBITED. FALKOFSKE ENGINEERING IS NOT RESPONSIBLE FOR THE ACCURACY OF ANY INFORMATION OBTAINED FROM THIS PLAN.

MASONRY RETAINING WALLS - SITE PLAN MARKUP
HARBOR HILLS
SUMMER LEE DRIVE
ROCKWALL, TEXAS
WALCO RETAINING WALLS, INC.
4800 S.E. LOOP 820
FORT WORTH, TEXAS 76140

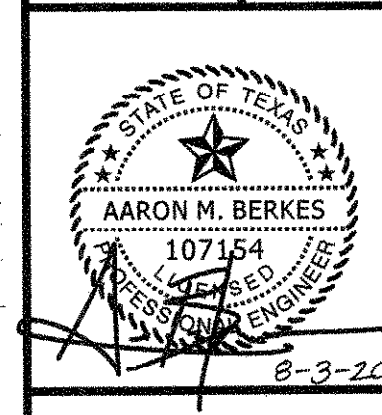

JOB NO. 151.20
SP2

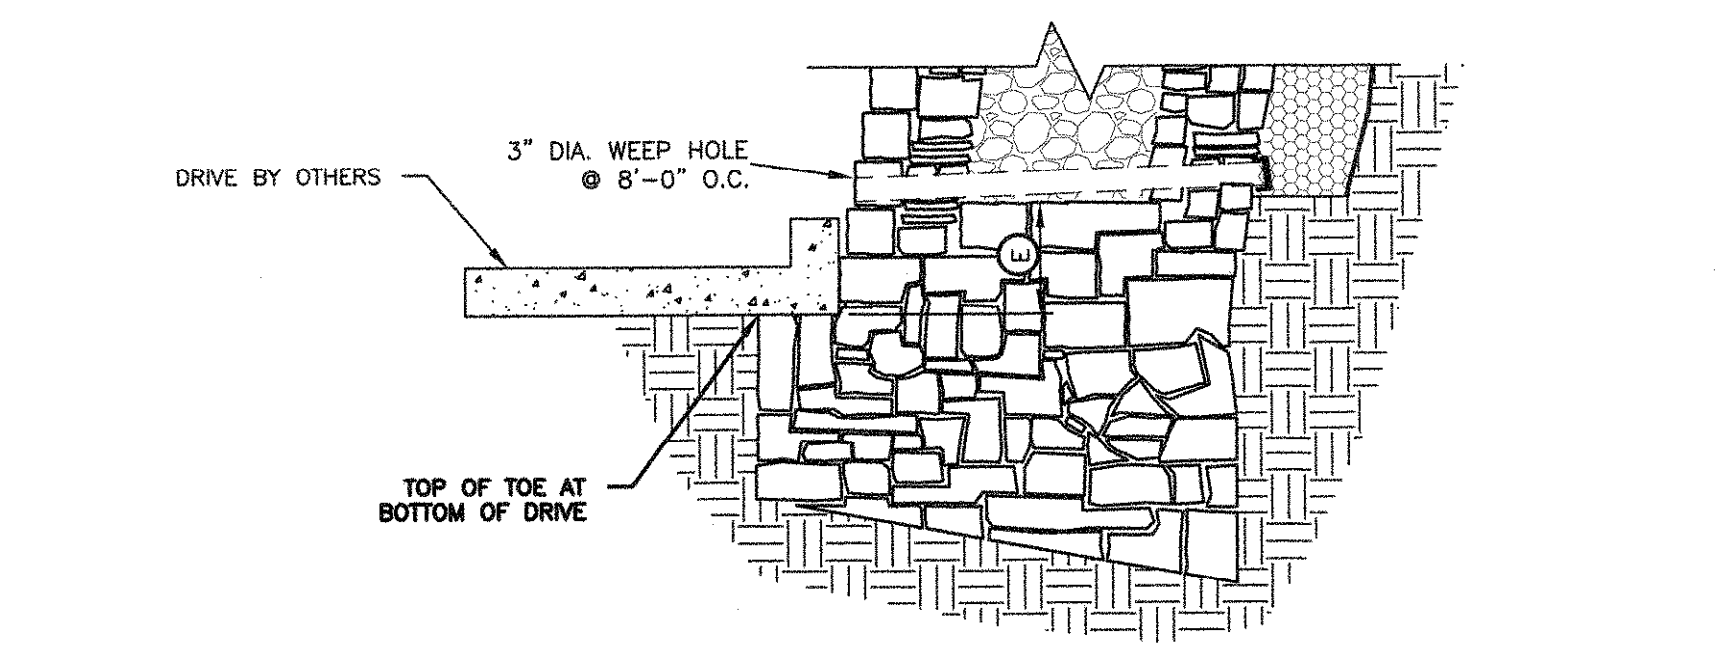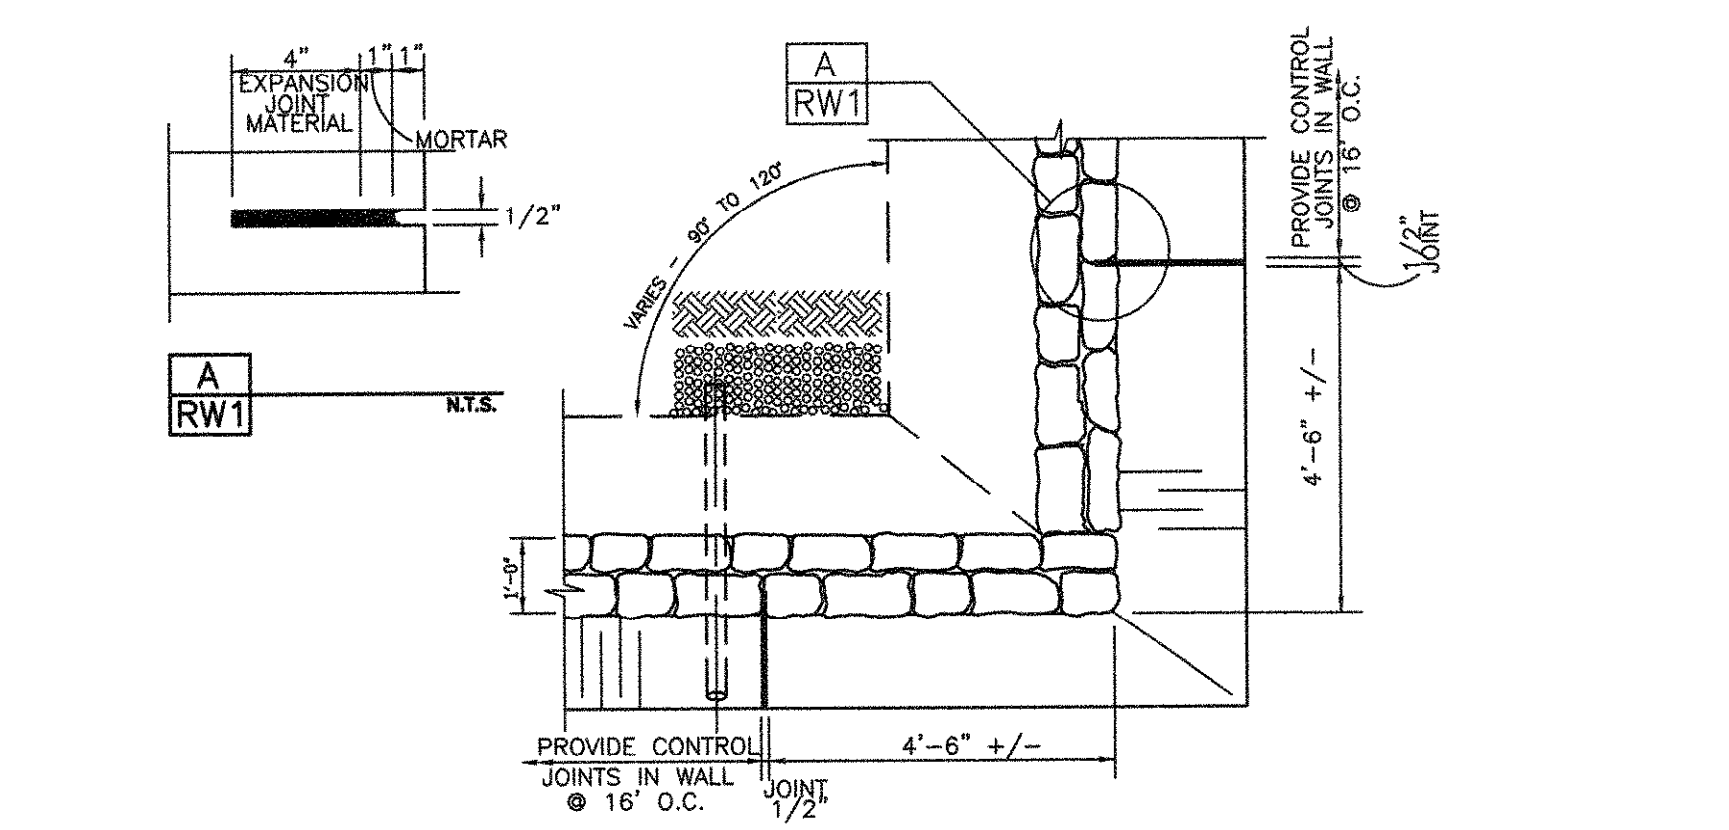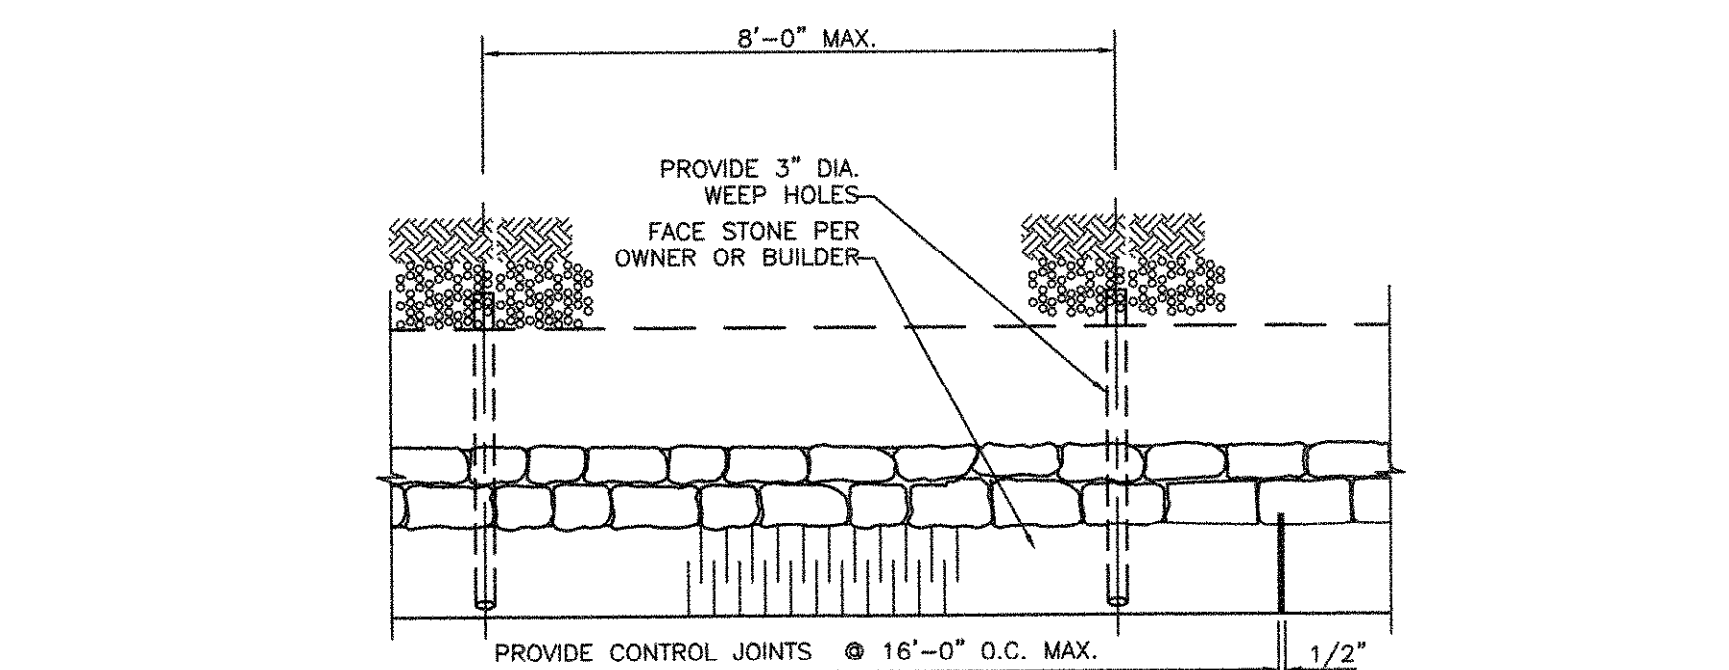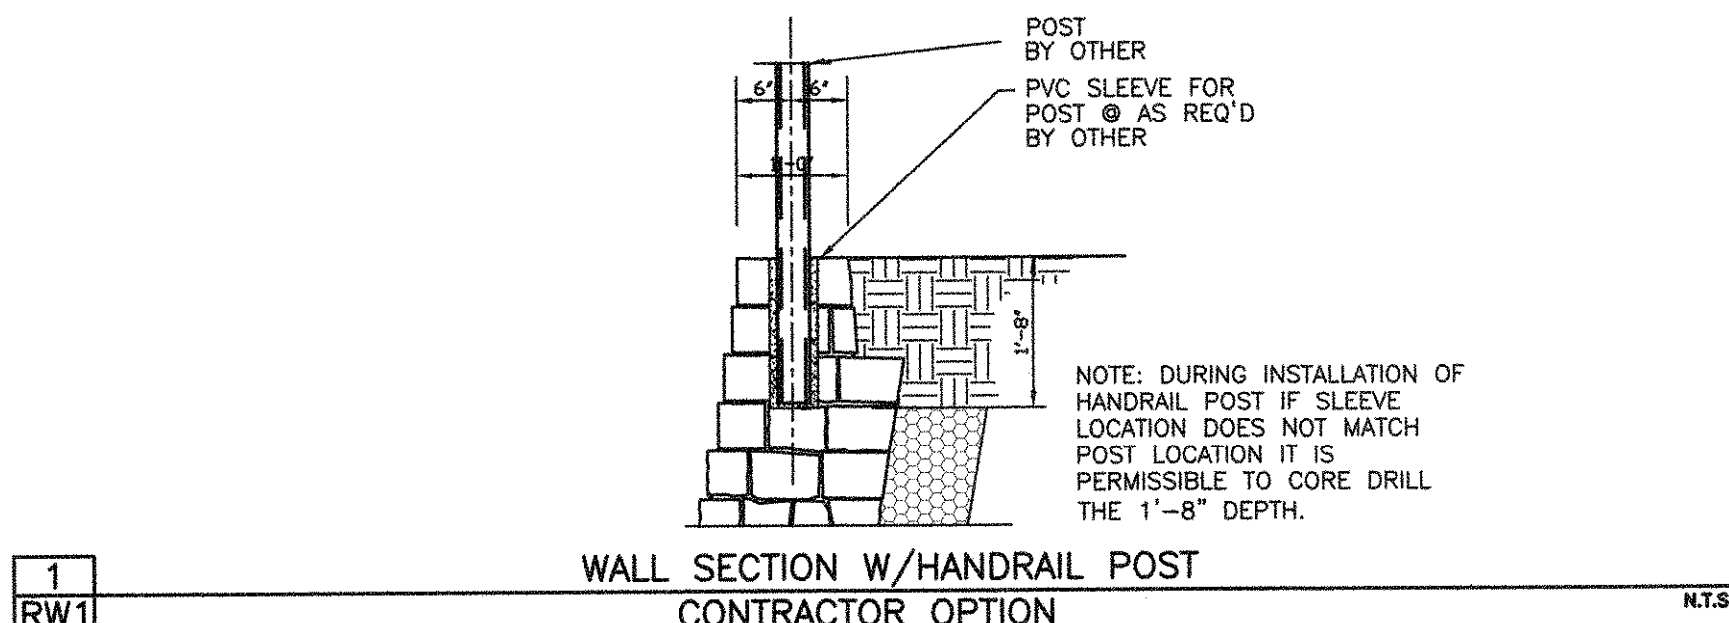

GENERAL NOTES

1. Design

1.1. Design Codes

International Building Code, 2015 Edition

1.2. Geotechnical Report

Firm: RONE ENGINEERING, Inc.
 Report No. 19-21094 Date: May 12, 2016
 Allowable Bearing Capacity 1500 pcf

1.3. Design Parameters

Soil Parameters:

Soil Type*	Friction Angle	Cohesion (psf)	Unit Weight (pcf)
Retained Backfill (On site clay)	26 deg	0 pcf	120 pcf
Foundation Soils (1500 pcf)	26 deg	0 pcf	120 pcf

*See materials below for a description of each Soil Type.

Factors of Safety:

External Stability

a. Minimum Factor of Safety Against Base Sliding (Static Condition)	1.5
b. Minimum Factor of Safety Against Overturning	2.0
c. Minimum Factor of Safety Against Global Stability	1.5
d. Minimum Factor of Safety for Bearing Capacity	3.0

Design Loading:

Lateral earth pressures are calculated using Coulomb's Lateral Earth Pressure Theory. Designs have been performed to accept loading per the proposed loading conditions based on the Civil Grading Plans. A live loading of 250 pcf has been used for all walls supporting areas subject to freeline loading.

Retaining walls should not have solid fence (such as wood fence) placed on top of wall other than that shown on these plans. Retaining walls shall not have additional surcharge placed above wall other than that shown on these plans. Retaining walls shall not have slope at base or top of wall that exceed that which is shown on these plans. The retaining walls noted above require special design.

2. Materials

2.1. Soil Types

- a. Retained Backfill
 - a.a. On site clayey soils
 - a.b. Properly compacted on-site fill soils, verification by others.
- b. Foundation Soils (Allowable Bearing = 1500 psf min)
 - b.a. Bearing on Stiff Natural Undisturbed Clayey or Sandy Soils or Compacted and Tested Fill Soils
 - b.b. Friction Angle between Base of Wall and Soil - 17 deg
 - b.c. Bearing in fill soils. Fill soils supporting the retaining walls shall be placed in accordance with the recommendations for the fill placement per the geotechnical report.
- c. Drainage Material
 - c.a. Free draining granular backfill, clean, non-plastic, relatively well-graded.

2.2. Dimension Stone

- a. Average Density of masonry wall varies from 135pcf to 145pcf.
- b. Stone size varies from 4" to 18"
- c. Face stone shall be coordinated between contractor and owner/developer.
- d. Recycled concrete 4" to 18" may be used in place of dimension stone, contractors option.

2.3. Rebar/Welded Wire Fabric (If Required)

- a. All steel reinforcement shall be new billet steel conforming to ASTM A-615, Grade 60 with fy=60ksi.
- b. All reinforcement shall not have deleterious material on it
- c. All welded wire fabric shall have minimum fy=65ksi and be hot dip galvanized.

2.4. Drainage Materials

- a. Weep pipes shall be PVC or corrugated HDPE pipe.
- b. Drainage zone shall be separated from retained backfill by mirafix 140N filter fabric or approved equal.

2.5. Portland Cement Mortar for Retaining Wall Construction.

The portland cement mortar used for construction of the masonry stone retaining walls shall be provided with the following proportions per cubic yard of concrete. The portland cement mortar supplier shall provide "batch tickets" clearly indicating that the appropriate amount of materials are provided in each truck load. The batch tickets shall clearly indicate the amount batched, the date, the project name and shall be provided to Falkofske Engineering, Inc. for review, documentation, and file.

Contents	Amount per cubic yard	Specific Gravity	Volume ft ³
Type 1 Portland cement	451 lbs	3.15	2.29
Type F Fly Ash	113 lbs	2.93	0.62
Fine Aggregate (sand)	2746 lbs	2.59	15.99
Potable Water	367 lbs	44 Gallons	5.88
Sika Air (or equivalent)	(AS REQ'D) oz	4.5%	1.22
			27.0 Total

Note: the portland cement mortar supplier material weights may vary slightly based on the specific gravity of the materials used.

Concrete retarders may be used at the discretion of the masonry wall contractor. A greater amount of retarder is typically used during hot periods and a less amount of retarder is typically used during cool weather.

Please note that the above proportions will provide a portland cement mortar with a compressive strength of about fc = 2500 psi. Falkofske Engineering, Inc. does not require any concrete testing provided the above proportions are verified by way of the "batch tickets"

3. Construction

3.1 Preparation Work

- a. Prior to grading or excavation of the site, confirm the location of the retaining walls and all underground features, including utility location within the area of construction. Ensure surrounding structures are protected from effects of wall excavation, and construction.
- b. Coordinate installation of underground utilities and other improvements with wall installation.

3.2 Excavation

- a. If a mortared footing is over-excavated, then the dimension stone shall be placed mortared. If a dry stone footing is over excavated, then the dimension stone does not need to be mortared.
- b. Fill over-excavated area in front of the wall footing with compacted on site soils before the wall construction exceeds 4 feet in height.
- c. In areas where the walls are installed in a cut, the required excavation shall extend horizontally to the extent of the width of the retaining wall. The wall may be built to the cut. If the wall is over cut, then soil shall either be compacted or the drainage zone may be widened.

3.3 Wall Construction

- a. The wall shall be constructed to the dimensions as shown on these plans. Front leads, back leads, and string lines shall be set for each wall. Care shall be taken to install the mortar zones the correct thickness, and to place drainage behind the wall as required.
- b. Control joints shall be installed at a maximum of 16'-0" o.c. per these plans.
- c. Weep pipes shall be placed at 8'-0" o.c. max.
- d. Face rock type shall be coordinated between the architect, owner, and retaining wall contractor.

3.4 Retained Backfill Placement

- a. Retained backfill shall be placed per the recommendations of the geotechnical engineer, but should not be less than 93% Standard Proctor Maximum Dry Density (ASTM D698).
- b. Fill should be placed in maximum 8" thick compacted lifts.
- c. Large compaction equipment (equipment heavier than 7,500 lb) shall remain a minimum of 1.5x the height of the wall away from the back of the wall for a period of 2 weeks from the time of construction.
- d. After a period of 2 weeks from the time of construction large compaction equipment may be used behind the wall but shall stay a minimum of 5'-0" away from the back of the wall.
- e. Soil placed within 5'-0" of the back of the wall shall be placed using handheld compaction equipment.
- f. If the wall is in a cut situation the wall may be built up to the cut. If the wall is overcut the drainage zone may be widened to the cut or compacted fill may be placed between the drainage zone and the cut.

3.6 Retaining Wall Performance, Maintenance, and Other Comments

- a. Control joints are provided in the retaining wall to allow for minor movements due to settlement and shrink swell of the soils. Some cracking may occur in the face of the retaining wall. This cracking, if minor (less than 3/8"), may be cosmetically repaired as desired.
- b. The retaining walls are designed to allow surface water to flow over the tops of the retaining walls. Care should be taken during and after construction to not allow water to pond behind the retaining walls, as this can have a negative impact on the stability of the retaining walls.
- c. If downspouts are located near the back of the retaining wall they should either be plumbed through the retaining wall to drain below the wall or collected and tied into the storm sewer system. Perforated subsurface pipes shall not be used behind the retaining walls.
- d. Positive drainage over the top of the walls shall be maintained throughout the life of the structure. If swales are placed behind the wall they shall remain clean and free draining. If water is found to be ponding in the swale it shall be fixed to allow water to freely drain as soon as possible.
- e. Any broken sprinklers behind the retaining wall shall be turned off and repaired as soon as possible.

3.7 Cold Weather Construction of Retaining Walls

Construction Requirements for temperatures between 40°F and 32°F:

- a. Water and aggregates used in mortar shall not be heated above 140°F.
- b. Mortar sand or mixing water shall be heated to produce mortar temperatures between 40°F and 120°F at the time of mixing.

Construction Requirements for temperatures between 32°F and 25°F:

- a. The guidelines above for construction requirements for temperatures between 40°F and 32°F and the following shall be met.
- b. The mortar temperature shall be maintained above freezing until used in masonry stone retaining wall.
- c. Visible ice and snow shall be removed from the top surface of existing foundations and masonry to receive new construction. These surfaces shall be heated to above freezing, using methods that do not result in damage.
- d. Newly constructed masonry shall be completely covered with weather-resistive membrane for 48 hours after being completed.

Construction Requirements for temperatures between 25°F and 20°F:

- a. The guidelines above for construction requirements for temperatures between 40°F and 32°F, the construction guidelines for temperatures between 32°F and 25°F, and the following shall be met.
- b. Masonry (raw stone) surfaces under construction shall be heated to 40°F.
- c. Wind breaks or enclosures shall be provided when the wind velocity exceeds 15 miles per hour.
- d. Newly constructed masonry shall be completely covered with weather-resistive insulating blankets, or equal protection, for 48 hours after being completed.

The above procedures comes from sections 2104.3.2.1, 2104.3.2.2, 2104.3.2.3, 2104.3.3.3, and 2104.3.3.4 of the International Building Code, and is in compliance with Masonry Standards Joint Committee recommendations for cold weather construction of masonry structures.


4. Construction Observations

4.1 Construction Observations by Falkofske Engineering, Inc.

- a. Falkofske Engineering, Inc. will perform construction observation, but only as a means of verification of the contractors quality control performance.
- b. Falkofske Engineering, Inc. will act as the Special Inspector for this project. Contractor shall contact Falkofske Engineering to set up inspections, at least 1 day before construction starts.
- c. All required materials testing shall be performed by an approved materials testing laboratory.
- d. Falkofske Engineering, Inc. is not responsible for means, methods, and material furnished by the retaining wall contractor.

4.2 Construction Observations by Others

- a. Construction observations as required by the city shall be coordinated by the contractor.

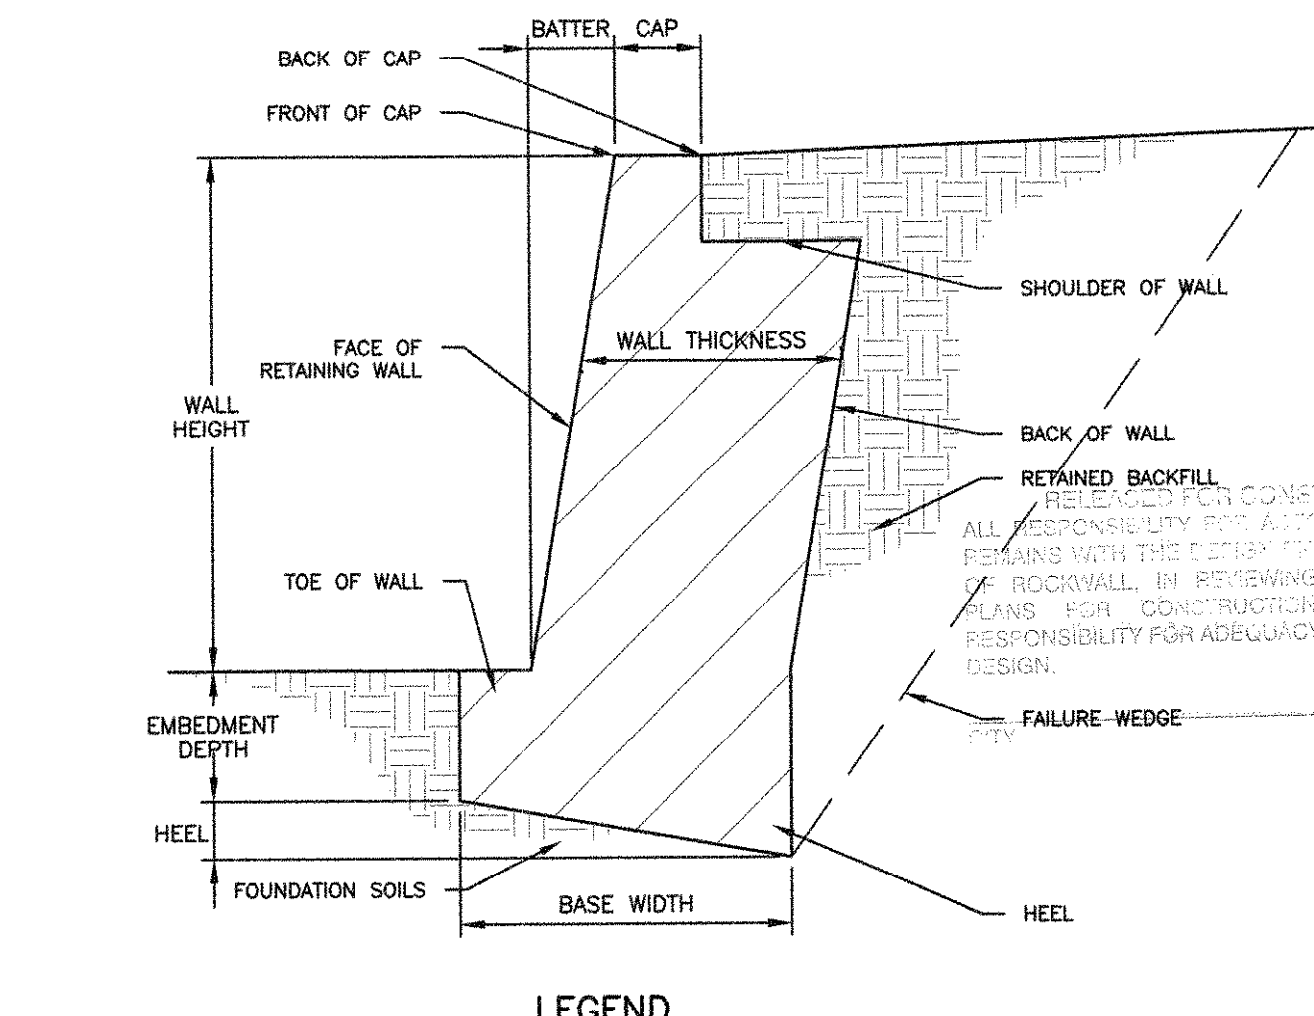


DATE	BY	NO.	DATE	BY
03-20-20	AMB			
03-20-20	RL			
03-20-20	AMB			

Falkofske Engineering, Inc.
 Structural Engineering Consultants
 TX Reg. Engineering Firm F-4038
 722 North Fielder Road
 Arlington, Texas 76012
 (817) 261-8300





This is a true and correct copy of the original design for which reproduction or distribution is prohibited. Any other reproduction, reuse, or modification, in whole or in part, is prohibited. Falkofske Engineering, Inc. assumes no responsibility for any errors or omissions in this document.

MASONRY RETAINING WALLS - NOTES & STANDARD DETAILS
 HARBOR HILLS
 SUMMER LEE DRIVE
 ROCKWALL, TEXAS

WALCO RETAINING WALLS, INC.
 4800 S.E. LOOP 820
 FORT WORTH, TEXAS 76140

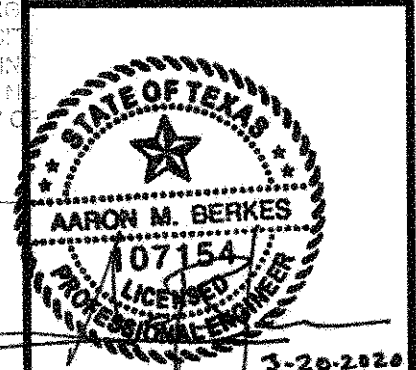

JOB NO. 151.20
 RW1

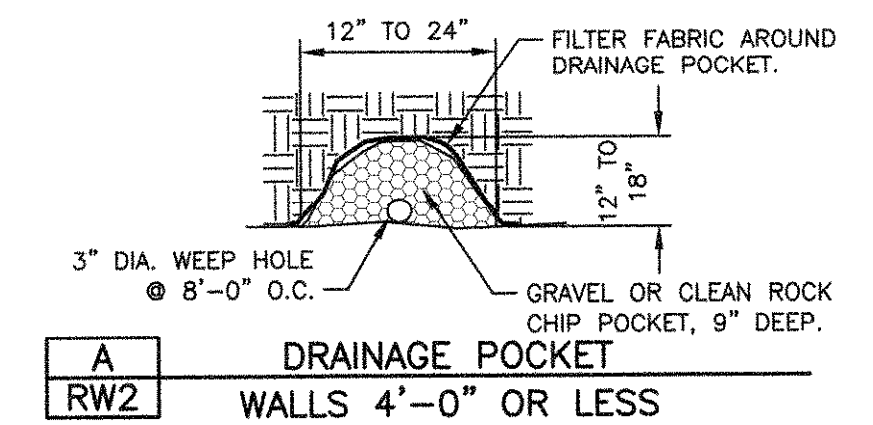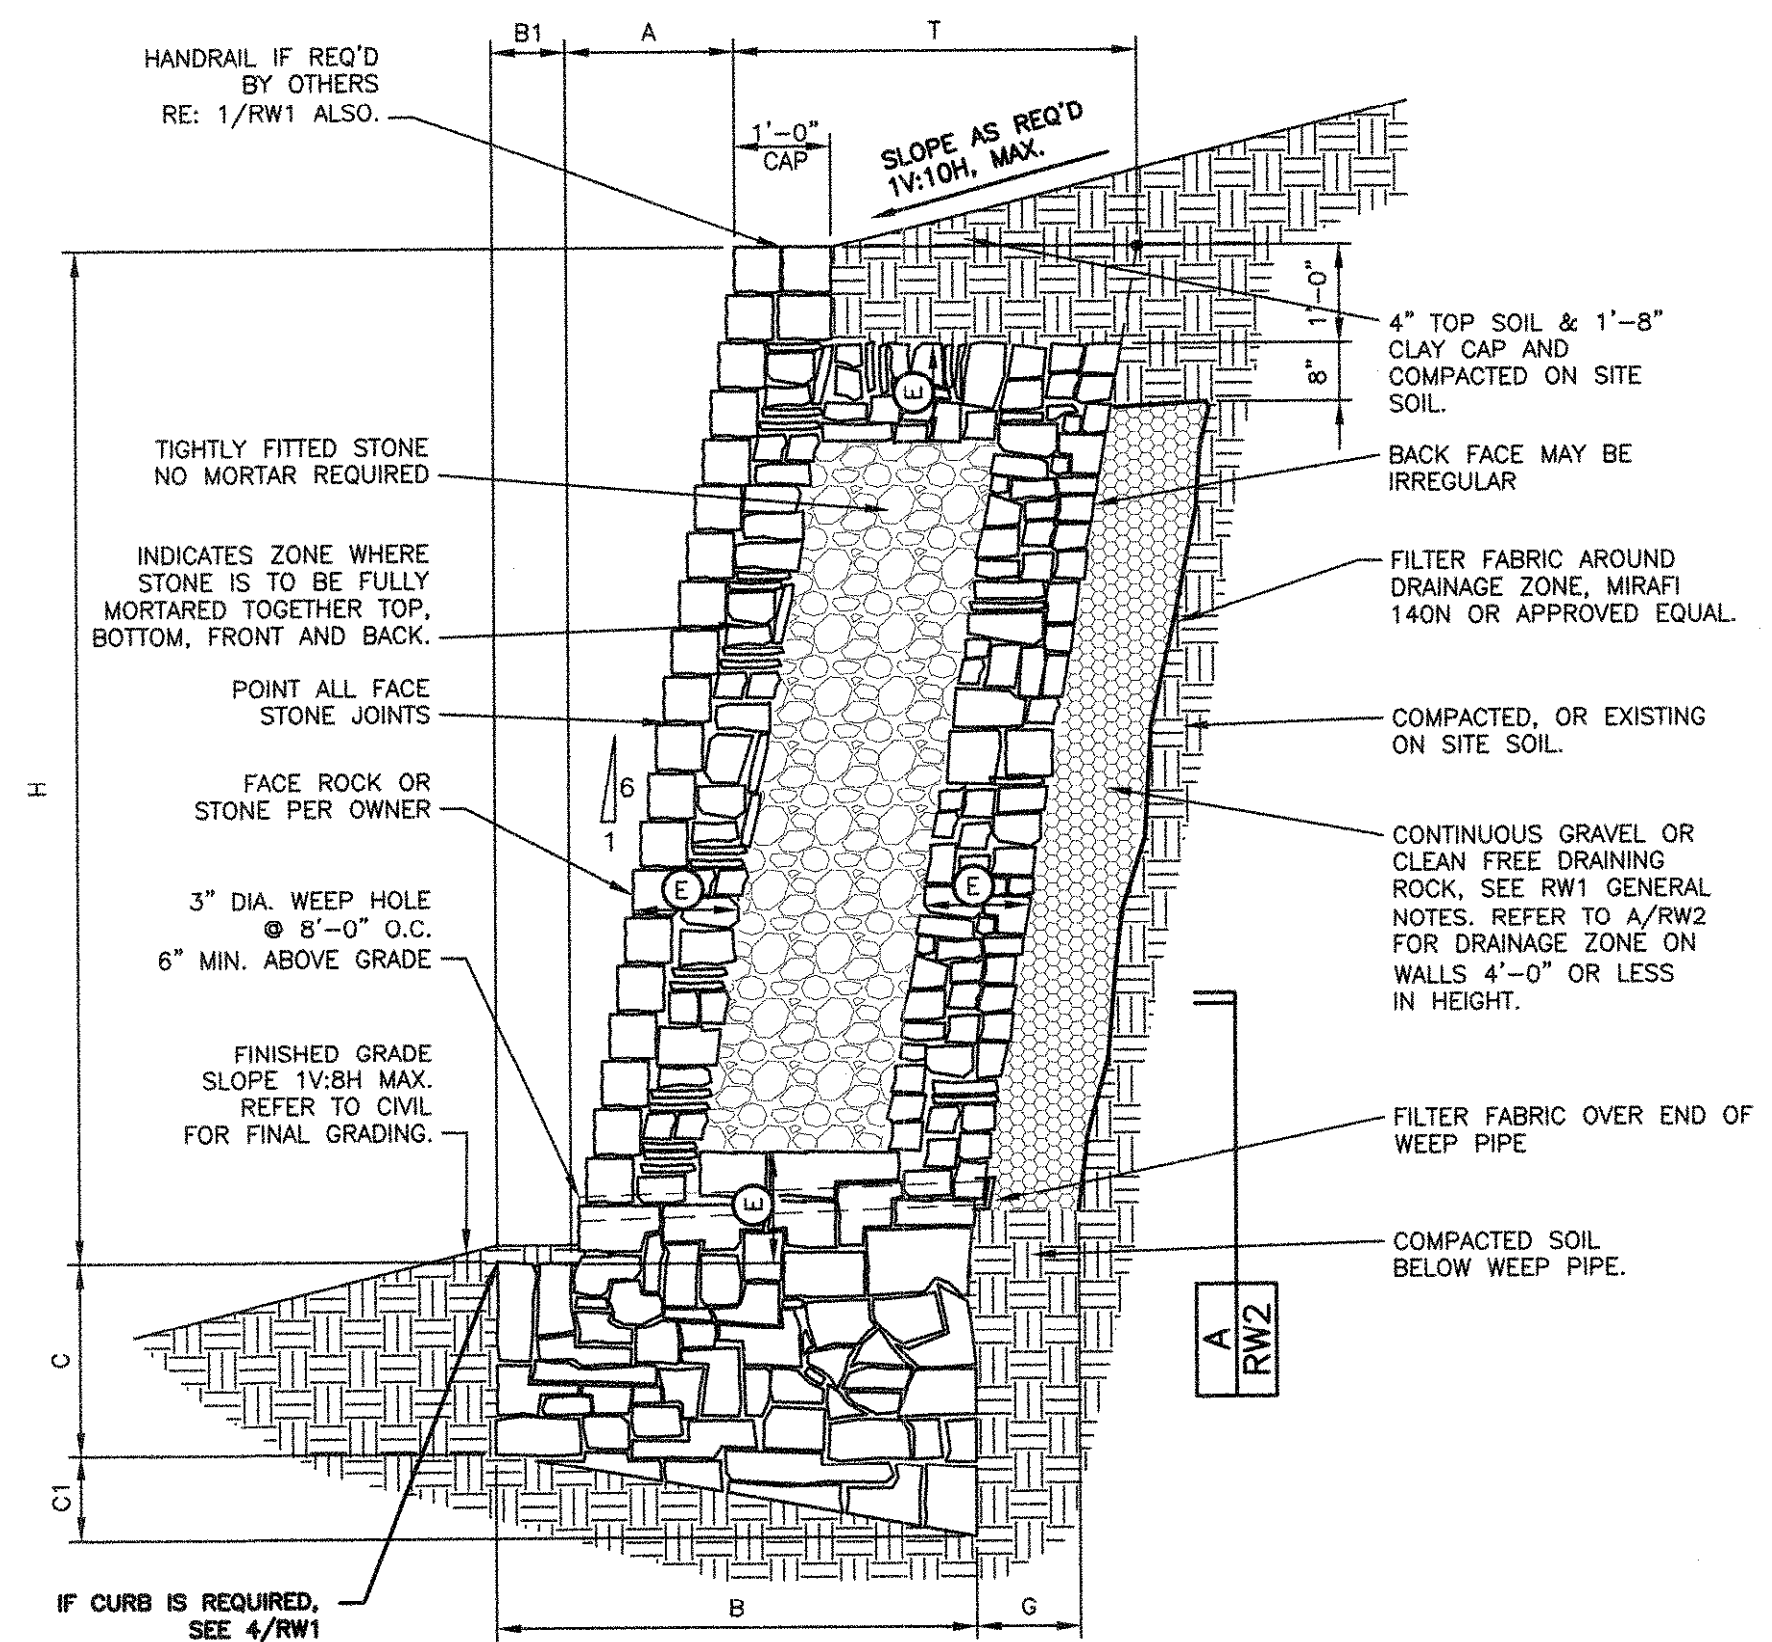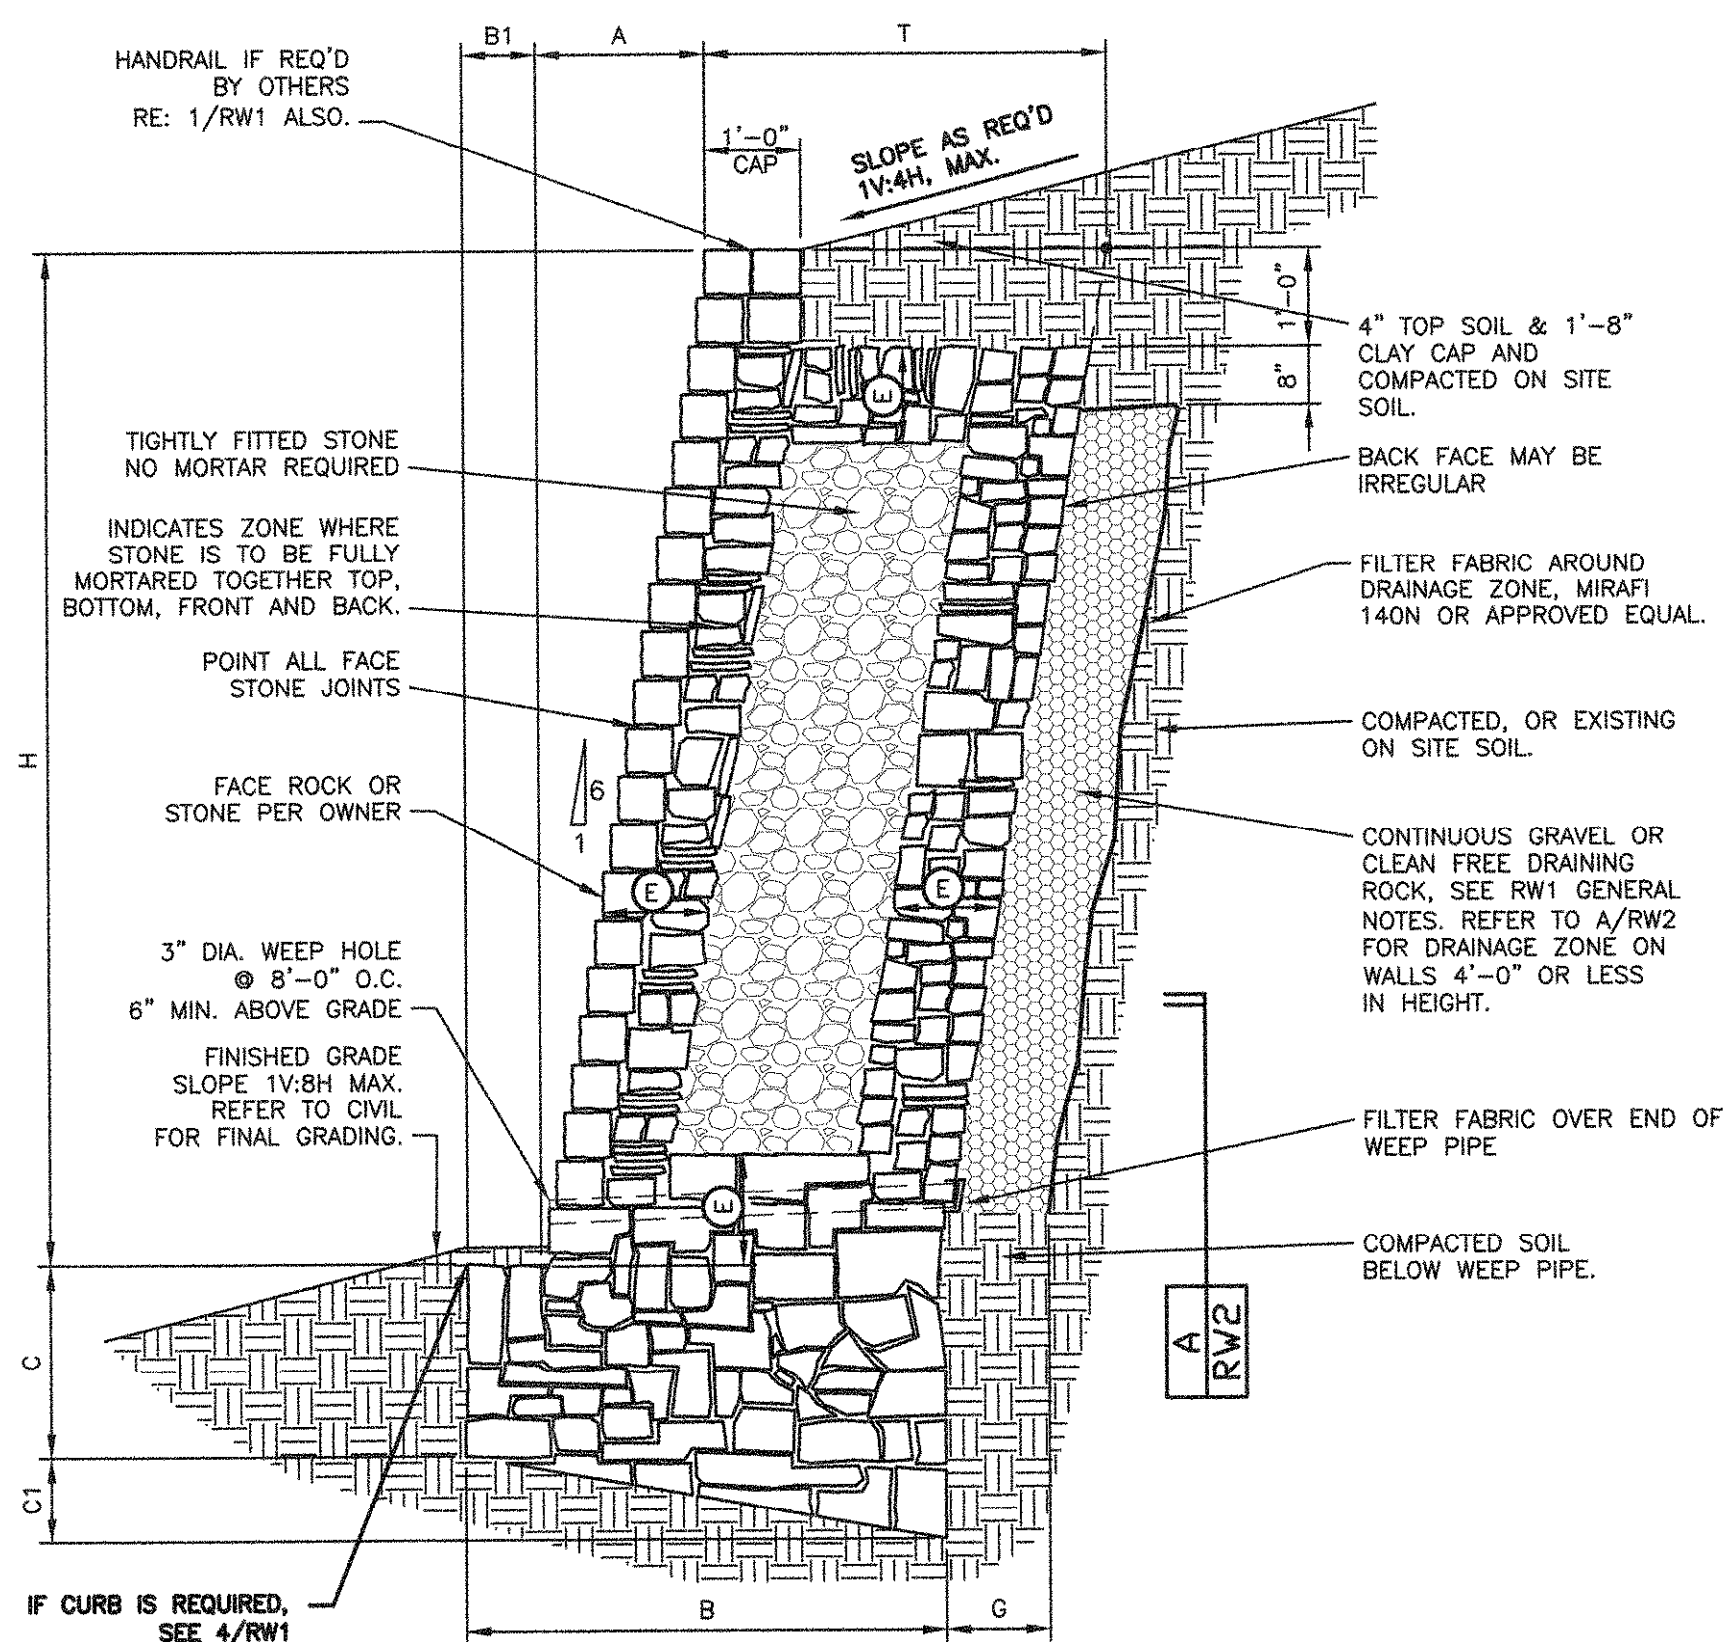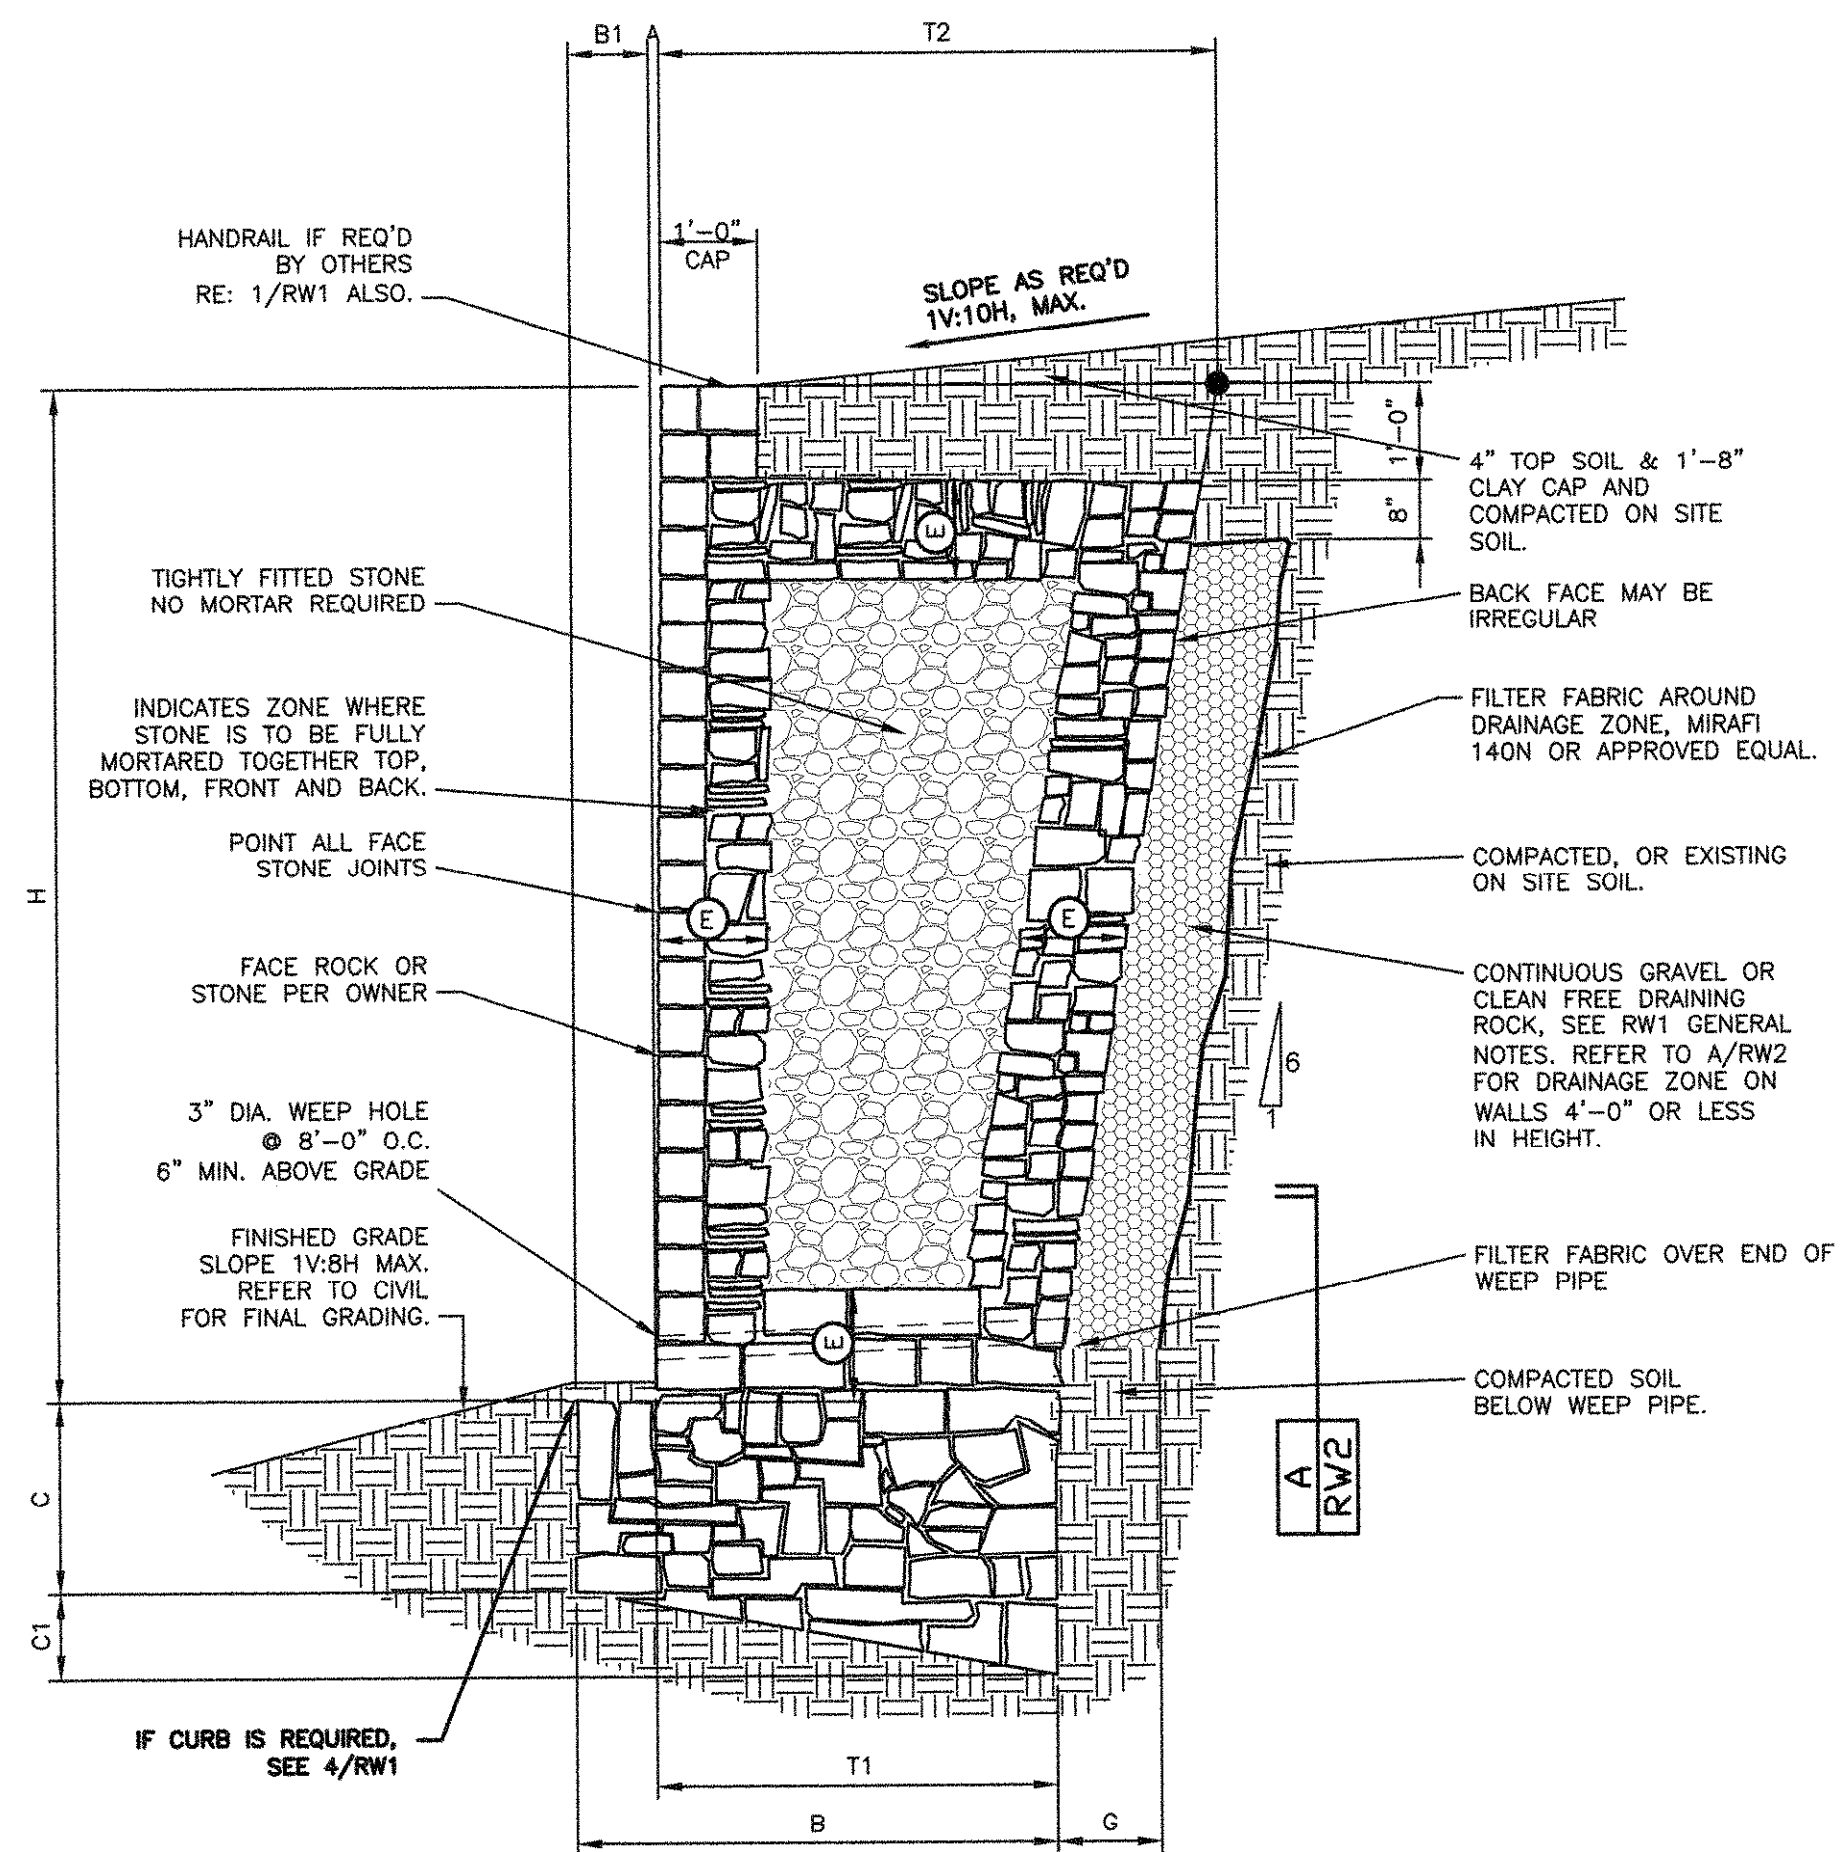

MASONRY WALL SCHEDULE											
1600 psf - BEARING CAPACITY (STIFF NATURAL UNDISTURBED SOILS OR COMPACTED AND TESTED SOILS SEE GENERAL NOTES SHEET RW1)											
WALL HEIGHT H	BASE WIDTH B	TOE B1	BASE DEPTH (TOE) C	BASE DEPTH (HEEL) C1	BATTER A	FULLY MORTARED ZONE E	THICKNESS OF WALL T1	THICKNESS OF WALL T2	DRAINAGE ZONE THICKNESS G	BEARING CAPACITY	
1'-0"	1'-0"	0'-0"	0'-6"	0'-2"	1/4"	DAILY MORTARED	1'-0"	1'-2"	SEE A/RW2	1500 psf	
2'-0"	1'-2"	0'-2"	0'-9"	0'-3"	1/2"	DAILY MORTARED	1'-0"	1'-4"	SEE A/RW2		
3'-0"	1'-6"	0'-3"	0'-9"	0'-4"	3/4"	DAILY MORTARED	1'-3"	1'-9"	SEE A/RW2		
4'-0"	2'-1"	0'-5"	1'-0"	0'-5"	1"	DAILY MORTARED	1'-8"	2'-4"	SEE A/RW2		
5'-0"	2'-9"	0'-7"	1'-3"	0'-6"	0'-1 1/4"	DAILY MORTARED	0'-8"	2'-2"	3'-0"		1'-0"
6'-0"	3'-5"	0'-10"	1'-6"	0'-8"	0'-1 1/2"	DAILY MORTARED	0'-10"	2'-7"	3'-7"		1'-0"
7'-0"	4'-0"	1'-0"	1'-9"	0'-9"	0'-1 3/4"	DAILY MORTARED	3'-0"	4'-2"	1'-0"		1700 psf
8'-0"	4'-10"	1'-4"	2'-3"	0'-11"	0'-2"	DAILY MORTARED	1'-0"	3'-8"	4'-10"		1'-0"

WALL DESIGN CRITERIA						
BEARING Q _u	SLOPE TOP β	SLOPE BOT β ₁	ACTIVE PRESSURE P _a	PASSIVE PRESSURE P _p	FRICTION ANGLE BASE δ	SLOPE OF BACK OF WALL α
1500PSF	5.71 deg	7.13 deg	26 deg	26 deg	17 deg	99.46 deg

USE THIS SCHEDULE FOR 3/RW2

MASONRY WALL SCHEDULE										
1600 psf - BEARING CAPACITY (STIFF NATURAL UNDISTURBED SOILS SEE GENERAL NOTES SHEET RW1)										
WALL HEIGHT H	BASE WIDTH B	TOE B1	BASE DEPTH (TOE) C	BASE DEPTH (HEEL) C1	BATTER A	FULLY MORTARED ZONE E	THICKNESS OF WALL T1	THICKNESS OF WALL T2	DRAINAGE ZONE THICKNESS G	BEARING CAPACITY
1'-0"	1'-0"	0'-0"	0'-6"	0'-2"	0'-2"	DAILY MORTARED	1'-0"	1'-2"	1'-0"	1500 psf
2'-0"	1'-4"	0'-2"	0'-9"	0'-3"	0'-4"	DAILY MORTARED	1'-2"	1'-4"	1'-0"	
3'-0"	1'-9"	0'-3"	0'-9"	0'-4"	0'-6"	DAILY MORTARED	1'-6"	1'-9"	1'-0"	
4'-0"	2'-7"	0'-4"	1'-0"	0'-6"	0'-8"	DAILY MORTARED	2'-3"	1'-0"	1'-0"	
5'-0"	3'-3"	0'-5"	1'-3"	0'-7"	0'-10"	DAILY MORTARED	0'-8"	2'-10"	1'-0"	
6'-0"	4'-0"	0'-7"	1'-6"	0'-9"	0'-10"	DAILY MORTARED	0'-10"	3'-5"	1'-0"	
7'-0"	4'-10"	0'-9"	1'-9"	0'-10"	1'-2"	DAILY MORTARED	0'-10"	4'-1"	1'-0"	
8'-0"	5'-8"	0'-10"	2'-3"	1'-0"	1'-4"	DAILY MORTARED	1'-0"	4'-10"	1'-0"	
9'-0"	6'-10"	0'-11"	2'-6"	1'-3"	1'-6"	DAILY MORTARED	1'-0"	5'-11"	1'-0"	1700 psf
10'-0"	7'-7"	1'-0"	3'-0"	1'-5"	1'-8"	DAILY MORTARED	1'-2"	6'-7"	1'-0"	1900 psf
11'-0"	8'-5"	1'-1"	3'-6"	1'-6"	1'-10"	DAILY MORTARED	1'-2"	7'-4"	1'-0"	1900 psf

WALL DESIGN CRITERIA						
BEARING Q _u	SLOPE TOP β	SLOPE BOT β ₁	ACTIVE PRESSURE P _a	PASSIVE PRESSURE P _p	FRICTION ANGLE BASE δ	SLOPE OF BACK OF WALL α
1500PSF	14 deg	7.13 deg	26 deg	26 deg	17 deg	99.46 deg

USE THIS SCHEDULE FOR 2/RW2

MASONRY WALL SCHEDULE										
1600 psf - BEARING CAPACITY (STIFF NATURAL UNDISTURBED SOILS SEE GENERAL NOTES SHEET RW1)										
WALL HEIGHT H	BASE WIDTH B	TOE B1	BASE DEPTH (TOE) C	BASE DEPTH (HEEL) C1	BATTER A	FULLY MORTARED ZONE E	THICKNESS OF WALL T1	THICKNESS OF WALL T2	DRAINAGE ZONE THICKNESS G	BEARING CAPACITY
1'-0"	1'-0"	0'-0"	0'-6"	0'-2"	0'-2"	DAILY MORTARED	1'-0"	1'-2"	1'-0"	1500 psf
2'-0"	1'-2"	0'-2"	0'-9"	0'-3"	0'-4"	DAILY MORTARED	1'-2"	1'-4"	1'-0"	
3'-0"	1'-7"	0'-3"	0'-9"	0'-4"	0'-6"	DAILY MORTARED	1'-6"	1'-9"	1'-0"	
4'-0"	2'-3"	0'-4"	1'-0"	0'-5"	0'-8"	DAILY MORTARED	2'-3"	1'-0"	1'-0"	
5'-0"	2'-9"	0'-5"	1'-3"	0'-6"	0'-10"	DAILY MORTARED	0'-8"	2'-4"	1'-0"	
6'-0"	3'-5"	0'-7"	1'-6"	0'-8"	1'-0"	DAILY MORTARED	0'-10"	2'-10"	1'-0"	
7'-0"	4'-1"	0'-9"	1'-9"	0'-9"	1'-2"	DAILY MORTARED	0'-10"	3'-4"	1'-0"	
8'-0"	4'-11"	0'-11"	2'-3"	0'-11"	1'-4"	DAILY MORTARED	1'-0"	4'-0"	1'-0"	
9'-0"	5'-11"	1'-1"	2'-6"	1'-1"	1'-6"	DAILY MORTARED	1'-0"	4'-10"	1'-0"	1700 psf
10'-0"	6'-8"	1'-3"	3'-0"	1'-2"	1'-8"	DAILY MORTARED	1'-2"	5'-5"	1'-0"	1900 psf
11'-0"	7'-4"	1'-4"	3'-6"	1'-4"	1'-10"	DAILY MORTARED	1'-2"	6'-0"	1'-0"	1900 psf

WALL DESIGN CRITERIA						
BEARING Q _u	SLOPE TOP β	SLOPE BOT β ₁	ACTIVE PRESSURE P _a	PASSIVE PRESSURE P _p	FRICTION ANGLE BASE δ	SLOPE OF BACK OF WALL α
1500PSF	5.71 deg	7.13 deg	26 deg	26 deg	17 deg	99.46 deg

USE THIS SCHEDULE FOR 1/RW2

3 RW2 TYPICAL VERTICAL WALL SECTION - 1V:10H MAX SLOPE ABOVE WALL BEARING IN CLAYEY OR SANDY SOILS 3/4" = 1'-0"

2 RW2 TYPICAL WALL SECTION BEARING IN CLAYS MAX. SLOPE ABOVE WALL 1V:4H MAX. SLOPE BELOW WALL 1V:8H

1 RW2 TYPICAL WALL SECTION - 1V:8H MAX SLOPE ABOVE WALL BEARING IN CLAYEY OR SANDY SOILS 1/2" = 1'-0"


DATE	BY	REVISION
03-20-20	AMB	
03-20-20	RL	
03-20-20	AMB	

Falkofsky Engineering, Inc.
Structural Engineering Consultants
Texas Registration F-4038
722 North Fielder Road
Arlington, Texas 76012
(817) 261-8300





The use of this plan, specification, or schedule is limited to the project and site for which it was prepared. It is not to be used for any other project, site, or purpose without the written consent of Falkofsky Engineering, Inc. Any reproduction, in whole or in part, is prohibited. Falkofsky Engineering, Inc. is not responsible for any errors or omissions in this document.

MASONRY RETAINING WALLS
HARBOR HILLS
SUMMER LEE DRIVE
ROCKWALL, TEXAS
WALCO RETAINING WALLS, INC.
4800 S.E. LOOP 820
FORT WORTH, TEXAS 76140

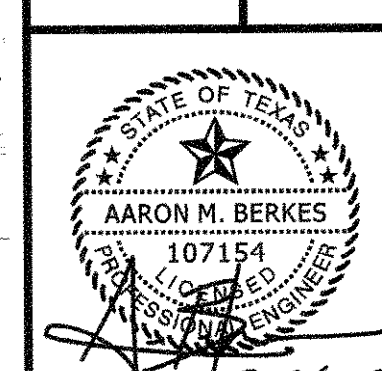

15-26-20
JOB NO. 151.20
RW2

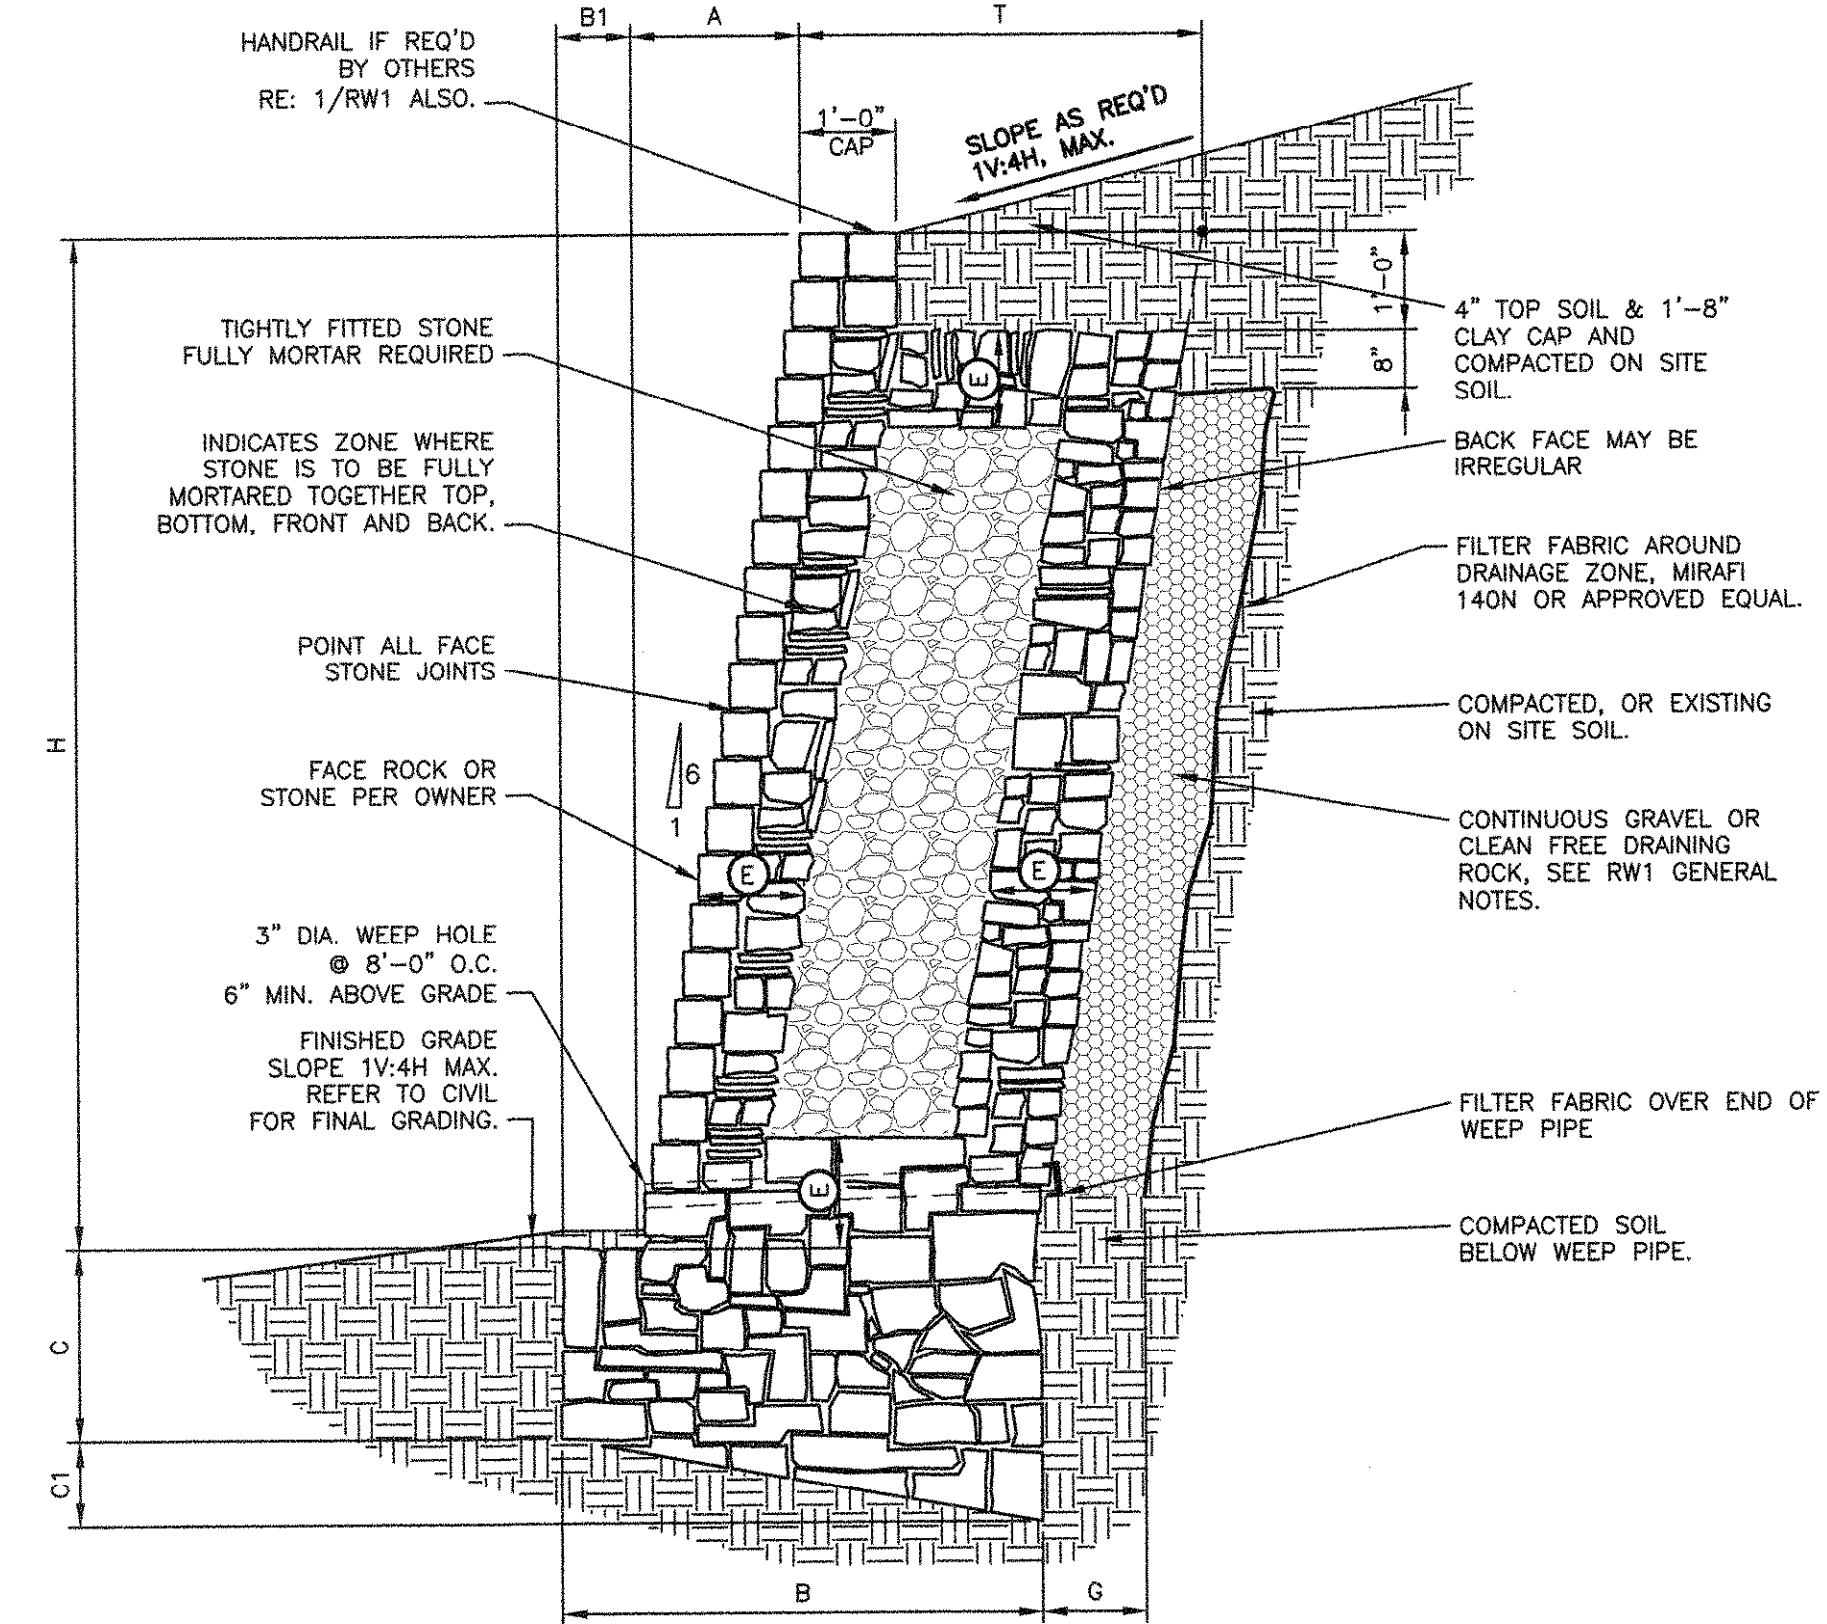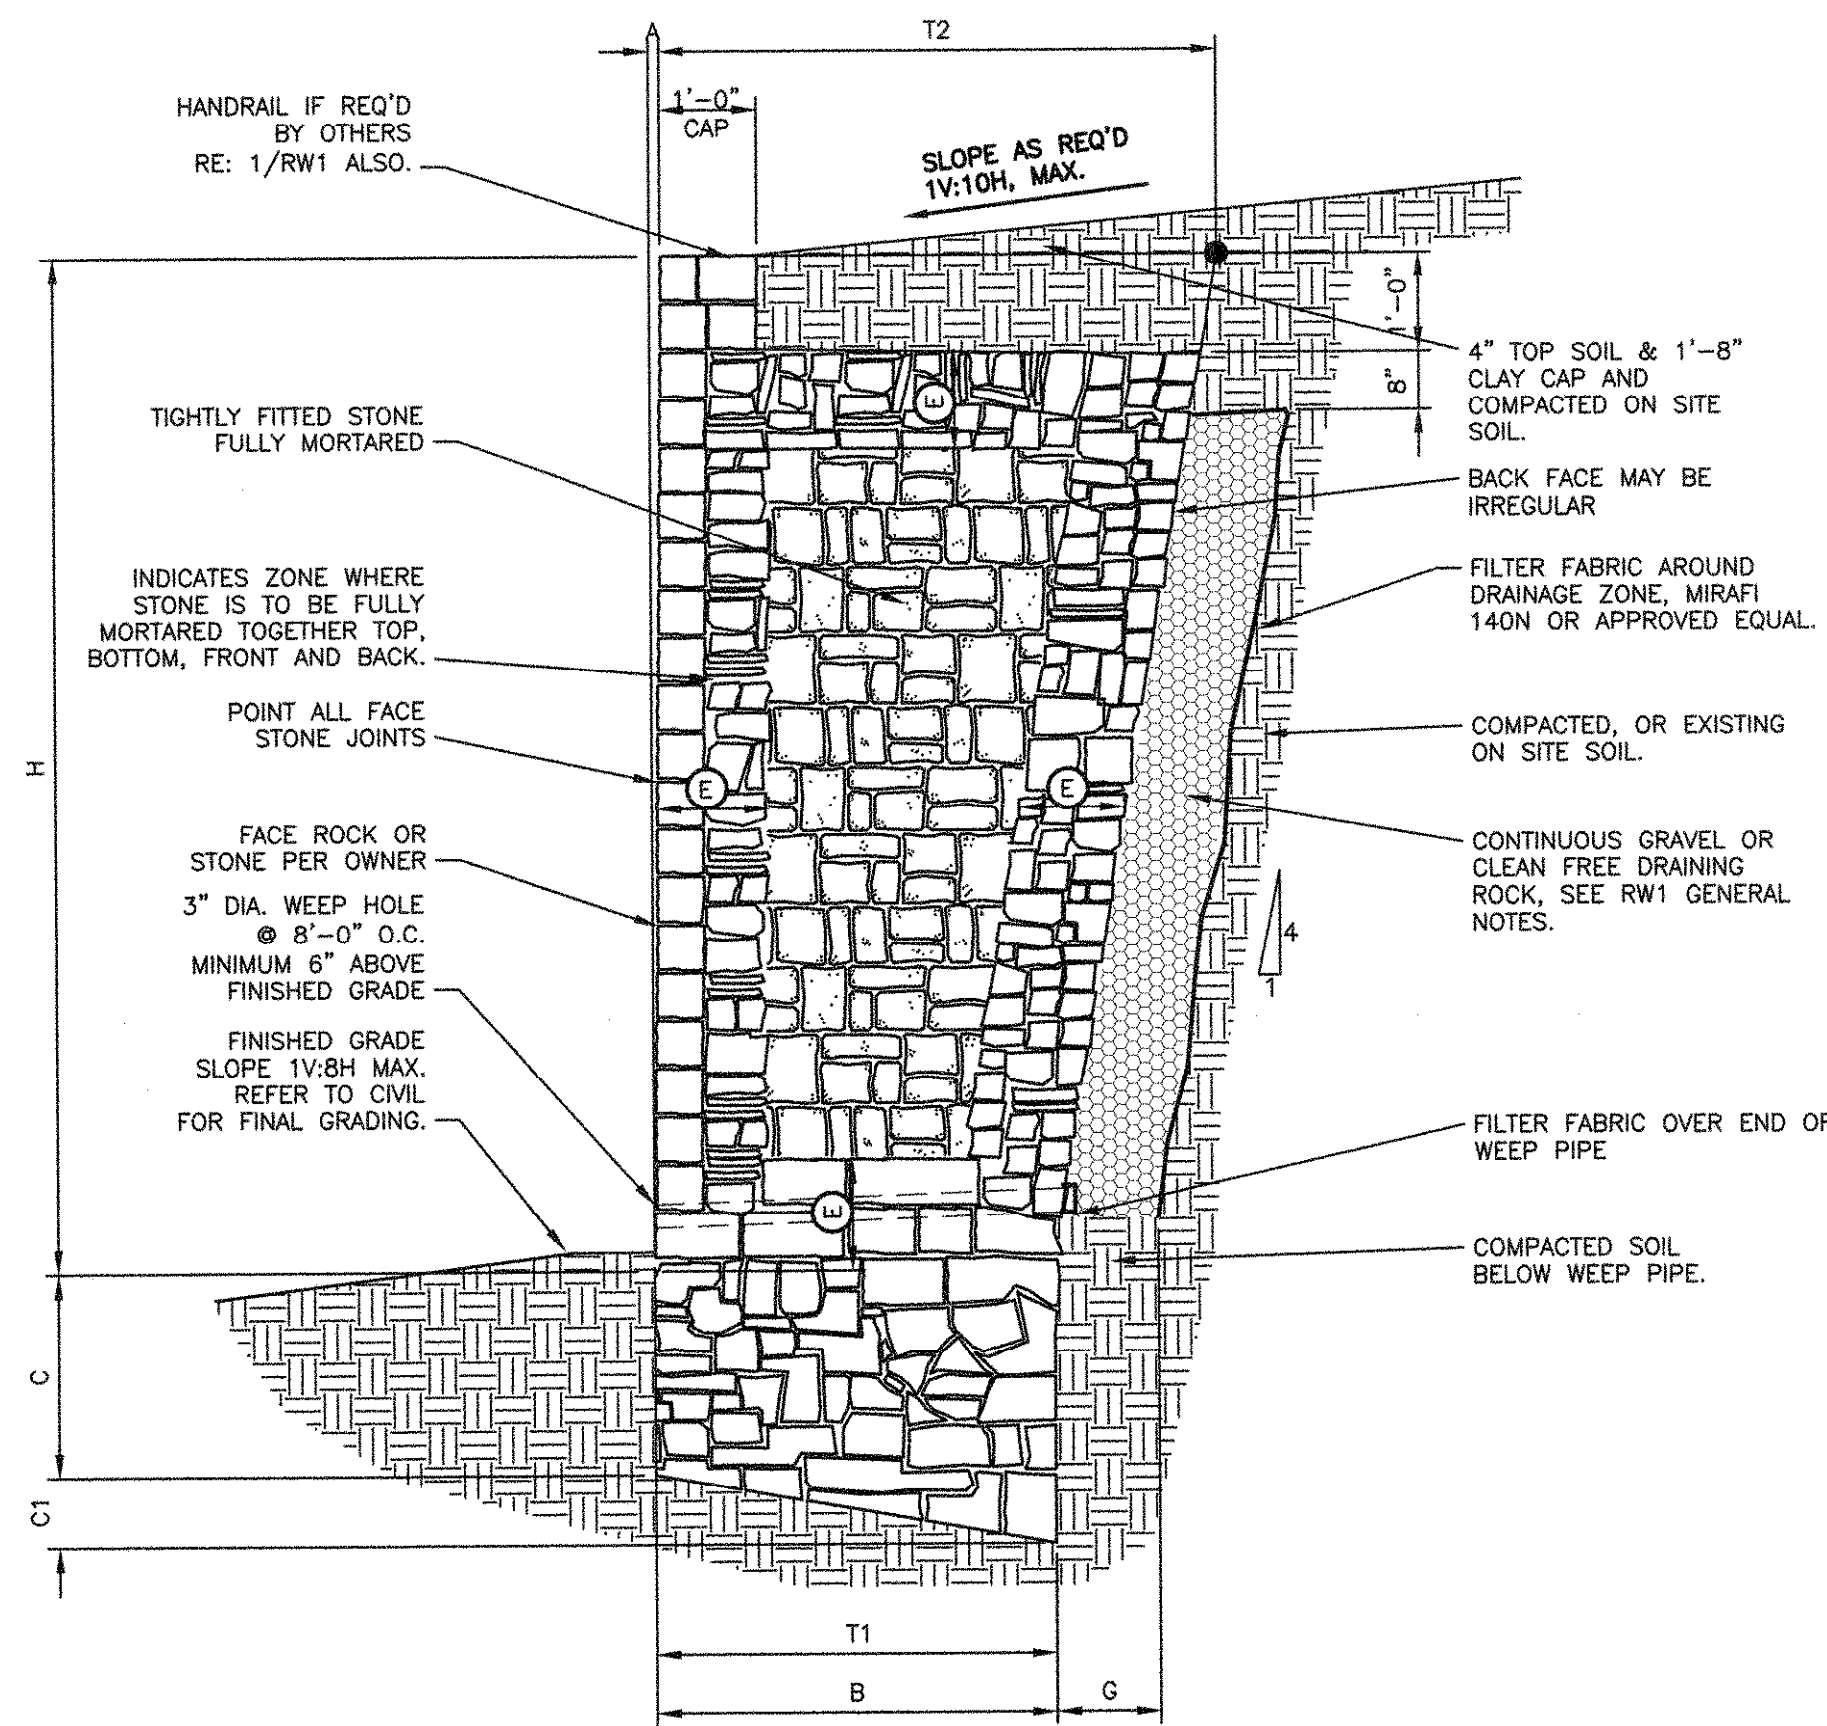

MASONRY WALL SCHEDULE
1800 psf - BEARING CAPACITY (STIFF NATURAL UNDISTURBED SOILS OR COMPACTED AND TESTED SOILS SEE GENERAL NOTES SHEET RW1)

WALL HEIGHT H	BASE WIDTH B	BASE DEPTH (TOE) C	BASE DEPTH (HEEL) C1	BATTER A	FULLY MORTARED ZONE E	THICKNESS OF WALL T1	THICKNESS OF WALL T2	DRAINAGE ZONE THICKNESS G	BEARING CAPACITY D
4'-0"	2'-0"	1'-0"	0'-5"	0'-1"	DAILY MORTARED	2'-0"	3'-0"	1'-0"	1500 psf
5'-0"	2'-6"	1'-3"	0'-6"	0'-1 1/4"	DAILY MORTARED	2'-6"	3'-9"	1'-0"	1500 psf
6'-0"	3'-0"	1'-6"	0'-7"	0'-1 1/2"	DAILY MORTARED	3'-0"	4'-6"	1'-0"	1850 psf
7'-0"	3'-6"	1'-9"	0'-8"	0'-1 1/2"	DAILY MORTARED	3'-6"	5'-3"	1'-0"	2150 psf

WALL DESIGN CRITERIA

BEARING Q _u	SLOPE TOP β	SLOPE BOT β ₁	ACTIVE PRESSURE α _a	PASSIVE PRESSURE α _p	FRICTION ANGLE BASE δ	SLOPE OF BACK OF WALL α	SURCHARGE q
1500PSF	5.71 deg	7.13 deg	26 deg	26 deg	17 deg	104.04 deg	0 psf

USE THIS SCHEDULE FOR 2/RW3

MASONRY WALL SCHEDULE
1800 psf - BEARING CAPACITY (STIFF NATURAL UNDISTURBED SOILS OR COMPACTED AND TESTED SOILS SEE GENERAL NOTES SHEET RW1)

WALL HEIGHT H	BASE WIDTH B	TOE DEPTH (TOE) C	BASE DEPTH (HEEL) C1	BATTER A	FULLY MORTARED ZONE E	THICKNESS OF WALL T1	DRAINAGE ZONE THICKNESS G	BEARING CAPACITY D
5'-0"	3'-6"	0'-5"	3'-0"	0'-8"	0'-10"	0'-9"	3'-1"	1'-0"
6'-0"	4'-3"	0'-6"	3'-6"	0'-9"	1'-0"	1'-0"	3'-9"	1'-0"
7'-0"	5'-2"	0'-7"	4'-0"	0'-11"	1'-2"	1'-0"	4'-7"	1'-0"
8'-0"	6'-1"	0'-8"	4'-6"	1'-1"	1'-4"	1'-3"	5'-5"	1'-0"
9'-0"	7'-3"	0'-9"	5'-0"	1'-3"	1'-6"	1'-3"	6'-6"	1'-0"
10'-0"	8'-1"	0'-10"	6'-0"	1'-6"	1'-8"	1'-6"	7'-3"	1'-0"
11'-0"	9'-0"	1'-0"	7'-0"	1'-7"	1'-10"	1'-6"	8'-0"	1'-0"

WALL DESIGN CRITERIA

BEARING Q _u	SLOPE TOP β	SLOPE BOT β ₁	ACTIVE PRESSURE α _a	PASSIVE PRESSURE α _p	FRICTION ANGLE BASE δ	SLOPE OF BACK OF WALL α	SURCHARGE q
1500psf	14 deg	14 deg	26 deg	26 deg	17 deg	99.46 deg	0 psf


USE THIS SCHEDULE FOR 1/RW3

2 RW3 TYPICAL VERTICAL WALL SECTION - 1V:10H MAX SLOPE ABOVE WALL BEARING IN CLAYEY OR SANDY SOILS 3/4" = 1'-0"

1 RW3 TYPICAL WALL SECTION - 1V:4H MAX SLOPE ABOVE WALL 1V:4H MAX SLOPE BELOW WALL BEARING IN CLAYEY SOILS 1/2" = 1'-0"


DATE	BY	CHK	DATE	BY	CHK
03-20-20	AMB	RL	03-20-20	AMB	RL
03-20-20	RL	AMB	03-20-20	AMB	RL

Falkofski Engineering, Inc.
Structural Engineering Consultants
Texas Registration F-4038
722 North Fielder Road
Arlington, Texas 76012
(817) 261-8300

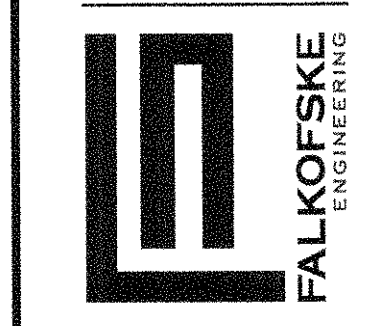





The use of this plan for any other project than that for which it was prepared is prohibited. Any other reproduction, reuse, or modification of this plan, in whole or in part, is prohibited. This plan contains proprietary information of Falkofski Engineering, Inc.

MASONRY RETAINING WALLS
HARBOR HILLS
SUMMER LEE DRIVE
ROCKWALL, TEXAS
WALCO RETAINING WALLS, INC.
4800 S.E. LOOP 820
FORT WORTH, TEXAS 76140

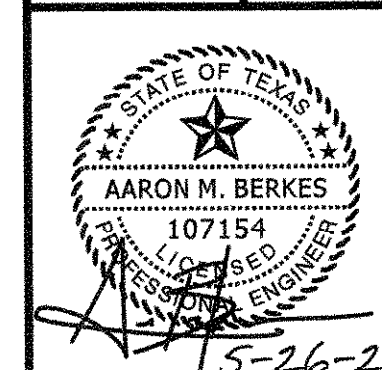

JOB NO. 151.20

RW3

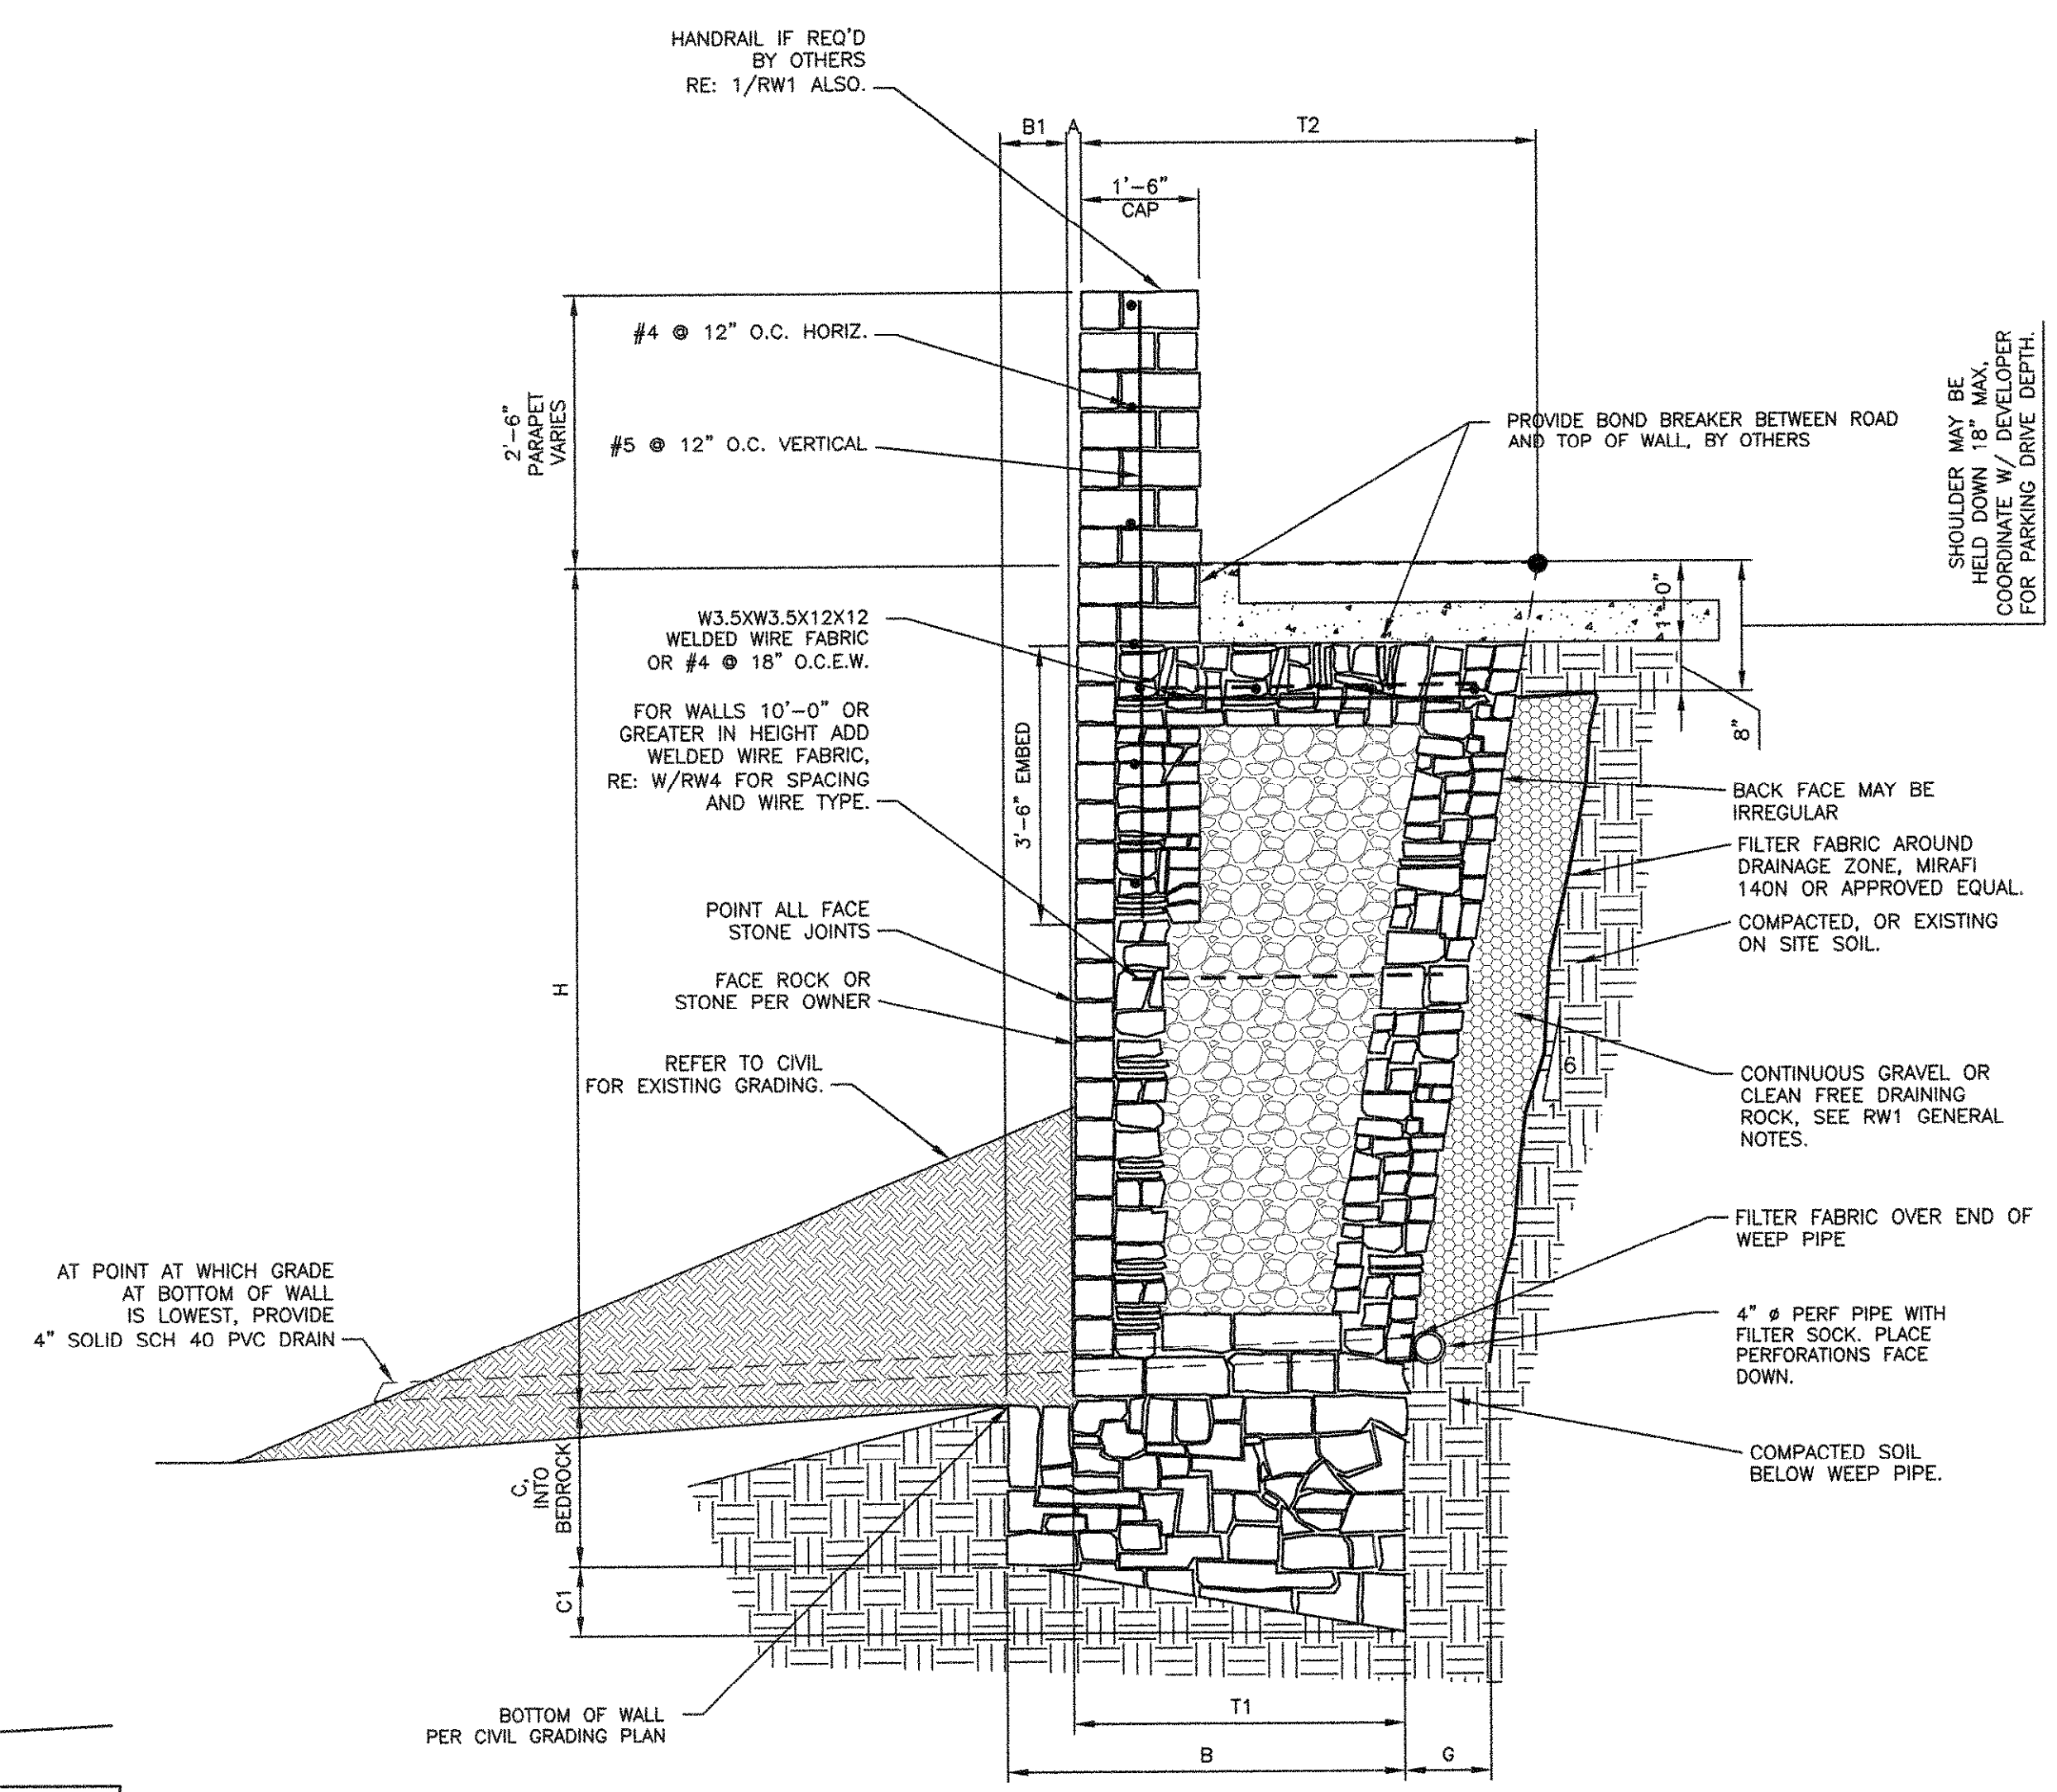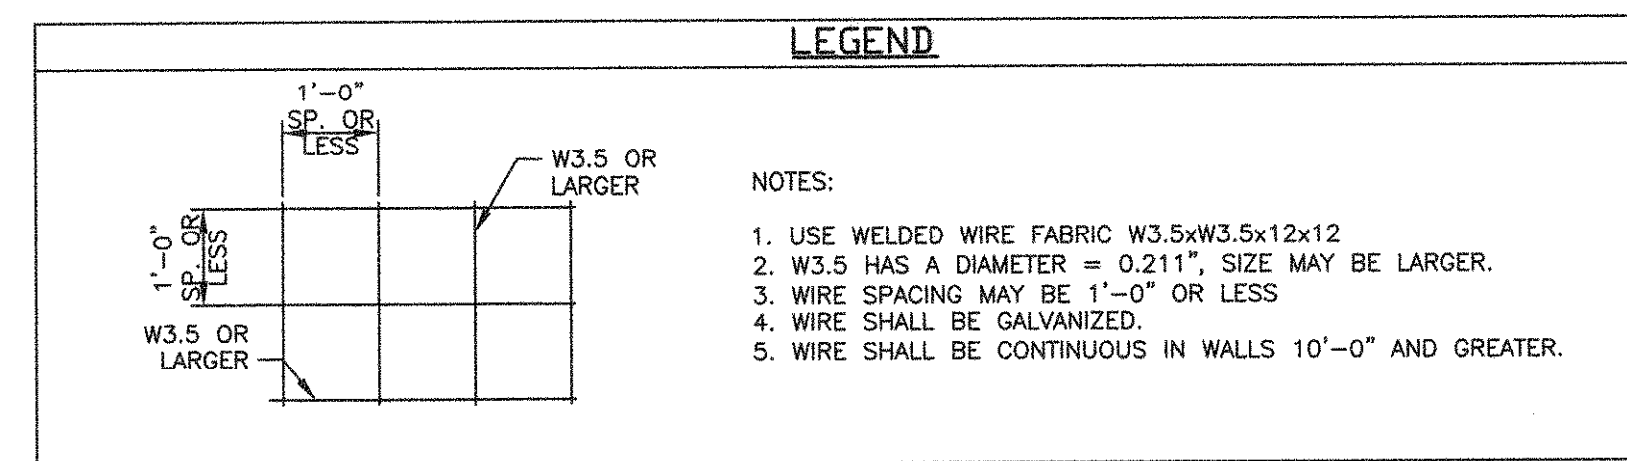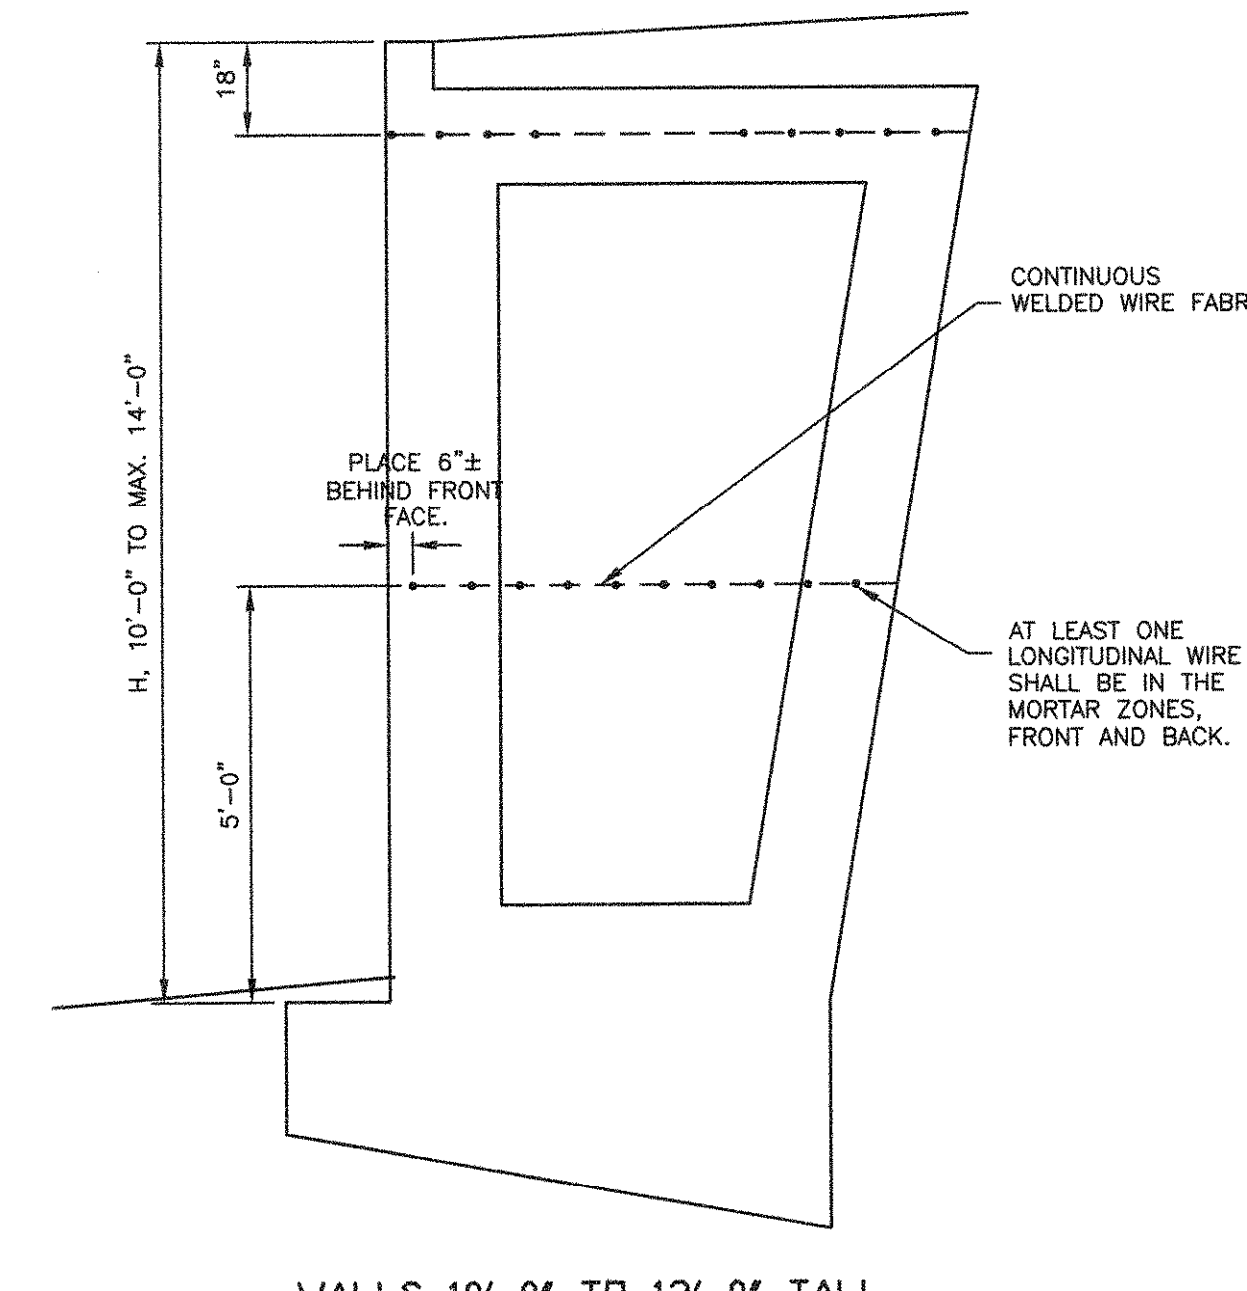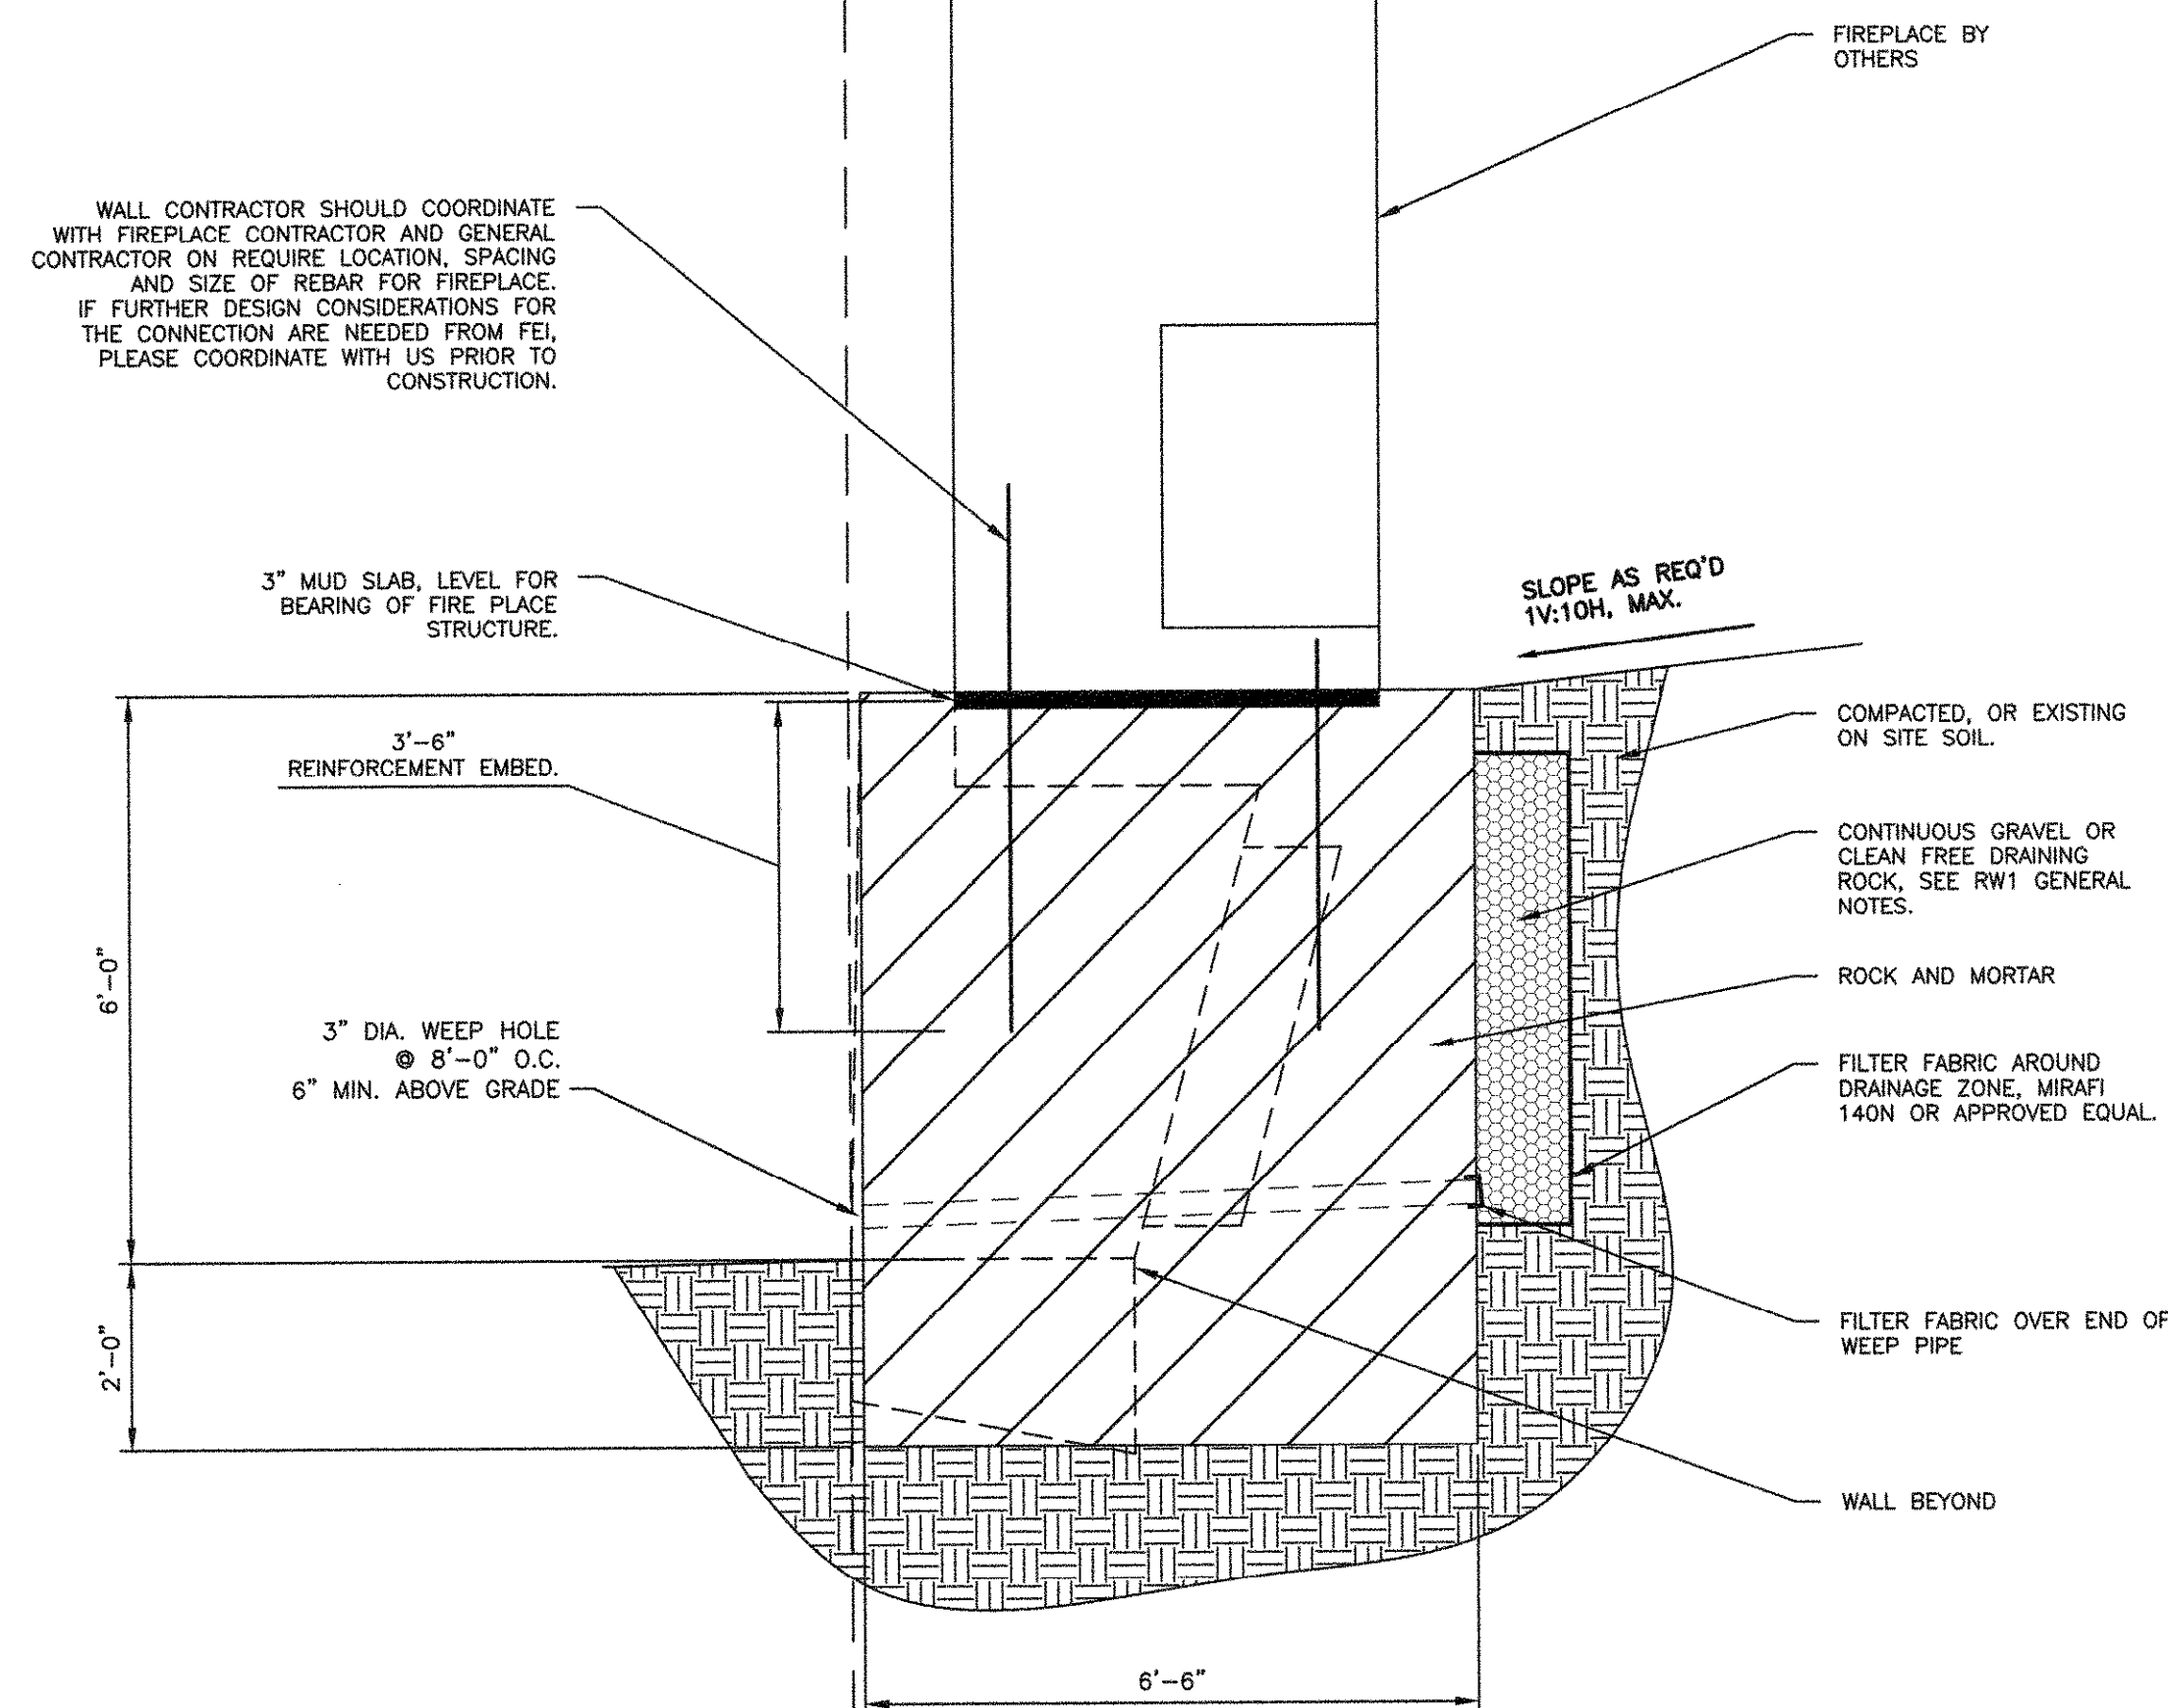

MASONRY WALL SCHEDULE
1000 psf - BEARING CAPACITY (STIFF NATURAL UNDISTURBED SOILS OR COMPACTED AND TESTED SOILS SEE GENERAL NOTES SHEET RW1)

WALL HEIGHT H	BASE WIDTH B	TOE B1	BASE DEPTH (TOE) C	BASE DEPTH (HEEL) C1	BATTER A	WEEDING ZONE E	THICKNESS OF WALL T1	THICKNESS OF WALL T2	DRAINAGE ZONE THICKNESS G	BEARING CAPACITY
10'-0"	7'-1"	1'-10"	4'-0"	1'-3"	0'-2 1/2"	DRAIN MORTARED	5'-3"	6'-11"	1'-0"	3050 psf
11'-0"	7'-6"	2'-0"	4'-0"	1'-4"	0'-2 3/4"	DRAIN MORTARED	5'-6"	7'-4"	1'-3"	3150 psf
12'-0"	8'-1"	2'-2"	4'-0"	1'-6"	0'-3"	DRAIN MORTARED	5'-11"	7'-11"	1'-3"	3200 psf

WALL DESIGN CRITERIA

BEARING CAPACITY	SLOPE TOP	SLOPE BOT	ACTIVE PRESSURE	PASSIVE PRESSURE	FRICITION ANGLE	SLOPE OF BACK OF WALL	SURCHARGE
1500PSF	0 deg	7.13 deg	26 deg	26 deg	17 deg	99.46 deg	250 psf

USE THIS SCHEDULE FOR 1/RW4

2
RW4 RETAINING WALL, PEDESTAL FOR FIREPLACE STRUCTURE

W
RW4 WIRE SPACING FOR WALLS - VERTICAL FACE WALLS 10'-0" AND GREATER

1
RW4 TYPICAL VERTICAL WALL SECTION - 250 PSF FIRELANE SURCHARGE 1V:8H MAX SLOPE BELOW WALL BEARING IN CLAYEY OR SANDY SOILS 3/4" = 1'-0"

DATE	BY	CHK.	REVISION
03-20-20	AMB		
03-20-20	RL		
03-20-20	AMB		

Falkofski Engineering, Inc.
Structural Engineering Consultants
Texas Registration F-4038
722 North Fielder Road
Arlington, Texas 76012
(817) 261-8300

FALKOFSKI ENGINEERING

The use of these plans and specifications does not constitute a warranty for which Falkofski Engineering, Inc. is not responsible. Any reproduction or distribution of these plans without the written consent of Falkofski Engineering, Inc. is prohibited. Falkofski Engineering, Inc. shall not be held liable for any errors or omissions in these plans.

MASONRY RETAINING WALLS
HARBOR HILLS
SUMMER LEE DRIVE
ROCKWALL, TEXAS


WALCO RETAINING WALLS, INC.
4800 S.E. LOOP 820
FORT WORTH, TEXAS 76140

RELEASED FOR CONSTRUCTION
ALL RESPONSIBILITY FOR ACCURACY OF DESIGN REMAINS WITH THE CLIENT. THE CITY OF ROCKWALL, IN REVIEWING AND RELEASING PLANS FOR CONSTRUCTION, ASSUMES NO RESPONSIBILITY FOR ADEQUACY OR ACCURACY OF DESIGN.


CITY _____ DATE _____

AARON M. BERKES
107154
Professional Engineer
6-26-20

JOB NO. 151.20
RW4

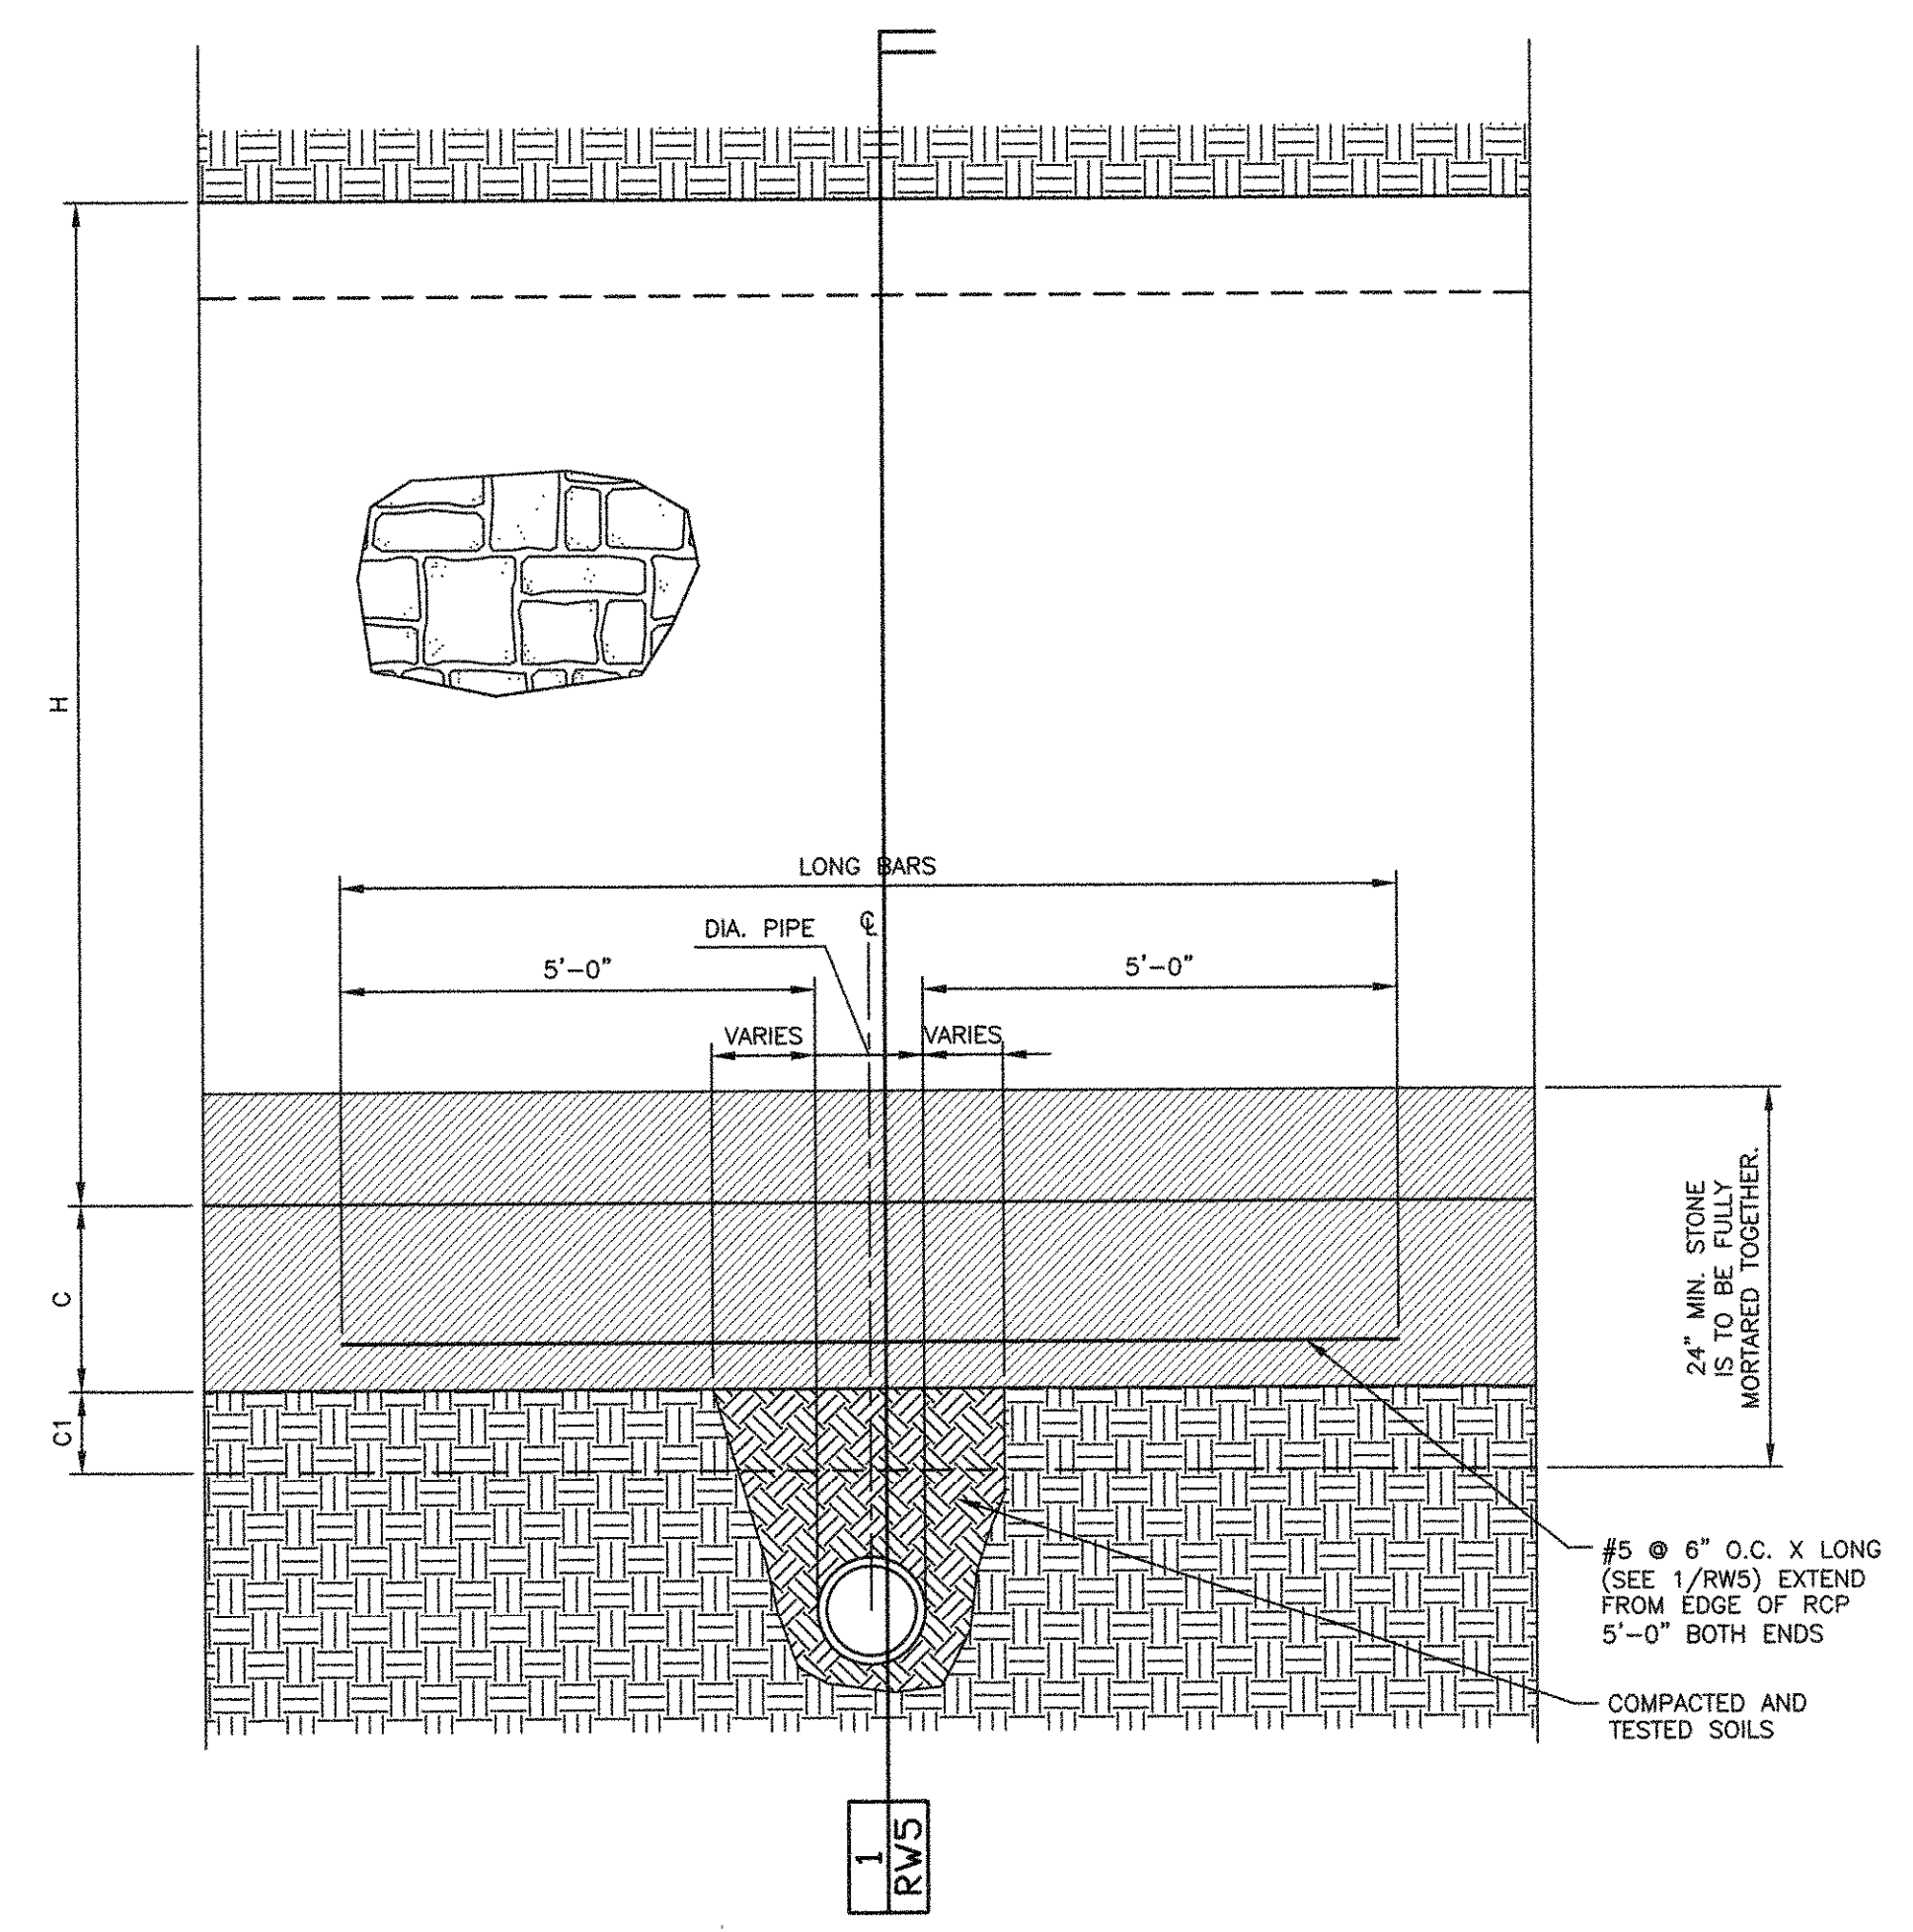


2
RW5 WALL ELEVATION W/RCP BELOW WALL

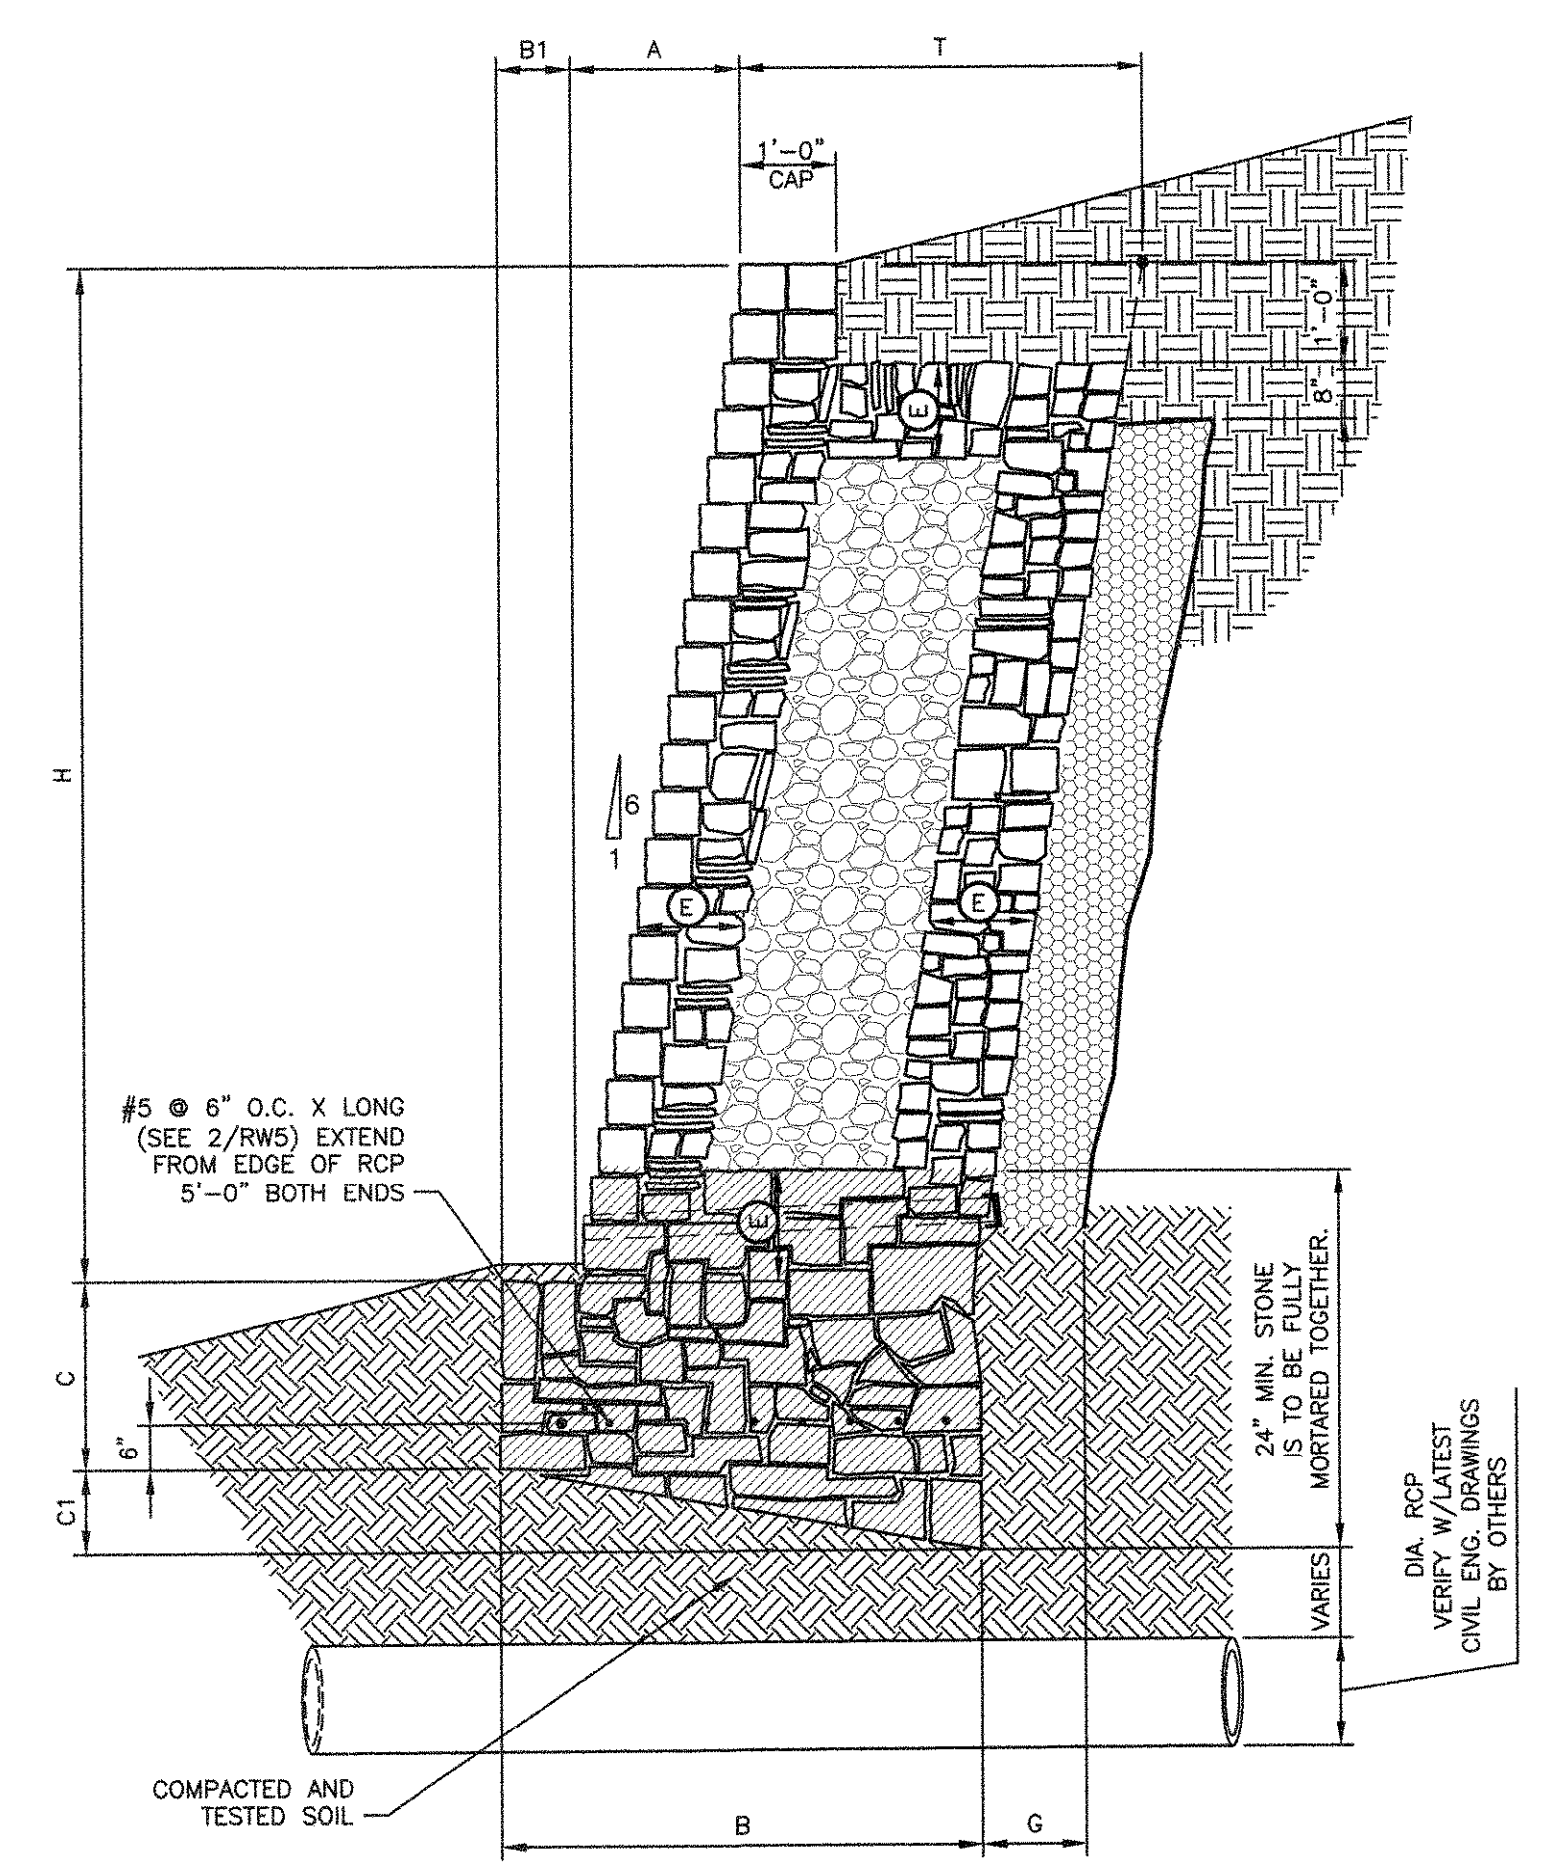

1
RW5 WALL SECTION W/RCP BELOW WALL

RELEASED FOR CONSTRUCTION
 ALL RESPONSIBILITY FOR ADEQUACY OF DESIGN
 REMAINS WITH THE DESIGN CONTRACTOR. THE CITY
 OF ROCKWALL, IN REVIEWING AND RELEASING
 PLANS FOR CONSTRUCTION, ASSUMES NO
 RESPONSIBILITY FOR ADEQUACY OR ACCURACY OF
 DESIGN.
 CITY _____ DATE _____

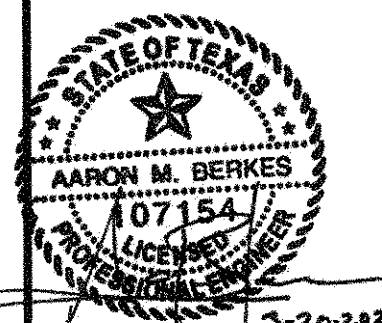


JOB NO. 151.20

RW5

FALKOFSKE ENGINEERING
 Falkofske Engineering, Inc.
 Structural Engineering Consultants
 Texas Registration F-4038
 722 North Fielder Road
 Arlington, Texas 76012
 (817) 261-8300

The information shown on this drawing is the property of Falkofske Engineering, Inc. and is not to be reproduced, stored in a retrieval system, or transmitted in any form or by any means, electronic, mechanical, photocopying, recording, or by any information storage and retrieval system, without the prior written permission of Falkofske Engineering, Inc.

DATE	BY	NO.	DATE	BY
03-20-20	AMB			
03-20-20	EJC			
03-20-20	AMB			

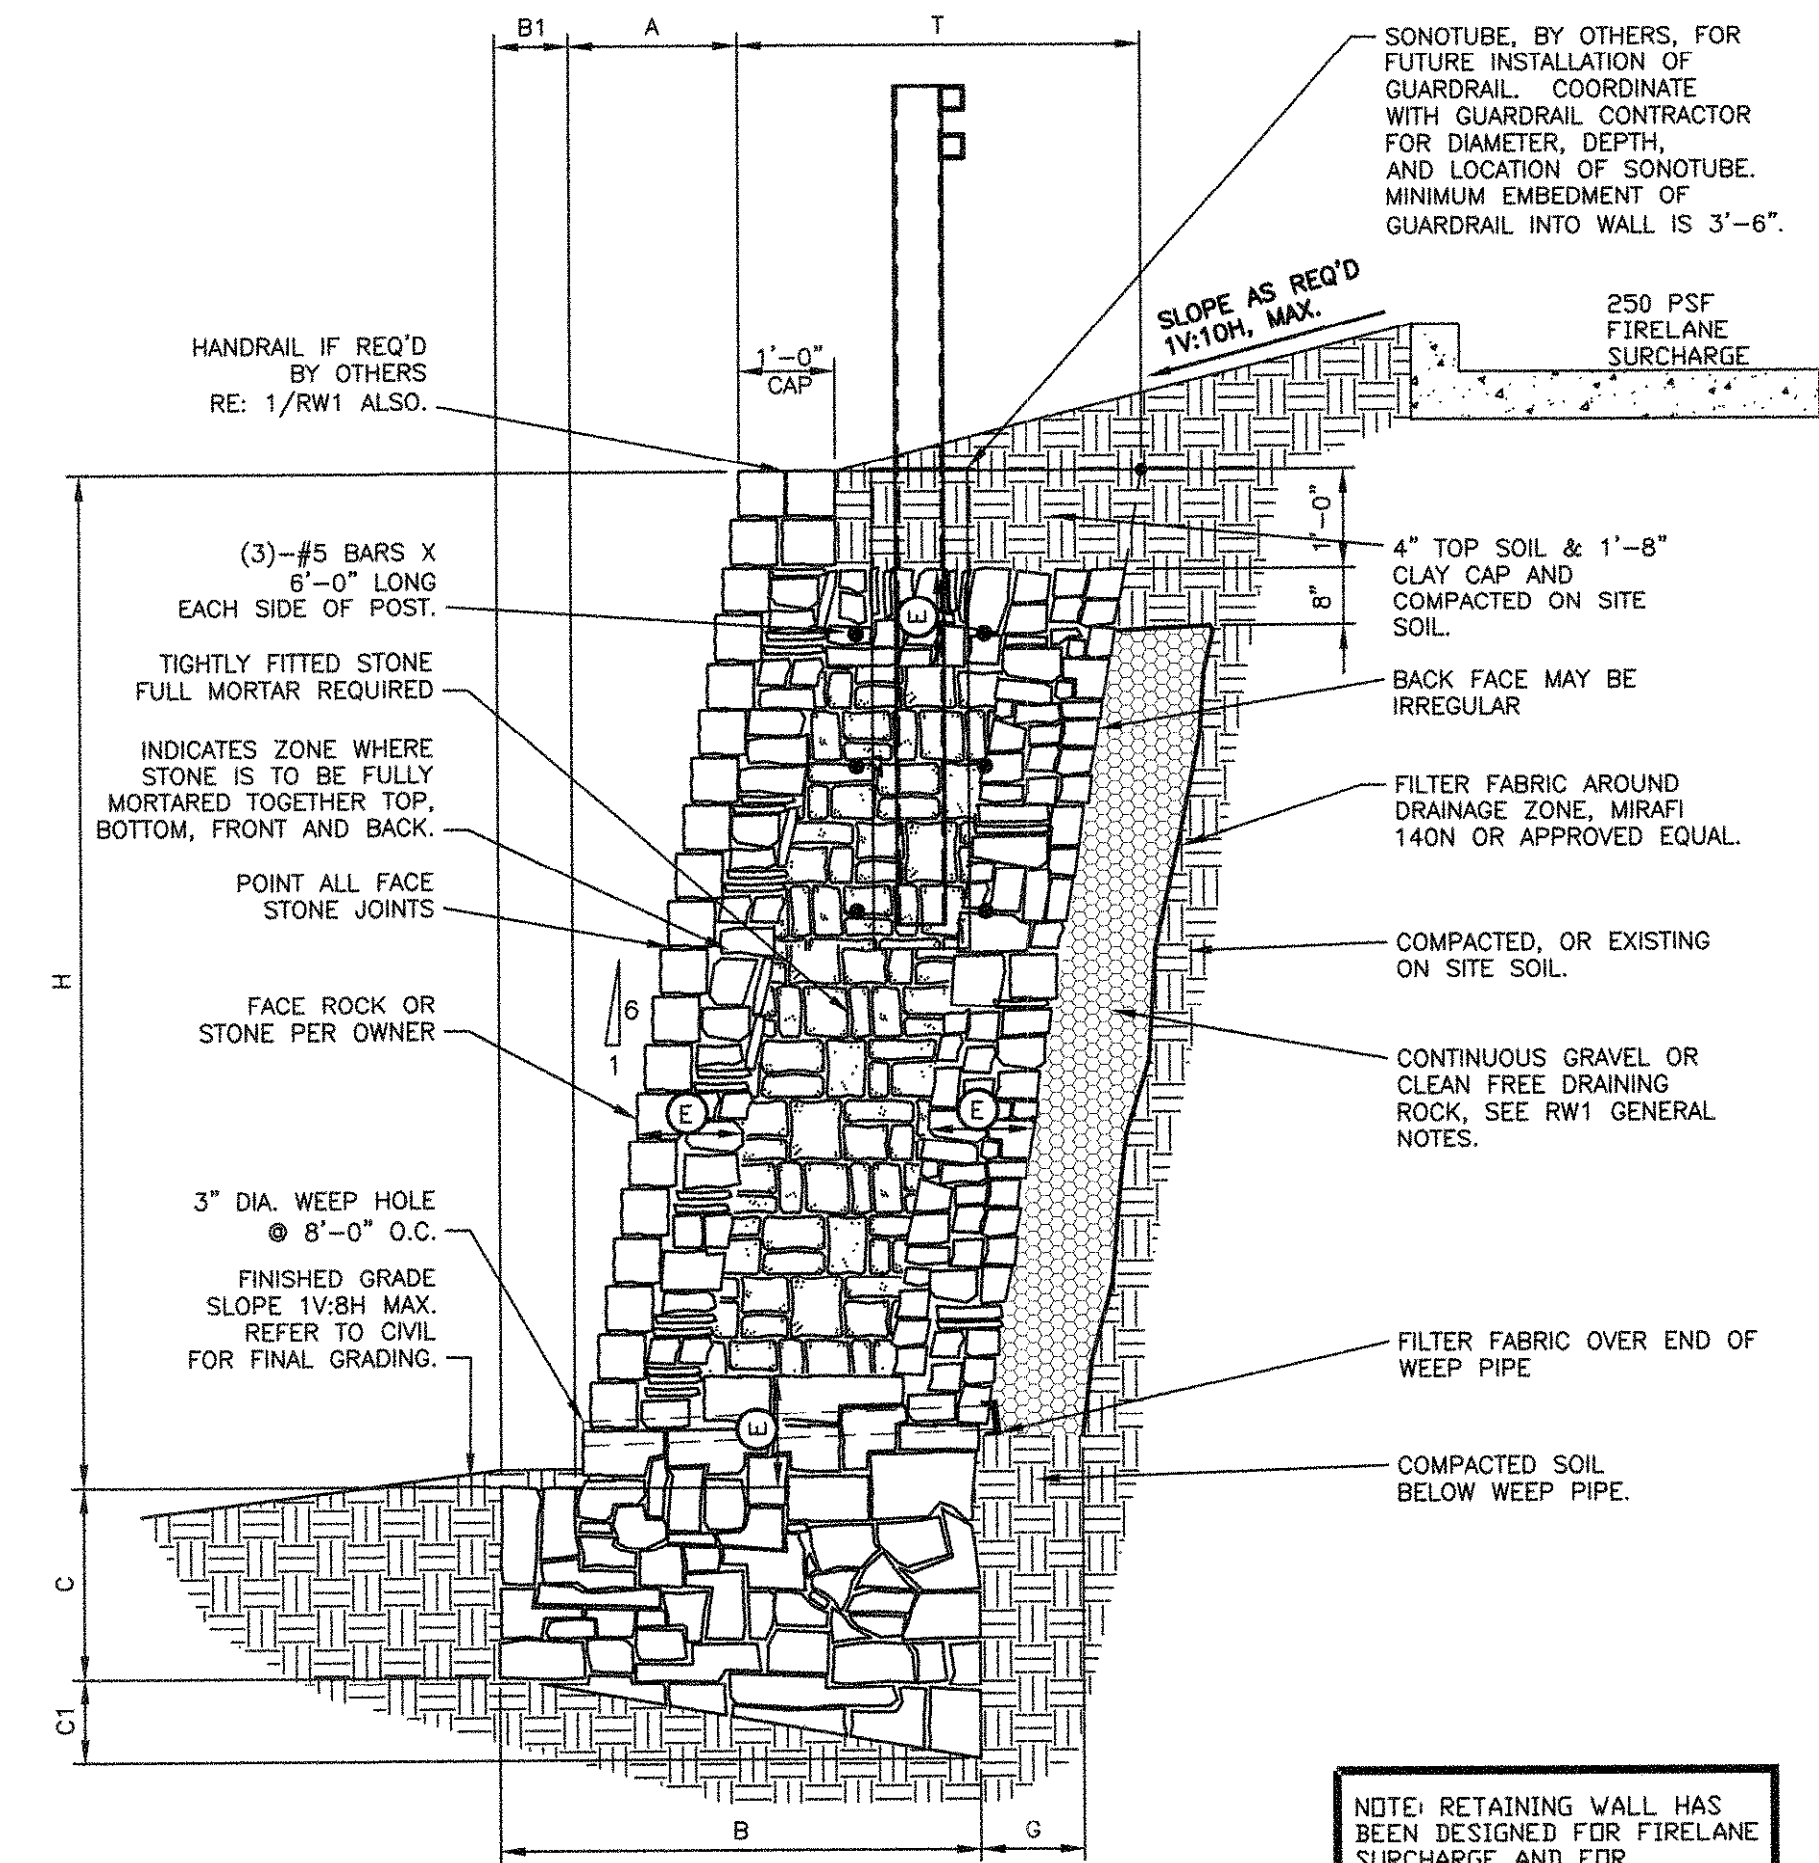

NOTE: RETAINING WALL HAS BEEN DESIGNED FOR FIRELANE SURCHARGE AND FOR VEHICULAR IMPACT LOADING.

MASONRY WALL SCHEDULE
1500 psf - BEARING CAPACITY (STIFF NATURAL UNDISTURBED SOILS OR COMPACTED AND TESTED SOILS SEE GENERAL NOTES SHEET RW6)

WALL HEIGHT H	BASE WIDTH B	TOE B1	BASE DEPTH (TOE) C	BASE DEPTH (HEEL) C1	BATTER A	FULLY MORTARED ZONE E	THICKNESS OF WALL T	DRAINAGE ZONE THICKNESS G	BEARING CAPACITY
6'-0"	5'-3"	1'-6"	2'-0"	1'-0"	1'-0"	DRY MORTARED	3'-9"	1'-0"	1500 psf
7'-0"	5'-7"	1'-6"	2'-0"	1'-1"	1'-2"	DRY MORTARED	4'-1"	1'-0"	1500 psf
8'-0"	6'-4"	1'-6"	2'-0"	1'-2"	1'-4"	DRY MORTARED	4'-11"	1'-0"	1500 psf
9'-0"	7'-0"	1'-6"	2'-3"	1'-3"	1'-6"	DRY MORTARED	5'-6"	1'-0"	1800 psf
10'-0"	7'-6"	1'-6"	2'-6"	1'-4"	1'-8"	DRY MORTARED	6'-0"	1'-0"	1800 psf
11'-0"	8'-0"	1'-6"	2'-9"	1'-5"	1'-10"	DRY MORTARED	6'-6"	1'-3"	2000 psf

WALL DESIGN CRITERIA							
BEARING q_u	SLOPE TOP β_1	SLOPE BOT β_2	ACTIVE PRESSURE e_a	PASSIVE PRESSURE e_p	FRICTION ANGLE BASE δ	SLOPE OF BACK OF WALL α	SURCHARGE s
1500PSF	0 deg	7.13 deg	26 deg	26 deg	17 deg	99.46 deg	250 psf

USE THIS SCHEDULE FOR 2/RW6

DATE	BY	CHK	NO.	DATE	REVISION	BY
05-26-20	AMB					
05-26-20	RL					
05-26-20	AMB					

Falkofske Engineering, Inc.
Structural Engineering Consultants
TX Reg. Engineering Firm F-4038
722 North Fielder Road
Arlington, Texas 76012
(817) 261-8300

The information contained herein is the property of Falkofske Engineering, Inc. and is not to be reproduced, stored in a retrieval system, or transmitted in any form or by any means, electronic, mechanical, photocopying, recording, or by any information storage and retrieval system, without the prior written permission of Falkofske Engineering, Inc.

MASONRY RETAINING WALLS
HARBOR HILLS
SUMMER LEE DRIVE
ROCKWALL, TEXAS

WALCO RETAINING WALLS, INC.
4800 S.E. LOOP 820
FORT WORTH, TEXAS 76140


RELEASED FOR CONSTRUCTION
ALL RESPONSIBILITY FOR THE DESIGN AND CONSTRUCTION OF THIS PROJECT REMAINS WITH THE CLIENT. THE CITY OF ROCKWALL, IN REVIEWING AND RELEASING THESE PLANS FOR CONSTRUCTION, ASSUMES NO RESPONSIBILITY FOR ACCURACY OR ADEQUACY OF DESIGN.

DATE: 5-26-20

JOB NO. 151.20

RW6


DISCLAIMER: The use of this standard is governed by the "Texas Engineering Practice Act". No warranty of any kind is made by TxDOT for any purpose whatsoever. TxDOT assumes no responsibility for any conversion of this standard to other formats or for incorrect results or damages resulting from its use.

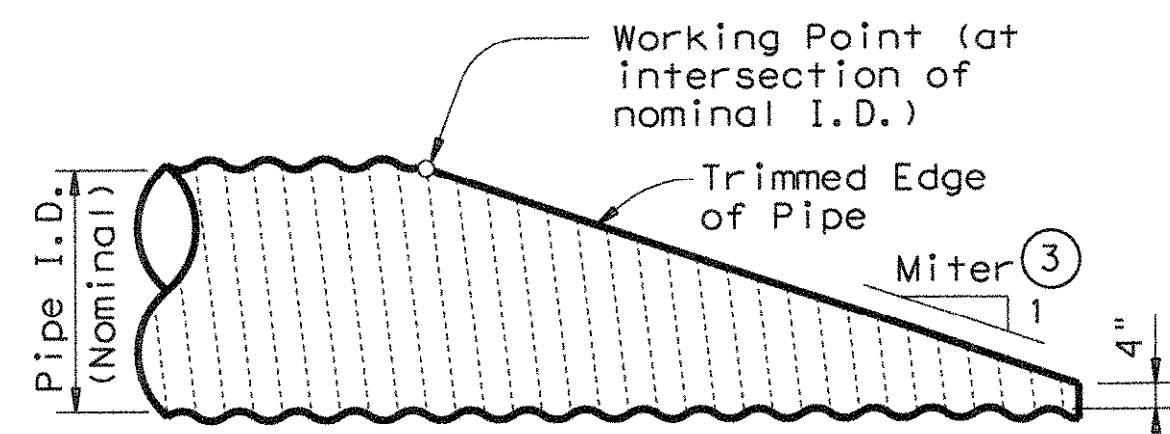

NOTE: All Pipe Runners, calculations, and dimensions are based on the pipe culverts mitered as shown in this detail. Alternate styles of mitered ends will require that appropriate adjustments be made to the values presented on this standard.


SIDE ELEVATION OF TYPICAL PIPE CULVERT MITER

(Showing Corrugated Metal Pipe Culvert. Details of Concrete Pipe Culvert are similar.)

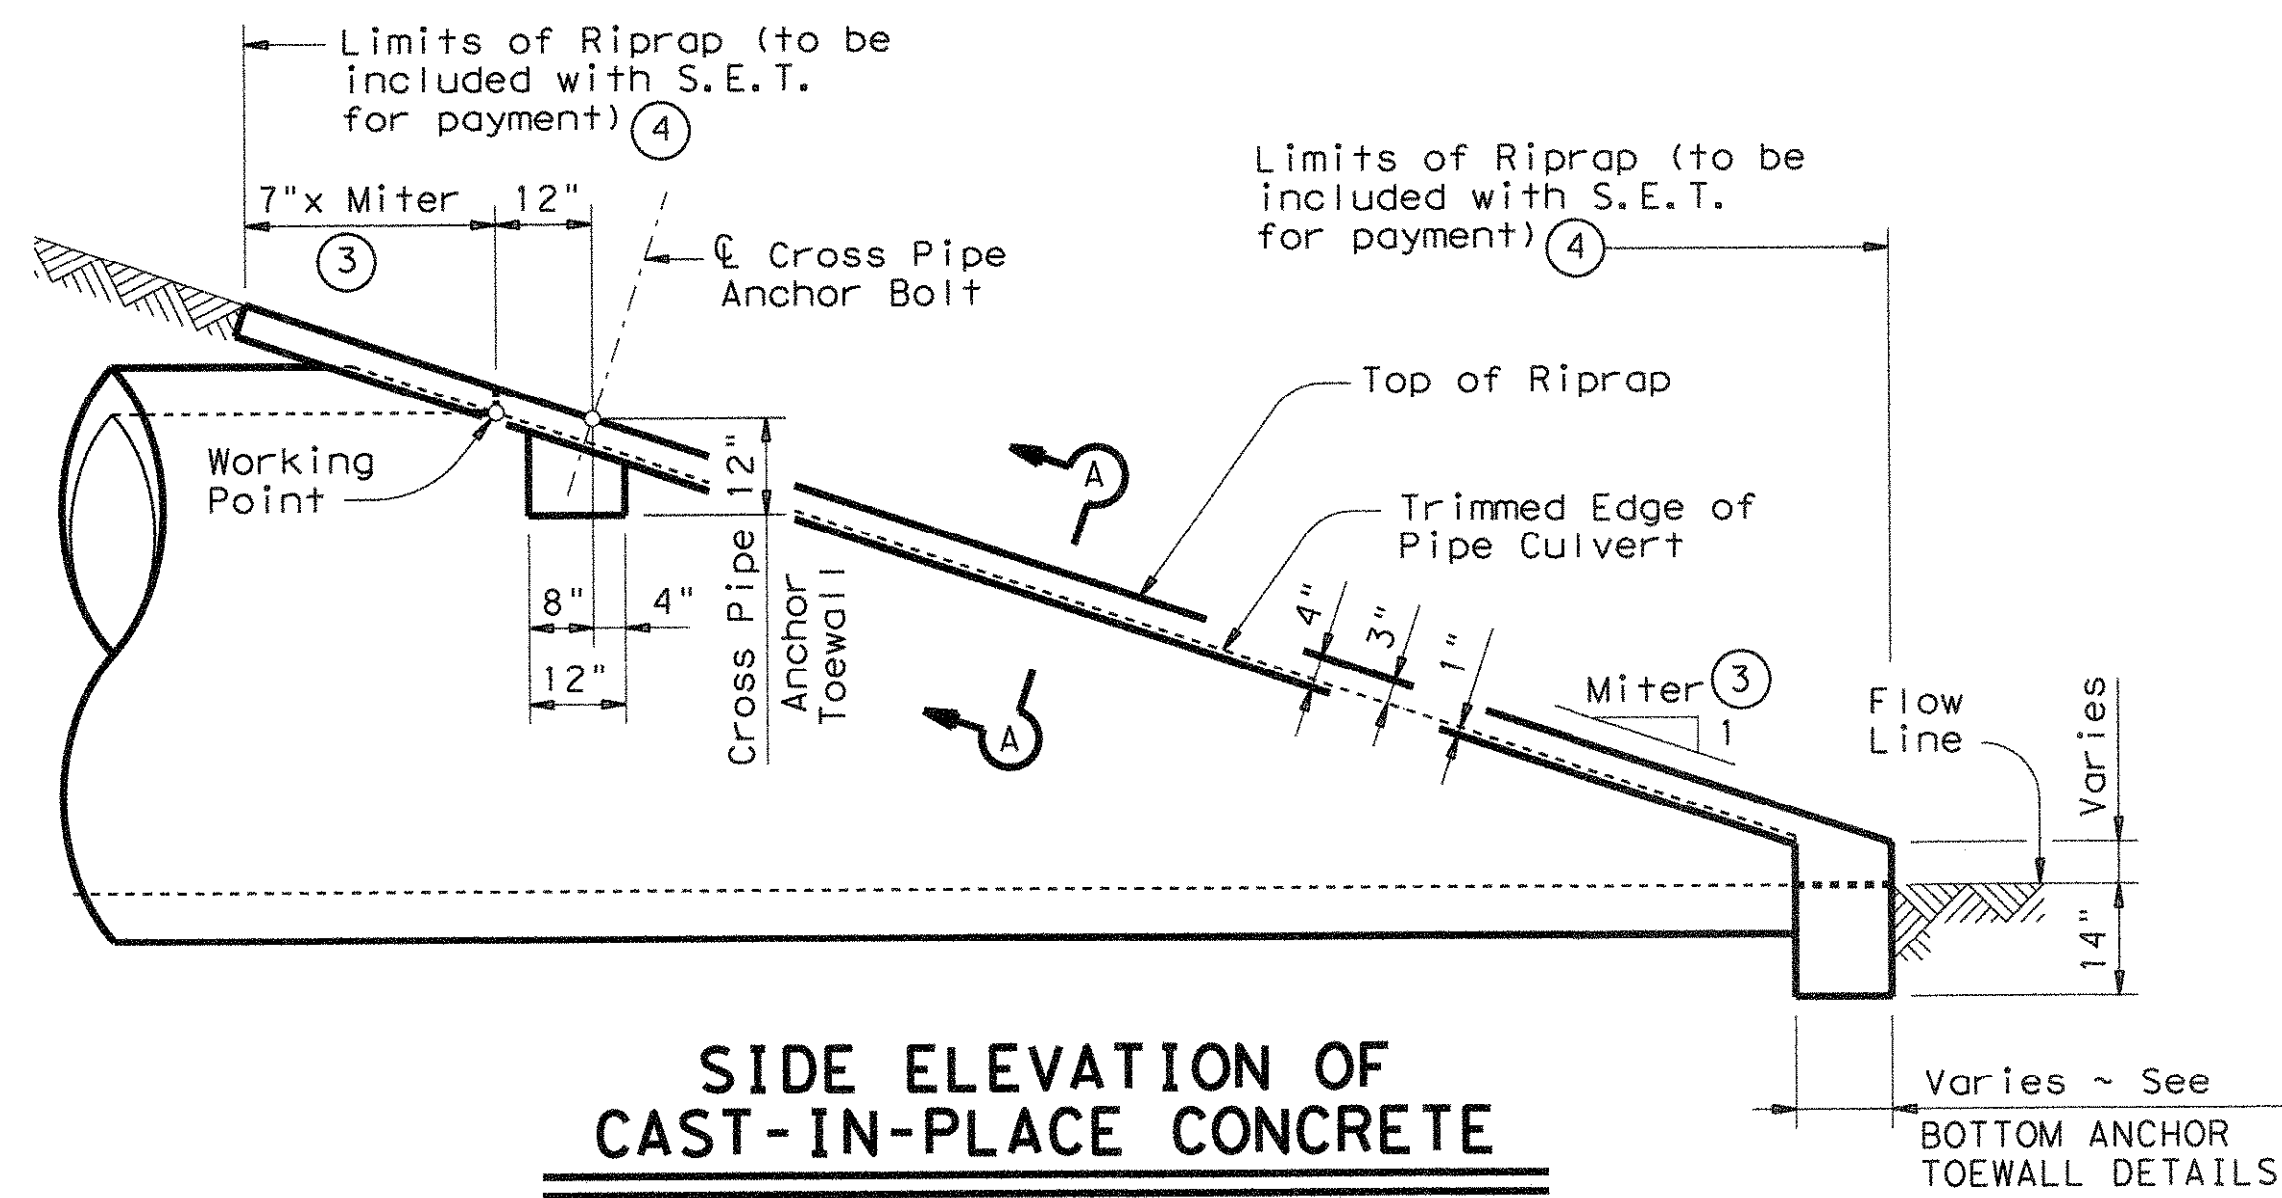

SIDE ELEVATION OF CAST-IN-PLACE CONCRETE

(Showing Concrete Pipe Culvert. Details of Corrugated Metal Pipe Culvert are similar. Pipe Runners not shown for clarity)

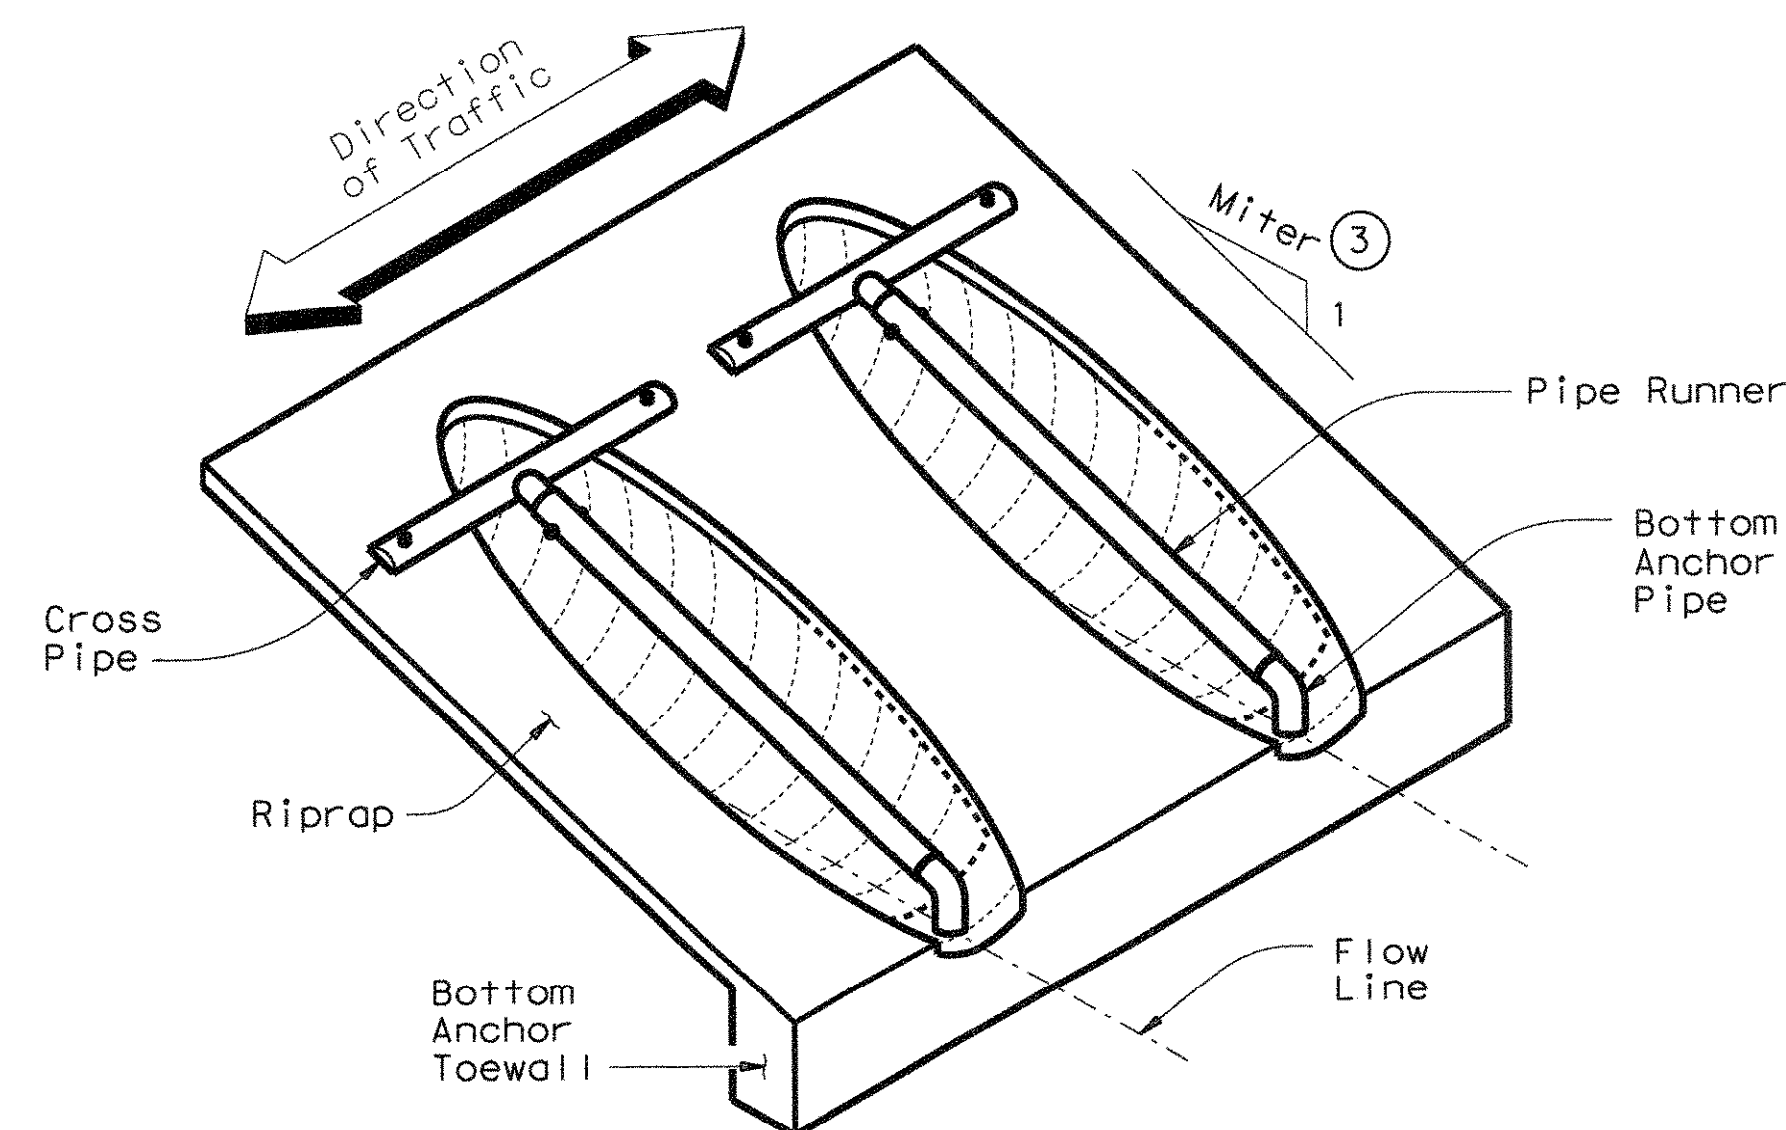

ISOMETRIC VIEW OF TYPICAL INSTALLATION

(Showing installation with no skew.)

CROSS PIPE LENGTHS & PIPE RUNNER LENGTHS (1)(2)

Nominal Culvert I.D.	Pipe Culvert Spa ~ G	Cross Pipe Length	Pipe Runner Length											
			3:1 Side Slope				4:1 Side Slope				6:1 Side Slope			
			0° Skew	15° Skew	30° Skew	45° Skew	0° Skew	15° Skew	30° Skew	45° Skew	0° Skew	15° Skew	30° Skew	45° Skew
24"	1'-7"	3'-5"	N/A	N/A	N/A	5'-10"	N/A	N/A	N/A	8'-1"	N/A	N/A	N/A	12'-9"
27"	1'-8"	3'-8"	N/A	N/A	5'-5"	6'-11"	N/A	N/A	7'-7"	9'-7"	N/A	N/A	11'-11"	14'-11"
30"	1'-10"	3'-11"	N/A	N/A	6'-4"	8'-0"	N/A	N/A	8'-9"	11'-0"	N/A	N/A	13'-8"	17'-0"
33"	1'-11"	4'-2"	6'-2"	6'-5"	7'-3"	9'-1"	8'-6"	8'-10"	10'-0"	12'-5"	13'-3"	13'-9"	15'-5"	19'-2"
36"	2'-1"	4'-5"	6'-11"	7'-3"	8'-2"	10'-2"	9'-6"	9'-11"	11'-2"	13'-10"	14'-9"	15'-3"	17'-2"	21'-3"
42"	2'-4"	4'-11"	8'-6"	8'-10"	9'-11"	12'-4"	11'-7"	12'-0"	13'-6"	16'-8"	17'-9"	18'-5"	20'-8"	25'-7"
48"	2'-7"	5'-5"	10'-1"	10'-5"	11'-9"	N/A	13'-7"	14'-2"	15'-10"	N/A	20'-9"	21'-6"	24'-2"	N/A
54"	3'-0"	5'-11"	11'-8"	12'-1"	N/A	N/A	N/A	15'-8"	16'-3"	N/A	23'-10"	24'-8"	N/A	N/A
60"	3'-3"	6'-5"	13'-3"	N/A	N/A	N/A	17'-9"	N/A	N/A	N/A	26'-10"	N/A	N/A	N/A

TYPICAL PIPE CULVERT MITERS (3)

Side Slope	0° Skew	15° Skew	30° Skew	45° Skew
3:1	3:1	3.106:1	3.464:1	4.243:1
4:1	4:1	4.141:1	4.619:1	5.657:1
6:1	6:1	6.212:1	6.928:1	8.485:1

CONDITIONS WHERE PIPE RUNNERS ARE NOT REQUIRED (2)

Nominal Culvert I.D.	Single Pipe Culvert	Multiple Pipe Culverts
12" thru 21"	Skews thru 45°	Skews thru 45°
24"	Skews thru 45°	Skews thru 30°
27"	Skews thru 30°	Skews thru 15°
30"	Skews thru 15°	Skews thru 15°
33"	Skews thru 15°	Always required
36"	Normal (No Skew)	Always required
42" to 60"	Always required	Always required

STANDARD PIPE SIZES & MAX PIPE RUNNER LENGTHS (1)

Pipe Size	Pipe O.D.	Pipe I.D.	Max Pipe Runner Length
2" STD	2.375"	2.067"	N/A
3" STD	3.500"	3.068"	10'-0"
4" STD	4.500"	4.026"	19'-8"
5" STD	5.563"	5.047"	34'-2"

ESTIMATED CONCRETE RIPRAP QUANTITIES (CY) (5)

Nominal Culvert I.D.	3:1 Side Slope				4:1 Side Slope				6:1 Side Slope			
	0° Skew	15° Skew	30° Skew	45° Skew	0° Skew	15° Skew	30° Skew	45° Skew	0° Skew	15° Skew	30° Skew	45° Skew
12"	0.4	0.4	0.5	0.5	0.5	0.5	0.5	0.6	0.7	0.7	0.7	0.8
15"	0.5	0.5	0.5	0.6	0.6	0.6	0.6	0.7	0.7	0.7	0.8	0.9
18"	0.5	0.5	0.6	0.6	0.6	0.7	0.7	0.8	0.8	0.8	0.9	1.0
21"	0.6	0.6	0.6	0.7	0.7	0.7	0.8	0.9	0.9	0.9	1.0	1.2
24"	0.6	0.7	0.7	0.8	0.8	0.8	0.8	1.0	1.0	1.0	1.1	1.3
27"	0.7	0.7	0.8	0.9	0.8	0.9	0.9	1.1	1.1	1.1	1.2	1.4
30"	0.8	0.8	0.8	0.9	0.9	0.9	1.0	1.2	1.2	1.2	1.3	1.6
33"	0.8	0.8	0.9	1.0	1.0	1.0	1.1	1.3	1.3	1.4	1.5	1.7
36"	0.9	0.9	0.9	1.1	1.1	1.1	1.2	1.4	1.4	1.5	1.6	1.8
42"	1.0	1.0	1.1	1.3	1.2	1.3	1.3	1.6	1.6	1.7	1.8	2.1
48"	1.1	1.1	1.2	N/A	1.4	1.4	1.5	N/A	1.9	1.9	2.1	N/A
54"	1.3	1.3	N/A	N/A	1.6	1.6	N/A	N/A	2.1	2.1	N/A	N/A
60"	1.4	N/A	N/A	N/A	1.7	N/A	N/A	N/A	2.3	N/A	N/A	N/A

(1) Size of Pipe Runner shall be as shown in the tables. Cross Pipe shall be the same size as the Pipe Runner. Cross Pipe Stub Out and Bottom Anchor Pipe shall be the next smaller size pipe as shown in the STANDARD PIPE SIZES table.

(2) This standard allows for the placement of only one pipe runner across each culvert pipe opening. In order to limit the clear opening to be traversed by an errant vehicle, the following conditions must be met:

- For 60" culvert pipes, the skew must not exceed 0°.
- For 54" culvert pipes, the skew must not exceed 15°.
- For 48" culvert pipes, the skew must not exceed 30°.
- For all culvert pipe sizes 42" and less, the skew must not exceed 45°.

If the above conditions cannot be met, the designer should consider using a safety end treatment with flared wings. For further information, refer to the TxDOT "Roadway Design Manual".

(3) Miter = Slope of Mitered Pipe Culvert End

(4) Riprap placed beyond the limits shown will be paid as Concrete Riprap in accordance with Item 432, "Riprap".

(5) Quantities shown are for one end of one reinforced Concrete Pipe Culvert. For multiple Pipe Culverts or for Corrugated Metal Pipe Culverts, quantities will need to be adjusted. Riprap quantities are for Contractor's information only.

1. All Concrete for Structure Shall be Class F (4200 psi 7.0 sack Cement).
2. No Fly Ash is Allowed for Structures.

SHEET 1 OF 2

Bridge Division Standard

SAFETY END TREATMENT
 FOR 12" DIA TO 60" DIA
 PIPE CULVERTS
 TYPE II ~ CROSS DRAINAGE


SETP-CD

FILE: setpcdse.dgn	DN: GAF	CK: CAT	DW: JRP	CK: GAF
©TxDOT February 2010	CONT SECT	JOB	HIGHWAY	
REVISIONS				
11-10: Add note for synthetic fibers.	DIST	COUNTY	SHEET NO.	


DATE: FILE:

DISCLAIMER: The use of this standard is governed by the "Texas Engineering Practice Act". No warranty of any kind is made by TxDOT for any purpose whatsoever. TxDOT assumes no responsibility for any conversion or this standard to other formats or for incorrect results or damages resulting from its use.

DATE:
FILE:

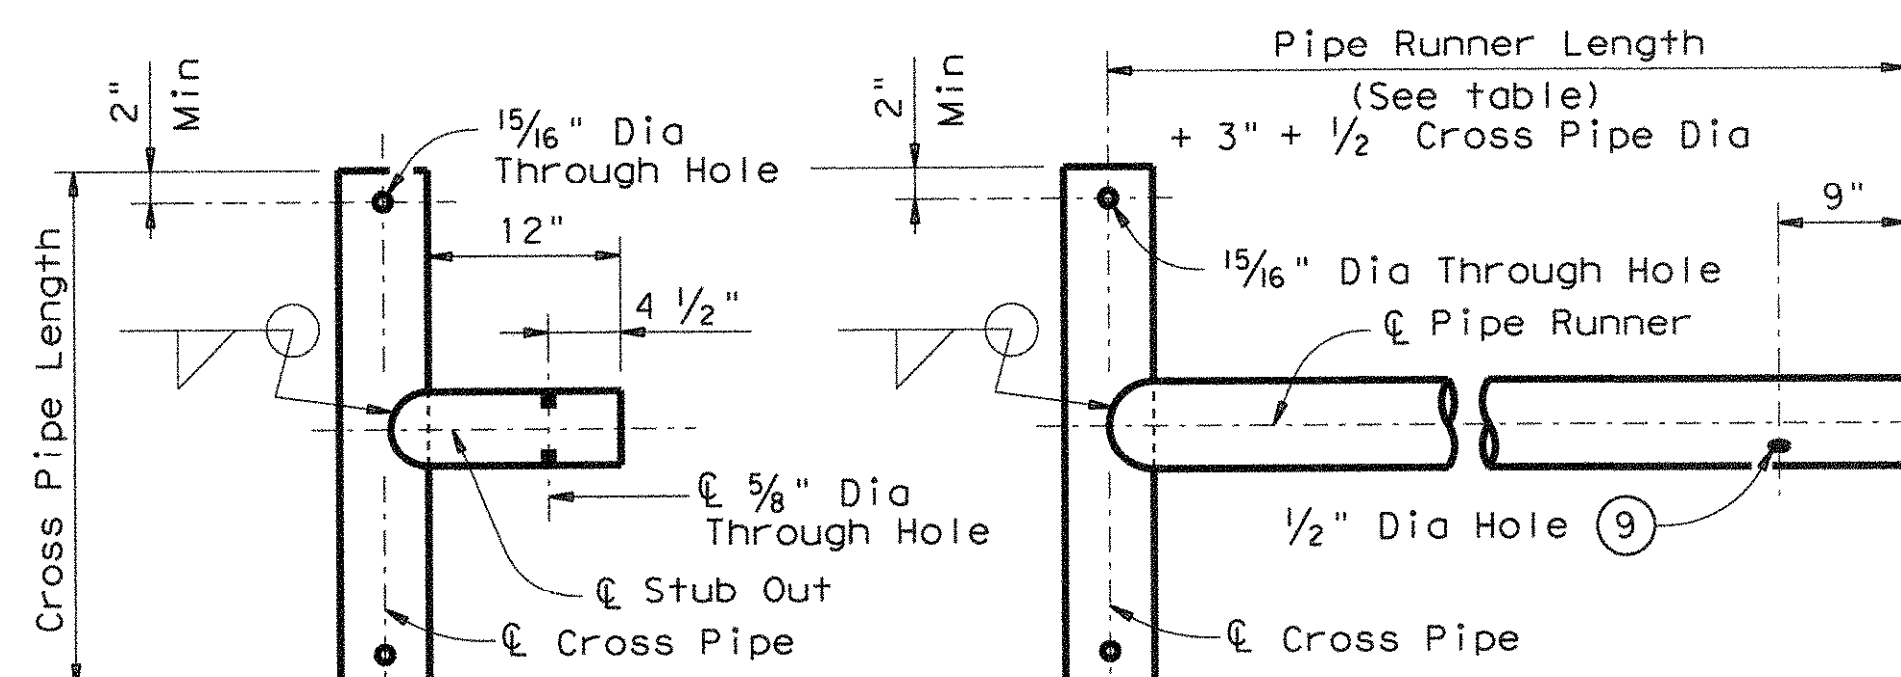


OPTION A1 **OPTION A2**
CROSS PIPE AND CONNECTIONS DETAILS

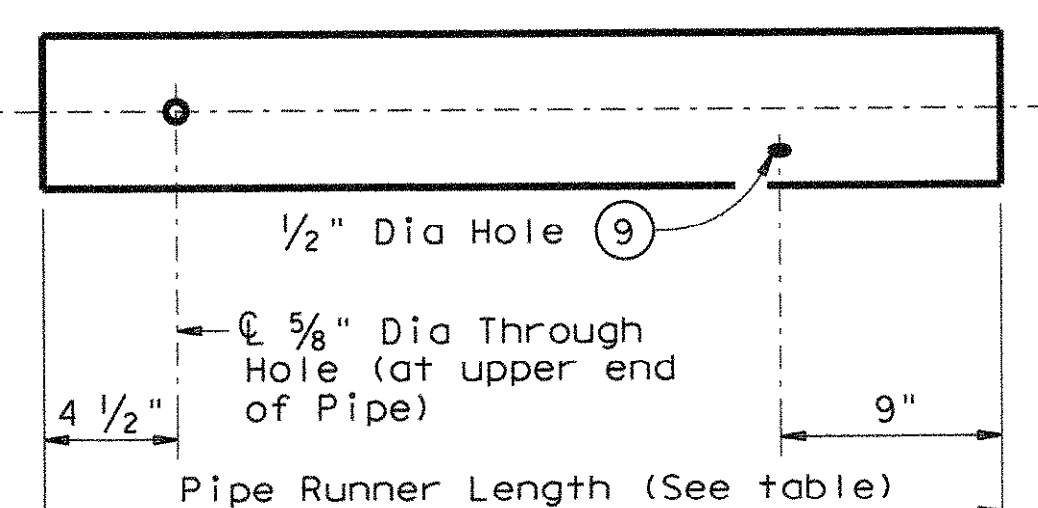


NOTE: The separate Pipe Runner shown is required when Cross Pipe Connection Option A1 is used.


PIPE RUNNER DETAILS

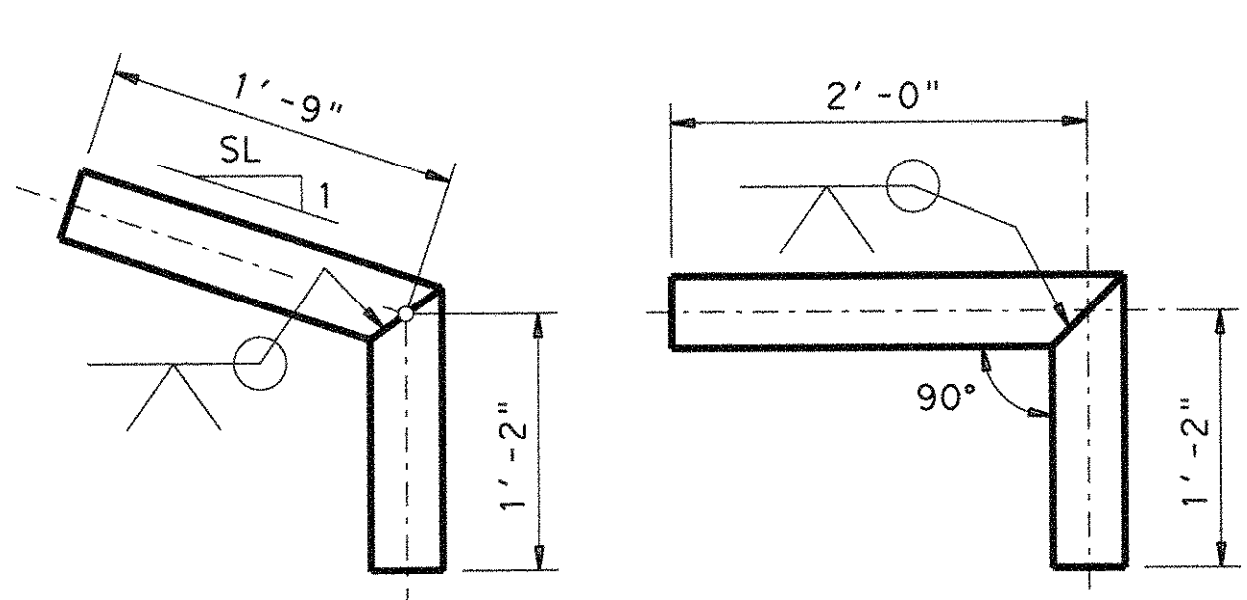

OPTION B1 **OPTION B2**
BOTTOM ANCHOR PIPE DETAILS ⑩

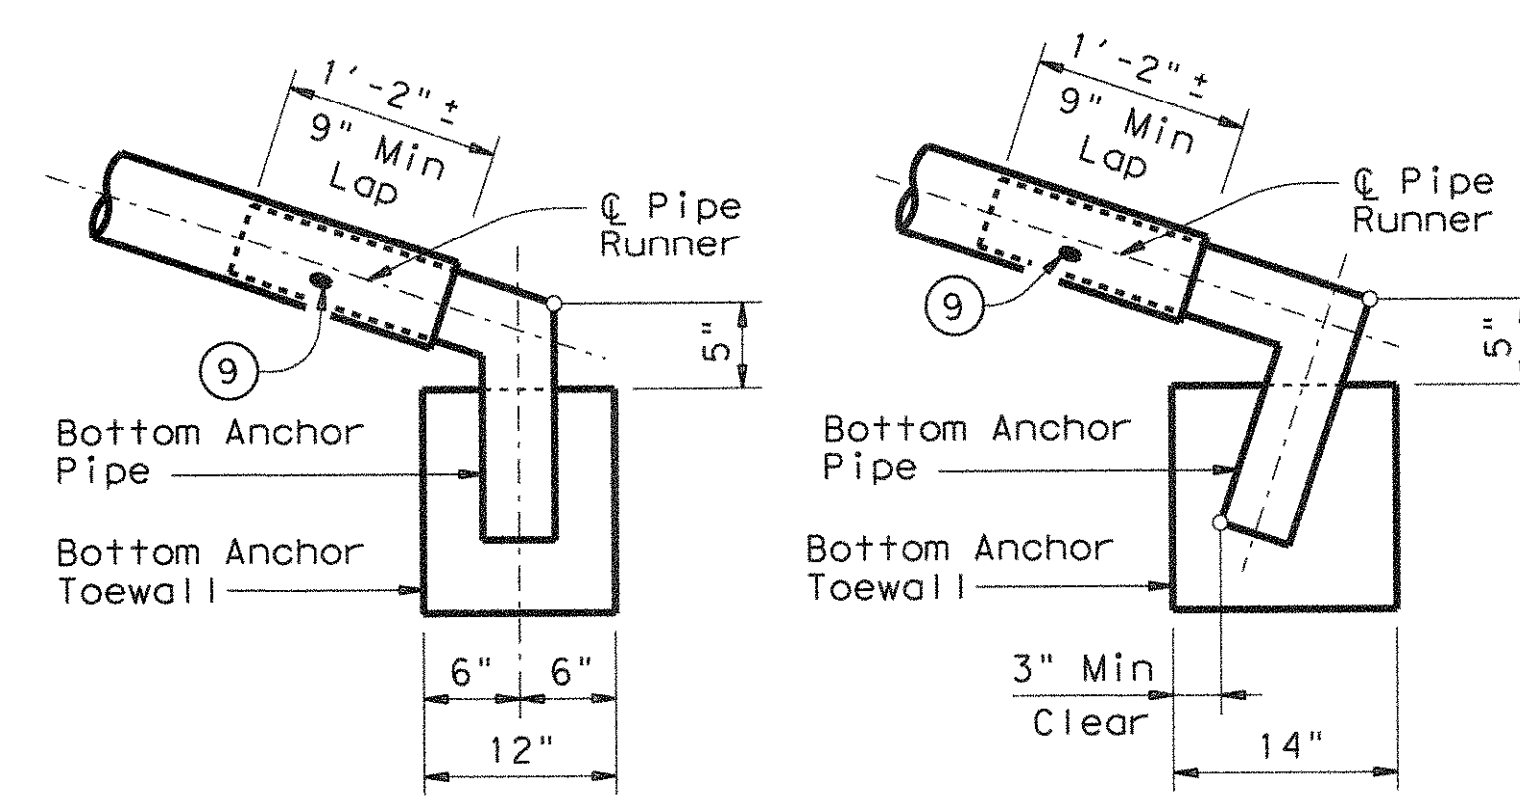


OPTION B1 **OPTION B2**
BOTTOM ANCHOR TOEWALL DETAILS
(Culvert & Riprap not shown for clarity)

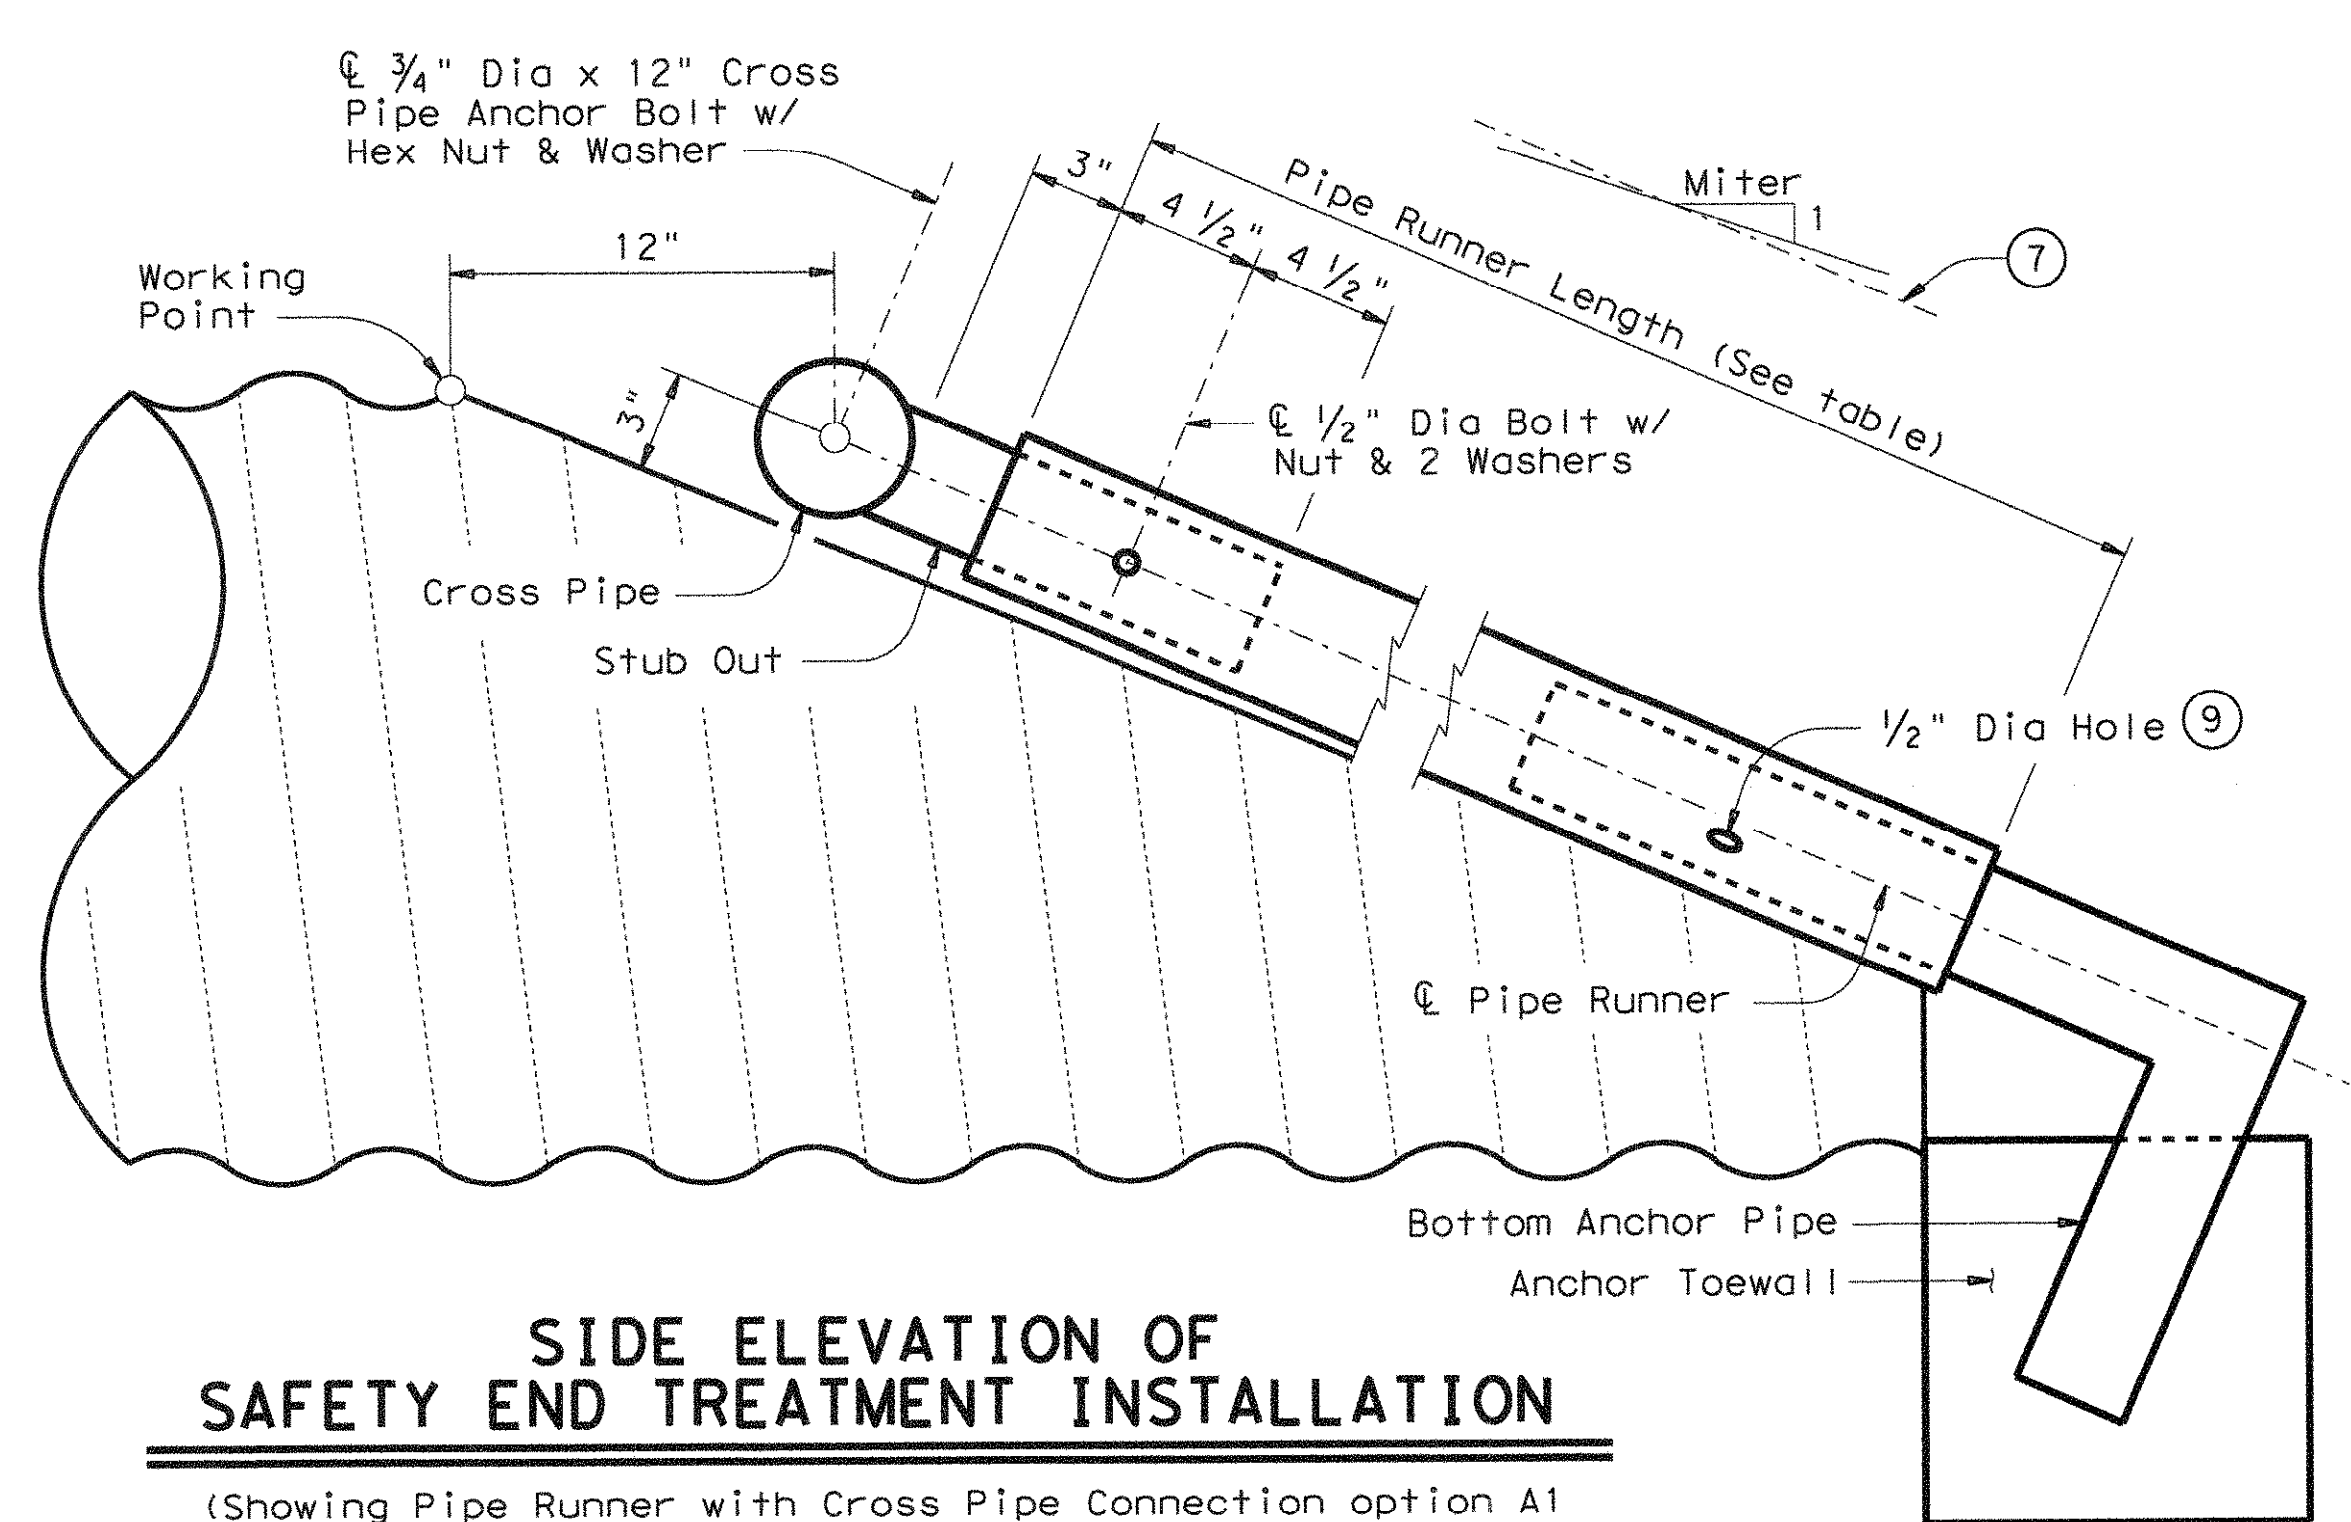


SIDE ELEVATION OF SAFETY END TREATMENT INSTALLATION


(Showing Pipe Runner with Cross Pipe Connection option A1 and Anchor Pipe option B2 on Corrugated Metal Pipe Culvert. Concrete Pipe Culvert details are similar. Riprap not shown for clarity)

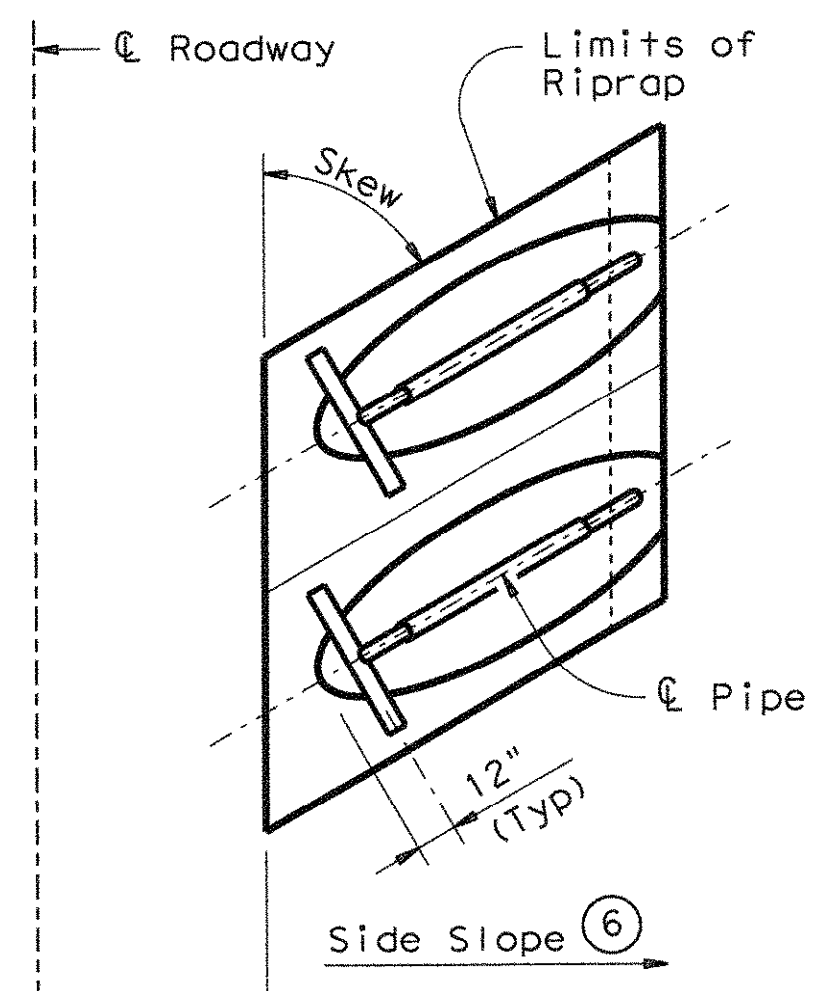

PLAN OF SKEWED INSTALLATION

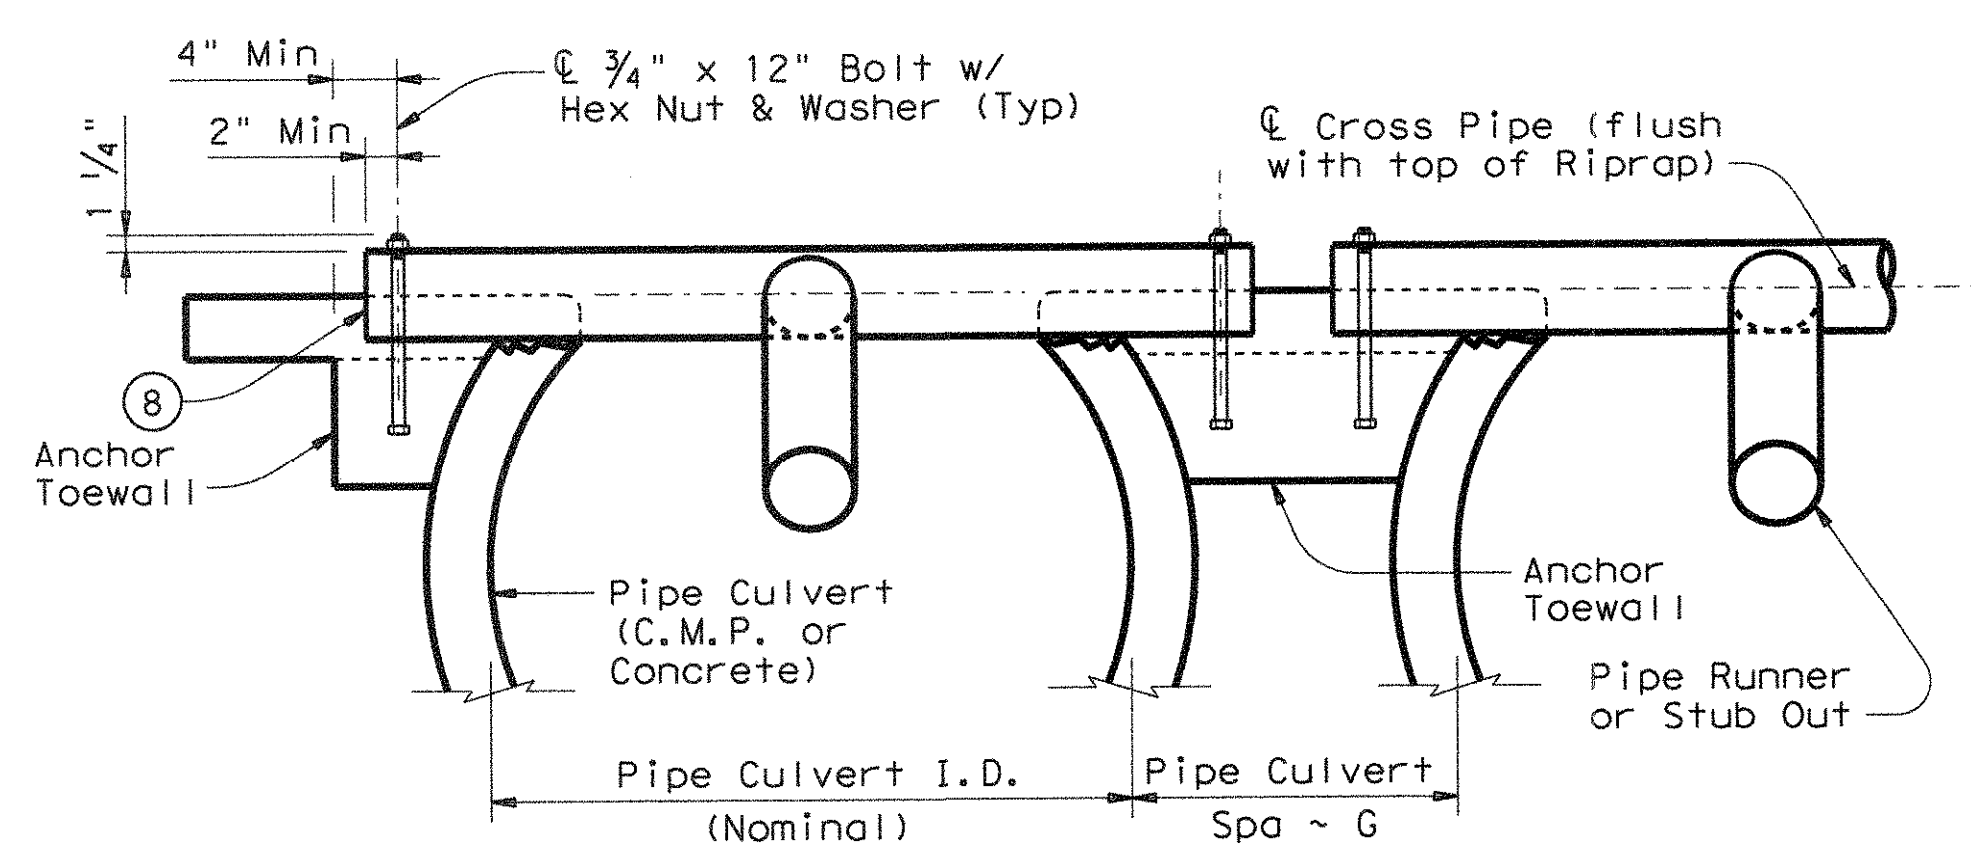

SHOWING CROSS PIPE & ANCHOR TOEWALL

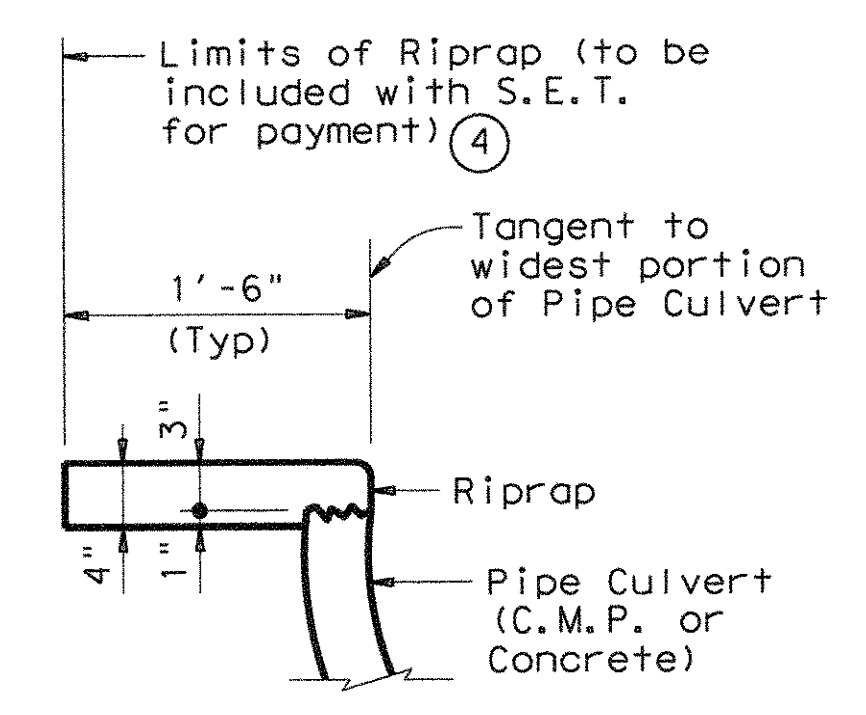

SHOWING TYPICAL PIPE CULVERT & RIPRAP

SECTION A-A

- ④ Riprap placed beyond the limits shown will be paid as Concrete Riprap in accordance with Item 432, "Riprap".
- ⑥ Recommended values of side slope are 3:1, 4:1, & 6:1. All quantities, calculations, and dimensions shown herein are based on these recommended values. Slope of 3:1 or flatter is required for vehicle safety.
- ⑦ Note that actual slope of Pipe Runner may vary slightly from Side Slope of Riprap and trimmed Culvert Pipe edge.
- ⑧ Care shall be taken to ensure that Riprap concrete does not flow into the Cross Pipe so as to permit disassembly of the bolted connection to allow cleanout access.
- ⑨ After installation, the 1/2" hole shall be inspected to ensure that the lap of the Pipe Runner with the Bottom Anchor Pipe is adequate.
- ⑩ At fabricator's option, a heat bend to a smooth 5" radius or a manufactured elbow (of the same material as the Runner) may be substituted for the mitered and welded joint in the Bottom Anchor Pipe.

GENERAL NOTES:
 Pipe Runners are designed for a traversing load of 1,800 pounds at yield as recommended by Research Report 280-1, "Safety Treatment of Roadside Cross-Drainage Structures", Texas Transportation Institute, March 1981.
 The Safety End Treatments shown herein are intended for use in those installations where out of control vehicles are likely to traverse the openings approximately perpendicular to the Pipe Runners.
 Riprap and all necessary inverts shall be Concrete Riprap conforming to the requirements of Item 432, "Riprap".
 Synthetic fibers listed on the "Fibers for Concrete" Material Producer List (MPL) may be used in lieu of steel reinforcing in riprap concrete unless noted otherwise.
 Payment for riprap and toewall is included in the Price Bid for each Safety End Treatment.
 Pipe Runners, Cross Pipes, and Anchor Pipes shall conform to the requirements of ASTM A53 (Type E or S, Grade B), ASTM A500 (Grade B), or API 5LX52.
 Bolts and nuts shall conform to ASTM A307.
 All steel components, except concrete reinforcing, shall be galvanized after fabrication. Galvanizing damaged during transport or construction shall be repaired in accordance with the specifications.

		Bridge Division Standard	
SAFETY END TREATMENT FOR 12" DIA TO 60" DIA PIPE CULVERTS TYPE II ~ CROSS DRAINAGE			
SETP-CD			
FILE: setpcdse.dgn	DN: GAF	CK: CAT	DW: JRP
©TxDOT February 2010	CONT	SECT	JOB
REVISIONS			
11-10: Add note for synthetic fibers.	DIST	COUNTY	SHEET NO.