


AS BUILT

B.M. Top Nut of F.H. at Intersection of Yacht Club Drive & Harbor Landing Drive  
Elev. 514.57

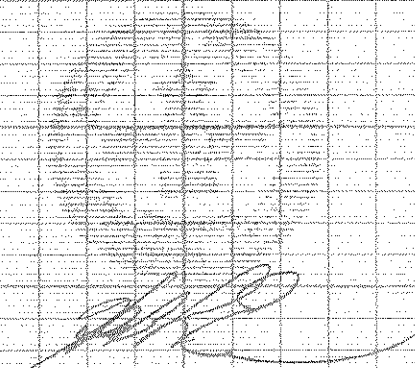

<b>HAROLD L. EVANS</b> CONSULTING ENGINEER 2331 GUS THOMASSON RD. SUITE 102 DALLAS, TEXAS 75228 PHONE (214) 328-8133			<b>UTILITY PROFILES</b> HARBOR LANDING PHASE TWO CITY OF ROCKWALL ROCKWALL, COUNTY, TEXAS		
SCALE 1" = 0'4"	DATE 4-14-87	JOB NO. 8755			
			10-02-98 9873		