



CURVE TABLE						
CURVE	DELTA	RADIUS	TANGENT	LENGTH	BEARING	DISTANCE
C1	33°00'53"	51.00'	15.11'	29.39'	S62°58'15" E	28.98'
C2	30°01'18"	111.50'	29.90'	58.42'	S31°30'04" E	57.76'
C3	45°32'01"	95.50'	40.00'	75.90'	S06°16'36" W	73.91'
C4	51°12'11"	39.00'	19.59'	34.85'	N54°38'42" E	33.70'
C5	45°32'01"	95.50'	35.04'	68.36'	S06°16'36" W	64.63'
C6	29°58'24"	99.50'	26.65'	52.08'	S31°29'07" E	51.49'
C7	9°61'46"	126.50'	10.91'	21.79'	S26°50'12" E	21.75'
C8	36°31'18"	100.00'	33.00'	63.74'	N40°09'58" W	62.67'
C9	28°11'53"	33.00'	8.29'	16.24'	S06°43'02" W	16.08'
C10	17°45'34"	80.00'	12.50'	24.00'	N01°28'52" E	24.70'
C11	29°53'06"	39.00'	8.91'	17.21'	S04°33'54" E	17.02'
C12	24°59'26"	64.00'	14.18'	27.91'	S02°07'04" E	27.69'
C13	14°01'54"	49.00'	6.03'	12.00'	N03°21'43" E	11.97'
C14	25°06'01"	64.00'	14.25'	28.04'	S05°37'47" W	27.81'
C15	22°58'32"	39.50'	8.03'	15.85'	N14°48'12" W	15.74'
C16	30°03'22"	3.00'	3.00'	4.72'	N71°19'39" W	4.24'
C17	30°18'52"	36.82'	9.99'	19.51'	N48°16'04" W	19.28'
C18	6°52'05"	103.44'	6.21'	12.40'	S58°05'05" E	12.38'
C19	68°36'20"	9.00'	4.85'	8.89'	N20°47'23" W	8.53'
C20	34°28'31"	100.56'	31.20'	60.51'	S31°51'37" E	59.80'
C21	69°27'38"	25.00'	17.33'	30.31'	S20°06'28" W	28.48'
C22	46°39'02"	39.00'	14.23'	26.87'	N31°30'46" E	26.13'
C23	33°23'41"	55.50'	19.65'	38.18'	S63°10'40" E	37.64'
C24	14°42'44"	55.50'	8.48'	16.82'	S39°07'27" E	16.77'
C25	17°28'01"	100.00'	15.38'	30.51'	S48°50'03" E	30.40'
C26	51°45'46"	39.00'	18.92'	35.29'	S73°52'20" E	34.05'

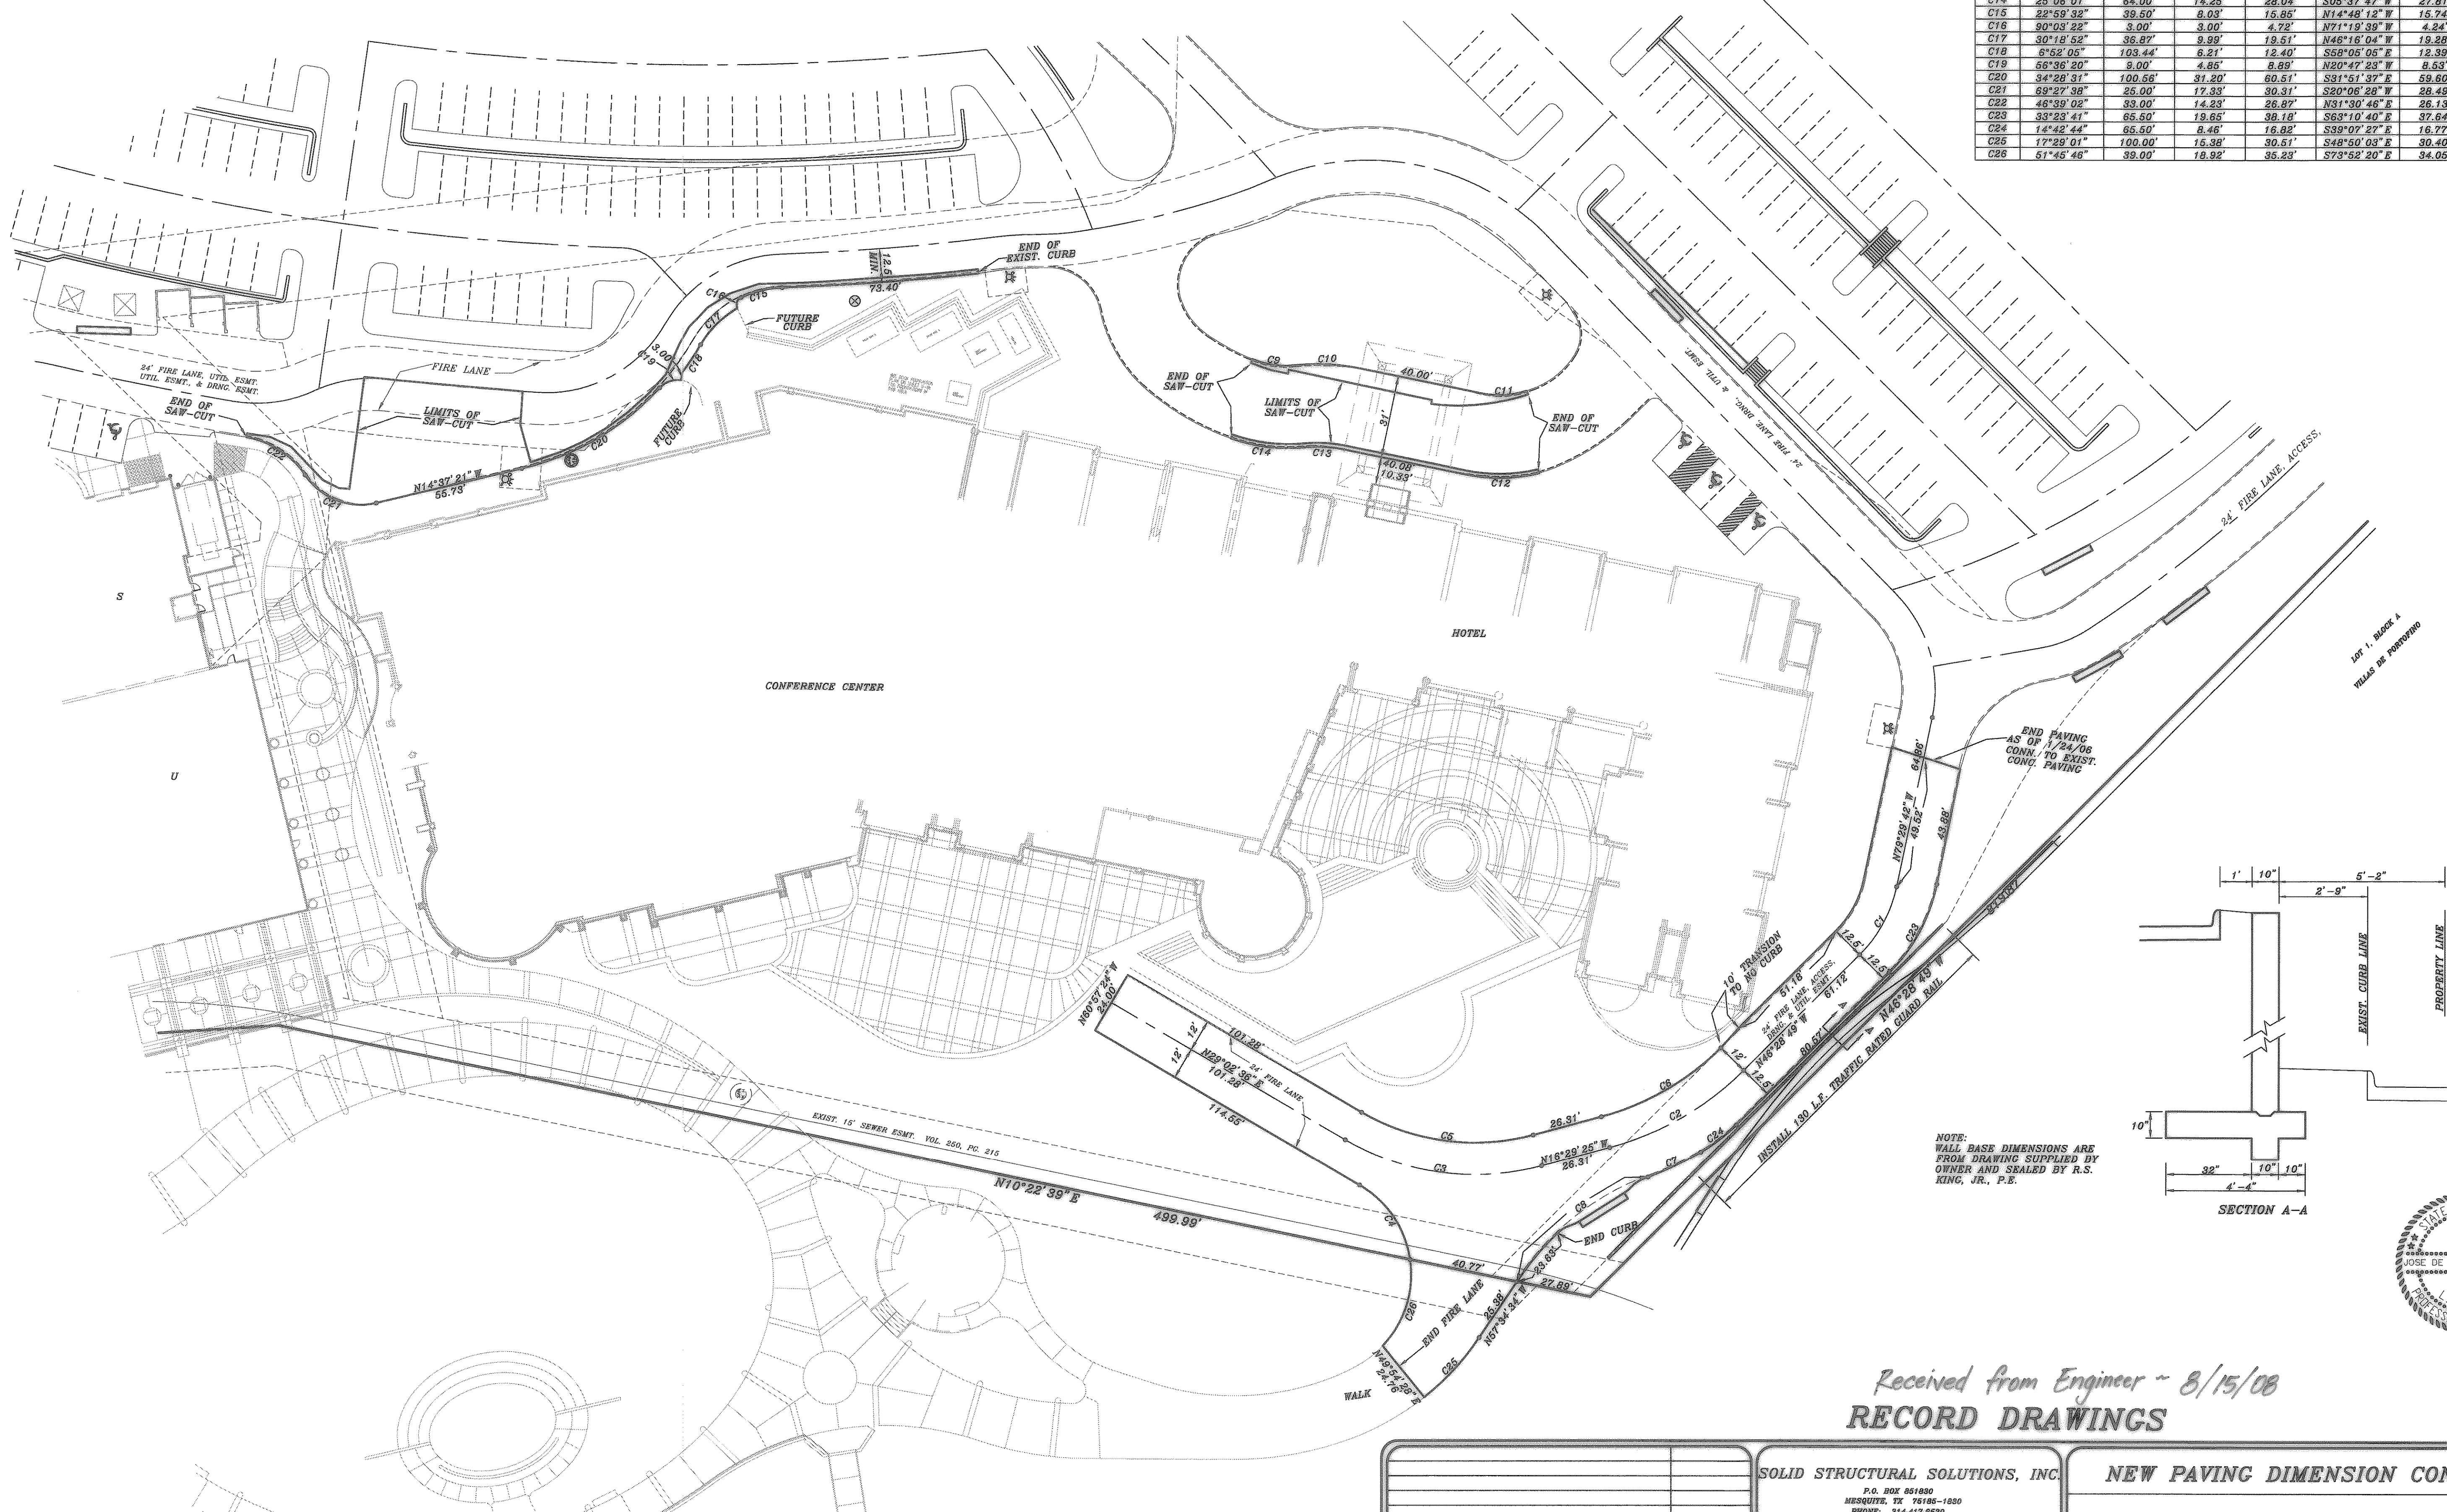

NOTE:  
WALL BASE DIMENSIONS ARE FROM DRAWING SUPPLIED BY OWNER AND SEALED BY R.S. KING, JR., P.E.

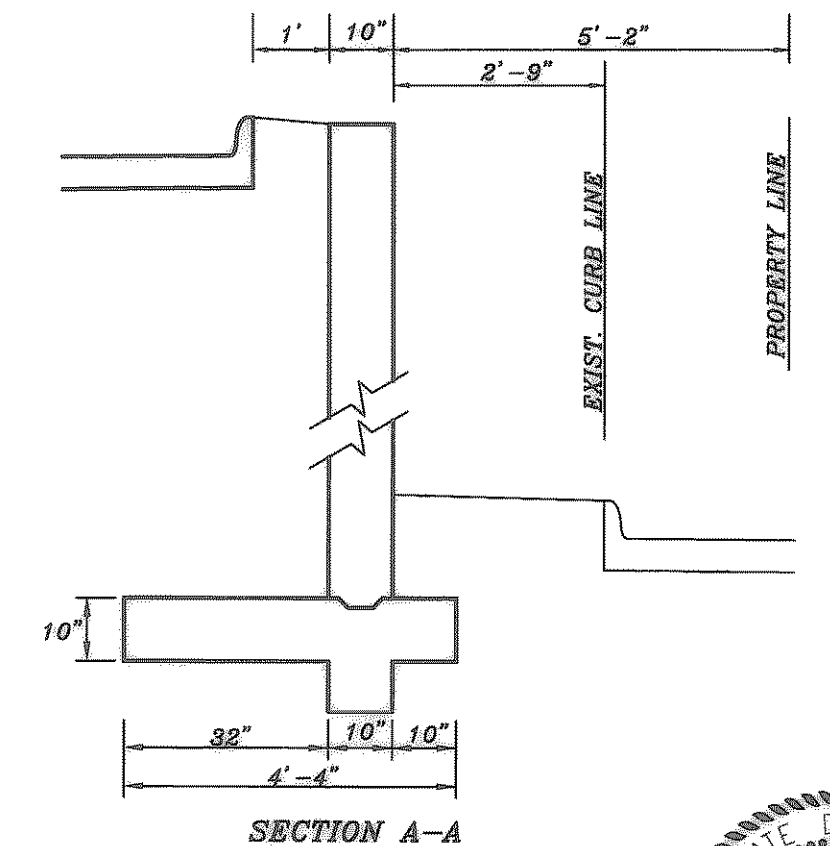

Received from Engineer ~ 8/15/08  
**RECORD DRAWINGS**

SOLID STRUCTURAL SOLUTIONS, INC. P.O. BOX 861880 MESSURITE, TX 76185-1880 PHONE: 214.417.0250 FAX: 972.888.5714				<b>NEW PAVING DIMENSION CONTROL</b>		SHEET NO. 2
REVISION DESCRIPTION 00136HOTEL DIM				DATE 7/18/08	SCALE 1"=30'	DESIGN H.L.E.
THE HARBOR HILTON CITY OF ROCKWALL				JOB NO. 0136		