


SECTION A-A

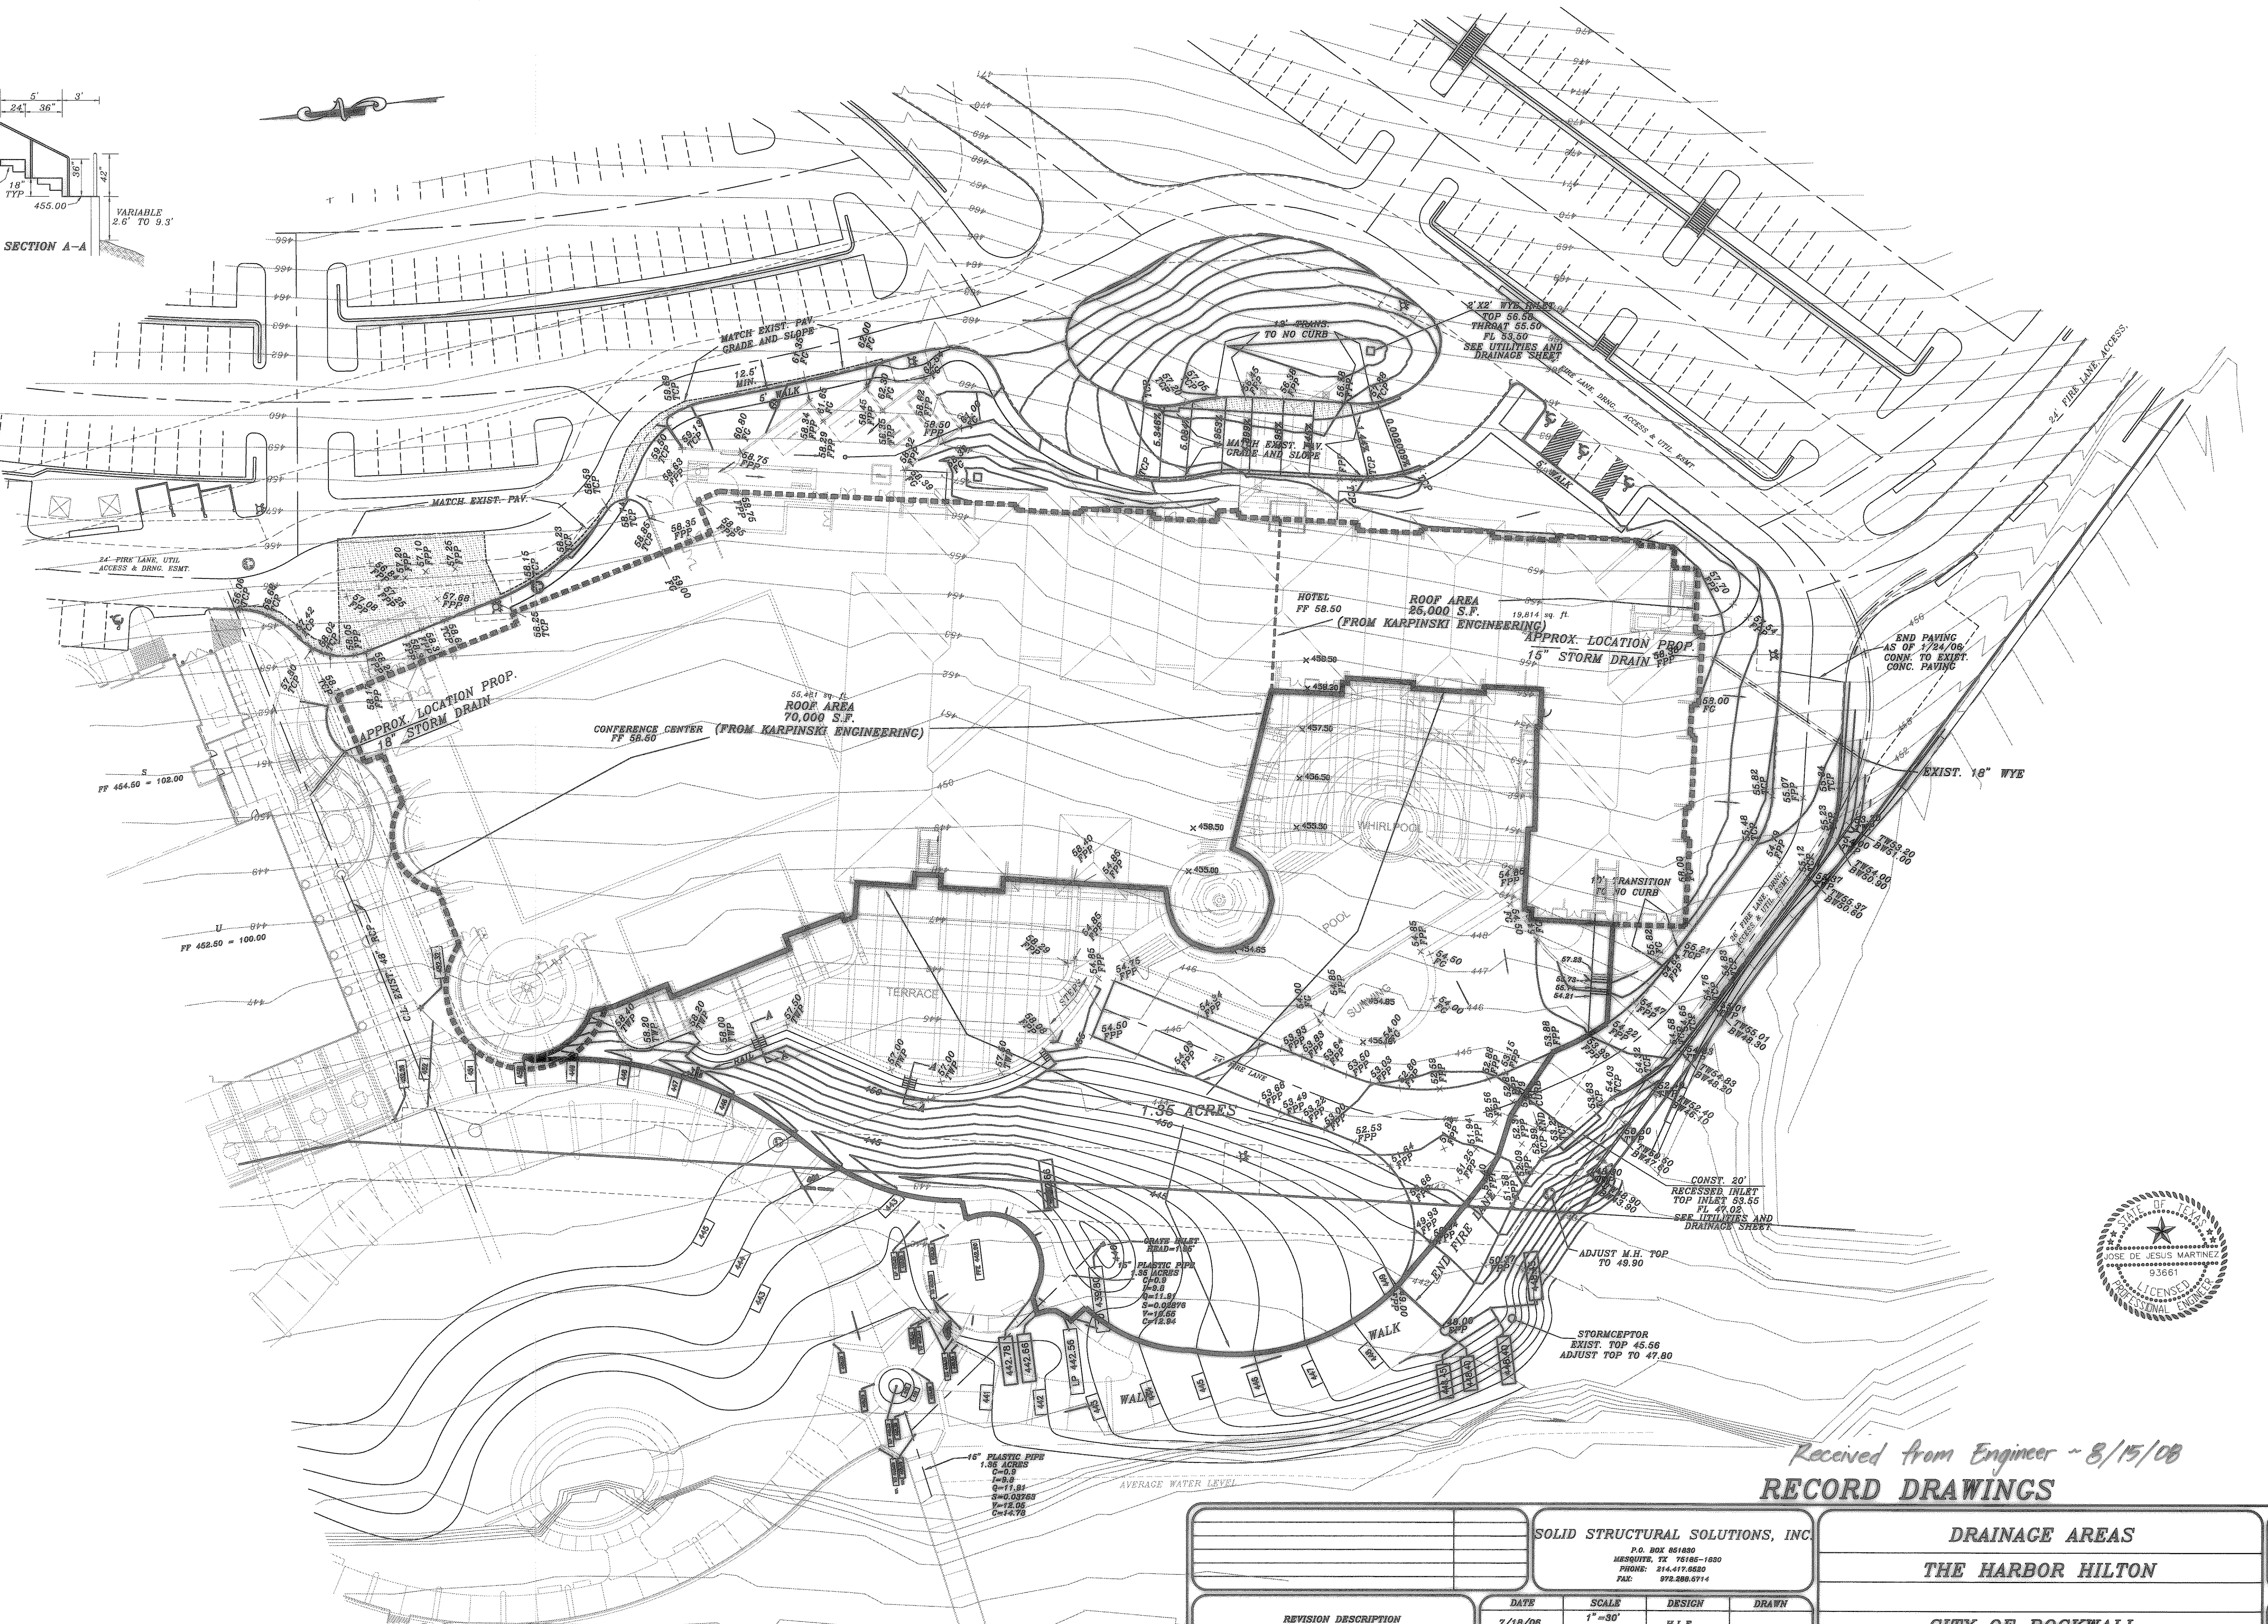

Received from Engineer - 8/15/08
RECORD DRAWINGS

SOLID STRUCTURAL SOLUTIONS, INC. P.O. BOX 851880 MESQUITE, TX 75188-1880 PHONE: 972-411-8820 FAX: 972-288-8714		DRAINAGE AREAS THE HARBOR HILTON		SHEET NO. 5
REVISION DESCRIPTION 0138HOTEL.DRW	DATE 7/18/08	SCALE 1"=30'	DESIGN H.L.F.	DRAWN
CITY OF ROCKWALL			JOB NO. 0136	SHEET NO. 5