



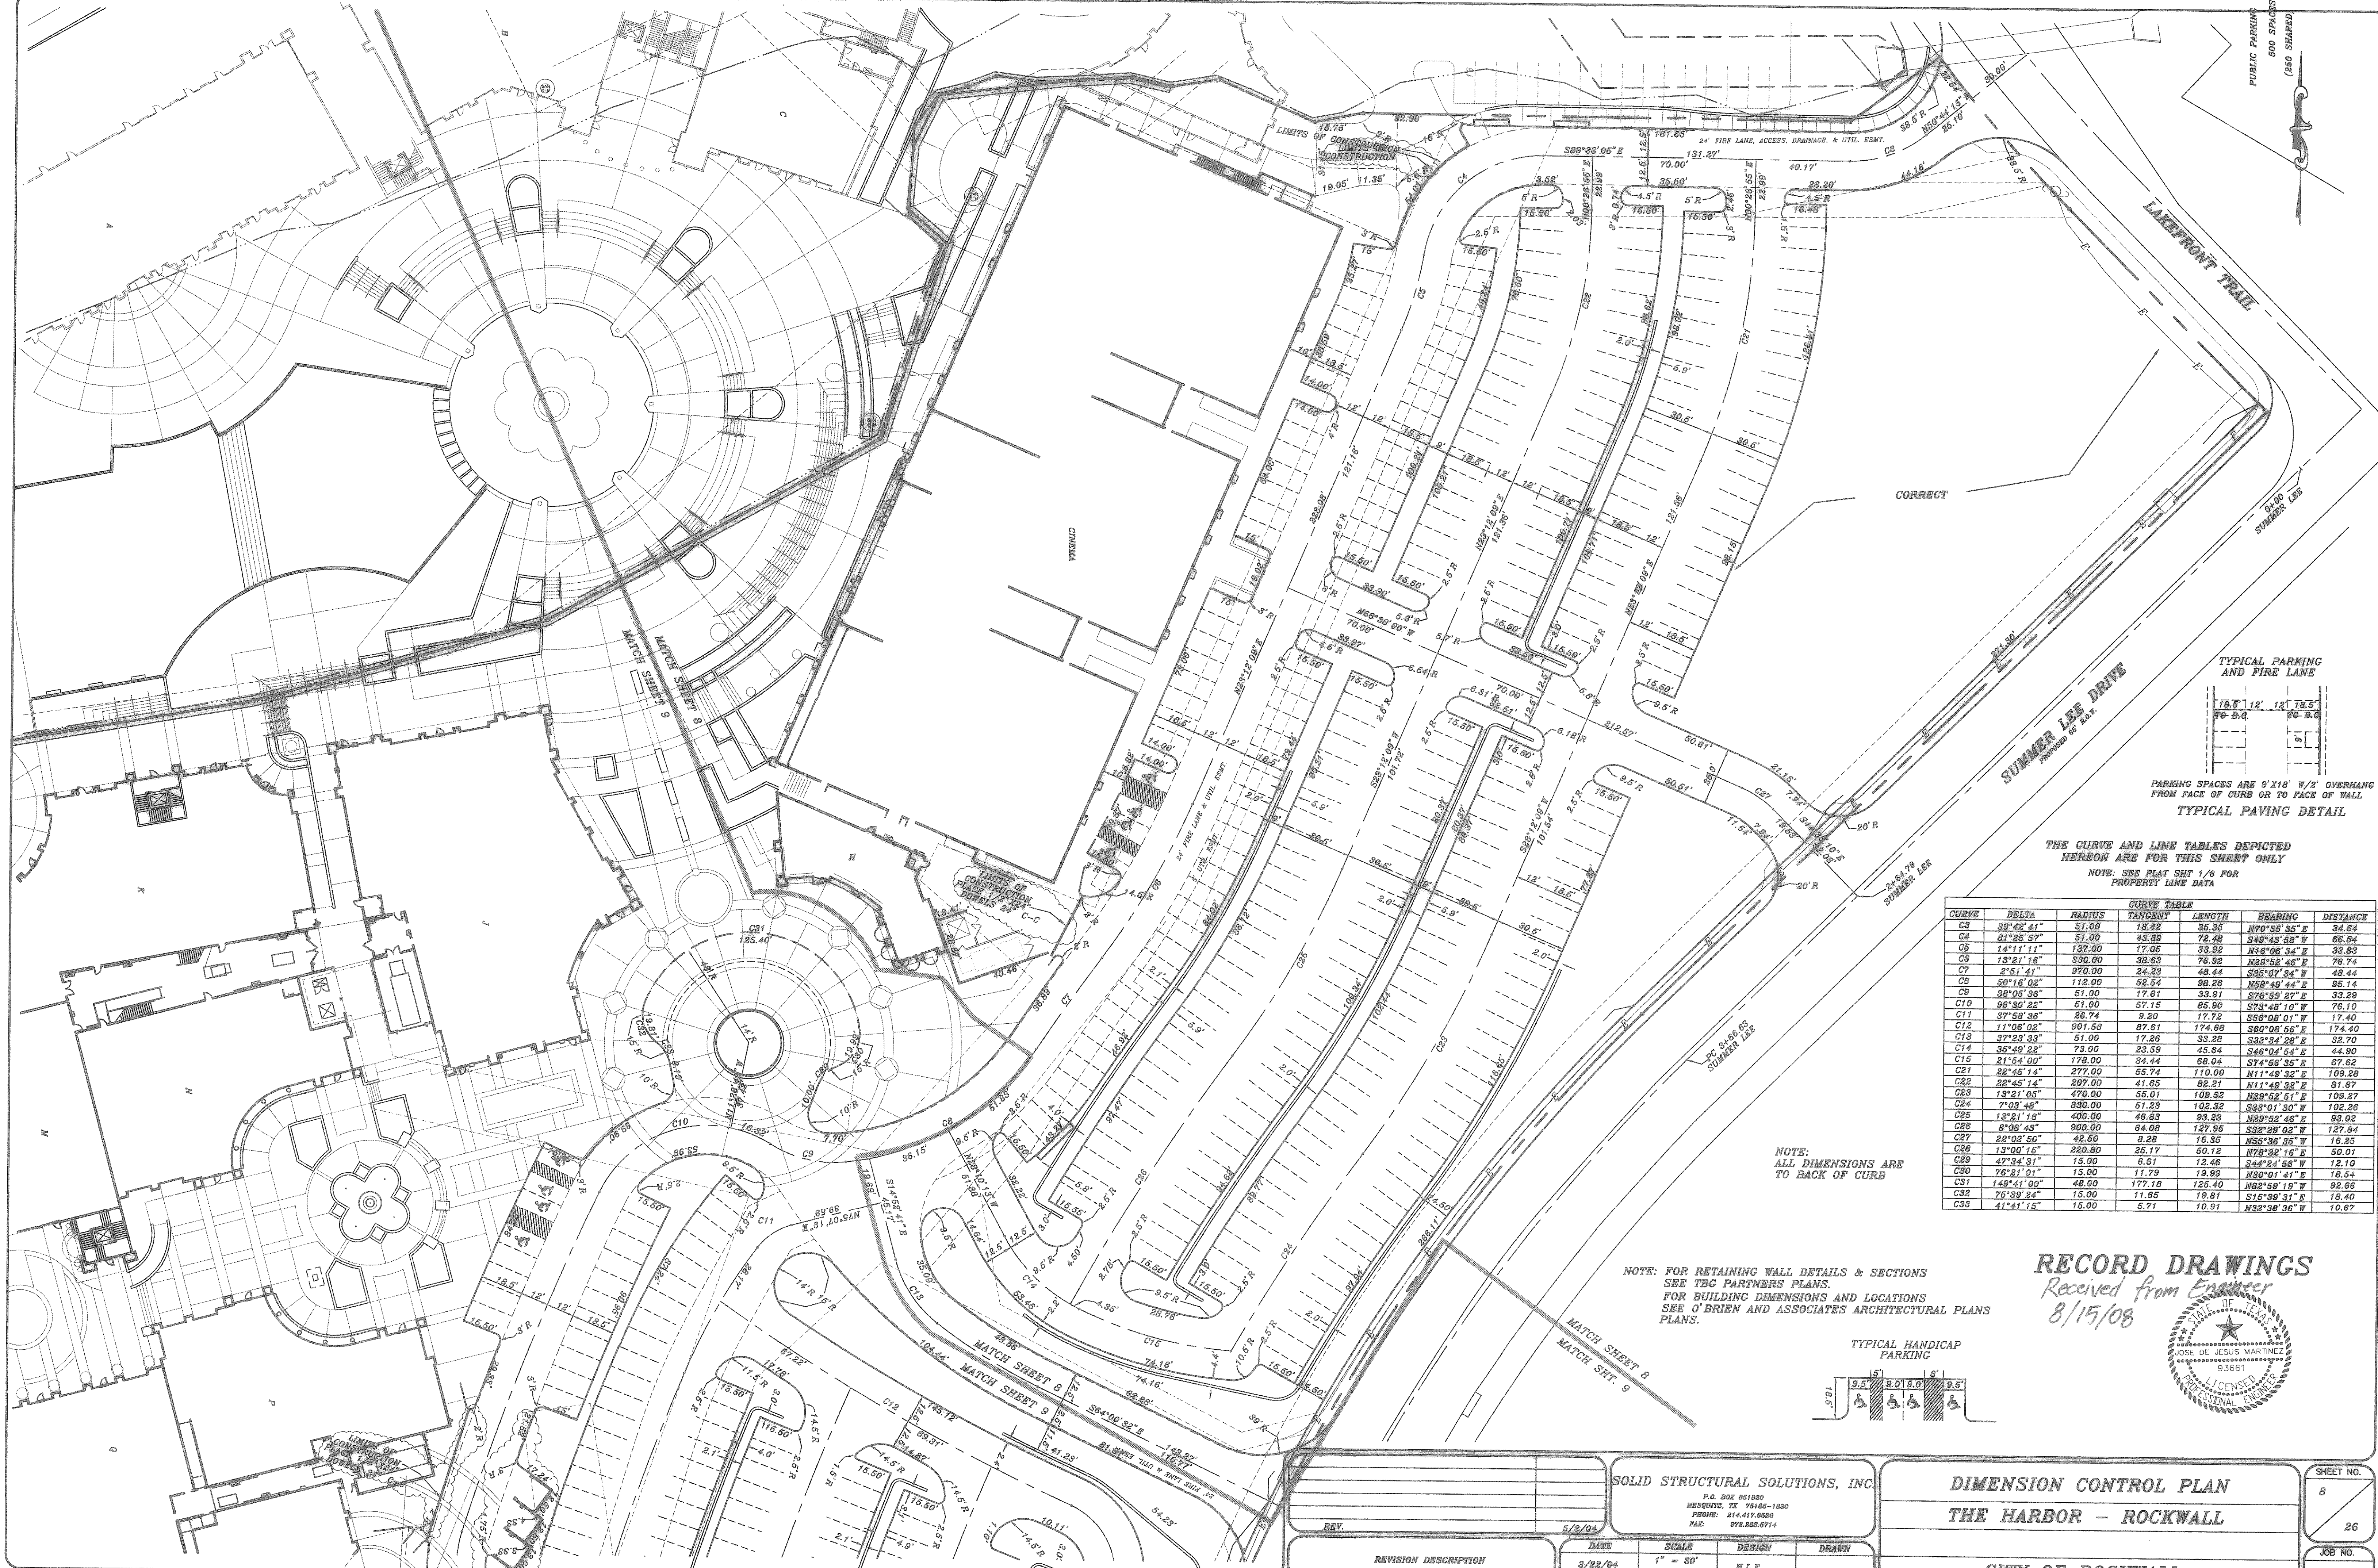

PUBLIC PARKING
600 SPACES
(240 STANDARD)

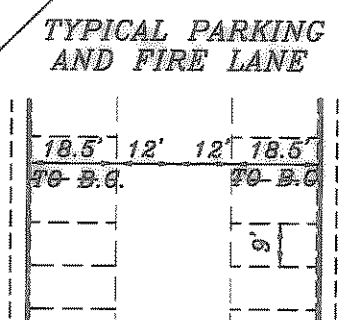


PARKING SPACES ARE 9'X18' W/2' OVERHANG FROM FACE OF CURB OR TO FACE OF WALL
TYPICAL PAVING DETAIL

THE CURVE AND LINE TABLES DEPICTED HEREON ARE FOR THIS SHEET ONLY
NOTE: SEE PLAT SHT 1/3 FOR PROPERTY LINE DATA

CURVE	DELTA	RADIUS	TANGENT	LENGTH	BEARING	DISTANCE
C3	39°42'41"	51.00	18.42	36.36	N70°35'35"E	34.84
C4	81°26'37"	51.00	43.89	72.49	S49°43'58"W	66.54
C5	14°11'11"	132.00	17.65	33.92	N16°06'34"E	33.83
C6	13°21'16"	330.00	38.63	76.82	N20°52'48"E	73.74
C7	2°51'41"	970.00	24.29	48.44	S38°07'34"W	48.44
C8	50°16'02"	112.00	62.54	98.26	N58°59'44"E	95.14
C9	38°05'36"	51.00	17.61	33.91	S78°59'27"E	33.29
C10	98°30'22"	51.00	57.15	85.90	S73°48'10"W	76.10
C11	37°52'36"	28.74	3.20	17.72	S80°08'55"E	17.40
C12	11°06'02"	901.58	87.61	174.68	S80°08'55"E	174.40
C13	37°23'33"	51.00	17.26	33.28	S38°34'28"E	32.70
C14	35°49'22"	73.00	23.59	45.64	S48°04'54"E	44.90
C15	21°54'00"	178.00	34.44	68.04	S74°56'35"E	67.62
C21	22°45'14"	277.00	55.74	110.00	N11°49'32"E	109.28
C22	22°45'14"	207.00	41.65	82.21	N11°49'32"E	81.67
C23	13°21'05"	470.00	55.01	108.52	N29°52'51"E	109.27
C24	7°03'42"	930.00	51.23	102.32	S38°01'30"W	102.58
C25	13°21'16"	400.00	46.83	93.23	N29°52'46"E	93.02
C26	8°08'49"	900.00	64.08	127.96	S32°28'02"W	127.84
C27	22°02'50"	42.50	6.28	16.35	N58°36'35"W	16.25
C28	13°00'15"	220.80	25.17	50.12	N78°32'18"E	50.01
C29	47°34'31"	15.00	6.51	12.46	S44°24'56"W	12.10
C30	76°21'01"	15.00	17.79	18.98	N30°01'41"E	18.54
C31	149°41'00"	48.00	177.18	125.40	N82°58'19"W	92.66
C32	75°38'24"	15.00	11.65	19.81	S15°38'31"E	15.40
C33	41°41'15"	15.00	5.71	10.91	N38°38'36"W	10.67

NOTE: ALL DIMENSIONS ARE TO BACK OF CURB

NOTE: FOR RETAINING WALL DETAILS & SECTIONS SEE TBC PARTNERS PLANS.
FOR BUILDING DIMENSIONS AND LOCATIONS SEE O'BRIEN AND ASSOCIATES ARCHITECTURAL PLANS.

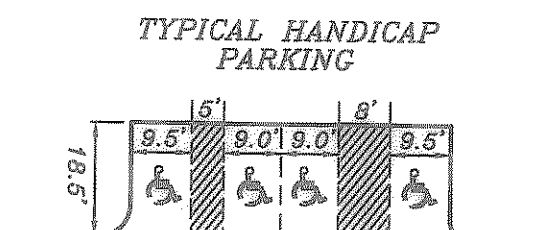

RECORD DRAWINGS
Received from Engineer
8/15/08



SOLID STRUCTURAL SOLUTIONS, INC. P.O. BOX 051880 MESQUITE, TX 75168-1880 PHONE: 214.417.6620 FAX: 972.288.0714		DIMENSION CONTROL PLAN THE HARBOR - ROCKWALL		SHEET NO. 8
REVISION DESCRIPTION 01:380012		DATE 3/22/04	SCALE 1" = 30'	DESIGN H.L.E.
		DRAWN		JOB NO. 0136
CITY OF ROCKWALL				