
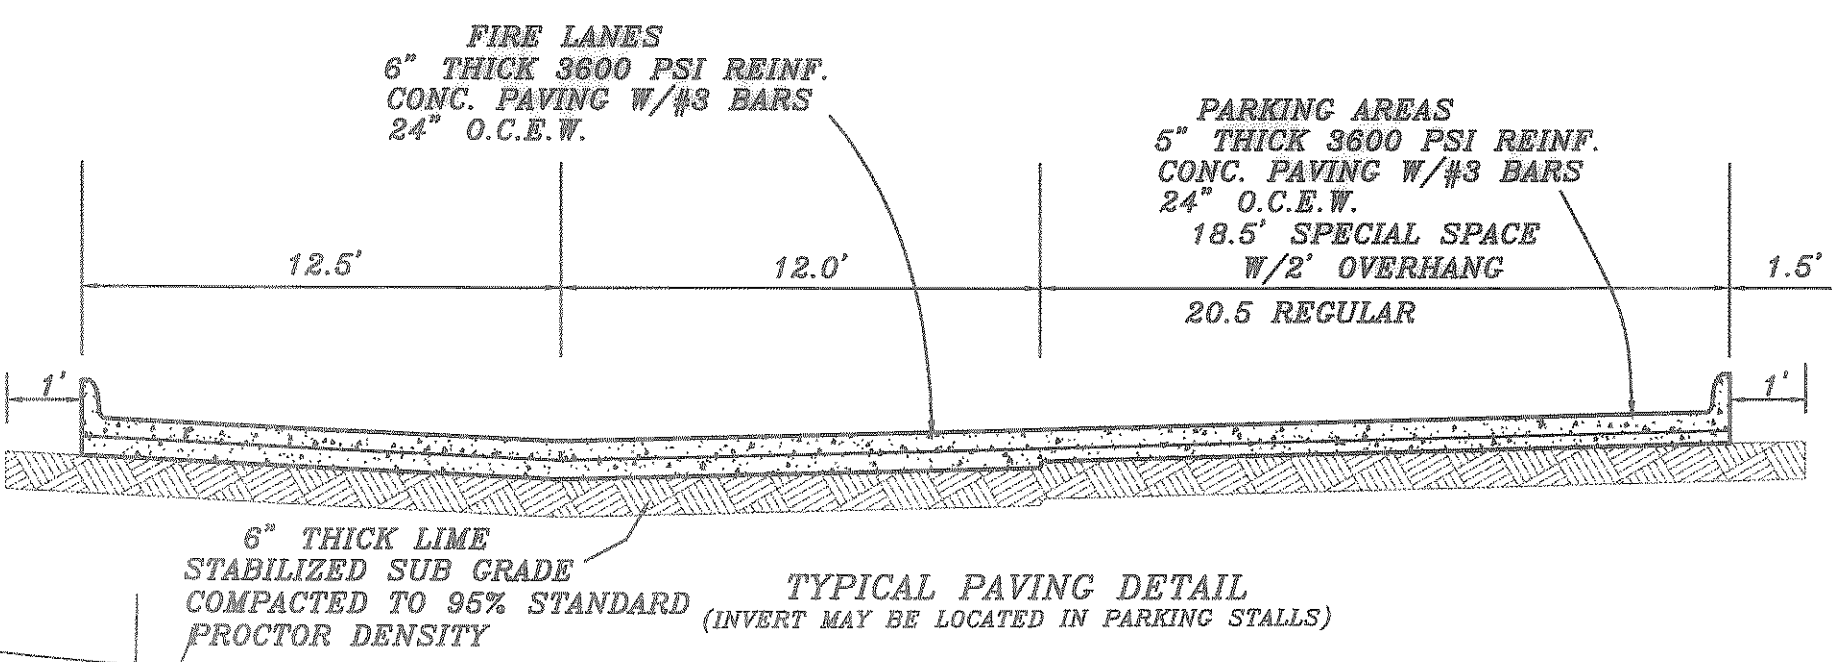


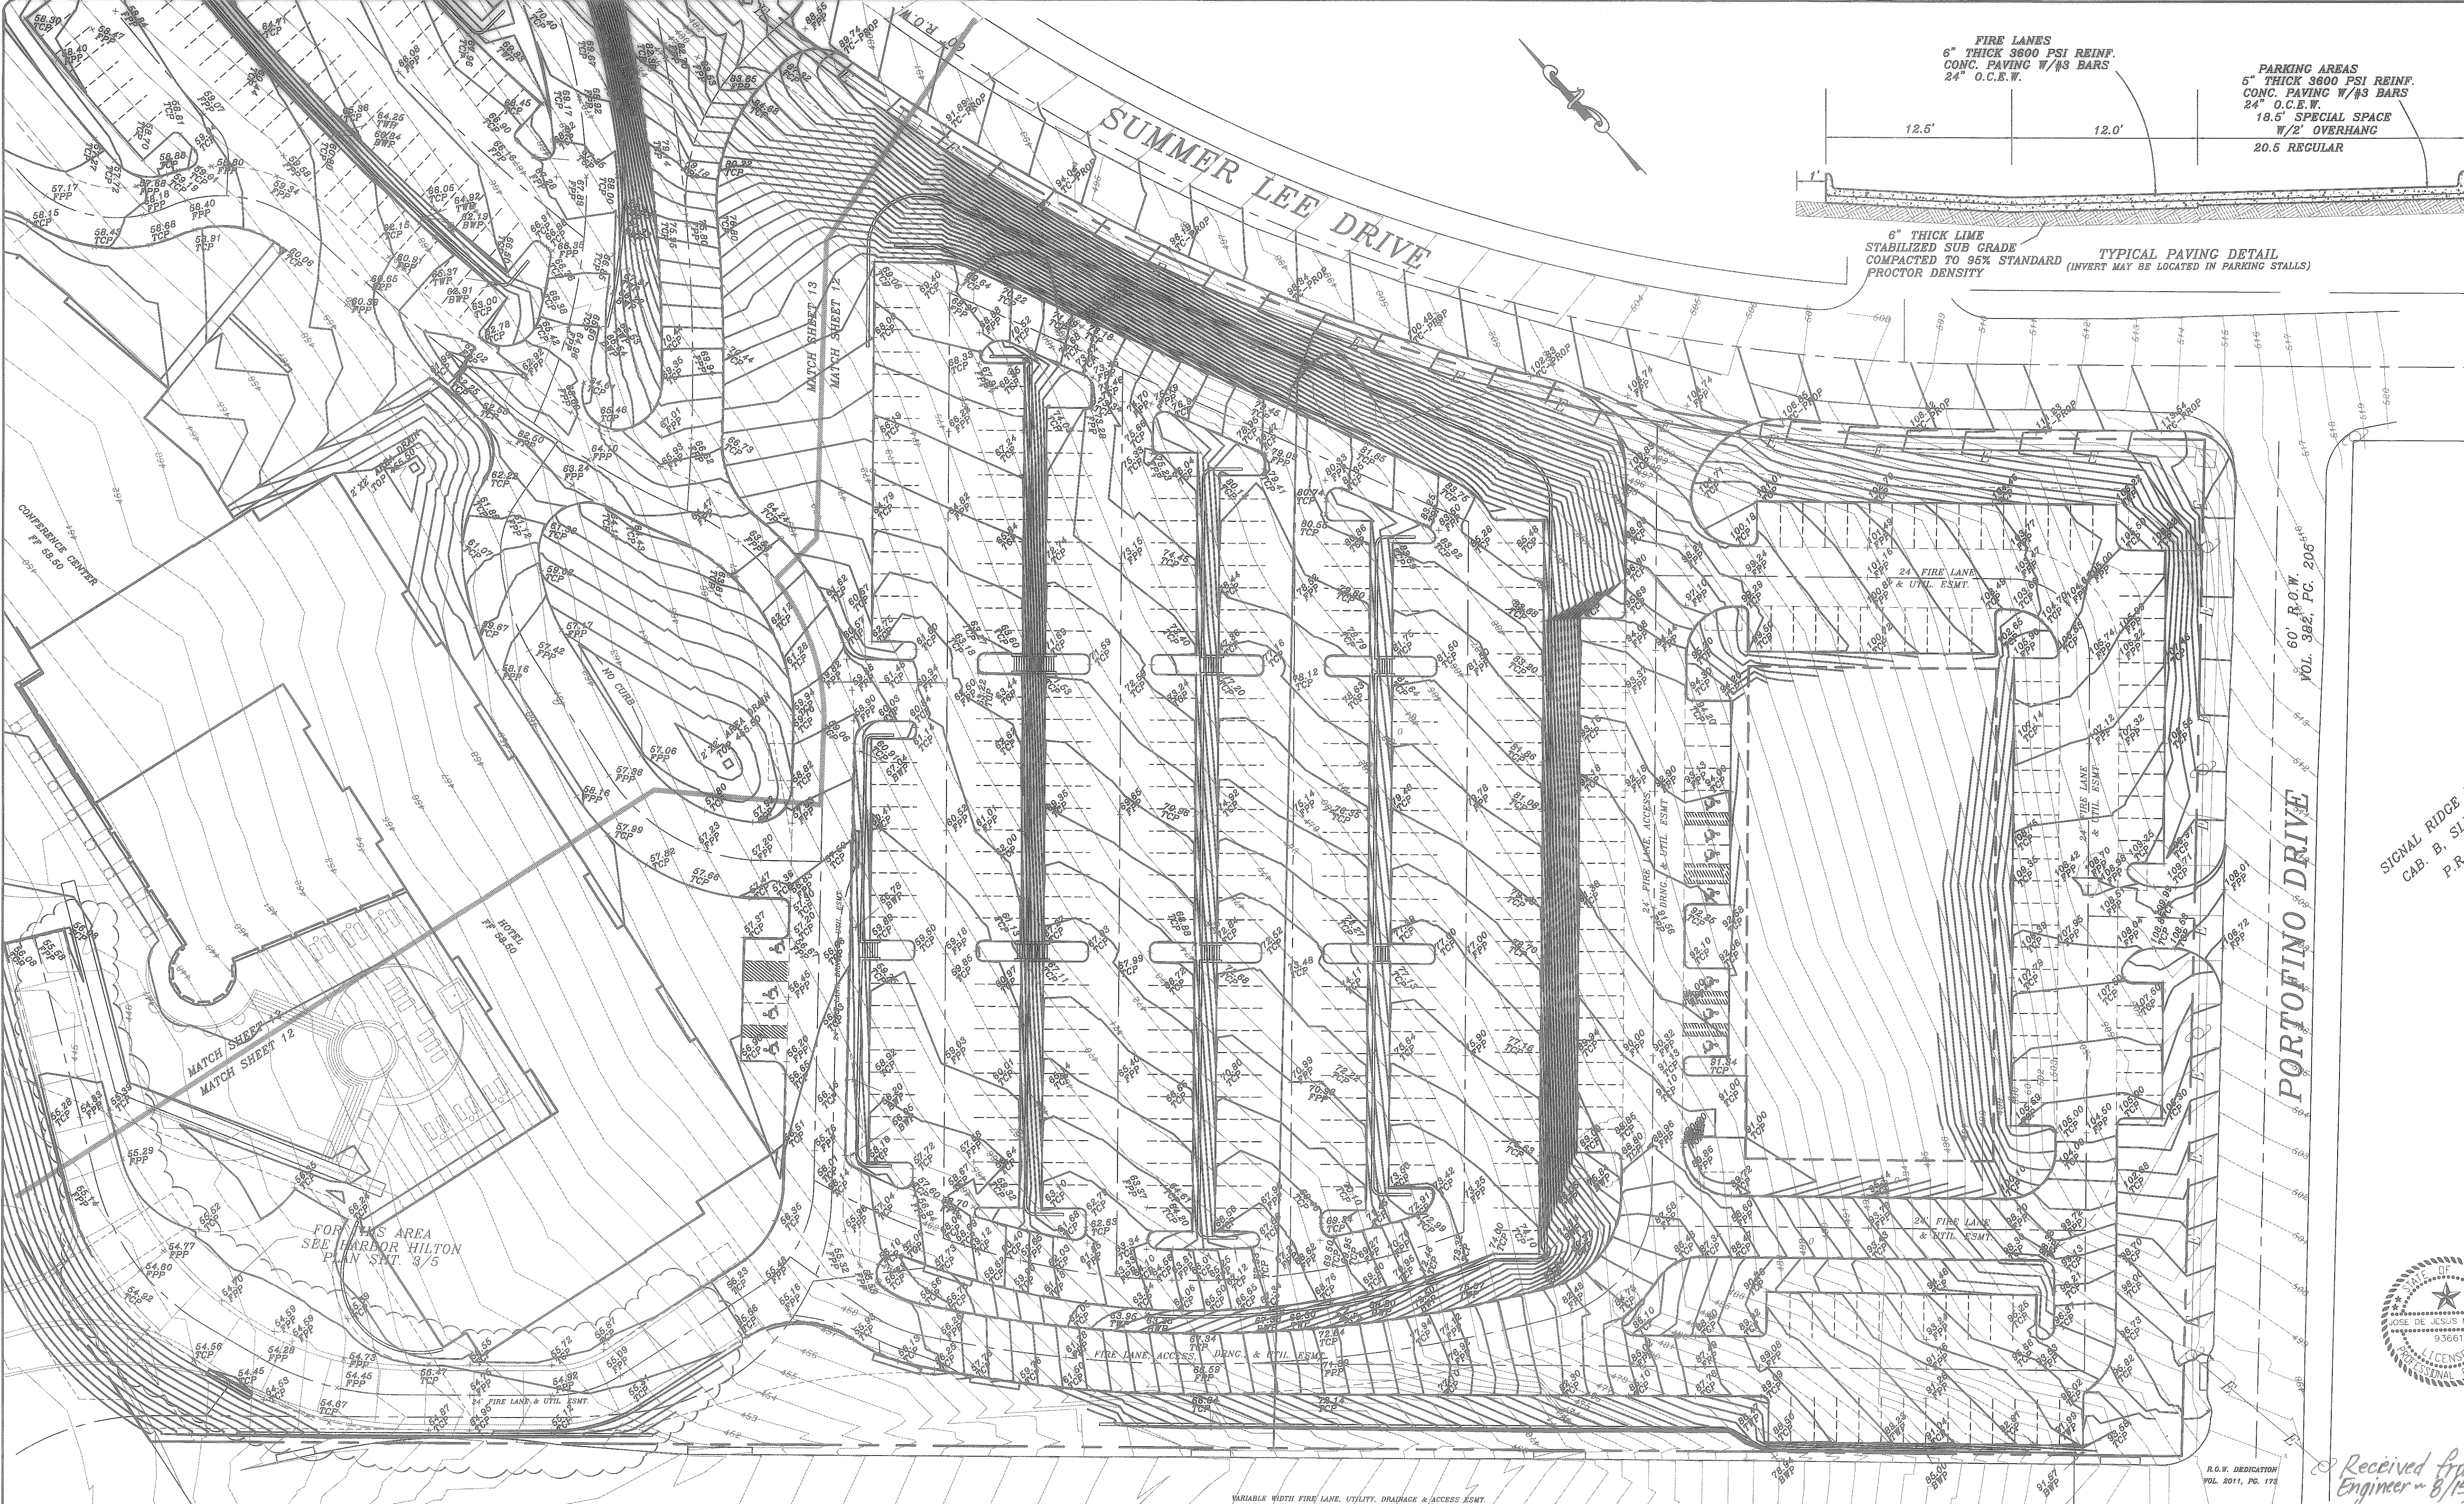

LEGEND

X TC ELEVATION	EXIST. TOP OF CURB
X TCE ELEVATION	PROPOSED TOP OF CURB
X FPP ELEVATION	PROPOSED FINISHED PAVING

ADD 400 TO PROPOSED ELEVATIONS

NOTE: FOR RETAINING WALL DETAILS & SECTIONS
SEE TBG PARTNERS PLANS.

LOT 1, BLOCK A
VILLAS DE PORTOFINO

REVISION		DATE 7/16/04 5/9/04	SCALE 1" = 30'	DESIGN H.L.E.	DRAWN	SHEET NO. 12 26
REV.	DESCRIPTION					
REVISION DESCRIPTION						

SOLID STRUCTURAL SOLUTIONS, INC.
P.O. BOX 861880
MESQUITE, TX 75185-1880
PHONE: 972.286.0714
FAX: 972.286.0714

GRADING AND PAVING
THE HARBOR - ROCKWALL
CITY OF ROCKWALL

RECEIVED FROM
Engineer - 8/15/08

RECORD DRAWINGS

