



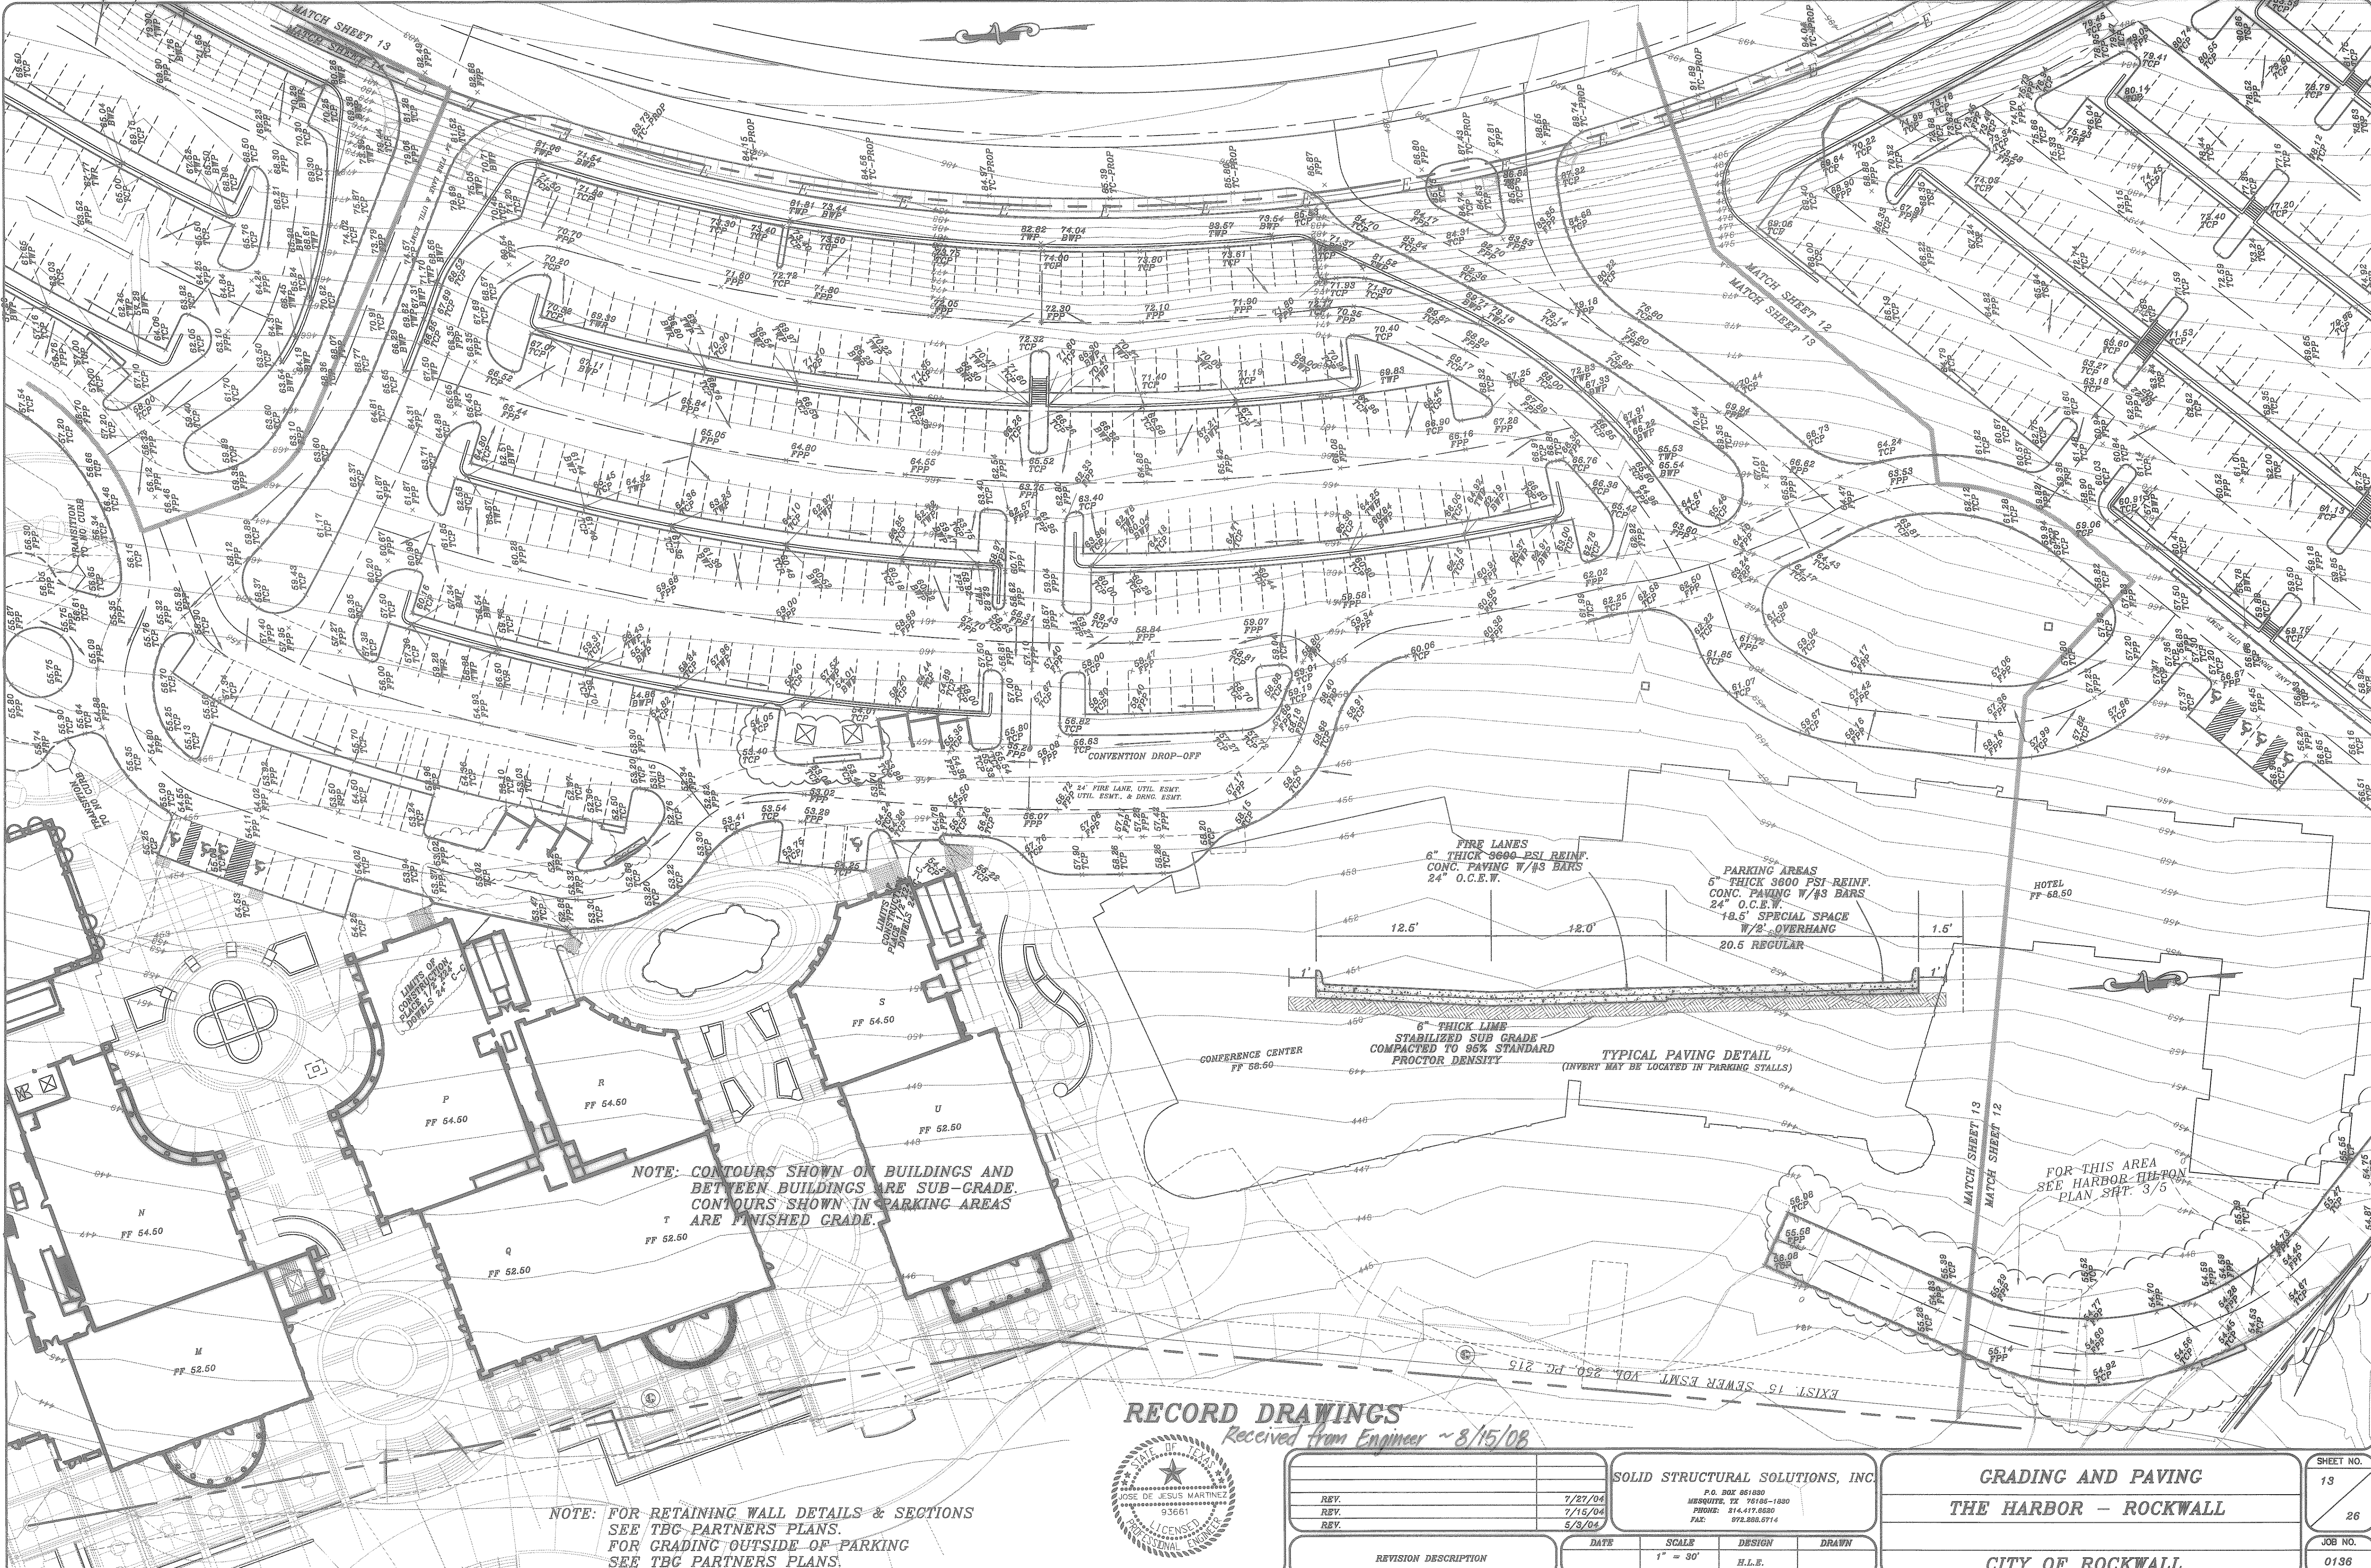

NOTE: CONTOURS SHOWN ON BUILDINGS AND BETWEEN BUILDINGS ARE SUB-GRADE. CONTOURS SHOWN IN PARKING AREAS ARE FINISHED GRADE.

NOTE: FOR RETAINING WALL DETAILS & SECTIONS SEE TBC PARTNERS PLANS. FOR GRADING OUTSIDE OF PARKING SEE TBC PARTNERS PLANS.

RECORD DRAWINGS
Received from Engineer ~ 8/15/08

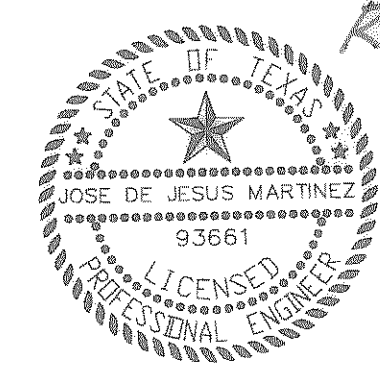

REV.	REVISION DESCRIPTION
1	7/27/04
2	7/15/04
3	5/9/04

SOLID STRUCTURAL SOLUTIONS, INC.			
P.O. BOX 851890			
MESQUITE, TX 75185-1890			
PHONE: 214.417.6880			
FAX: 972.288.9714			
DATE	SCALE	DESIGN	DRAWN
	1" = 30'	H.L.E.	

GRADING AND PAVING		SHEET NO. 13
THE HARBOR - ROCKWALL		
CITY OF ROCKWALL		JOB NO. 0136