


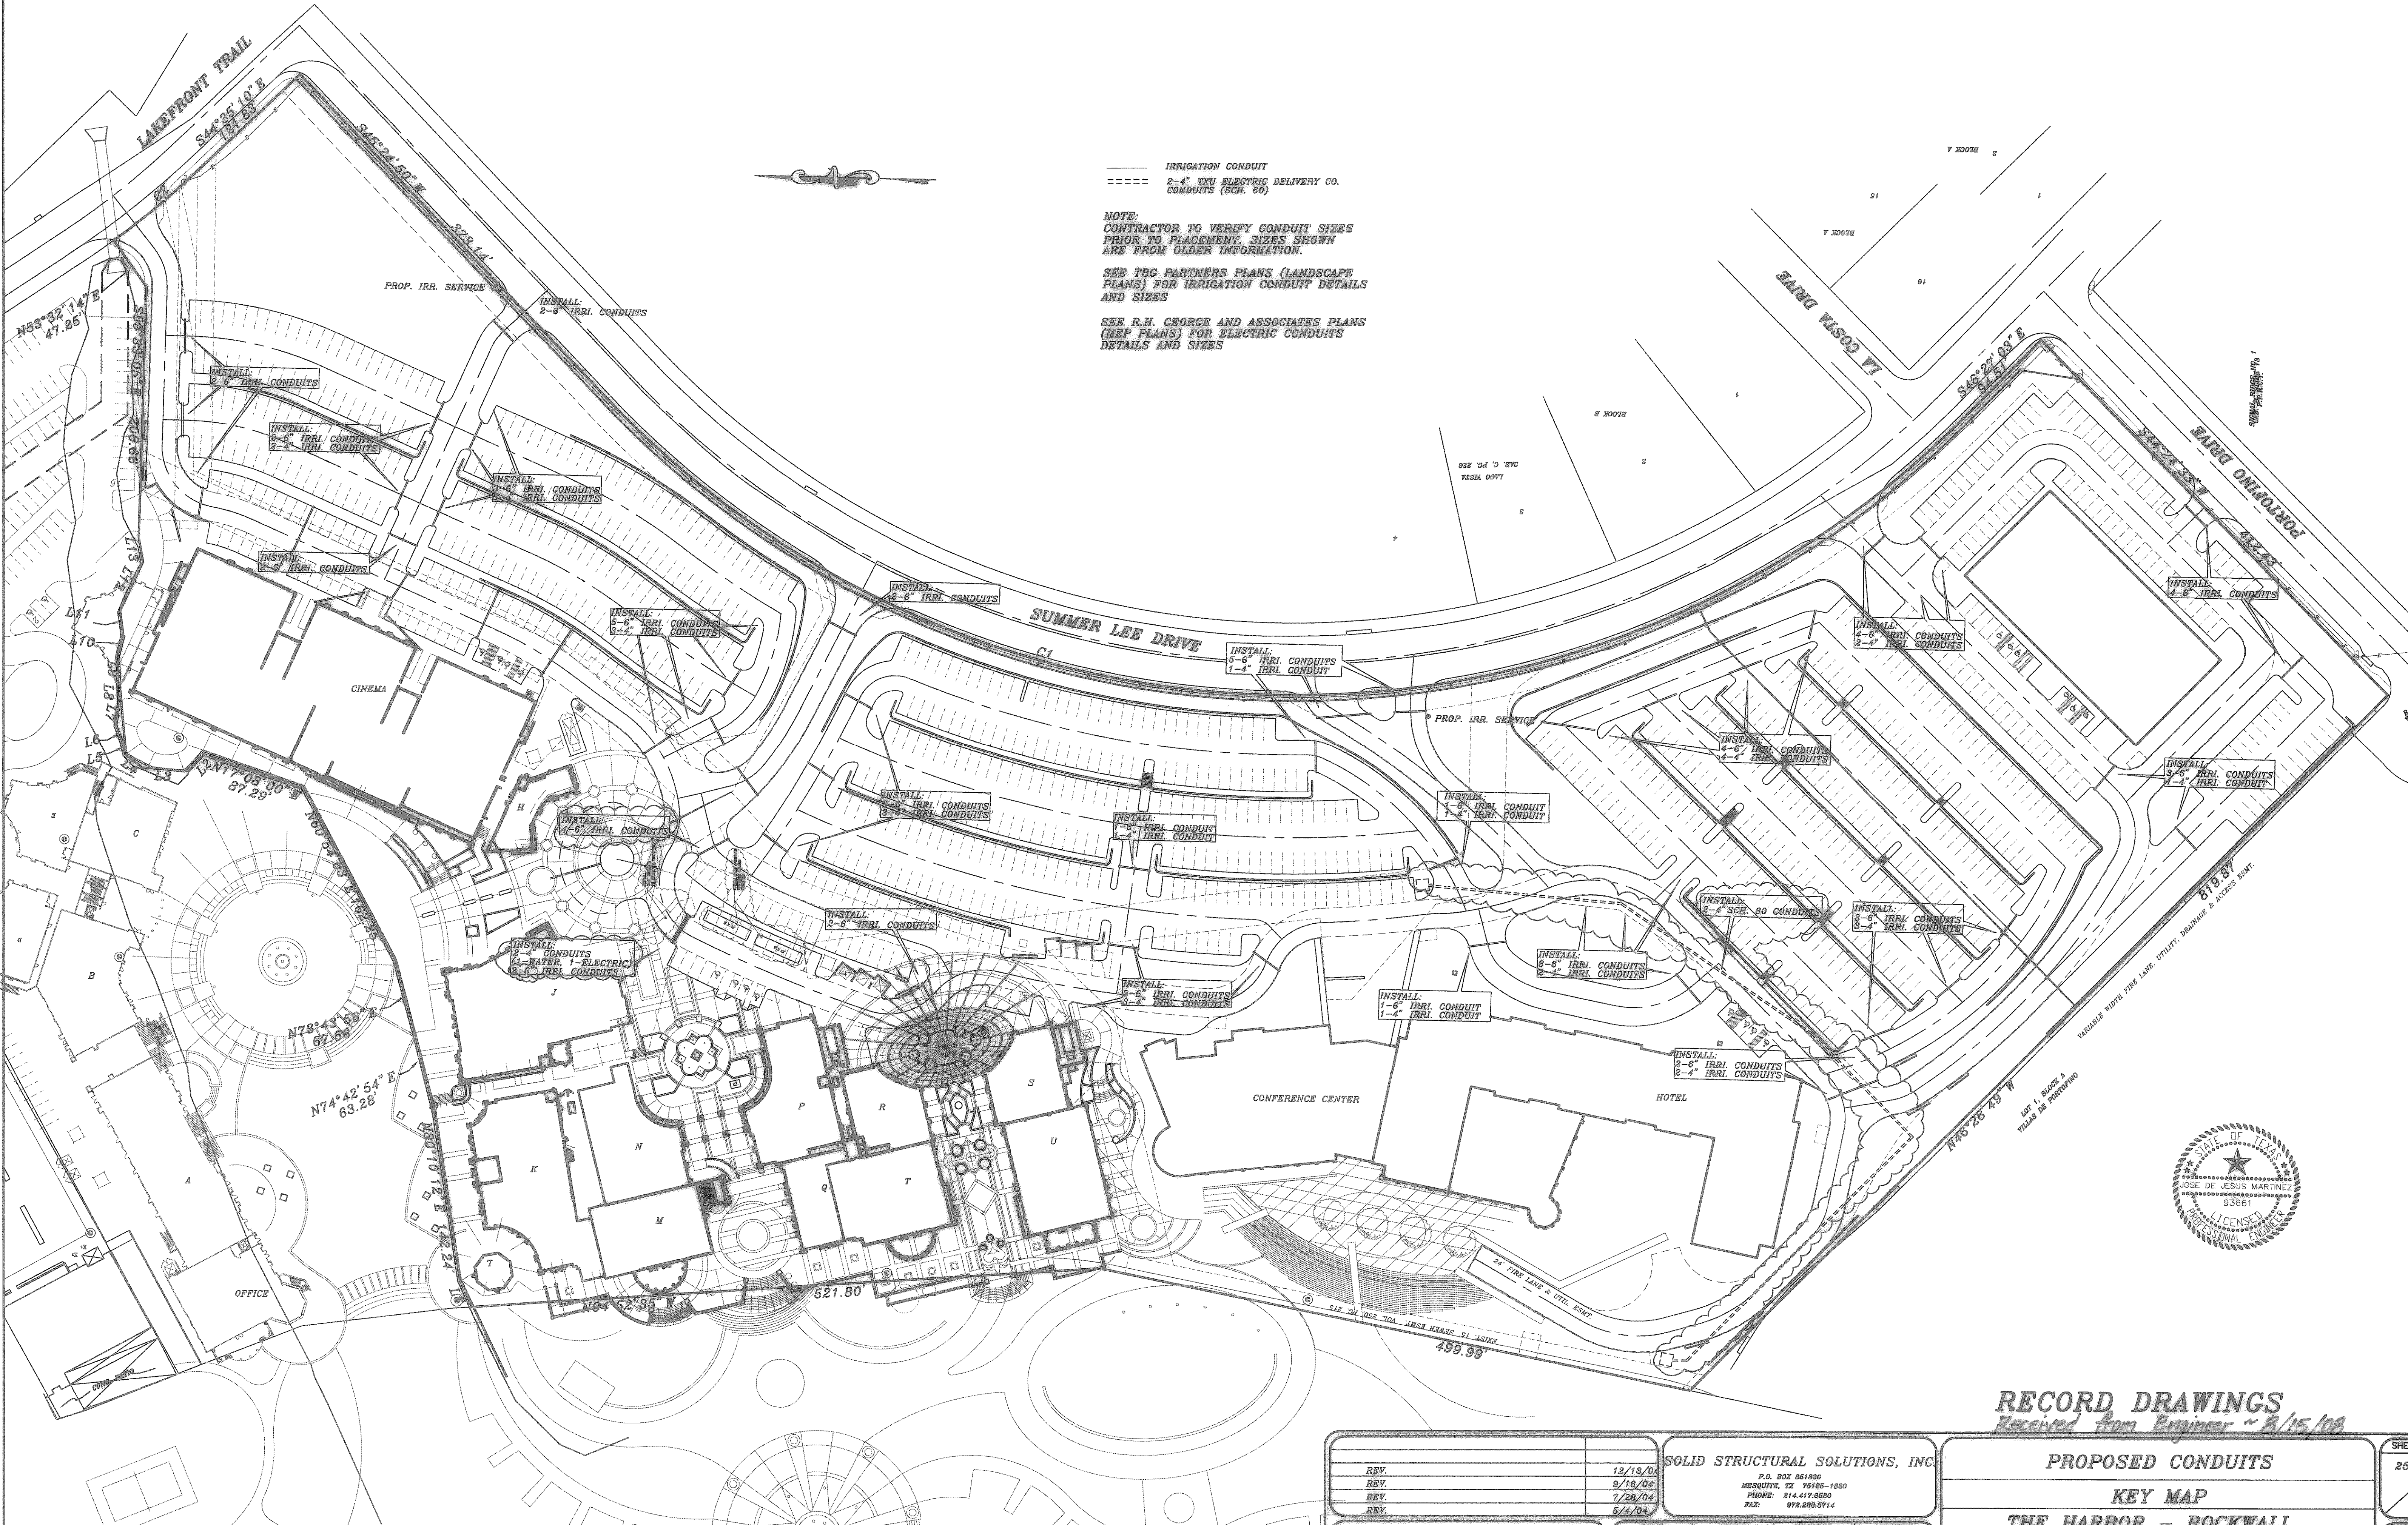

RECORD DRAWINGS
Received from Engineer ~ 8/15/08

SOLID STRUCTURAL SOLUTIONS, INC. P.O. BOX 851600 MESQUITE, TX 75186-1600 PHONE: 814.417.8580 FAX: 972.888.5714				PROPOSED CONDUITS		SHEET NO. 25
THE HARBOR - ROCKWALL				KEY MAP		26
CITY OF ROCKWALL				JOB NO. 0136		
REVISION DESCRIPTION 0136CONDUITS		DATE 4/16/04	SCALE 1" = 60'	DESIGN H.L.E.	DRAWN	
REV.		12/19/04				
REV.		9/16/04				
REV.		7/20/04				
REV.		5/1/04				