

DRAINAGE TABLE


DRAINAGE AREA NO.	ACRES	T.C.	C	I 100 YR.	Q 100 YR.	SUM Q
LINE B		10 MIN.	0.9	9.8		
1A	0.31	"	"	"	2.73	2.73
1B	0.19	"	"	"	1.68	4.41
2	1.39	"	"	"	12.26	16.87
2A	0.45	"	"	"	3.97	20.84
3	0.47	"	"	"	4.15	24.79
4	1.88	"	"	"	16.58	41.37
5	0.19	"	"	"	1.68	43.05
6	0.51	"	"	"	4.50	47.55
7	1.36	"	"	"	12.00	59.55
8	0.65	"	"	"	5.73	65.28
9	0.28	"	"	"	2.47	67.75
10	1.92	"	"	"	16.83	84.68
11	1.08	"	"	"	9.61	94.29
12	0.69	"	"	"	6.09	100.38
13	2.77	"	"	"	24.43	124.81
14	1.806	"	"	"	(14.17)	138.98
LINE C						
15	1.16	"	"	"	10.14	10.14
16	0.19	"	"	"	1.68	11.82
17	0.31	"	"	"	2.73	14.55
18	1.75	"	"	"	15.44	28.99
19	2.88	"	"	"	23.46	53.45
20	(0.57)	"	"	"	(5.01)	58.48
21	1.93	"	"	"	16.74	74.60

CITY OF ROCKWALL, TEXAS INLET DESIGN		PROJECT NAME: THE HARBOR - ROCKWALL LINE B											BY: HAROLD L. EVANS DATE: 2/17/04		
CALCULATIONS		AREA Q = CIA											SELECTED INLET		
NO.	LOCATION	DESIGN STORM FREQUENCY (years)	TIME OF CONC. (min)	INTENSITY I (in/hr)	RUNOFF COEFF.	AREA (ac.)	"Q" (c.f.s.)	CARRY-OVER UPSTREAM INLET (c.f.s.)	TOTAL GUTTER FLOW (c.f.s.)	GUTTER CAPACITY	GUTTER SLOPE	CROWN	LENGTH "L" (Feet)	TYPE	CARRY-OVER DOWNSTREAM INLET (c.f.s.)
1	2	3	4	5	6	7	8	9	10	11	12	13	14	15	16
B-1	19+72	100	10	9.8	0.90	0.31	2.73	7.26	9.99	42	0.005	TRIANGULAR	10'	CURB	
B-2	19+61	"	"	"	"	1.39	12.26	—	12.26	42	4.8	TRIANGULAR	15'	CURB	7.26
B-3	19+48	"	"	"	"	0.19	1.68	—	—	—	—	DRAIN	—	—	
B-4	17+59	"	"	"	"	0.45	3.97	—	—	—	—	DRAIN	—	—	
B-5	16+49	"	"	"	"	0.47	4.15	—	—	—	—	DRAIN	—	—	
B-6	14+28	"	"	"	"	1.88	16.58	—	16.58	20	SAG	—	20' INLET	CURB	
B-7	14+18	"	"	"	"	0.19	1.68	—	—	—	—	DRAIN	—	—	
B-8	13+13	"	"	"	"	0.51	4.50	—	—	—	—	DRAIN	—	—	
B-9	12+47	"	"	"	"	1.36	12.00	—	—	—	—	DRAIN	—	—	
B-10	11+83	"	"	"	"	0.65	5.73	—	—	—	—	DRAIN	—	—	
B-11	10+83	"	"	"	"	0.28	2.47	—	—	—	—	DRAIN	—	—	
B-12	10+62	"	"	"	"	1.82	16.93	4.43	21.36	42	SAG	TRIANGULAR	20'	CURB	
B-13	10+50	"	"	"	"	1.09	9.61	—	9.61	30	SAG	—	10'	CURB	
B-14	9+64	"	"	"	"	0.69	6.09	—	—	—	—	DRAIN	—	—	
B-15	9+64	"	"	"	"	2.77	24.43	—	24.43	42	0.005	TRIANGULAR	20'	CURB	4.43
B-16	8+50	"	"	"	"	1.47	12.97	—	—	—	—	DRAIN	—	—	
17-28	8+50	"	"	"	"	1.47	12.97	—	—	—	—	DRAIN	—	—	

CITY OF ROCKWALL, TEXAS INLET DESIGN		PROJECT NAME: THE HARBOR - ROCKWALL LINE C											BY: HAROLD L. EVANS DATE: 2/17/04		
CALCULATIONS		AREA Q = CIA											SELECTED INLET		
NO.	LOCATION	DESIGN STORM FREQUENCY (years)	TIME OF CONC. (min)	INTENSITY I (in/hr)	RUNOFF COEFF.	AREA (ac.)	"Q" (c.f.s.)	CARRY-OVER FROM UPSTREAM INLET (c.f.s.)	TOTAL GUTTER FLOW (c.f.s.)	GUTTER CAPACITY	GUTTER SLOPE	CROWN	LENGTH "L" (Feet)	TYPE	CARRY-OVER TO DOWNSTREAM INLET (c.f.s.)
1	2	3	4	5	6	7	8	9	10	11	12	13	14	15	16
C-1	8+96.76	100	10	9.8	0.90	1.15	10.14	0	10.14	40	3.009	TRIANGULAR	20'	CURB	
C-2	AREA DRAIN	"	"	"	"	0.19	1.68	0	—	—	—	2X2	GRATE	—	
C-3	AREA DRAIN	"	"	"	"	0.31	2.73	0	—	—	—	2X2	GRATE	—	
C-4	7+22	"	"	"	"	1.75	15.44	0	15.44	42	4.4	TRIANGULAR	15'	CURB	2.94
C-5	LINE "D"	"	"	"	"	2.66	23.46	0	—	—	—	—	—	—	
C-6	6+60	"	"	"	"	0.36	3.18	0	—	—	—	—	—	—	
C-7	4+55	"	"	"	"	1.83	16.14	2.94	21.51	20' RA/SAG	4.4	—	20	CURB	

Received from Engineer
3/15/08
RECORD DRAWINGS

SOLID STRUCTURAL SOLUTIONS, INC.		DRAINAGE AREA MAP		
P.O. BOX 651690 MESQUITE, TX 75165-1690 PHONE: 214.417.6820 FAX: 972.228.5714		THE HARBOR - ROCKWALL		
REV. REV.	DATE 2/28/06 3/30/06	SCALE 1"=60'	DESIGN	DRAWN
0136DRN		12/16/08		
REVISION DESCRIPTION		12/16/08	H.L.E.	
CITY OF ROCKWALL				

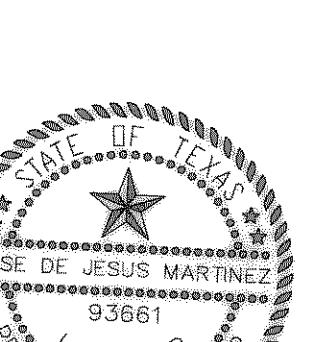

SHEET NO.
16
26
JOB NO.
0136