



THE CURVE AND LINE TABLES DEPICTED HEREON ARE FOR THIS SHEET ONLY
NOTE: SEE SHT 1/5 FOR PROPERTY LINE DATA

CURVE	DELTA	RADIUS	TANGENT	LENGTH	BEARING	DISTANCE
C25	10°12'50"	331.07	29.64	58.12	S15°06'17"E	59.05
C28	4°56'45"	150.00	6.48	12.95	S22°41'05"E	12.94
C27	71°36'11"	92.08	67.06	116.20	N10°38'38"E	109.78
C30	52°25'27"	75.00	36.92	66.62	S15°35'28"E	66.25
C31	56°05'45"	51.00	27.17	48.93	N72°27'26"E	47.96
C32	33°00'54"	51.00	15.11	28.39	S82°59'15"E	28.90
C33	29°50'24"	112.00	30.00	58.62	S31°22'07"E	57.96
C34	45°32'01"	96.00	40.29	76.29	S08°18'36"W	74.30
C35	49°57'12"	311.60	145.14	271.66	S42°18'35"E	269.14
C36	1°32'42"	499.50	6.74	13.47	N47°15'10"W	13.47
C37	23°49'28"	51.00	10.76	21.21	S23°08'10"E	21.05
C38	26°57'28"	554.58	132.92	260.91	S48°31'37"E	258.51
C39	74°29'30"	51.00	38.78	66.29	N60°45'26"E	61.22
C40	90°00'00"	32.00	32.00	50.27	N01°28'49"W	45.25
C41	57°12'40"	25.50	13.91	25.48	N72°07'31"E	24.42

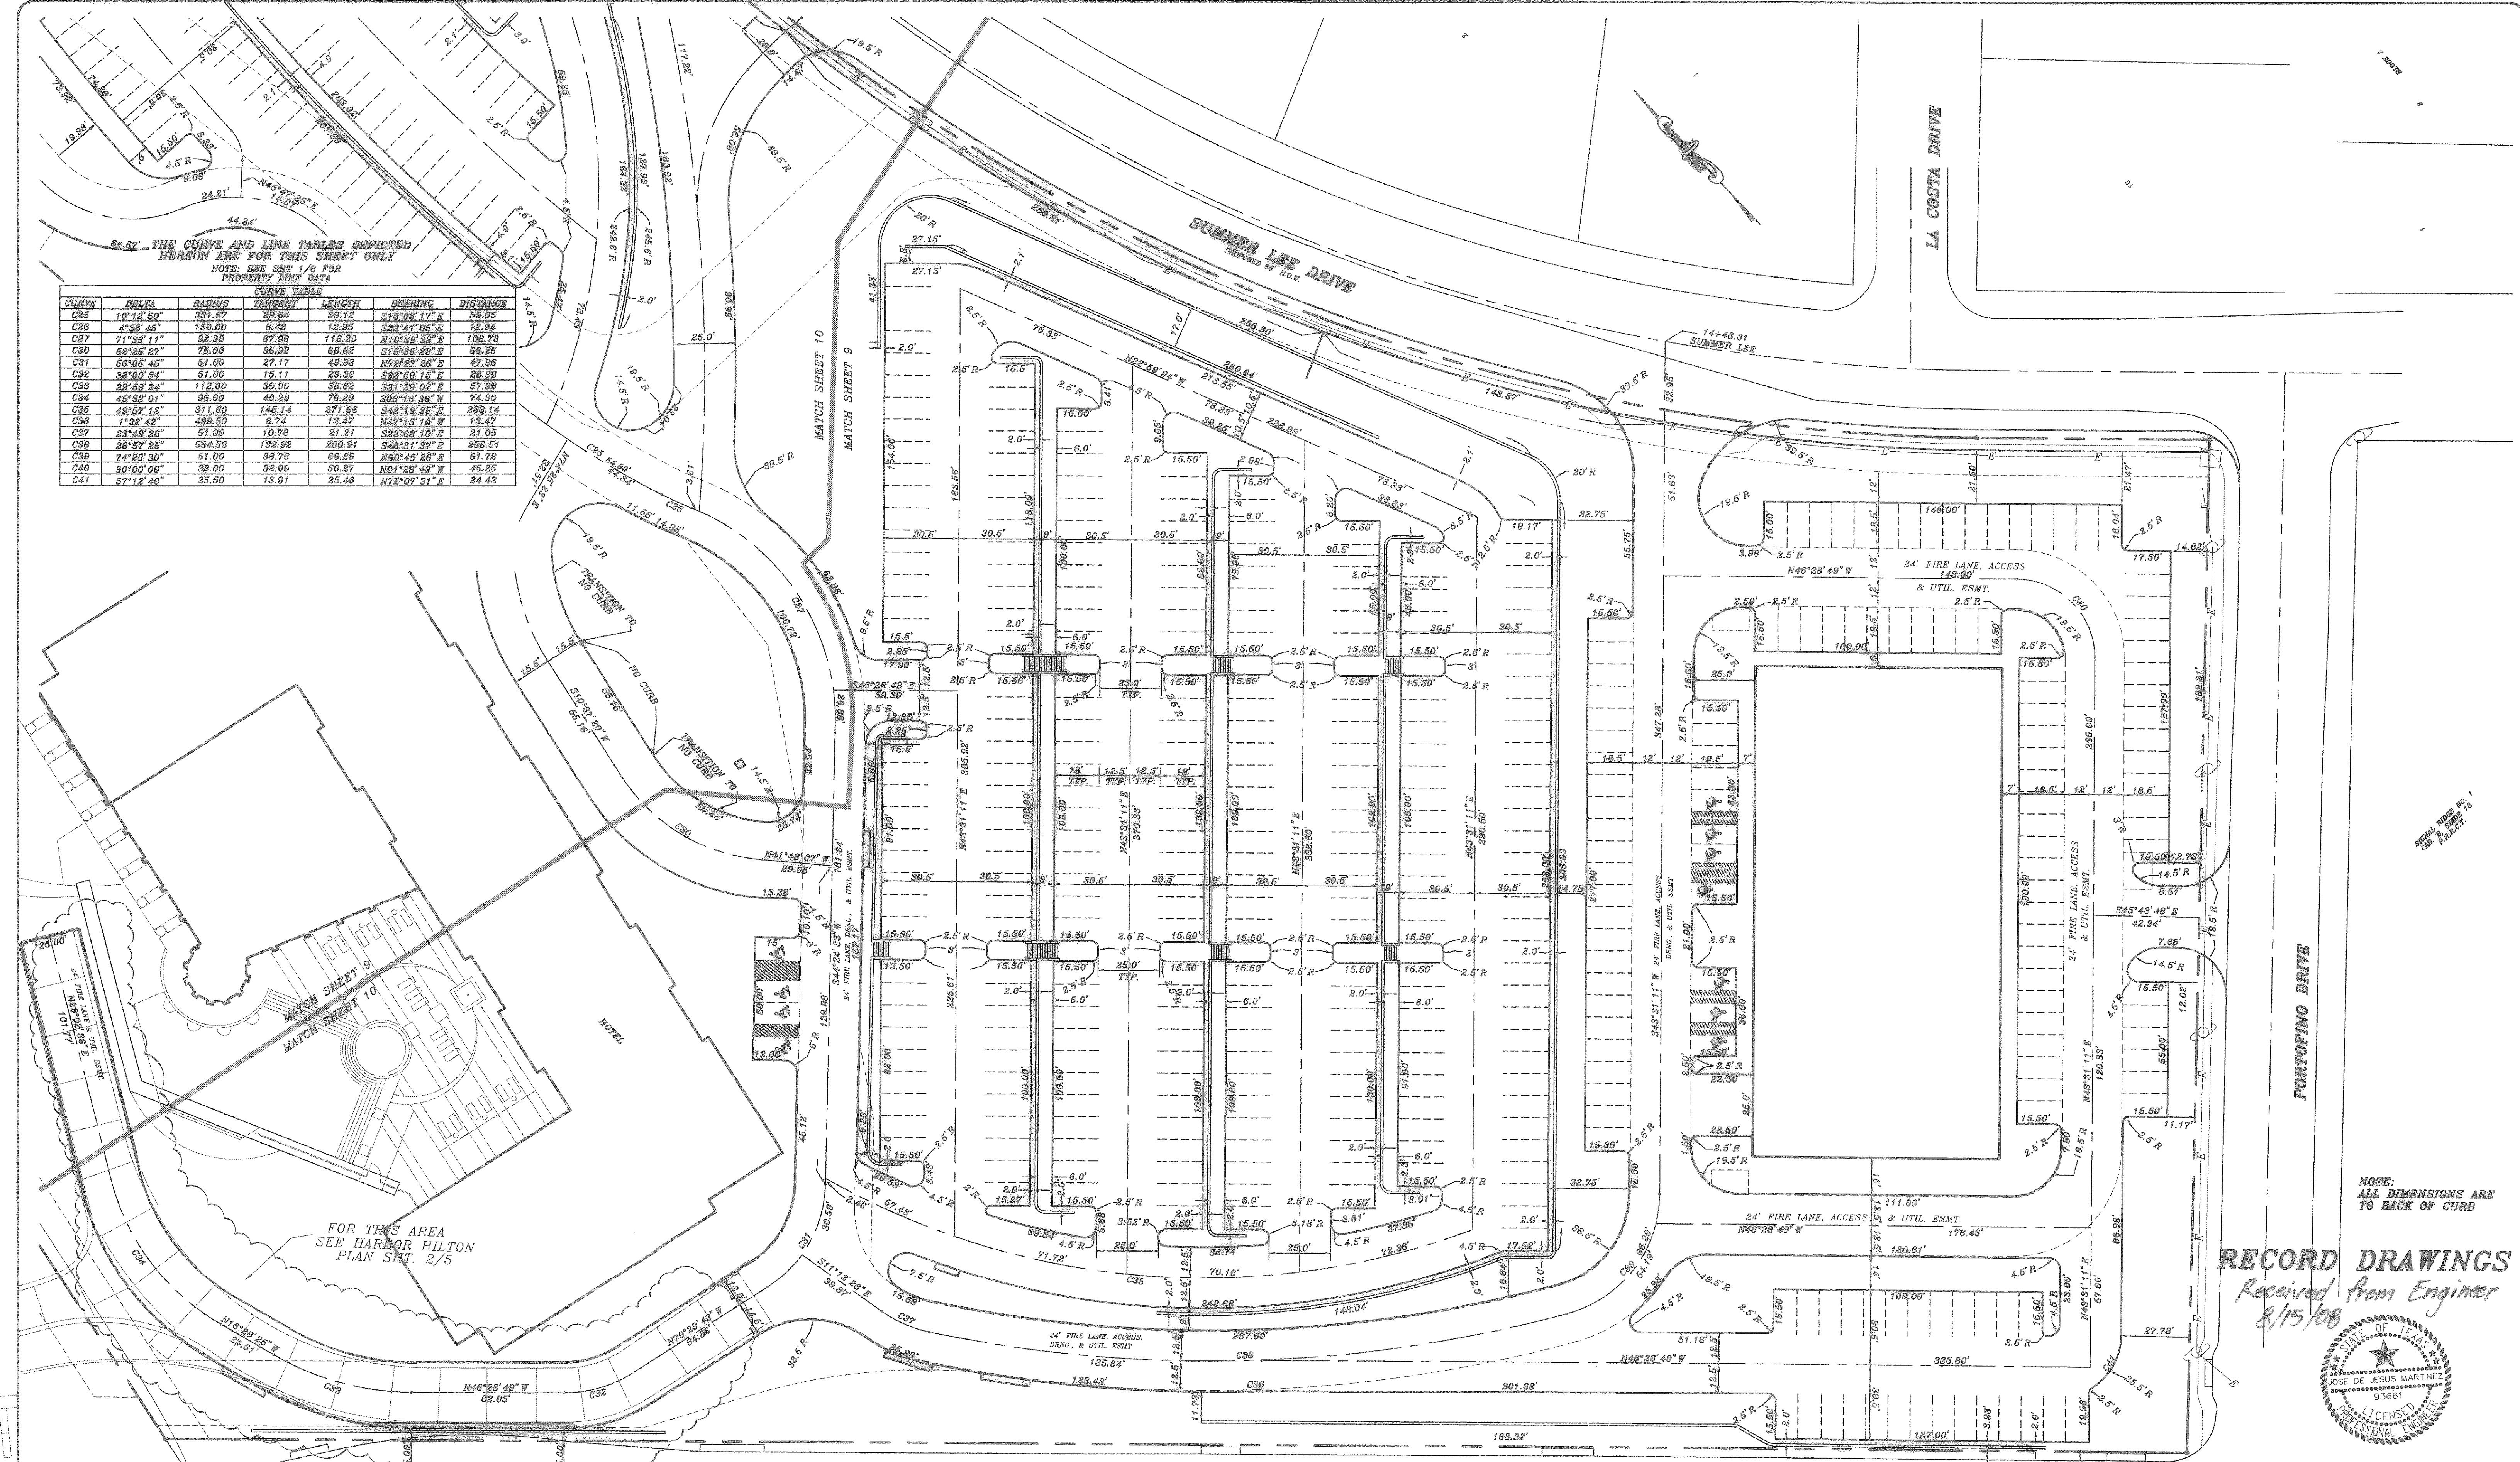


FOR THIS AREA
SEE HARBOR HILTON
PLAN SHT. 2/5

TYPICAL PARKING
AND FIRE LANE

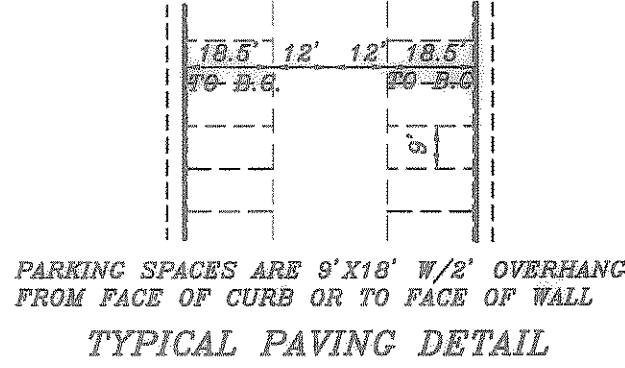

TYPICAL HANDICAP
PARKING

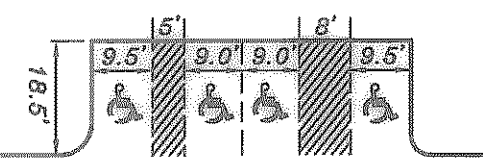

NOTE: FOR RETAINING WALL DETAILS & SECTIONS
SEE TBC PARTNERS PLANS.
FOR BUILDING DIMENSIONS AND LOCATIONS
SEE O'BRIEN AND ASSOCIATES ARCHITECTURAL PLANS.

RECORD DRAWINGS
Received From Engineer
8/15/08



R.O.W. DESIGNATION
VOL. 2011, PG. 178

REV. 5/9/04 REVISION DESCRIPTION 01380201		SOLID STRUCTURAL SOLUTIONS, INC. P.O. BOX 061800 MESQUITE, TX 75069-1800 PHONE: 817.417.8580 FAX: 817.888.5714		DIMENSION CONTROL PLAN THE HARBOR - ROCKWALL CITY OF ROCKWALL		SHEET NO. 10 26 JOB NO. 0136
DATE	SCALE	DESIGN	DRAWN			
3/22/04	1" = 30'	H.L.E.				