

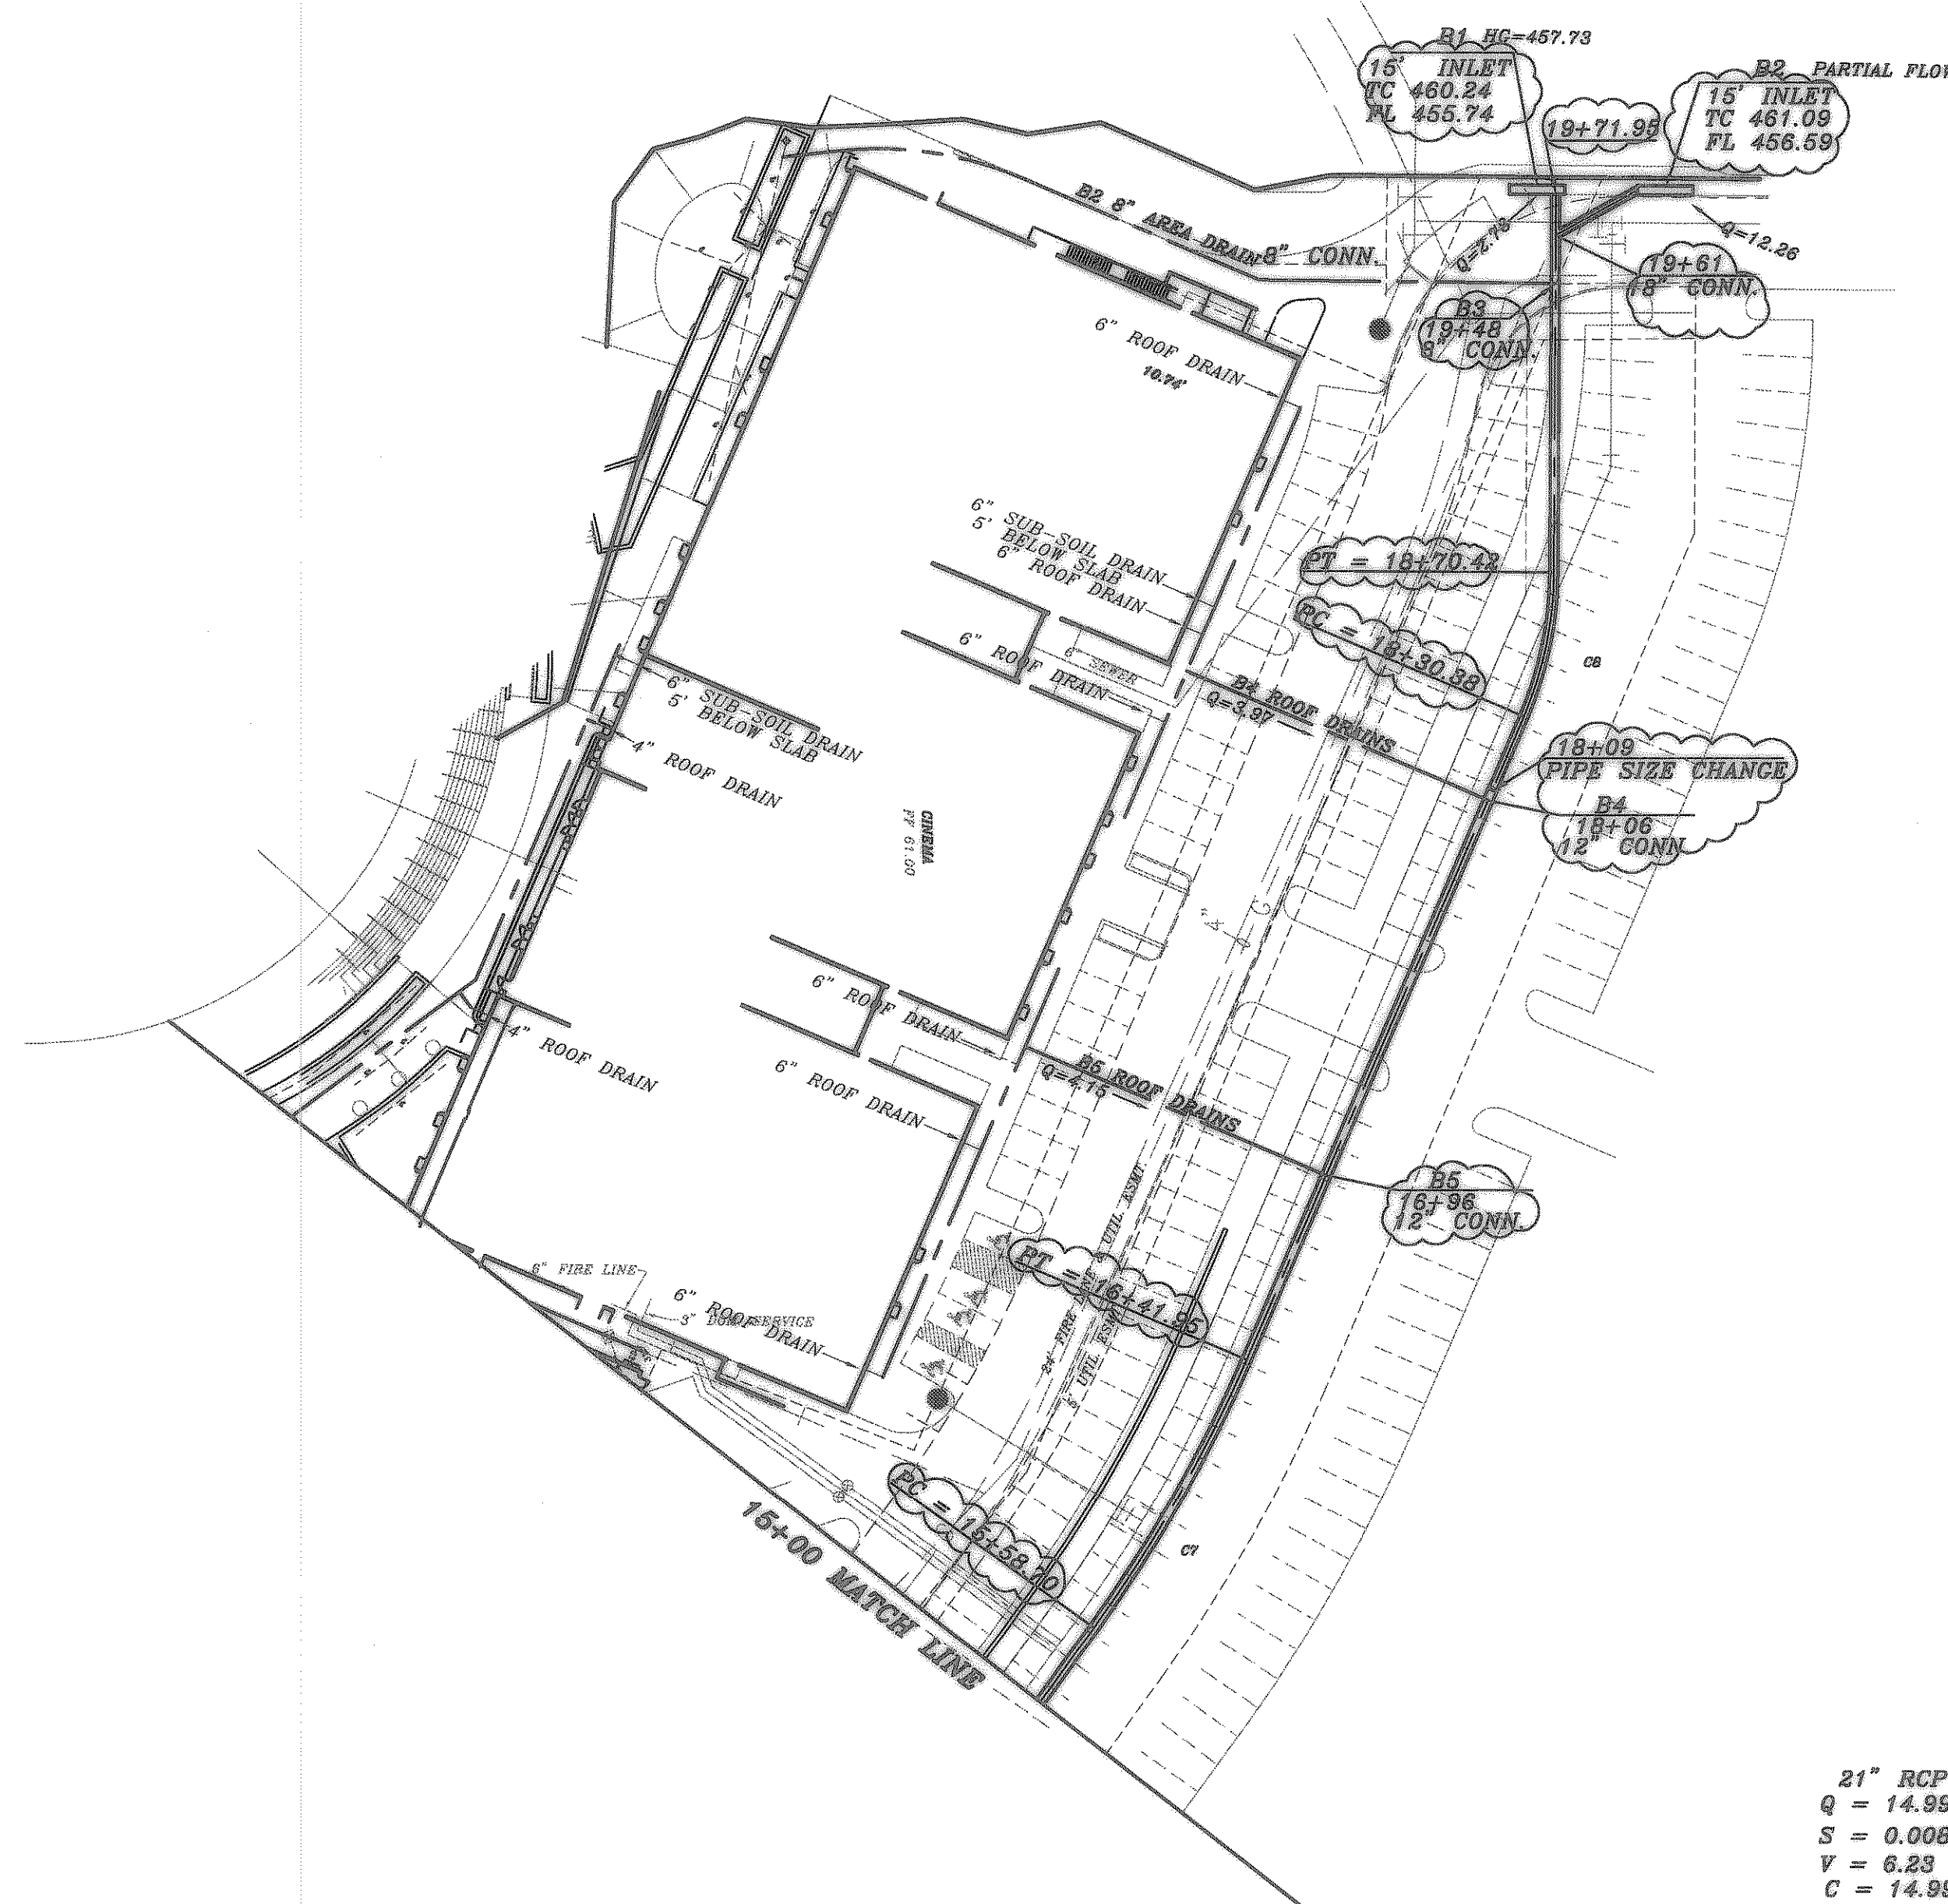


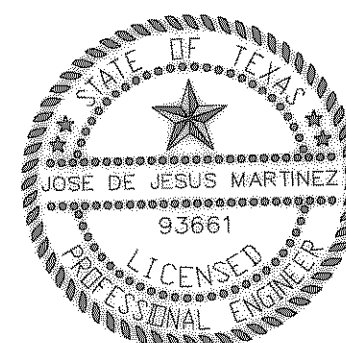

CURVE TABLE				
CURVE	DELTA	RADIUS	TANGENT	LENGTH
C7	12°30'26"	381.39	41.79	83.25
C8	22°56'39"	100.00	20.29	40.04

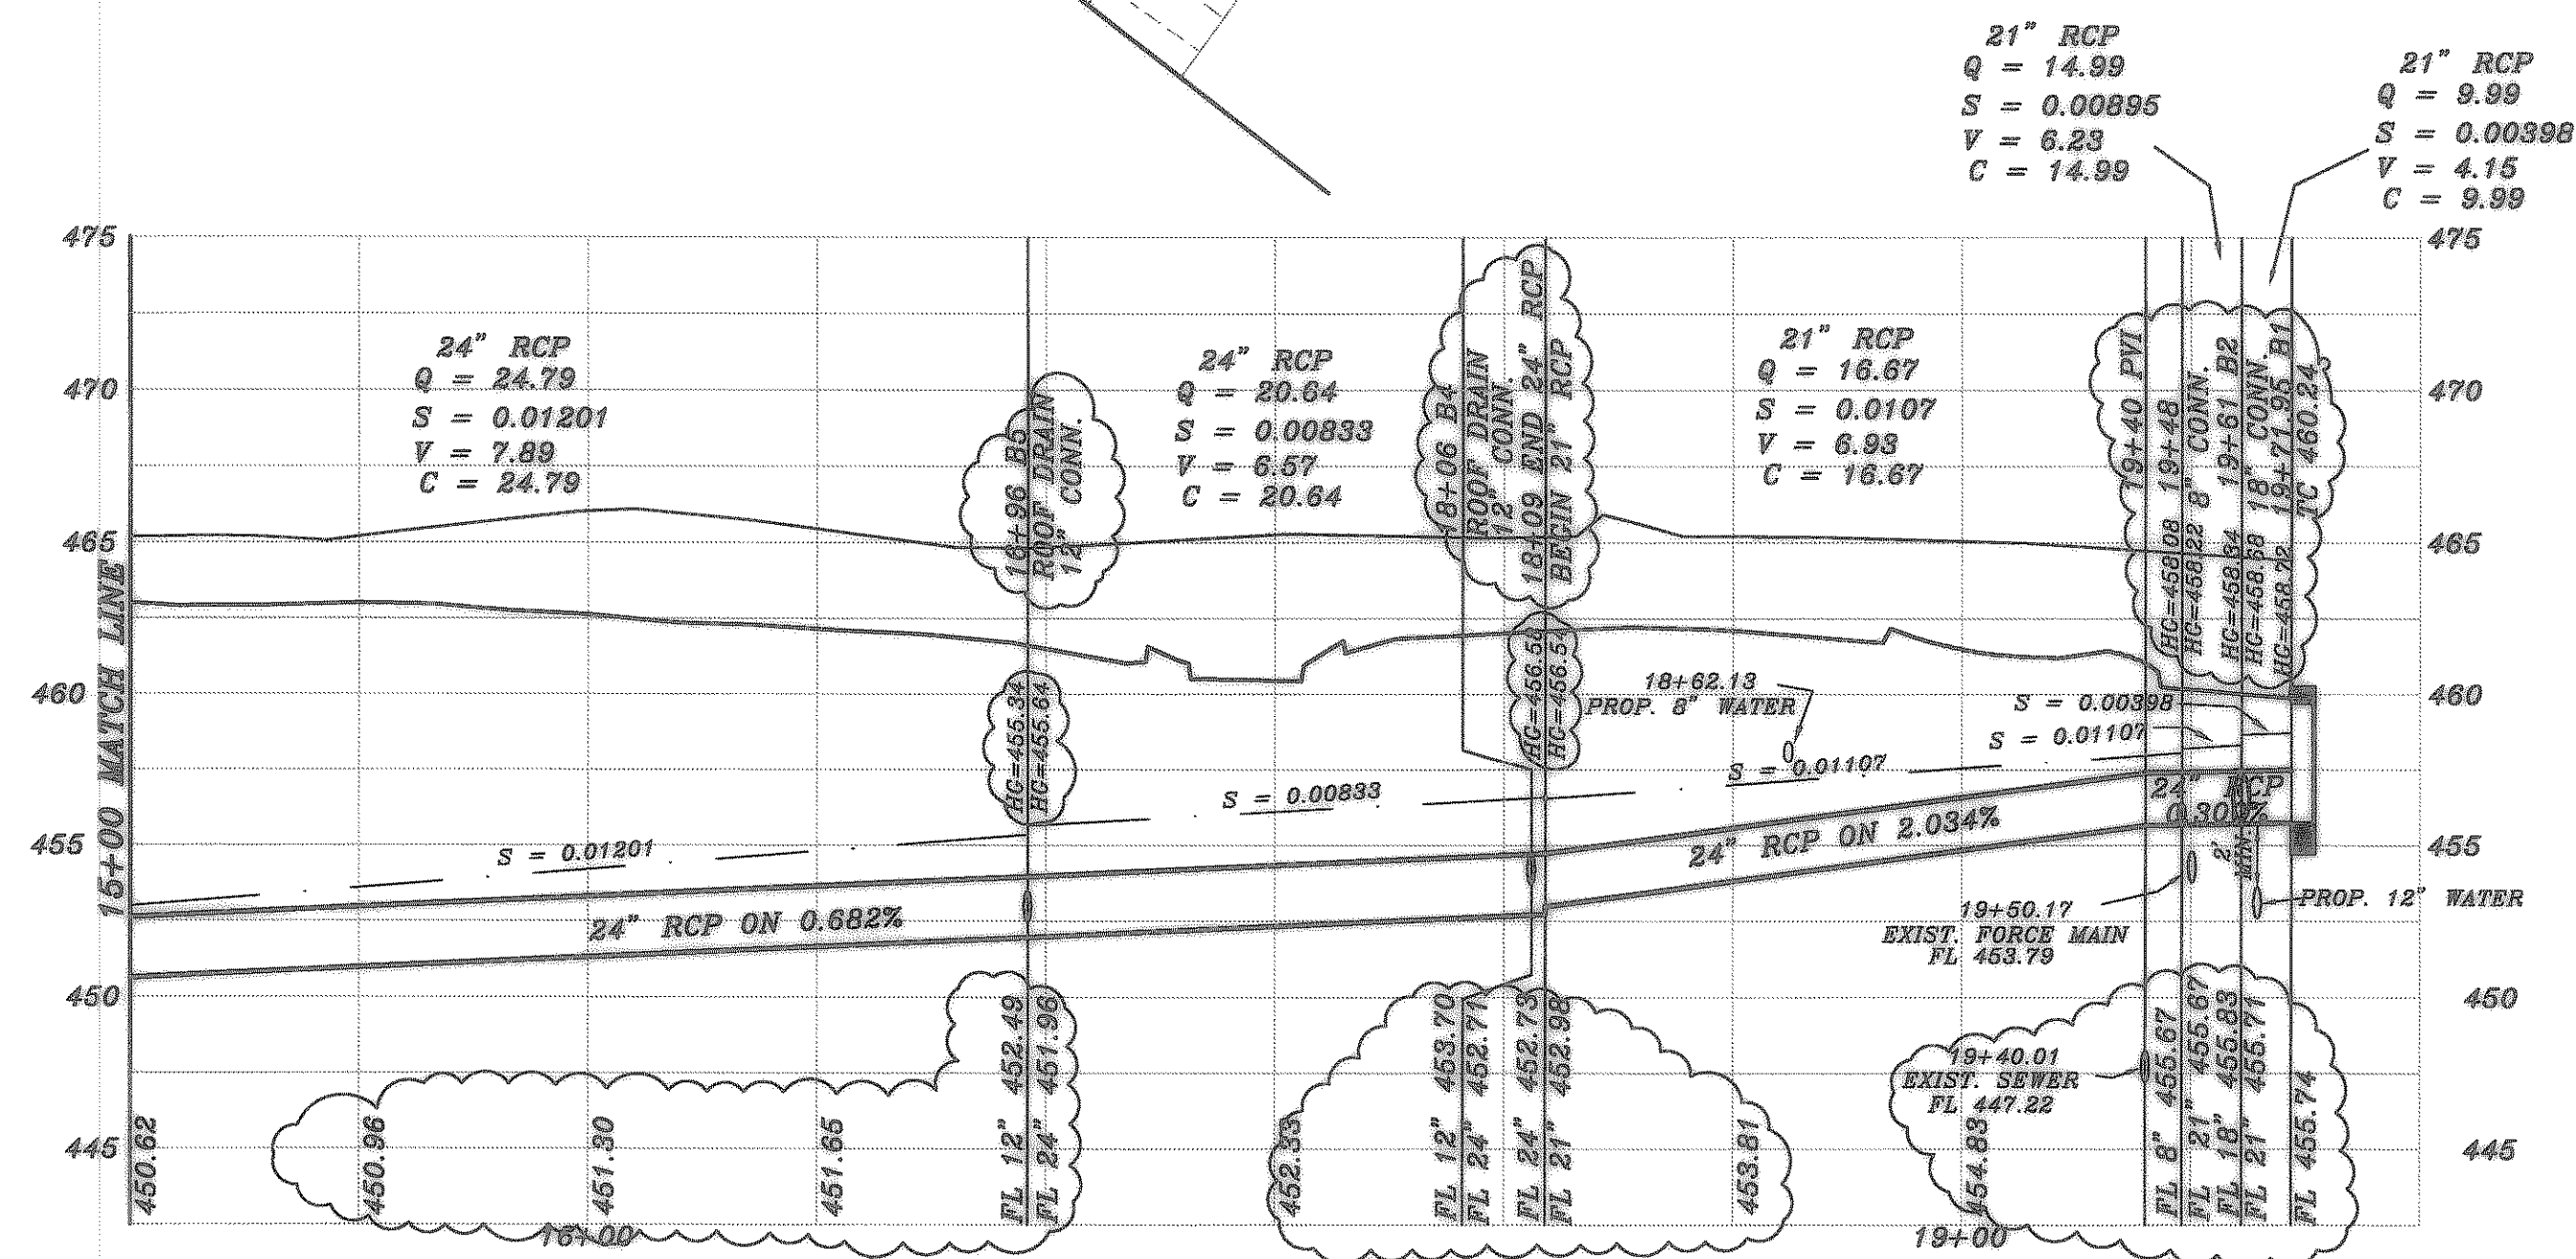

Received from Engineer
8/15/08
RECORD DRAWINGS

REV.		8/21/04	SOLID STRUCTURAL SOLUTIONS, INC. P.O. BOX 851830 MESQUITE, TX 75188-1830 PHONE: 214-417-5830 FAX: 972-288-5714			PROPOSED DRAINAGE			SHEET NO.	
REV.		5/18/04				17				
REV.		5/9/04				26				
REV.		4/15/04				JOB NO.				
REV.		3/19/04				0136				
REVISION DESCRIPTION			DATE	SCALE	DESIGN	DRAWN	LINE B			
0136CRD3				1" = 40'	H.L.E.		THE HARBOR - ROCKWALL			
				1" = 8'			CITY OF ROCKWALL			