
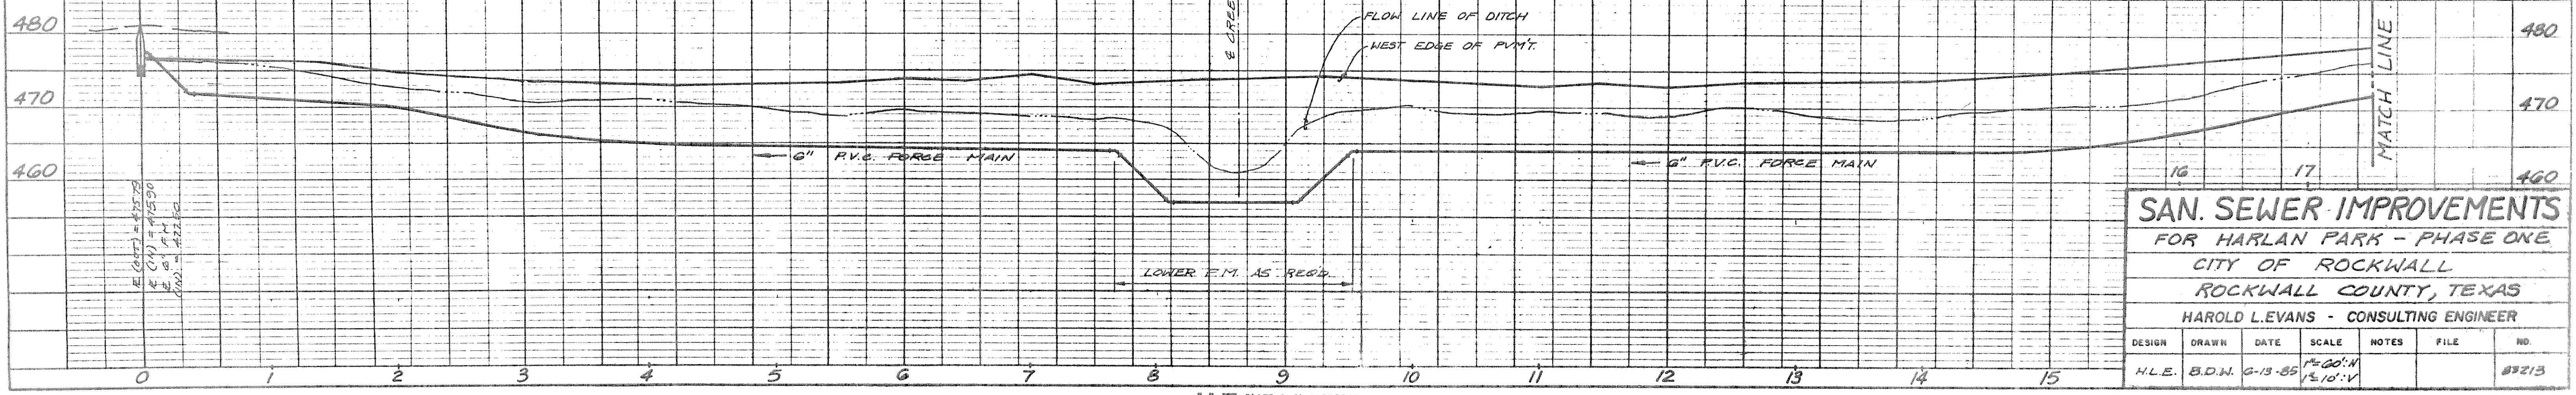
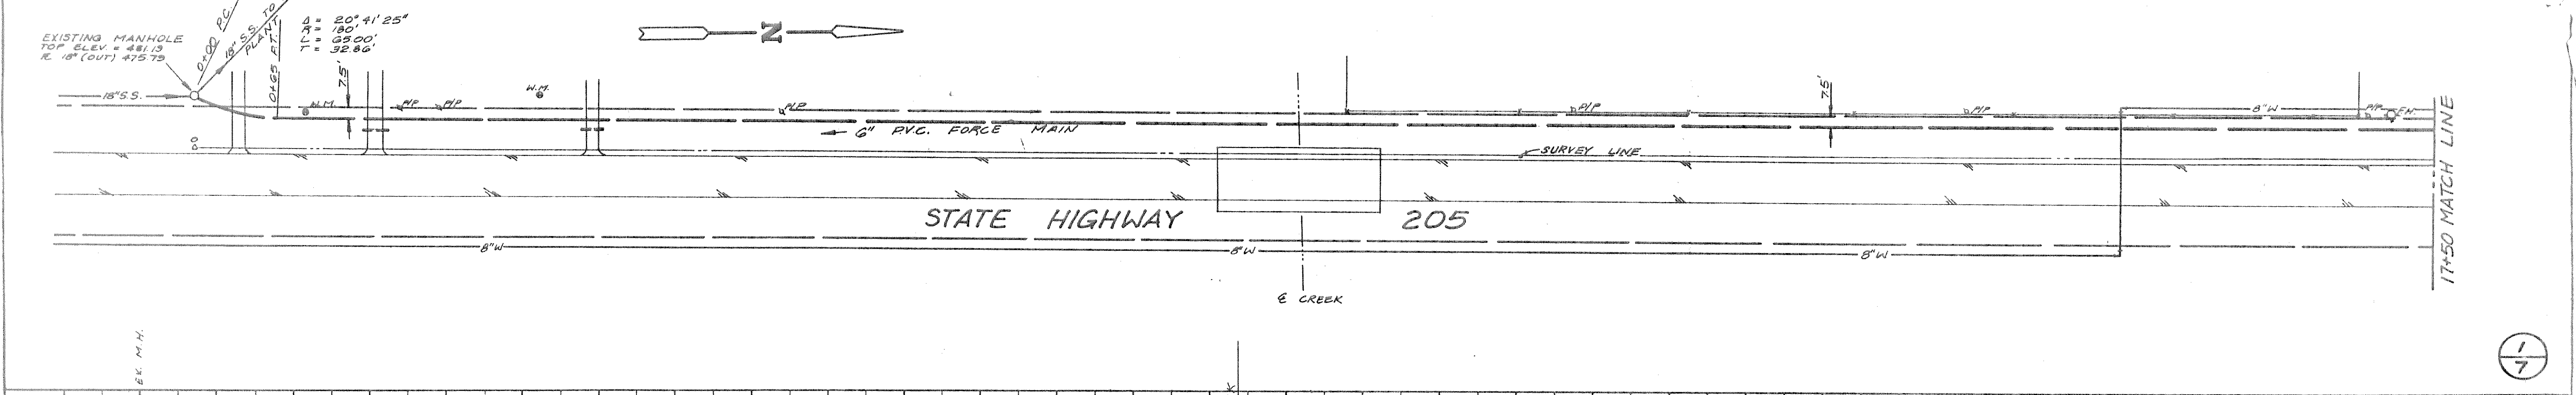
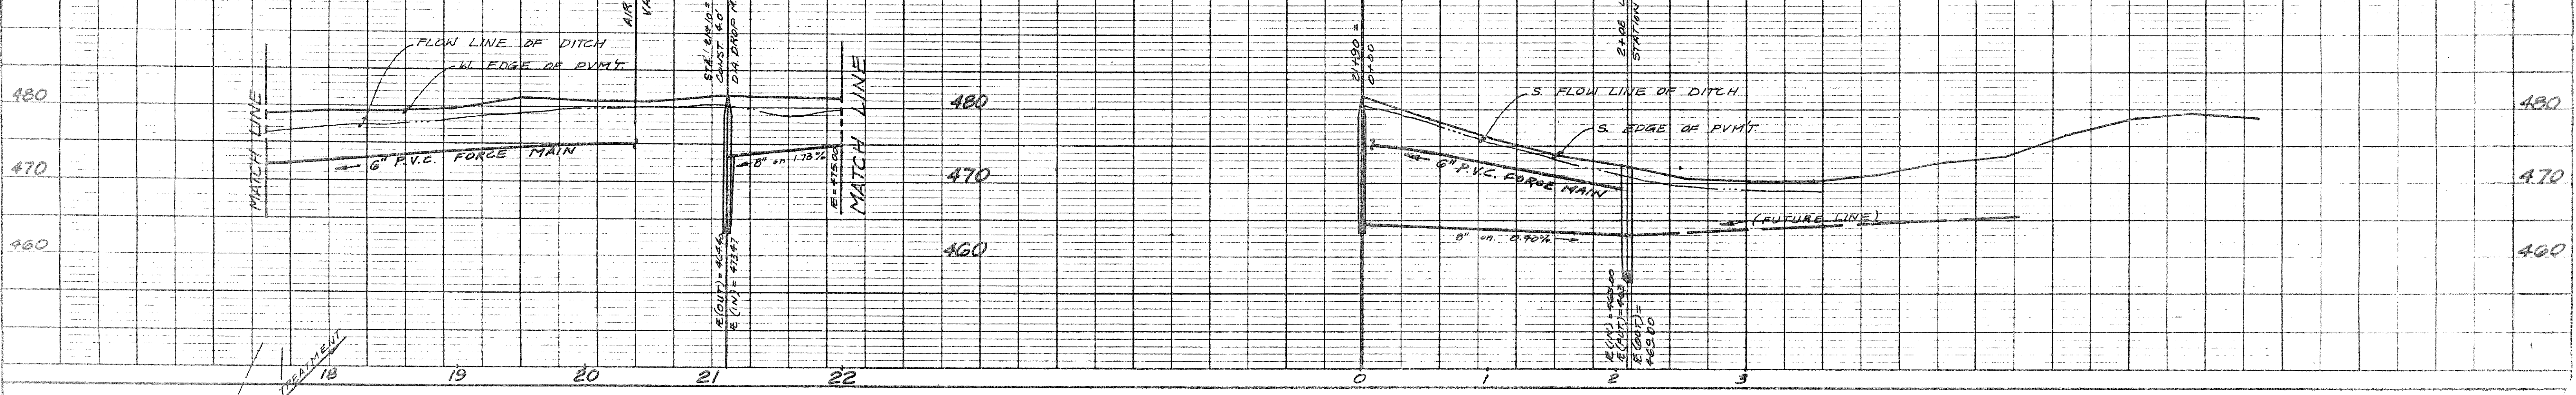


PLAN  
 REVISIONS  
 NO. 1  
 DATE  
 DRAWN BY  
 CHECKED BY  
 DATE  
 NO. 1  
 DATE

PROFILE  
 REVISIONS  
 NO. 1  
 DATE  
 DRAWN BY  
 CHECKED BY  
 DATE  
 NO. 1  
 DATE

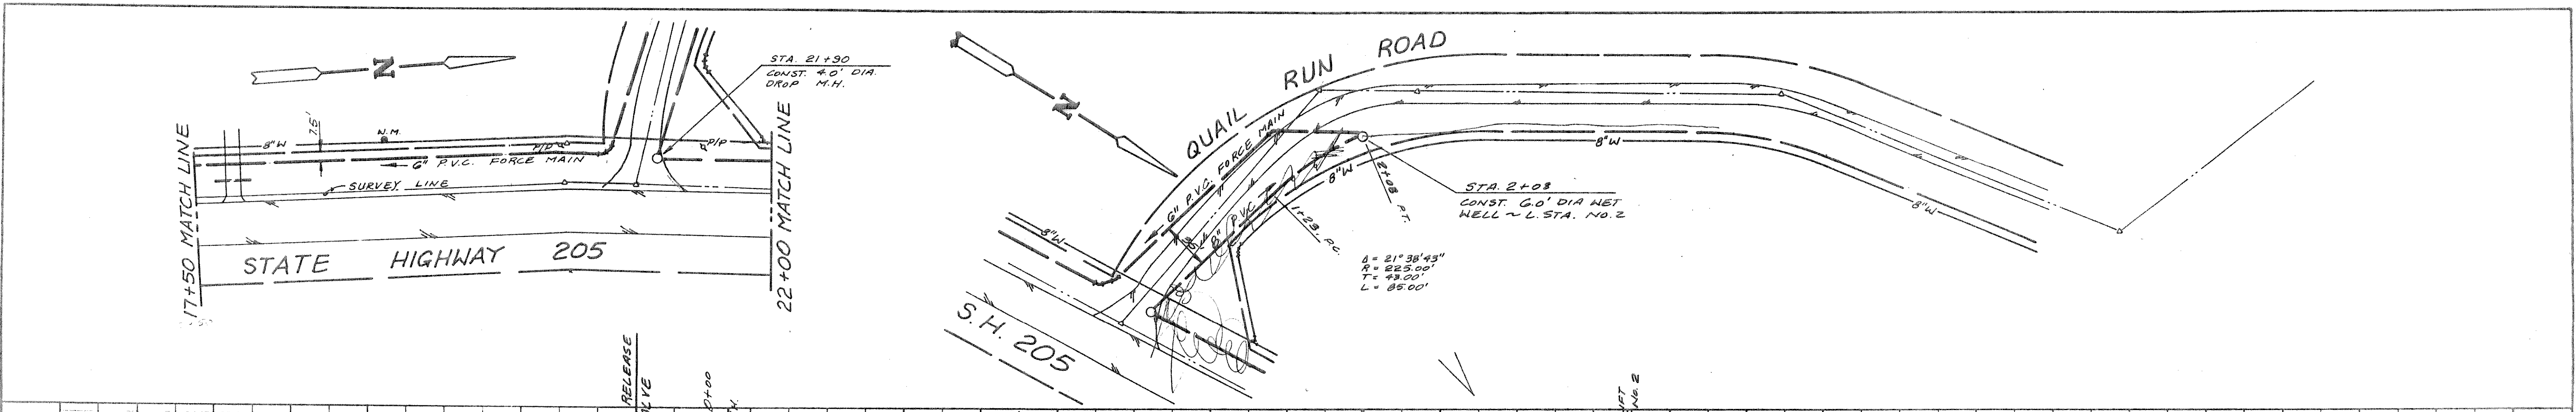

<b>SAN. SEWER IMPROVEMENTS</b>						
FOR HARLAN PARK - PHASE ONE						
CITY OF ROCKWALL						
ROCKWALL COUNTY, TEXAS						
HAROLD L. EVANS - CONSULTING ENGINEER						
DESIGN	DRAWN	DATE	SCALE	NOTES	FILE	NO.
H.L.E.	B.D.W.	6-13-85	1"=60' H 1/8"=10' V			89213