
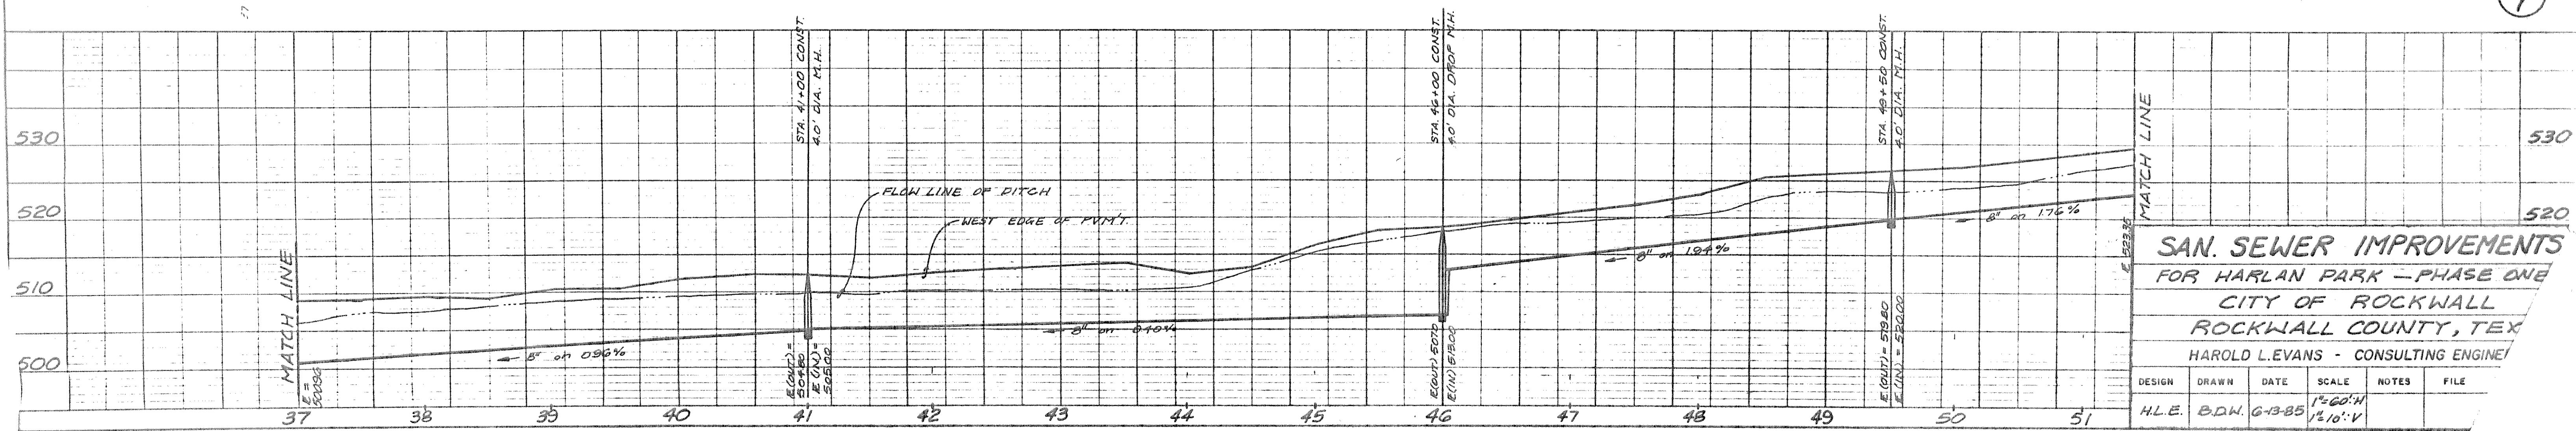
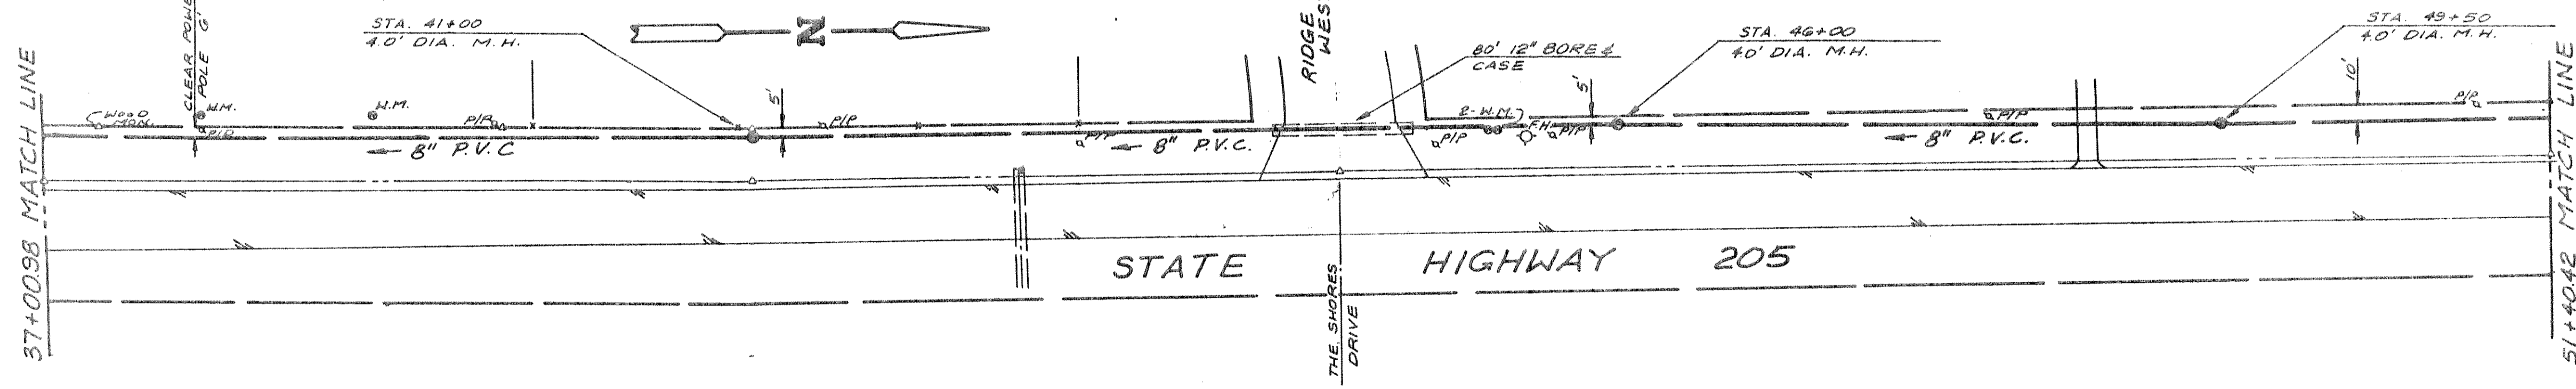
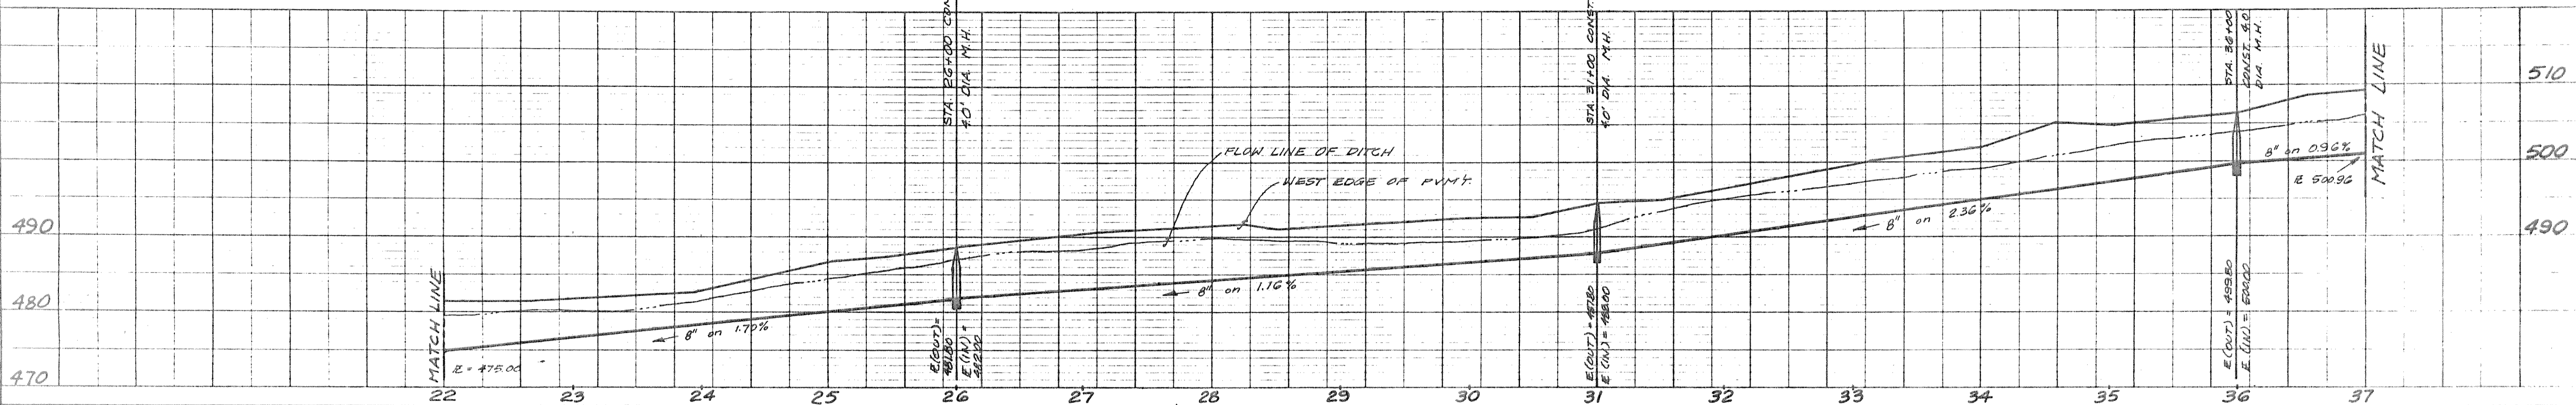


PLAN  
 DATE: 6-13-85  
 SCALE: 1" = 40'

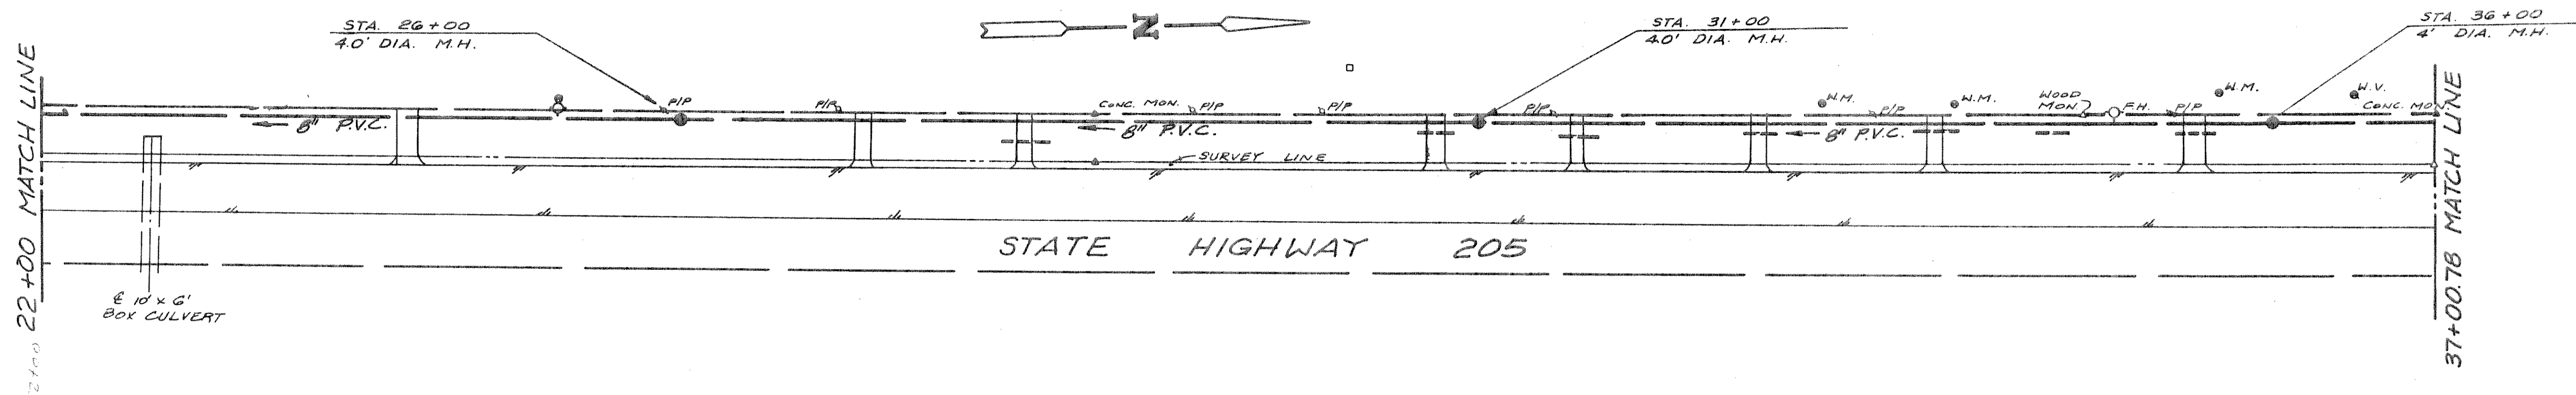

**SAN. SEWER IMPROVEMENTS**  
 FOR HARLAN PARK - PHASE ONE  
 CITY OF ROCKWALL  
 ROCKWALL COUNTY, TEX  
 HAROLD L. EVANS - CONSULTING ENGINEER

DESIGN	DRAWN	DATE	SCALE	NOTES	FILE
H.L.E.	B.D.W.	6-13-85	1" = 40' 1/2" = 10'		