

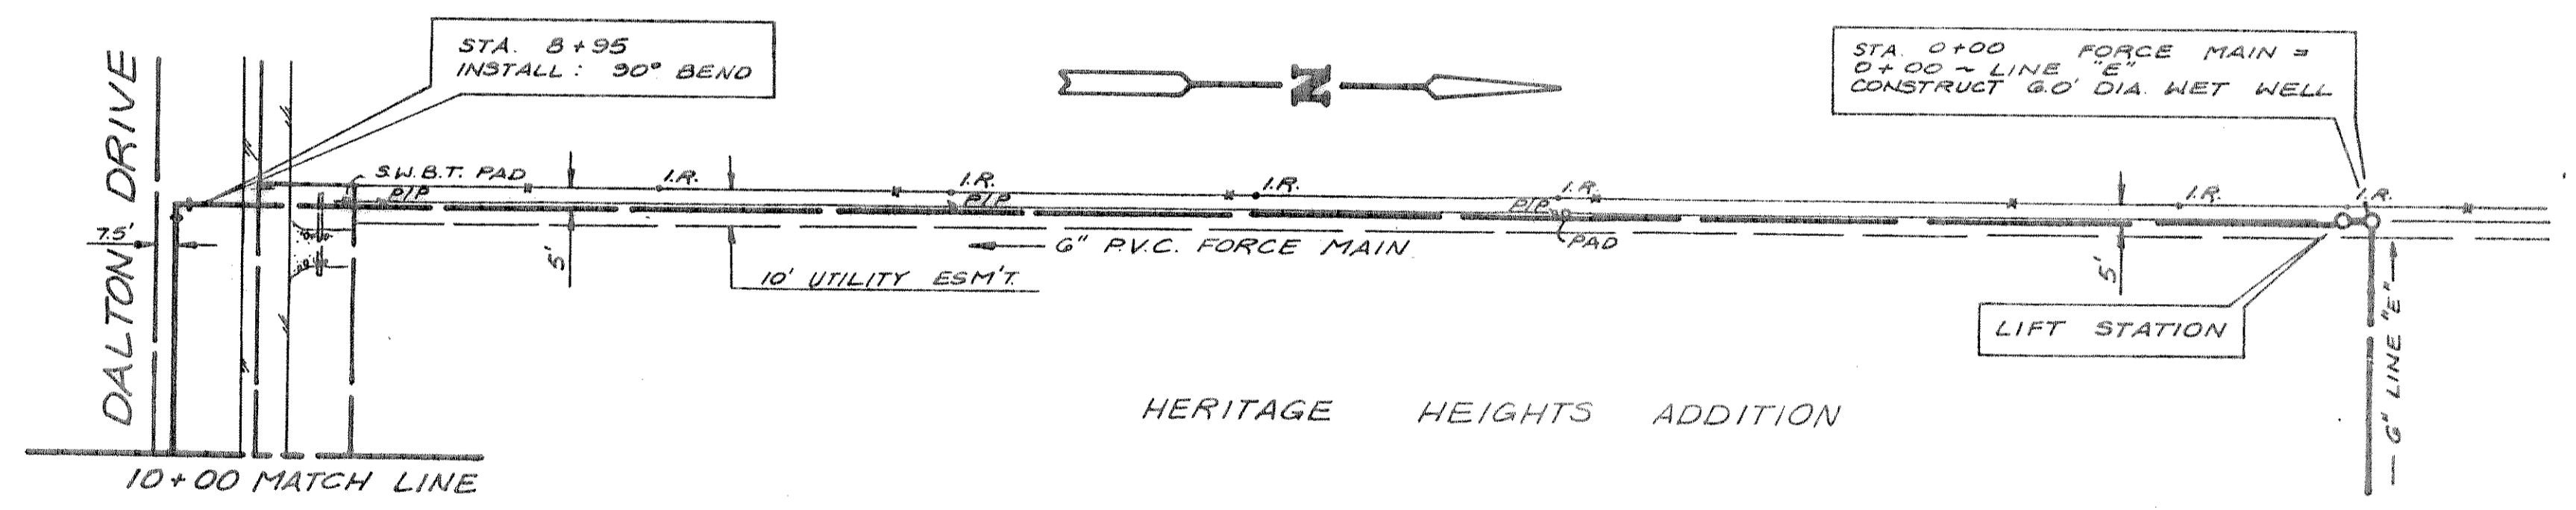


PLAN
 NOTE BOOK NO. 11
 DATE 6-13-88
 BY B.D.W.
 CHECKED BY H.L.E.
 NO. 11

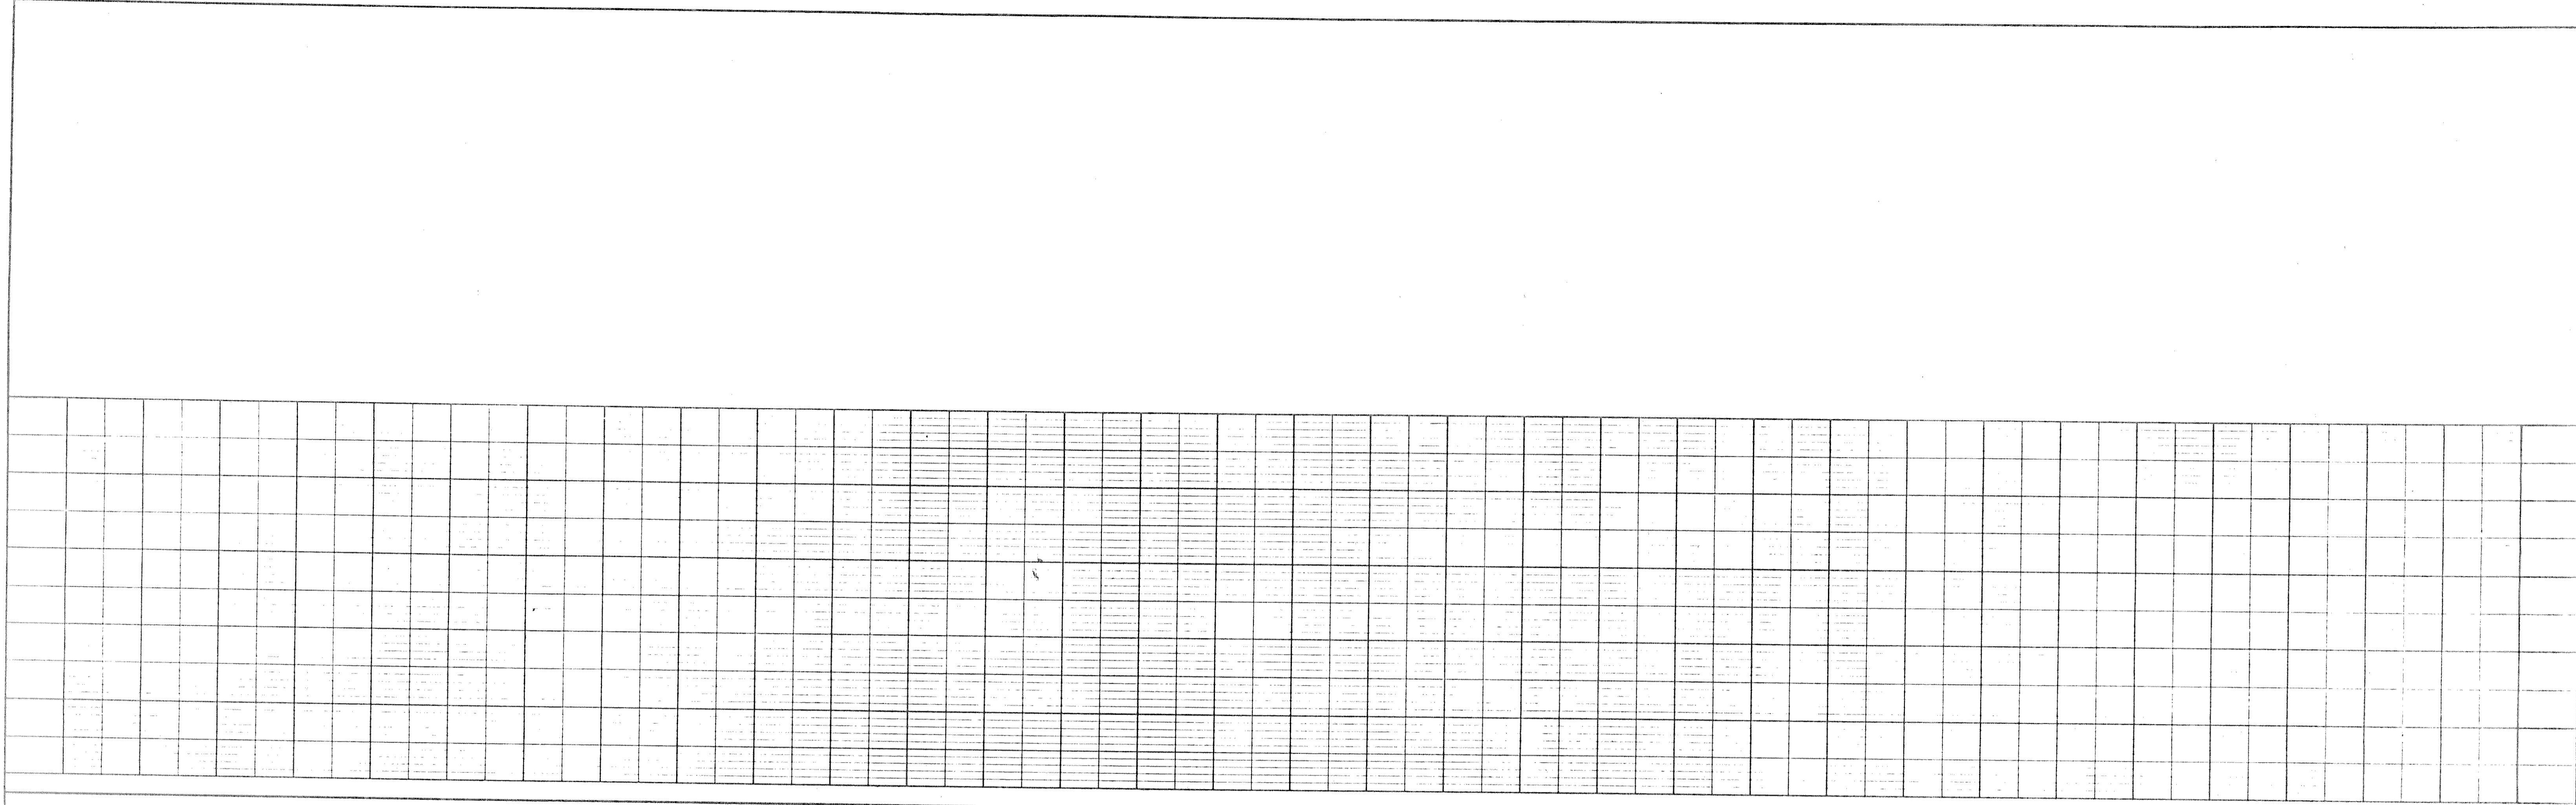

PROFILE
 NOTE BOOK NO. 11
 DATE 6-13-88
 BY B.D.W.
 CHECKED BY H.L.E.
 NO. 11

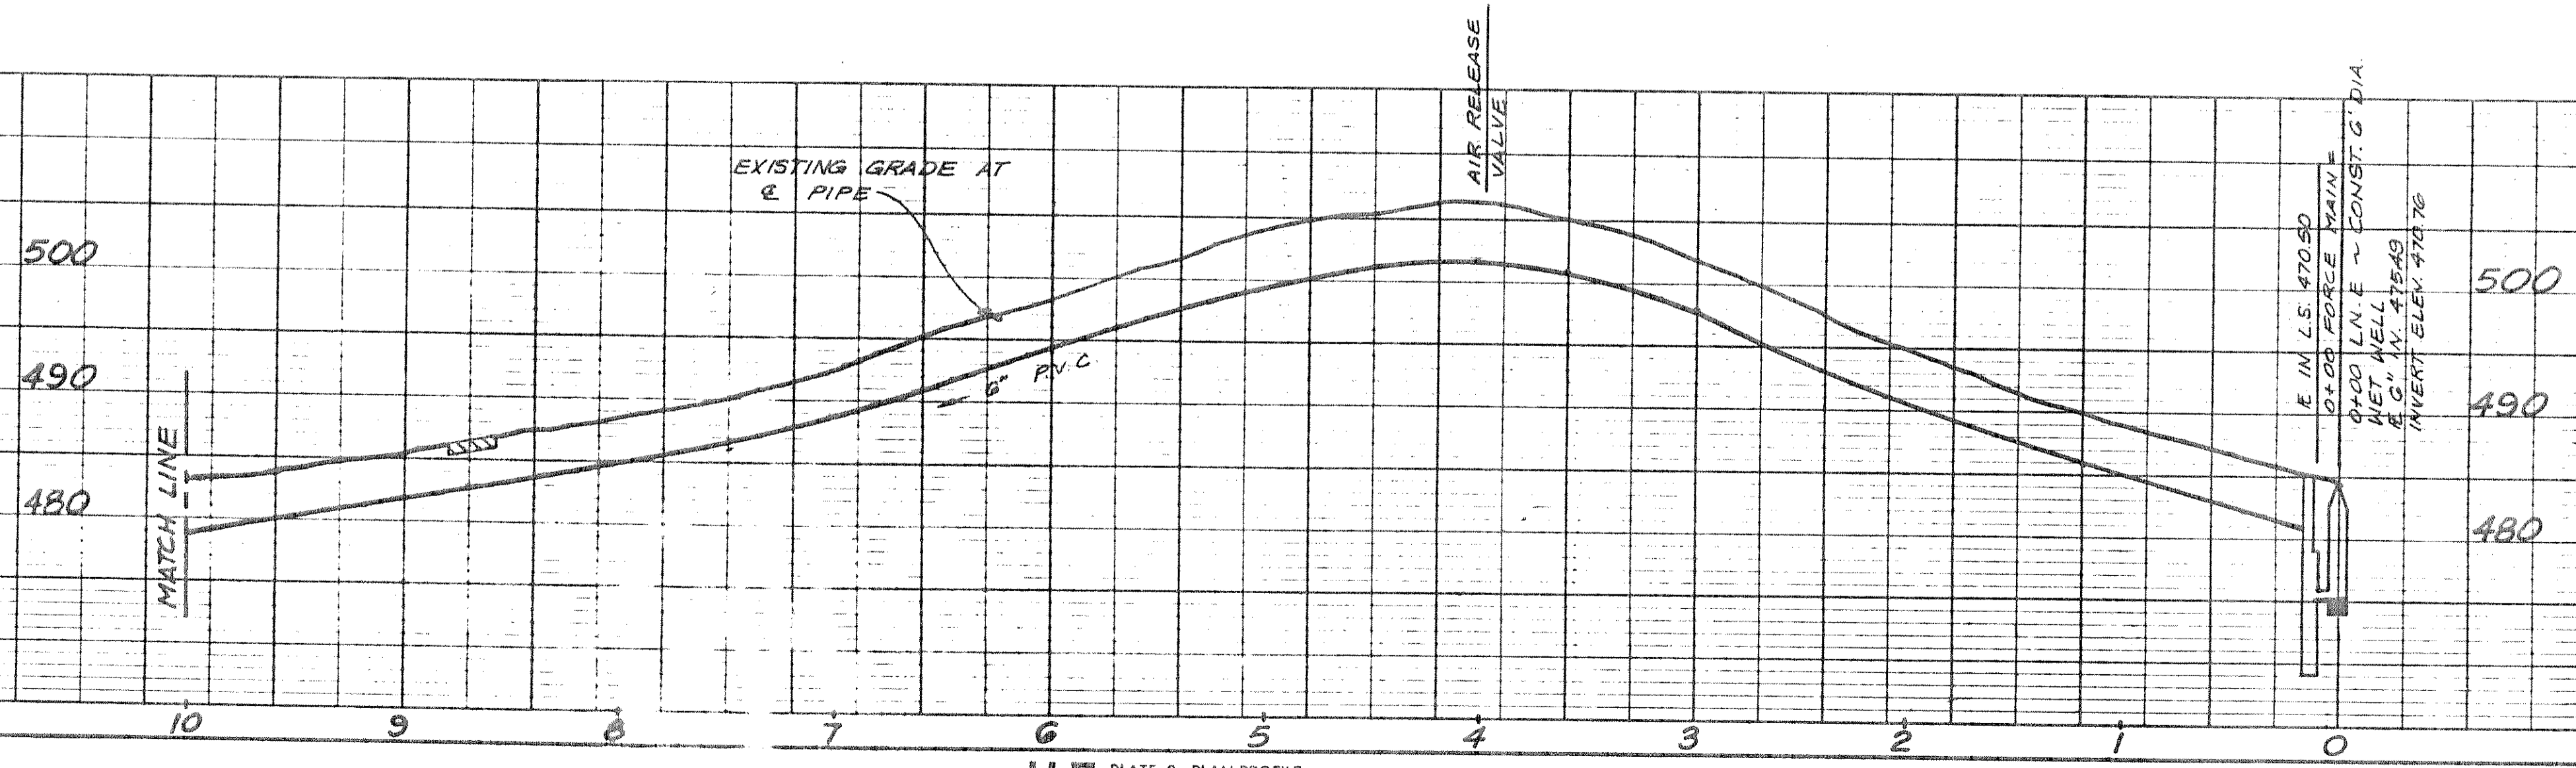

SAN. SEWER IMPROVEMENTS						
FOR HARLAN PARK - PHASE ONE						
CITY OF ROCKWALL						
ROCKWALL COUNTY, TEXAS						
HAROLD L. EVANS - CONSULTING ENGINEER						
DESIGN	DRAWN	DATE	SCALE	NOTES	FILE	NO.
H.L.E.	B.D.W.	6-13-88	1"=60'H 1"=10'V			83213