

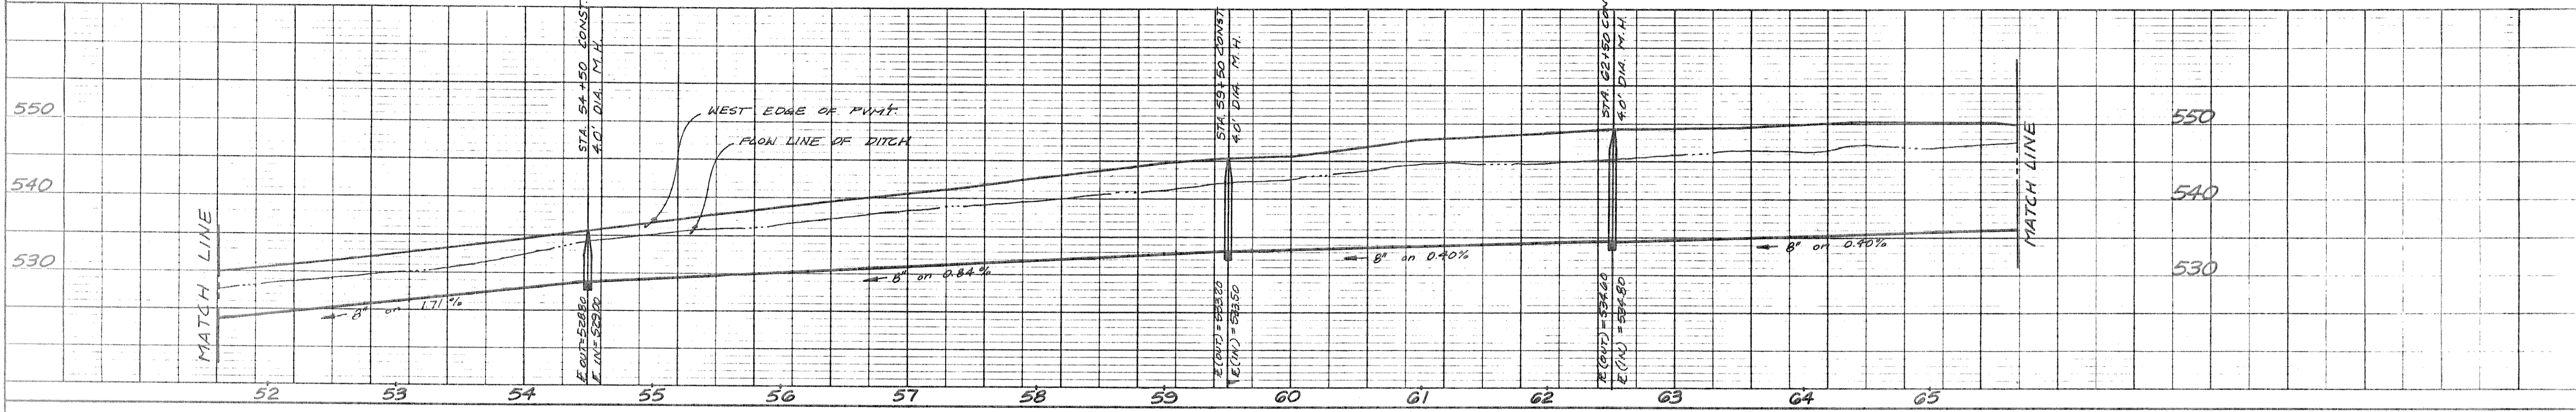
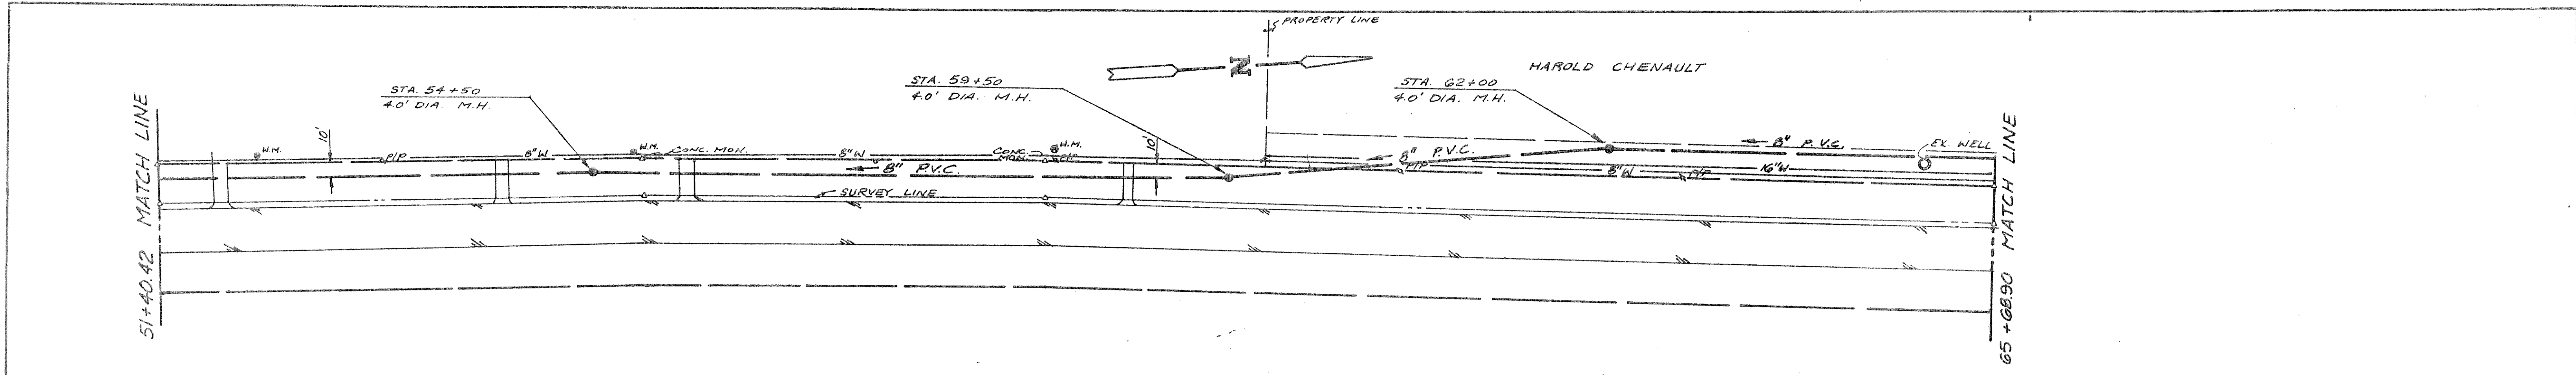


PLAN
 NOTE BOOK NO. 111111
 CHECKED BY: [Signature]
 DATE: [Date]

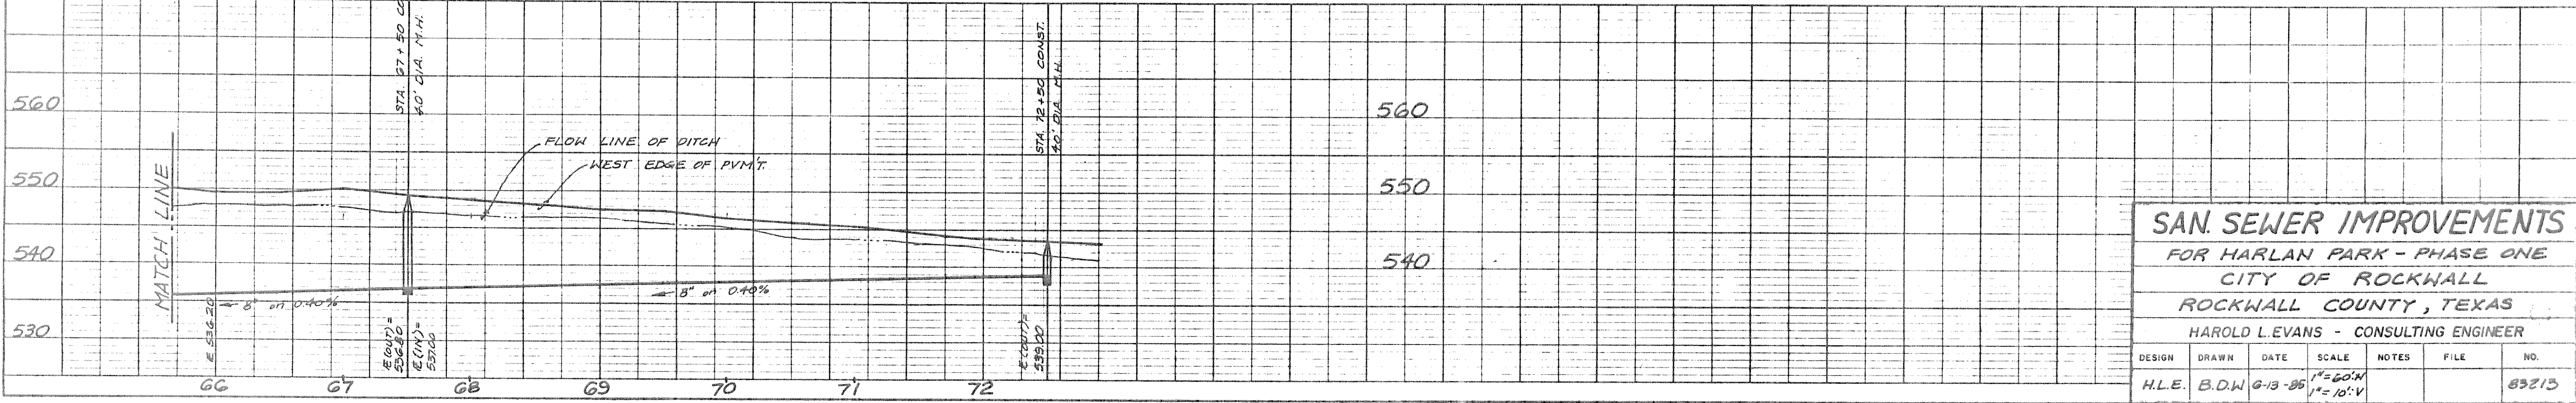

PROFILE
 NOTE BOOK NO. 111111
 CHECKED BY: [Signature]
 DATE: [Date]

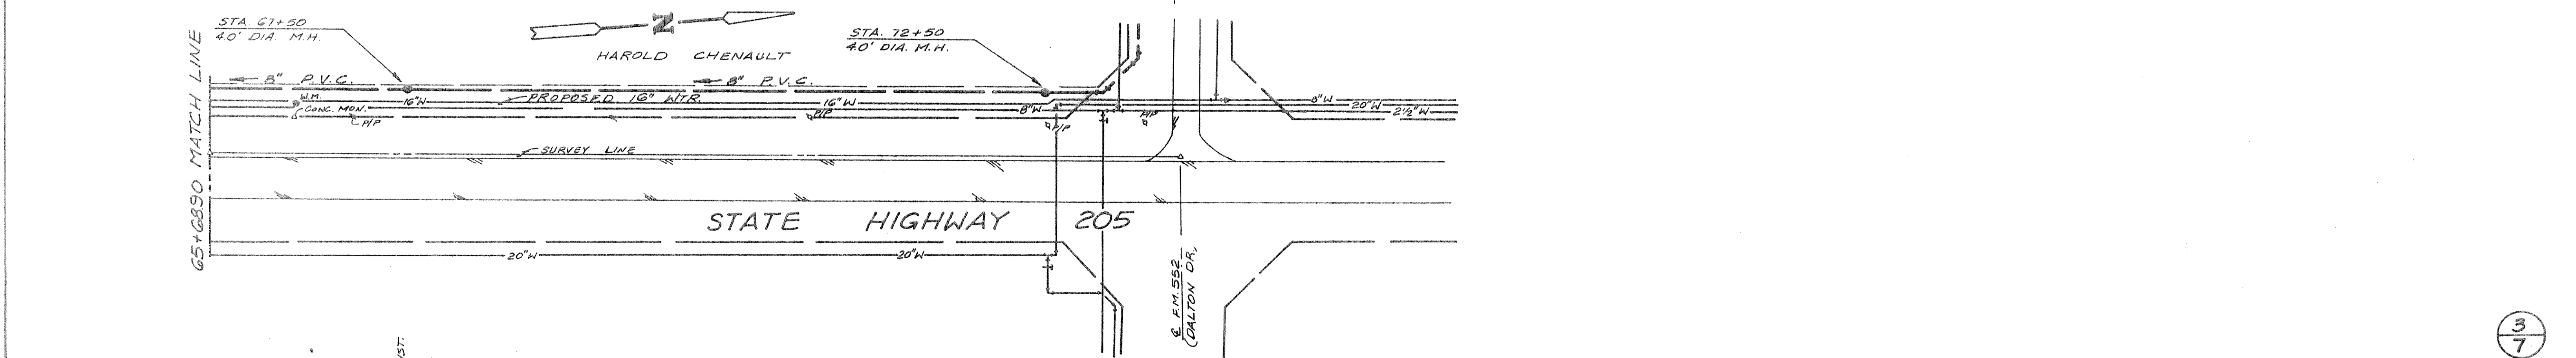

3
7

SAN SEWER IMPROVEMENTS
 FOR HARLAN PARK - PHASE ONE
 CITY OF ROCKWALL
 ROCKWALL COUNTY, TEXAS

HAROLD L. EVANS - CONSULTING ENGINEER

DESIGN	DRAWN	DATE	SCALE	NOTES	FILE	NO.
H.L.E.	B.D.W.	6-13-85	1" = 60' H 1" = 10' V			83213