

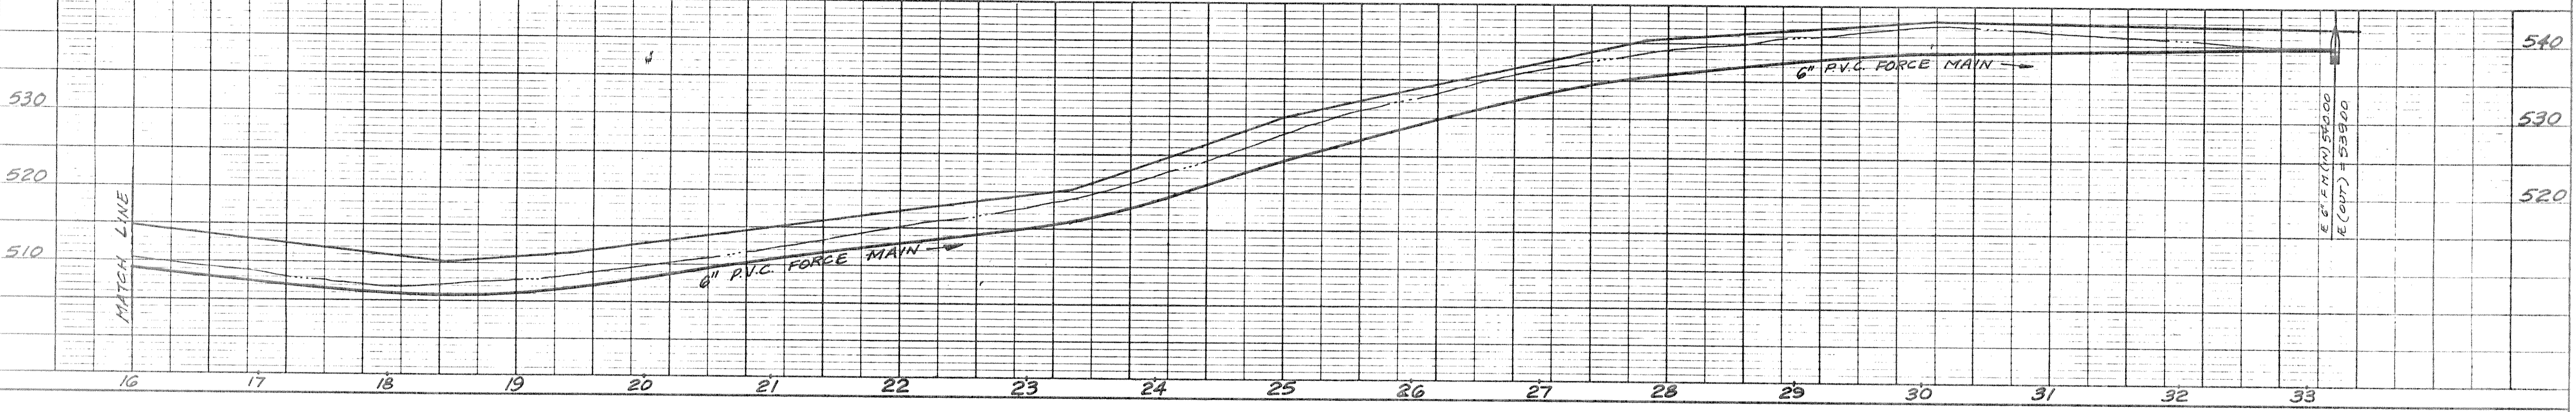
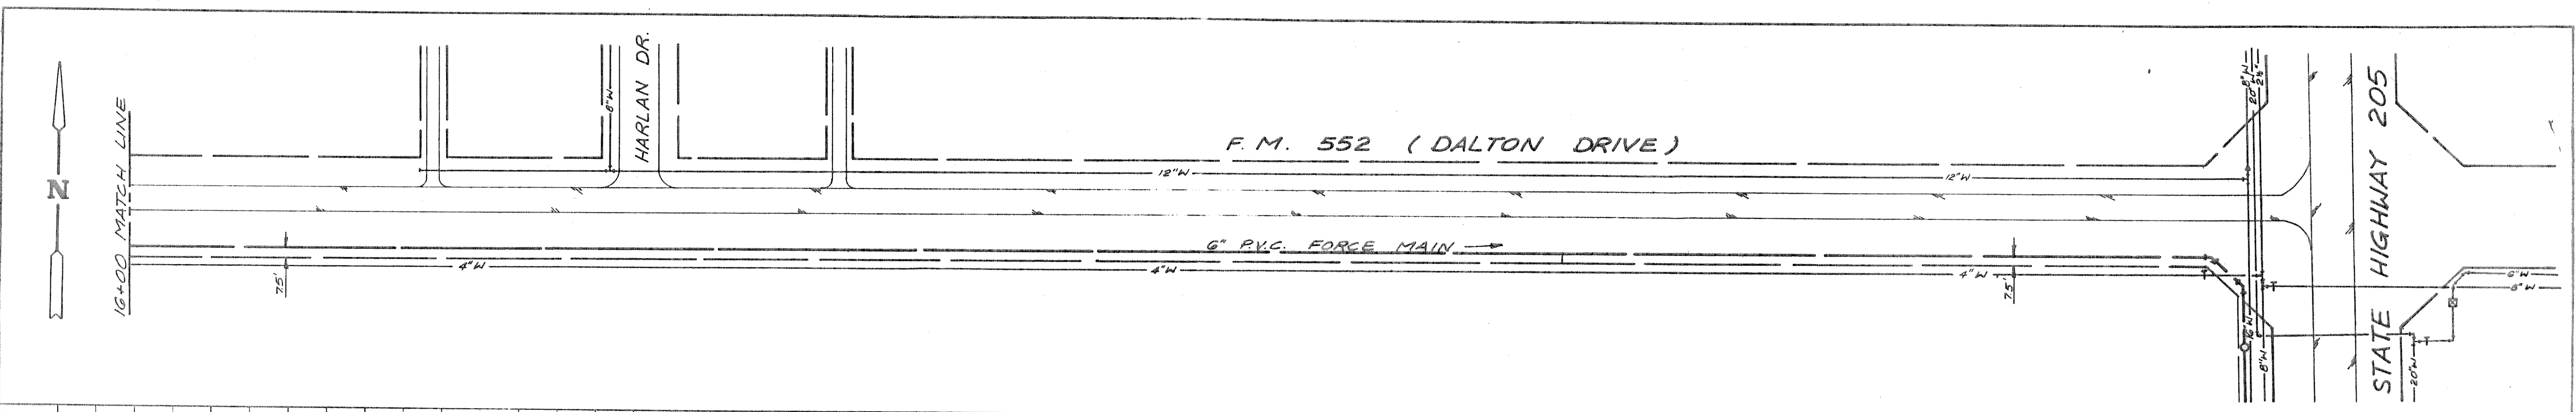


PLAN
 DATE
 NO.
 NOTE BOOK IN CHARGE CHECKED
 BY: CT. WAY CHECKED

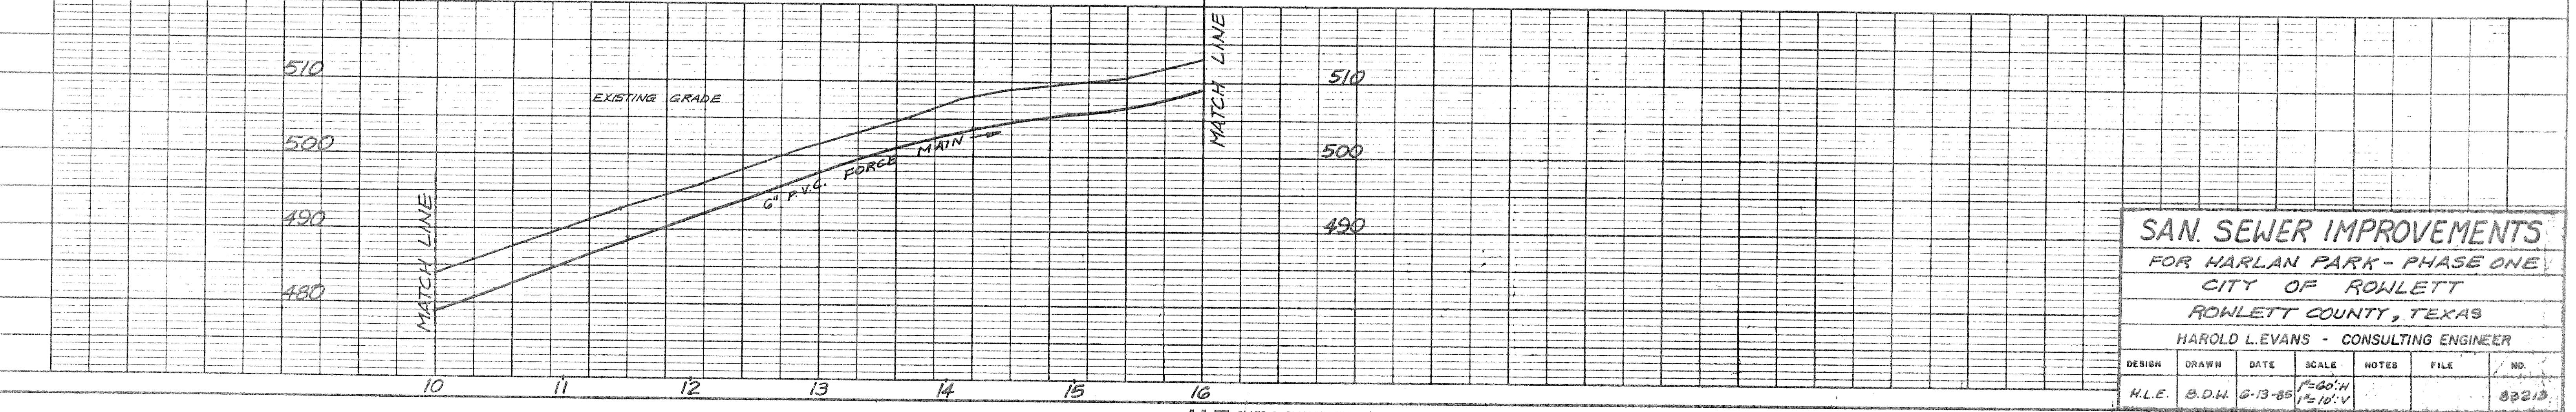

PROFILE
 DATE
 NO.
 NOTE BOOK IN CHARGE CHECKED
 BY: CT. WAY CHECKED

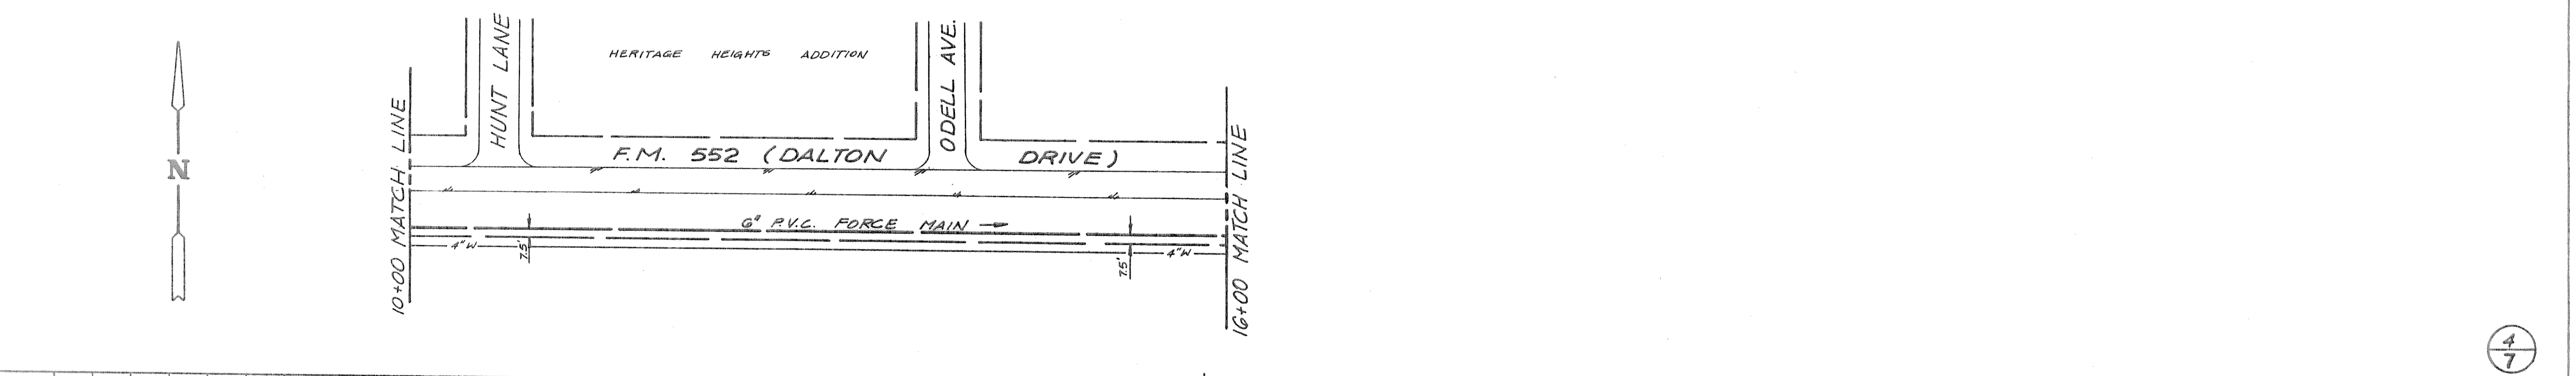

SAN. SEWER IMPROVEMENTS						
FOR HARLAN PARK - PHASE ONE						
CITY OF ROWLETT						
ROWLETT COUNTY, TEXAS						
HAROLD L. EVANS - CONSULTING ENGINEER						
DESIGN	DRAWN	DATE	SCALE	NOTES	FILE	NO.
H.L.E.	B.O.W.	6-13-85	1"=60' H 1"=10' V			88213