

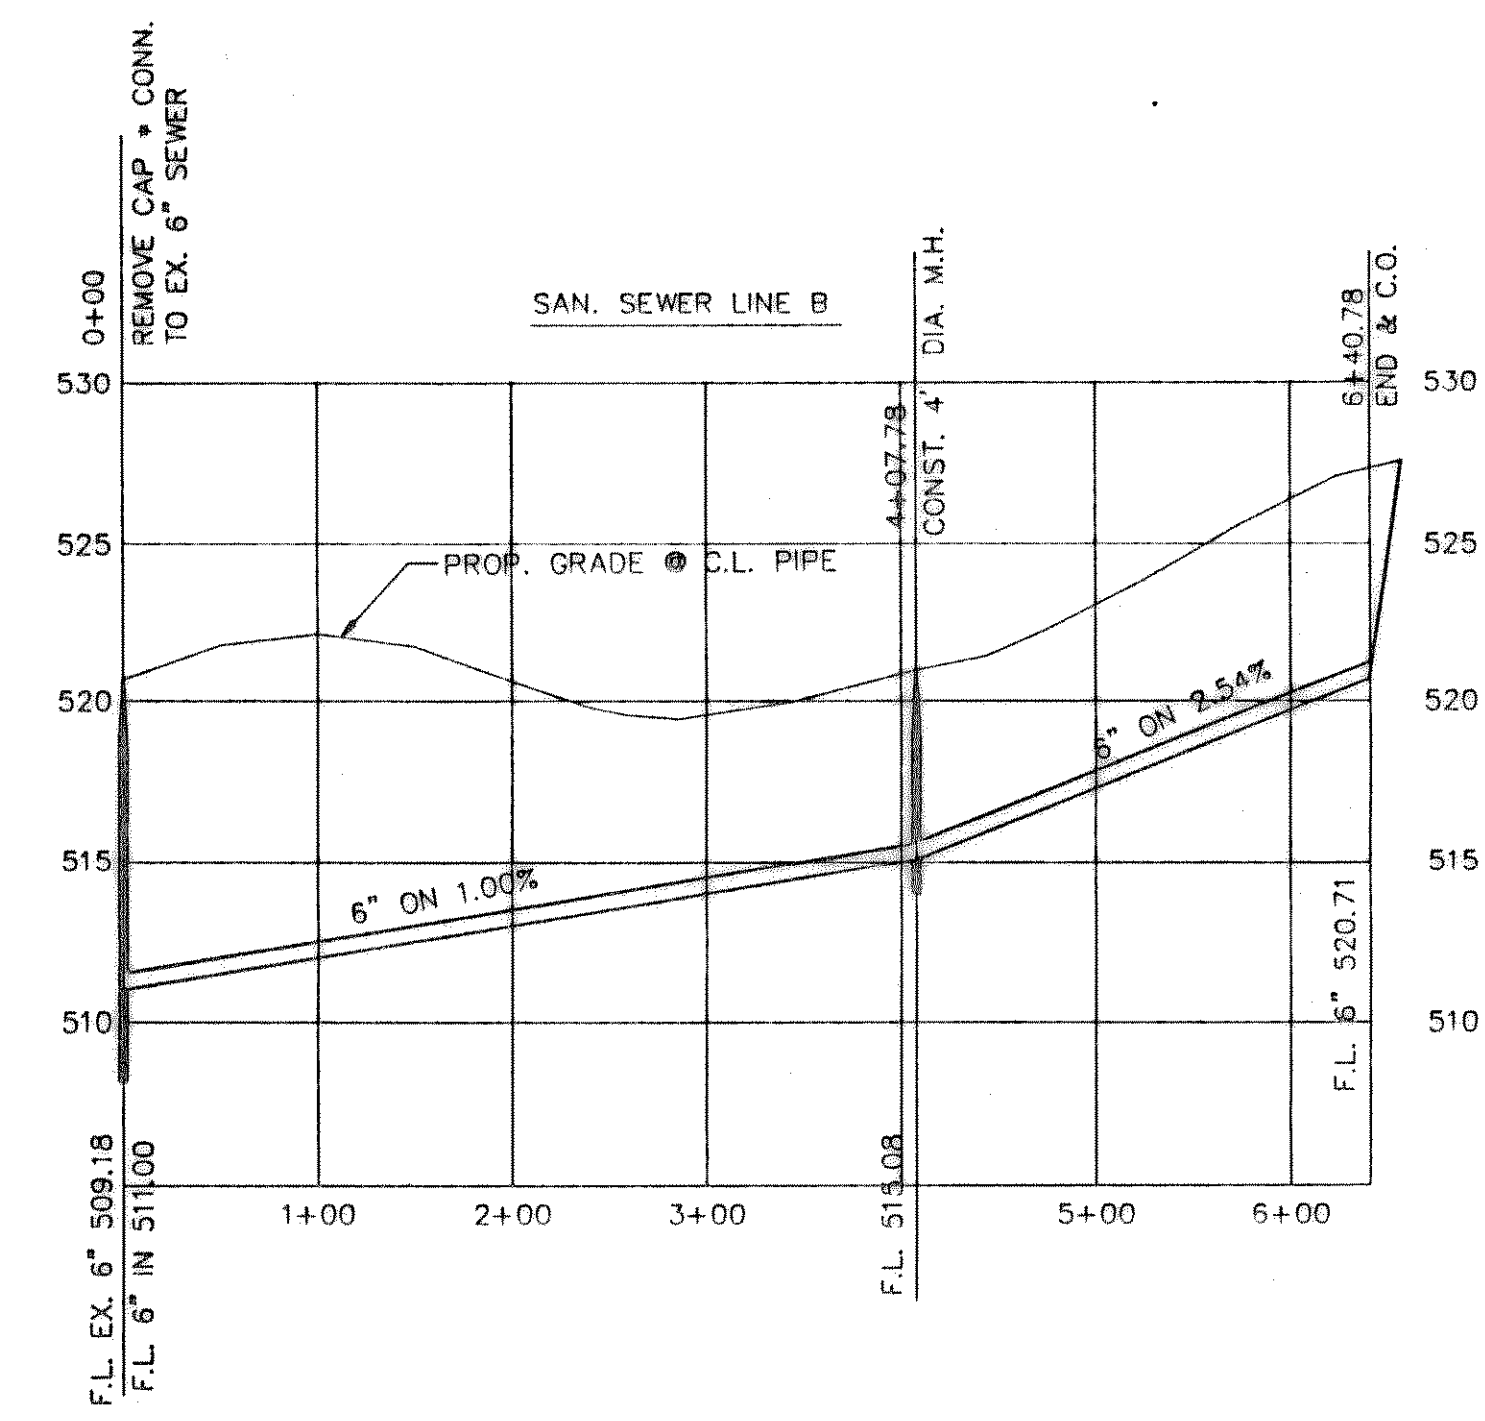
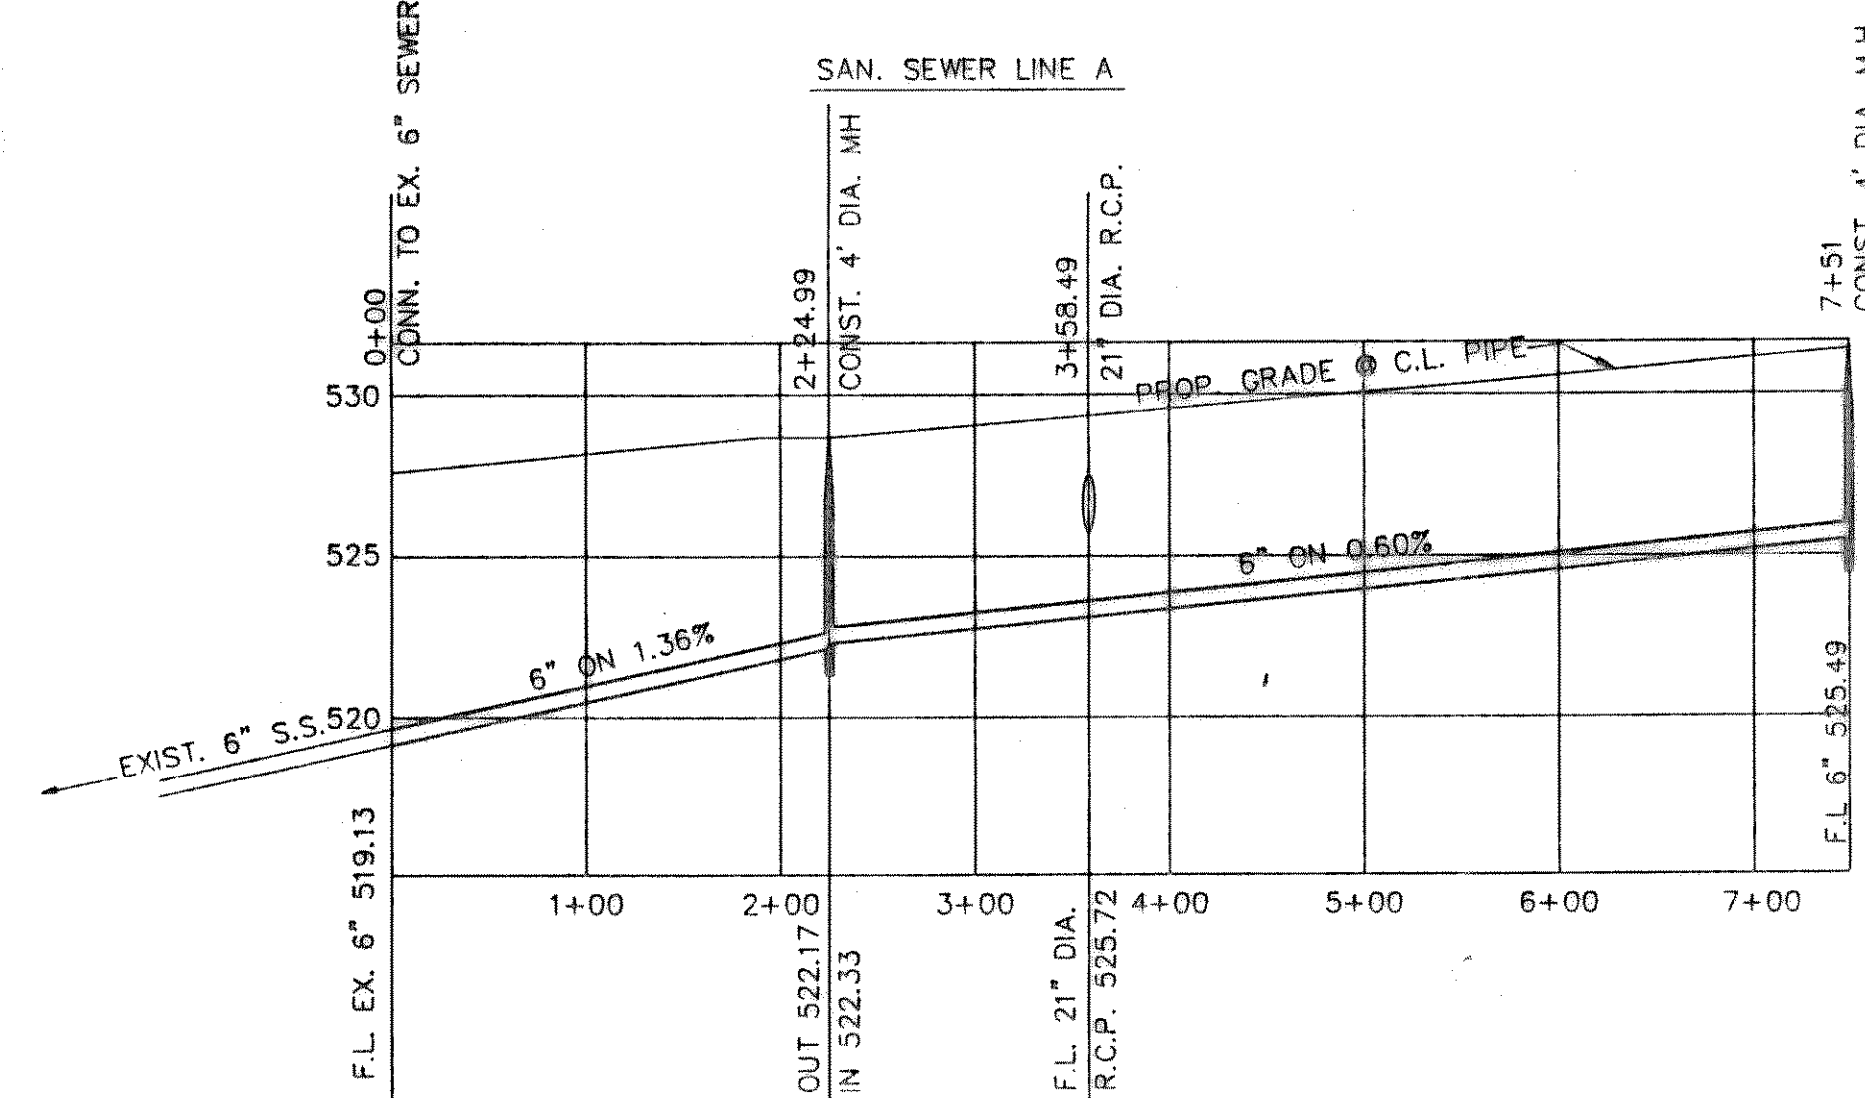


CURVE	RADIUS	LENGTH	TANGENT	CHORD	BEARING	DELTA
C-1	153.50	118.78	62.54	115.84	N20°22'05"E	44°20'10"
C-2	278.50	71.01	35.70	70.81	S80°53'46"W	14°36'29"
C-3	365.71	81.92	41.13	81.75	N90°53'46"E	12°50'03"

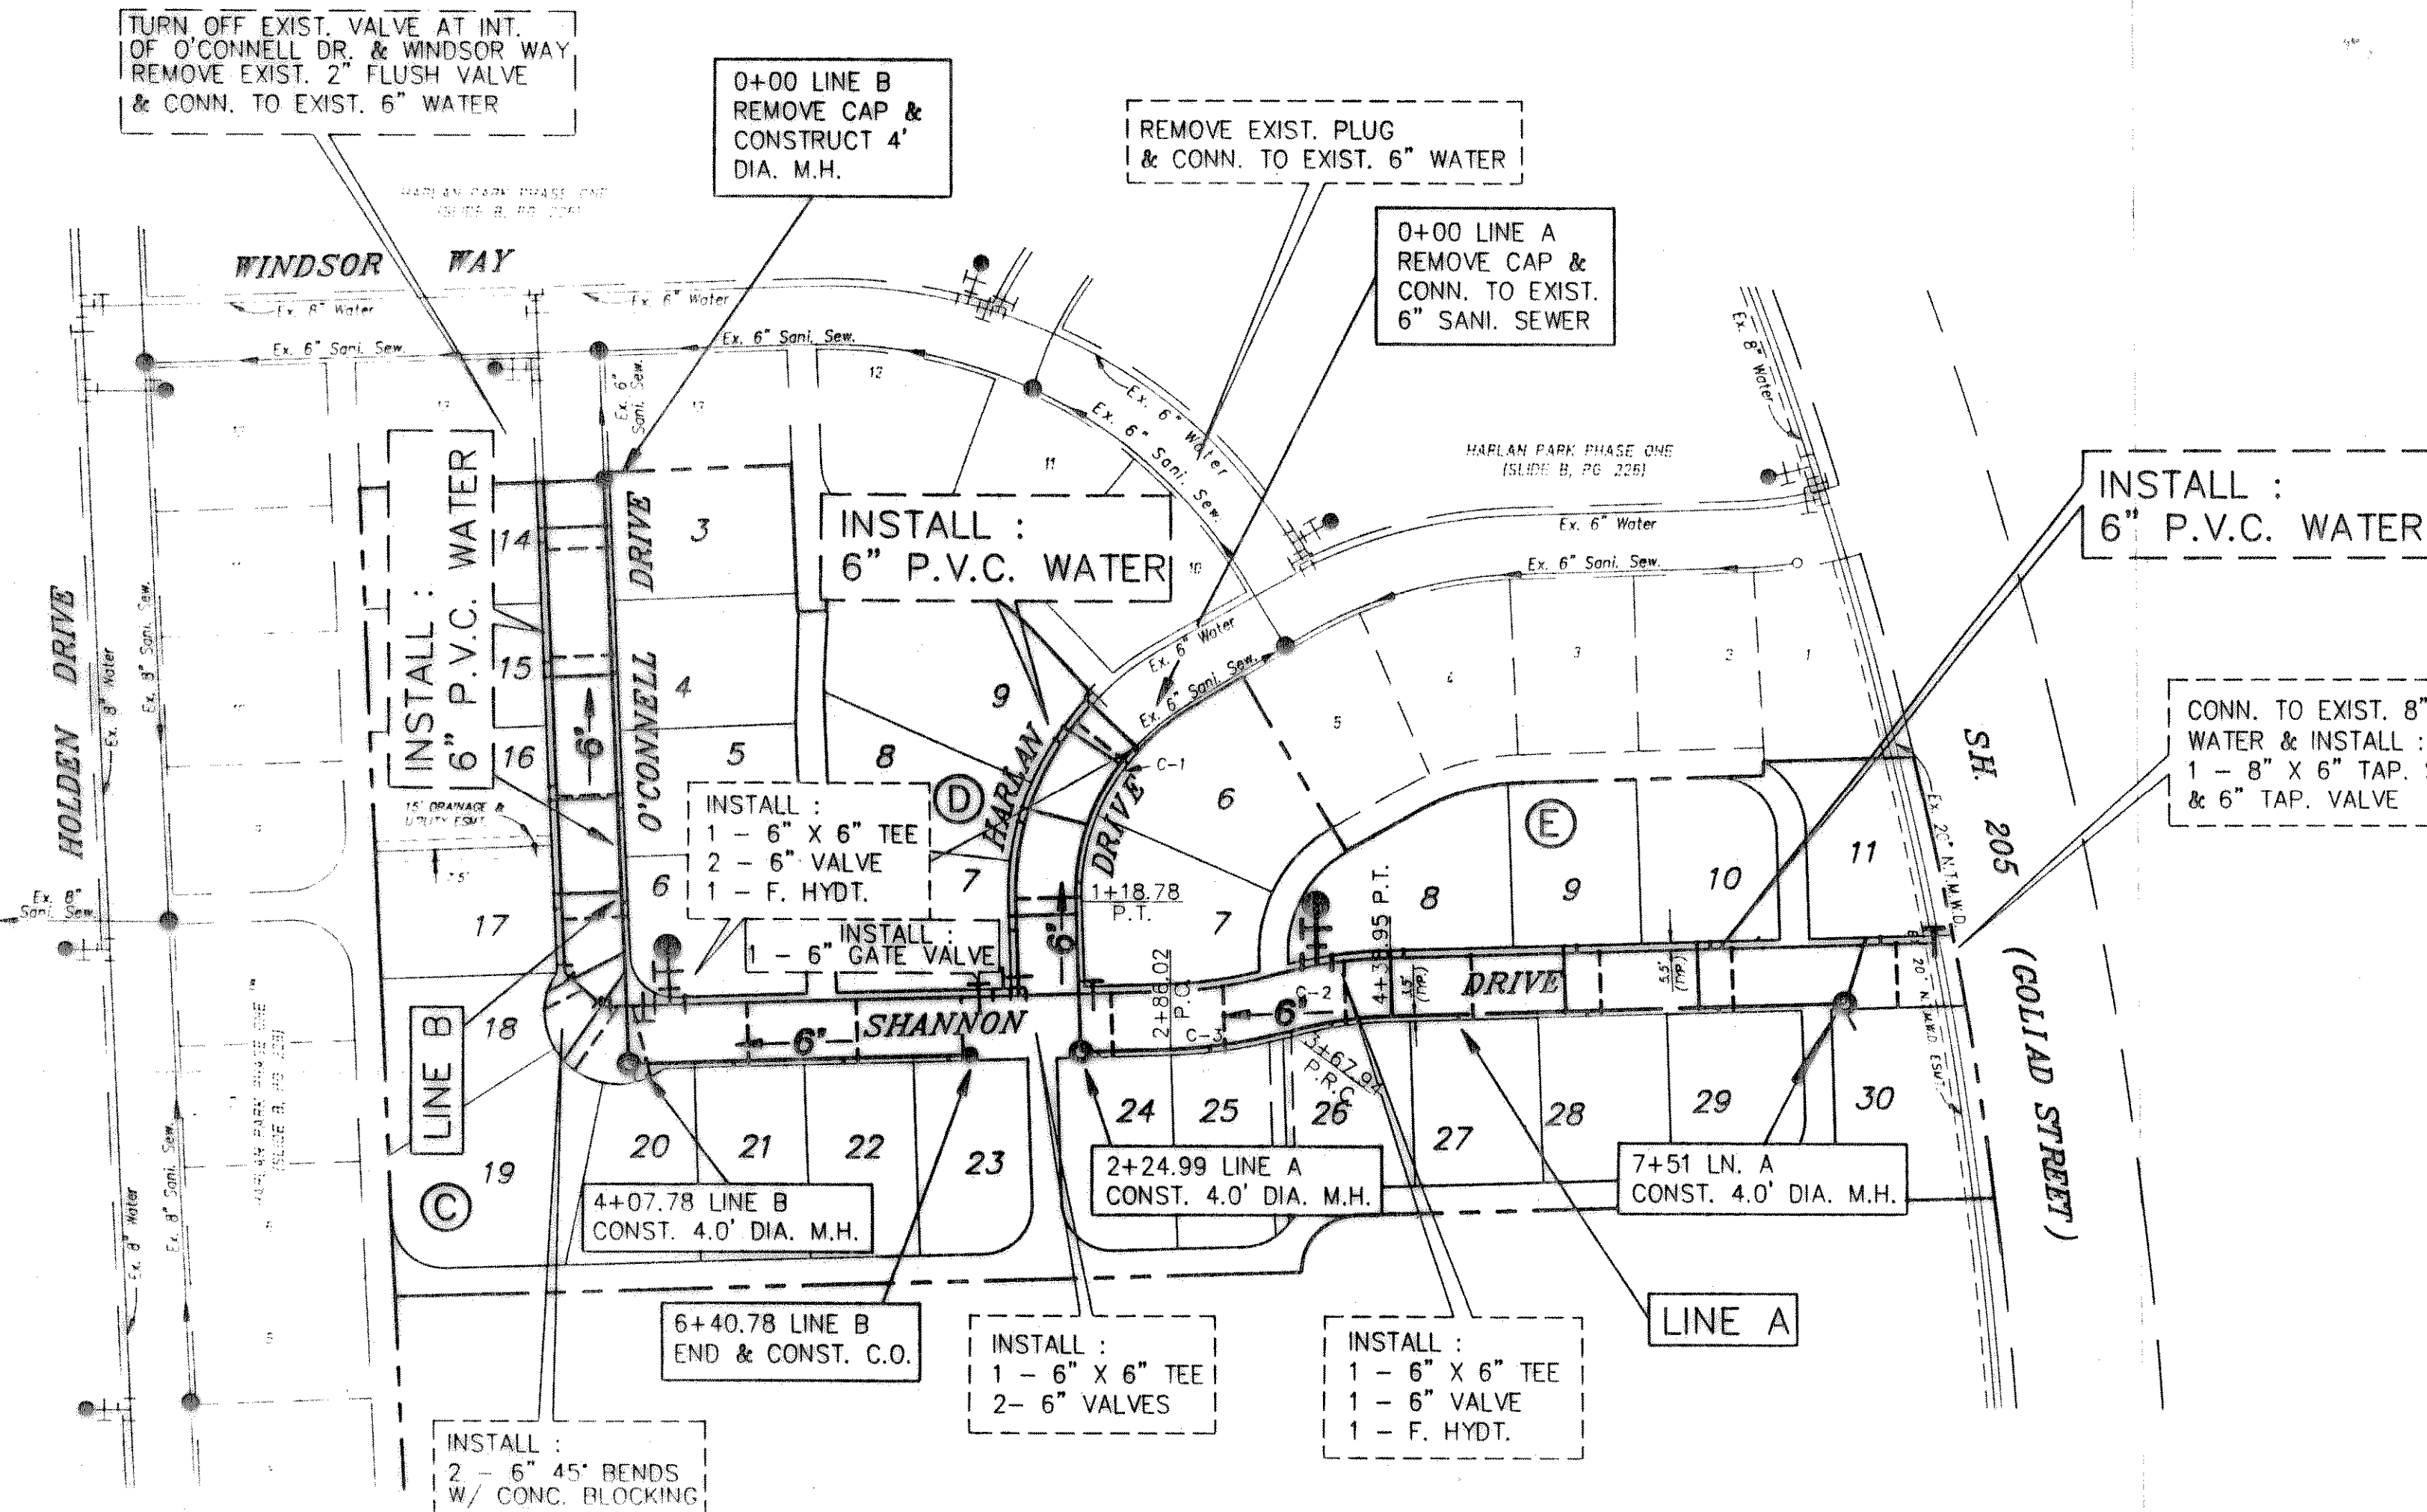

B.M.
 SQUARE ON TOP OF CONC. HWY. 200' SOUTH
 OF SOUTHEAST ADDITION CORNER ON WEST SIDE
 ST. HWY. 205.
 ELEVATION = 532.95

B.M.
 R.R. SPIKE IN P.P. ON WEST SIDE ST. HWY.
 205, 280' +/- NORTH OF NORTHEAST ADDITION
 CORNER.
 ELEVATION = 530.36

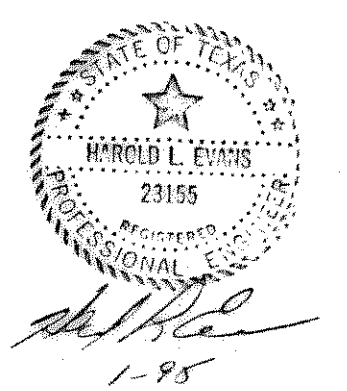

HAROLD L. EVANS CONSULTING ENGINEER P.O. BOX 28365 2331 GUS THOMASSON ROAD, SUITE 102 DALLAS, TEXAS 75228, (214) 328-8133		WATER & SANITARY SEWER PLAN HARLAN PARK PHASE TWO CITY OF ROCKWALL ROCKWALL COUNTY, TEXAS		SHEET NO. 6	
REVISION DESCRIPTION 93144MSA 12/29/94		DATE 11/4/94	SCALE 1" = 100' HOR. 1" = 8' VERT.	DESIGN H.L.E.	DRAWN K.E.B.