


DRAINAGE DATA

D.A. No.	AREA (ACRES)	C	I (100)	Q (CFS)	SUM Q 100 (CFS)
1	2.52	.80	9.8	19.76	19.76
2	1.49	.50	9.8	7.30	27.06
3	1.55	.50	9.8	7.60	
4	2.01	.50	9.8	9.85	17.45
5A	1.43	.50	9.8	7.01	
5B	1.57	.50	9.8	7.69	32.15
6	1.24	.50	9.8	6.07	6.07

B.M.
 SQUARE ON TOP OF CONC. HWY. 200' SOUTH
 OF SOUTHEAST ADDITION CORNER ON WEST SIDE
 ST. HWY. 205.
 ELEVATION = 532.95

B.M.
 R.R. SPIKE IN P.P. ON WEST SIDE ST. HWY.
 205, 280' +/- NORTH OF NORTHEAST ADDITION
 CORNER.
 ELEVATION = 530.36

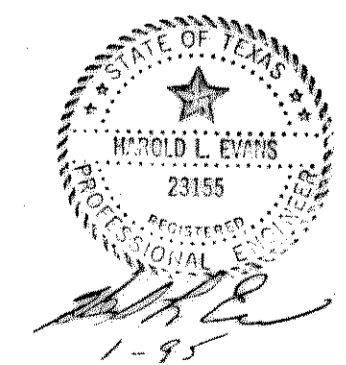

HAROLD L. EVANS CONSULTING ENGINEER P.O. BOX 28365 2331 GUS THOMASSON ROAD, SUITE 102 DALLAS, TEXAS 75228, (214) 328-8133		DRAINAGE AREA MAP HARLAN PARK PHASE TWO CITY OF ROCKWALL ROCKWALL COUNTY, TEXAS		SHEET NO. 7 9
DATE 11/16/94	SCALE 1" = 100' HORZ	DESIGN H.L.E.	DRAWN K.E.B.	SHEET NO. 93144