

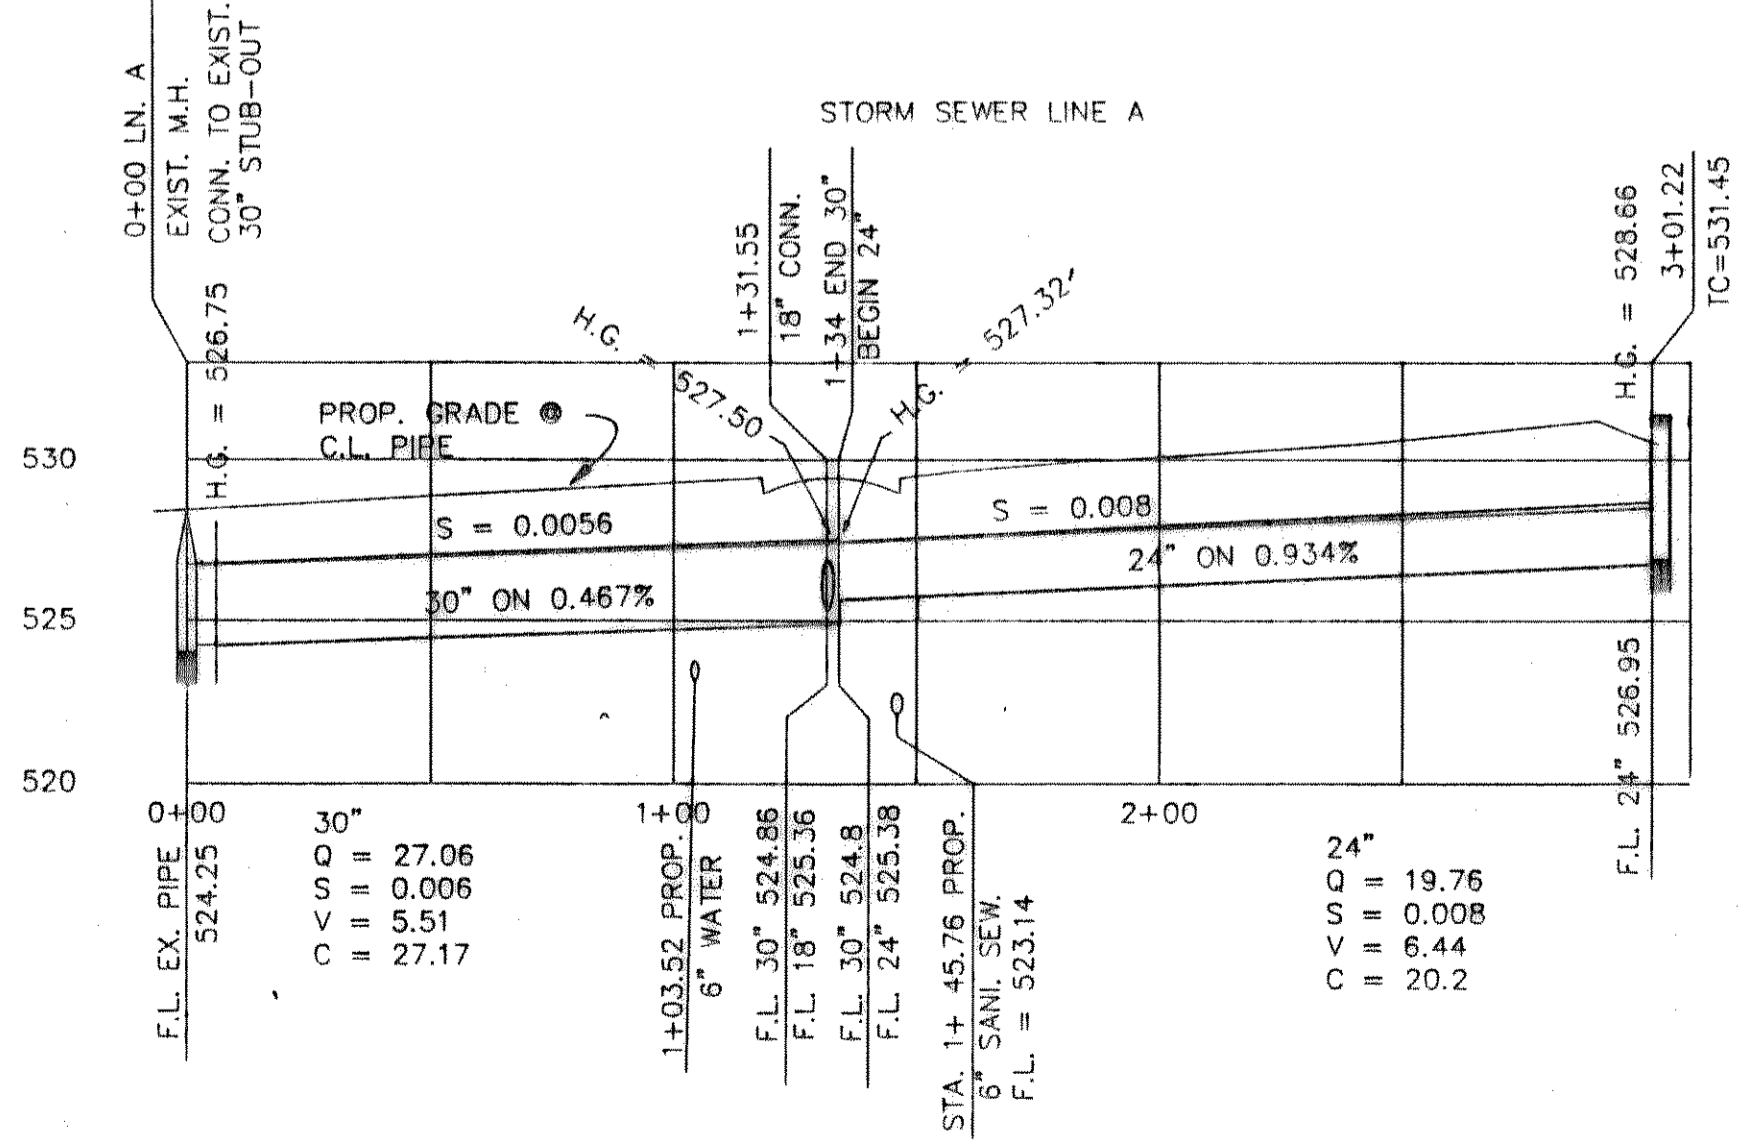
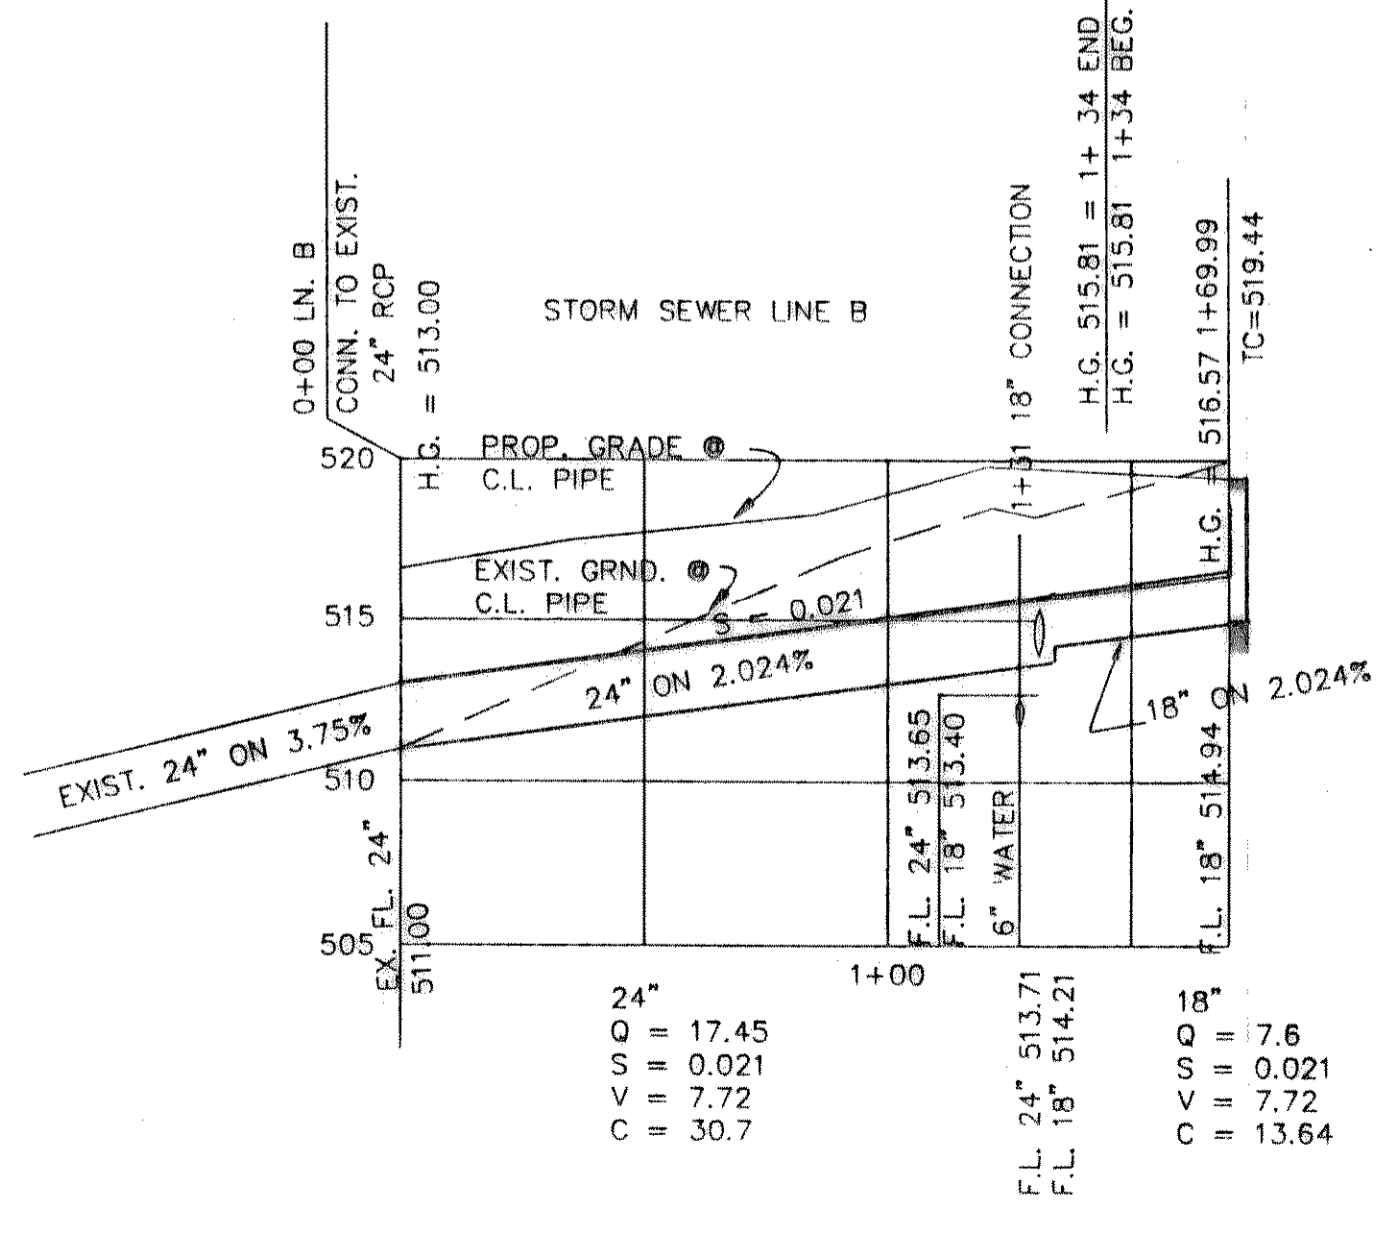
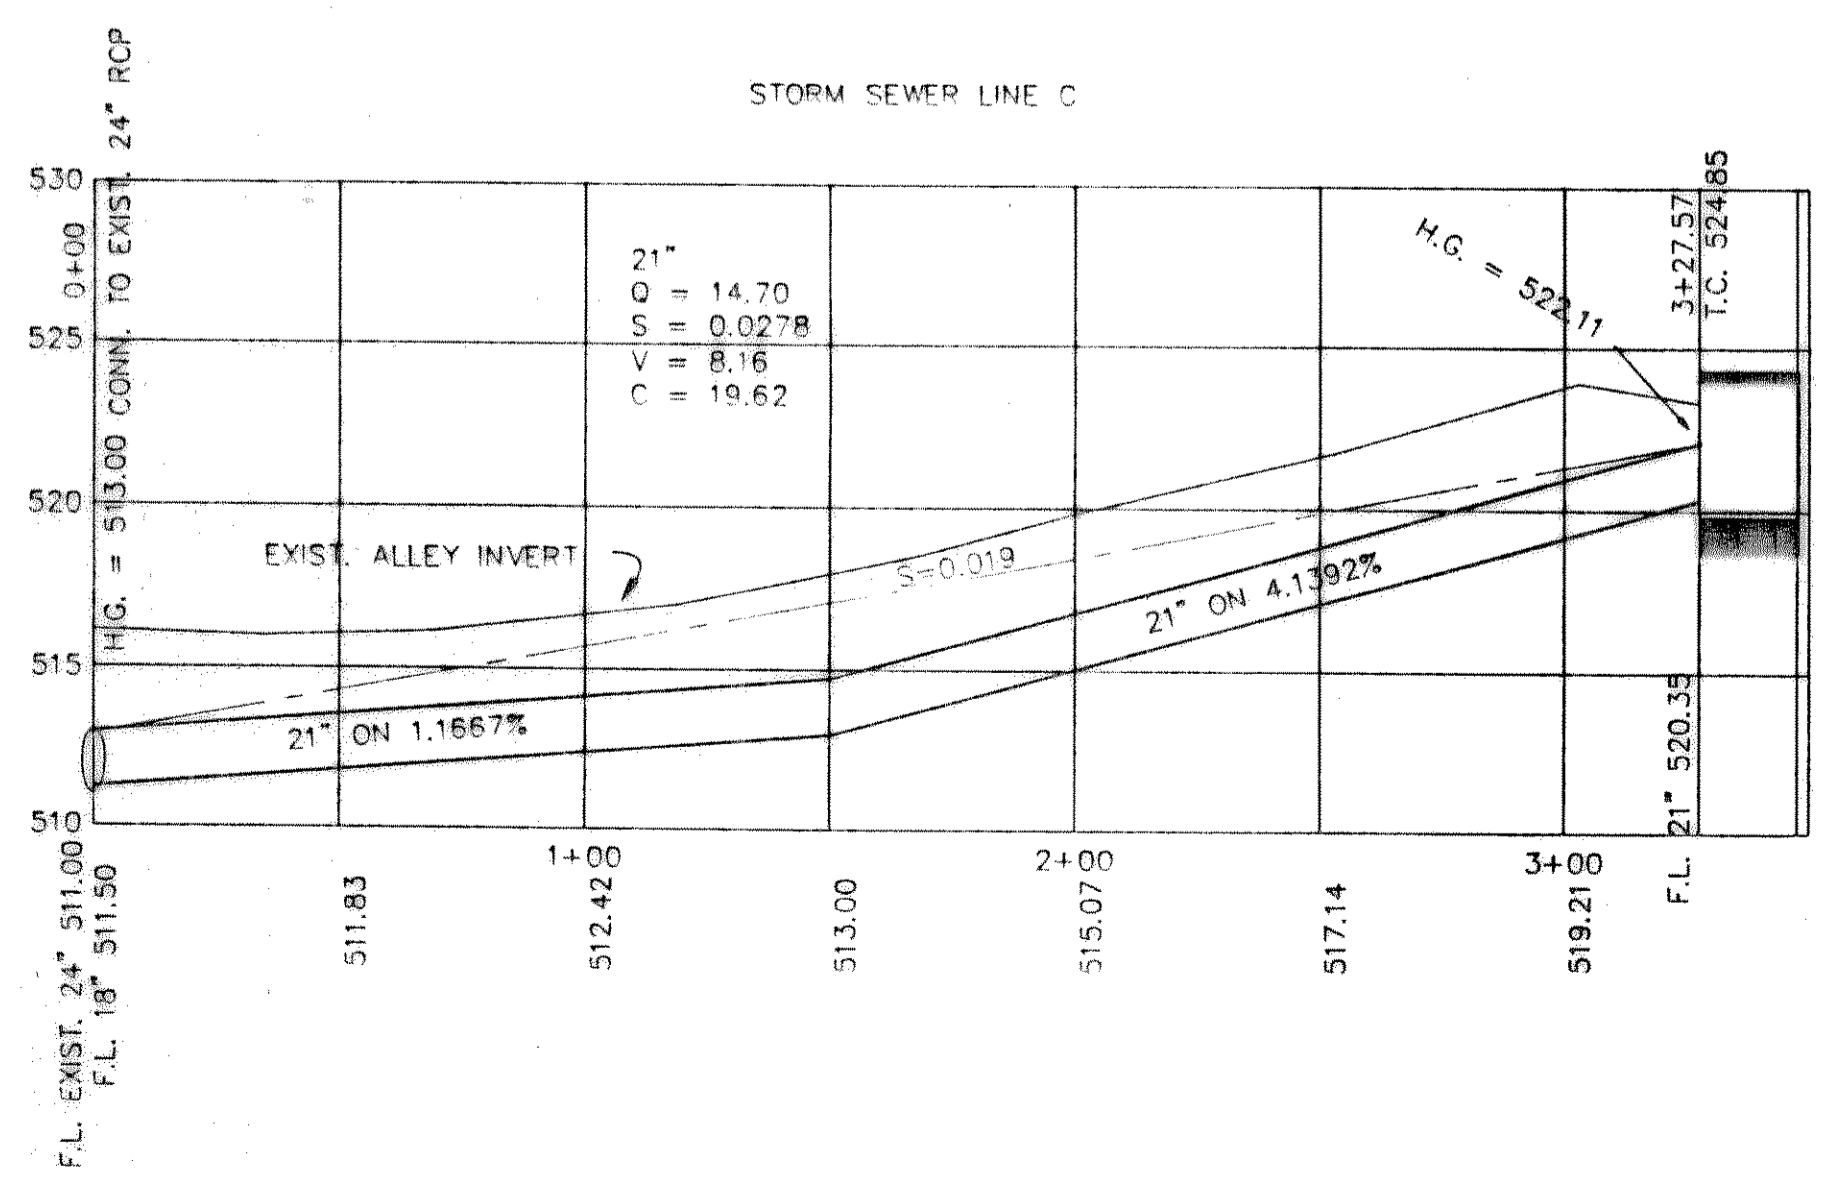


CURVE	RADIUS	LENGTH	TANGENT	CHORD	BEARING	DELTA
C1	92.80	91.77	50.03	88.08	S26°31'57"W	56°39'54"
C2	100.00	84.84	45.16	82.32	N68°03'43"W	48°36'35"
C3	100.00	34.30	17.32	34.13	S77°48'23"W	19°39'09"
C4	100.00	106.92	59.21	101.90	S32°58'50"E	61°13'38"

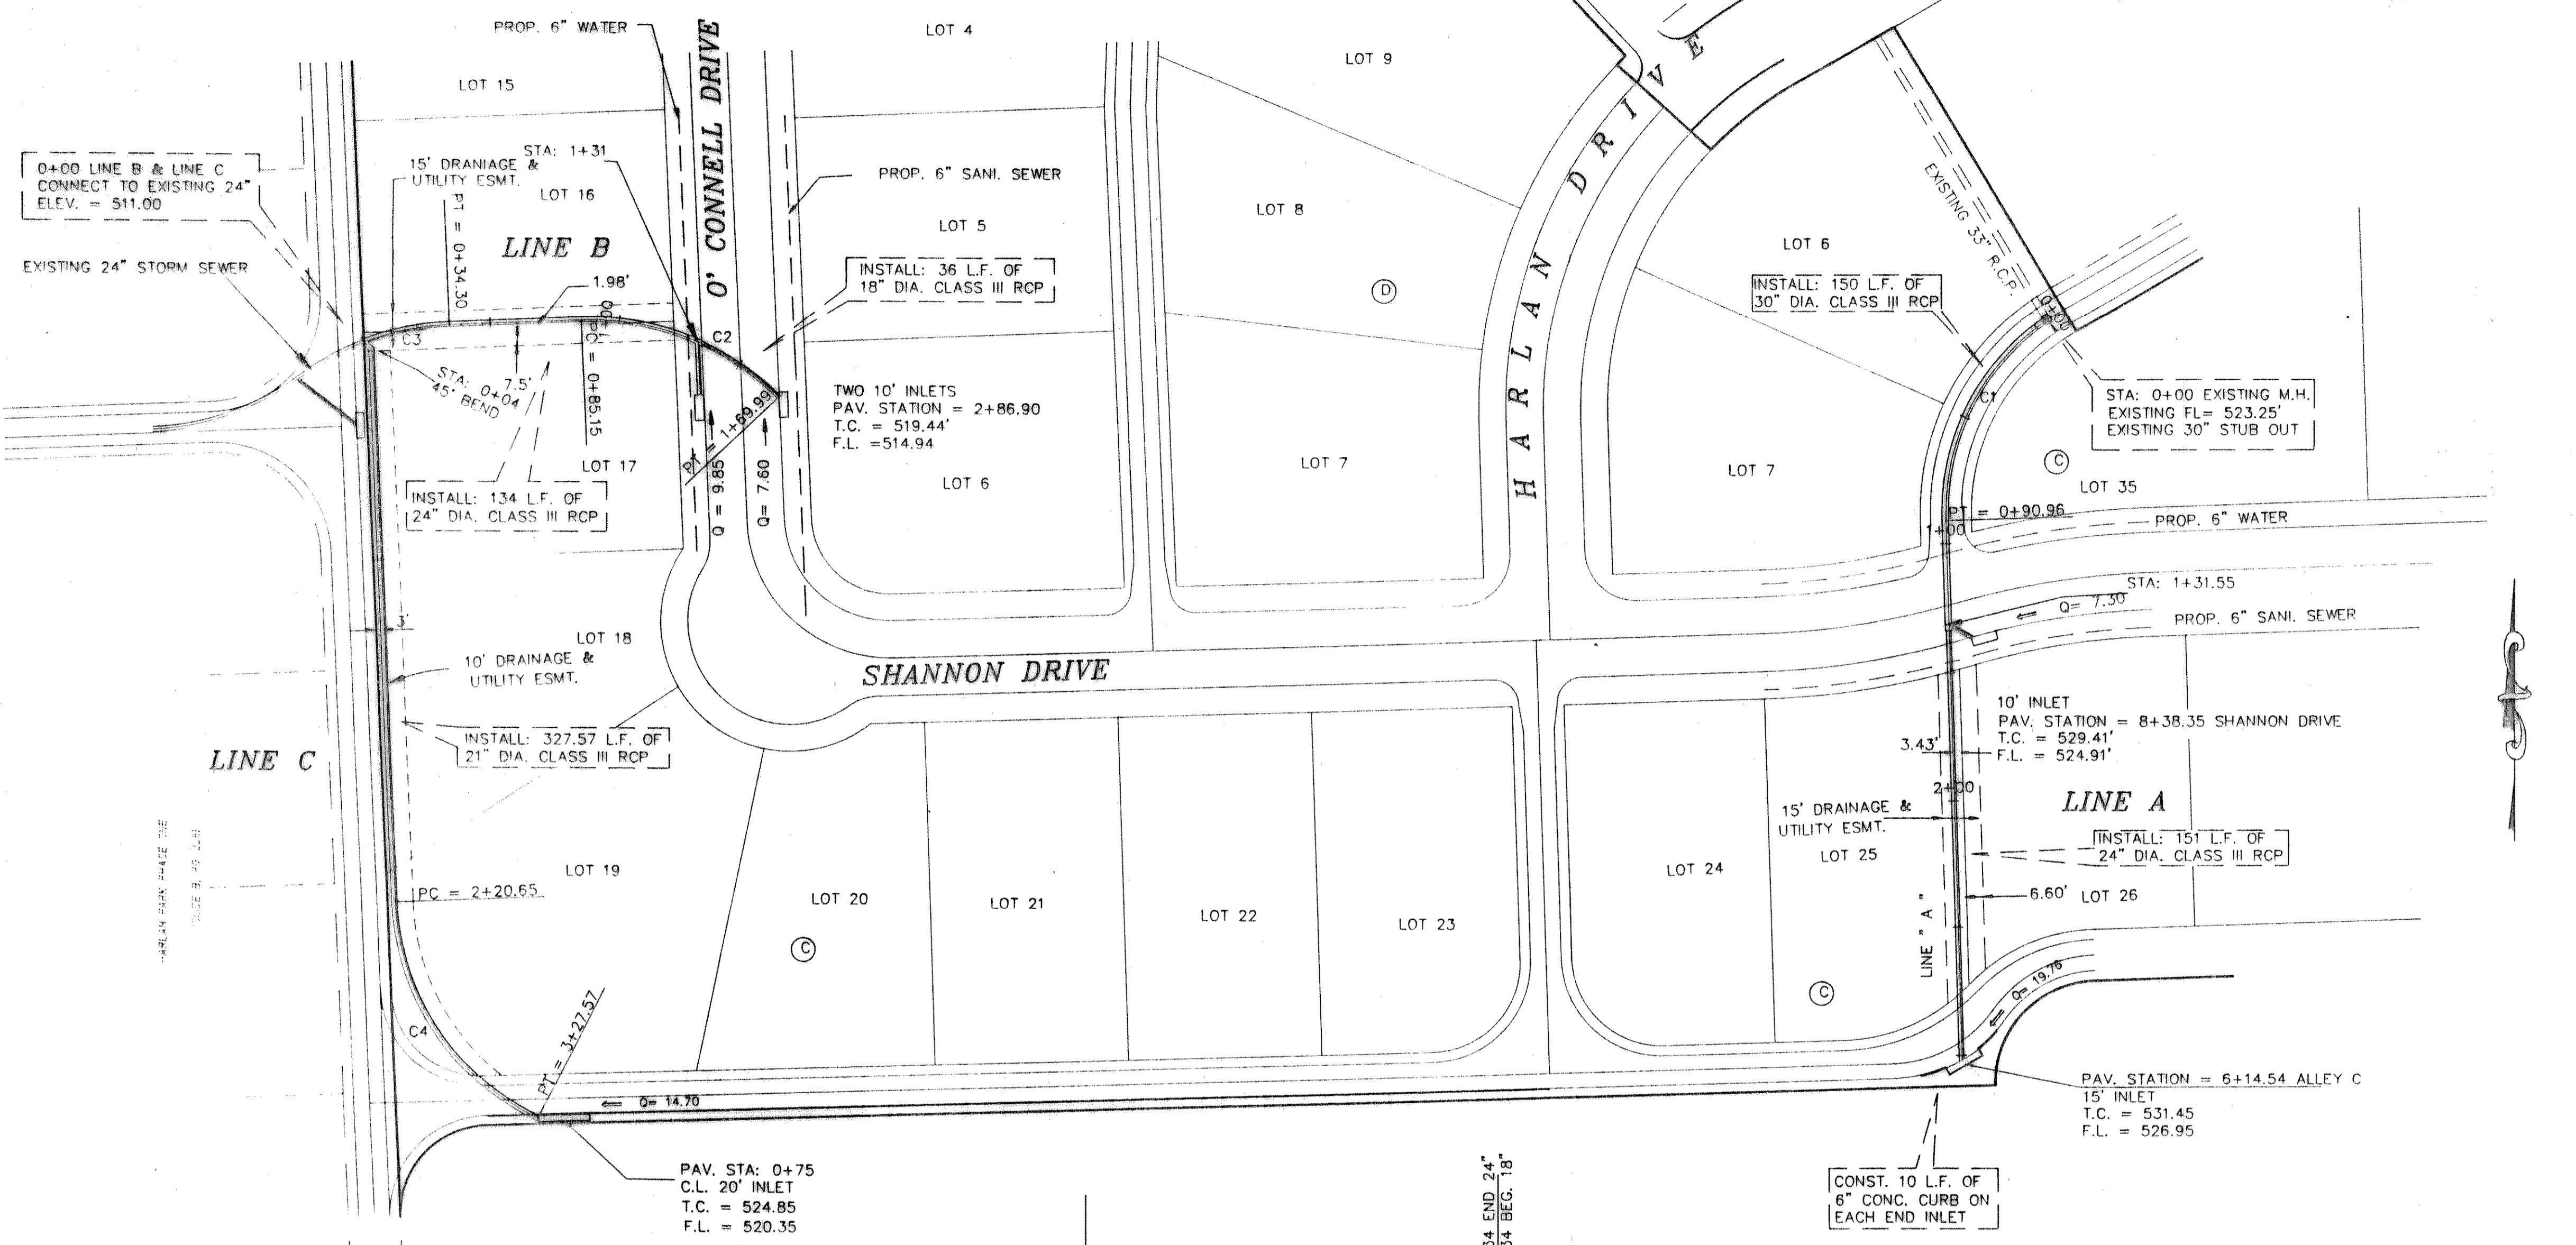

B.M.
SQUARE ON TOP OF CONC. FOUND. 200' SOUTH
OF SOUTHEAST CORNER OF WEST SIDE
ST. HWY. 205.
ELEVATION = 530.95

B.M.
P.B. SPINE IN P.P. ON WEST SIDE ST. HWY.
205, 280' 4\"/>

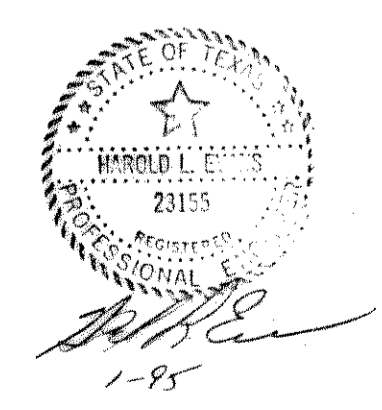

HAROLD L. EVANS CONSULTING ENGINEER P.O. BOX 28355 2331 GUS THOMASSON ROAD, SUITE 102 DALLAS, TEXAS 75228. (214) 328-8133		STORM SEWER ROCKWALL COUNTY, TEXAS HARLAN PARK PHASE TWO CITY OF ROCKWALL		SHEET NO. 8	
REV. PER FINAL CITY REVIEW REV. PER CITY REVIEW	9314457A 1/20/95 12/29/94	DATE 11/16/94	SCALE 1" = 40' HOR. 1" = 6' VERT.	DESIGN H.L.E.	DRAWN K.F.B.