


DRAINAGE DATA										
AREA	ACRES	t_c	C	I_s	Q_s	Q_s ACCUM	T_{25}	Q_{25}	Q_{25} ACCUM	
1	14.66	12	0.50	6.1	44.71	—	8.6	63.04	—	
2	4.78	13	0.50	5.9	14.10	58.81	8.3	19.84	82.88	
3	4.44	10	0.50	6.6	14.65	73.46	9.3	20.65	103.53	
4	2.42	10	0.50	6.6	7.99	81.46	9.3	11.25	114.78	
5	26.66	14	0.50	5.7	75.98	157.44	8.0	106.64	221.42	
6	2.85	12	0.50	6.1	8.69	166.13	8.6	12.26	233.68	
7	15.31	30	0.50	4.7	36.05	202.18	5.3	40.65	274.33	
8	1.07	10	0.50	6.6	3.63	205.71	9.3	4.98	279.31	
9	3.85	10	0.50	6.6	12.71	218.42	9.3	17.90	297.21	
10	1.5	10	0.50	6.6	4.95	223.31	9.3	6.98	304.19	
11	3.4	14	0.50	5.7	9.69	233.06	8.0	13.60	317.79	
12	1.4	10	0.50	6.6	4.62	237.68	9.3	6.51	324.30	
13	9.84	33	0.50	3.6	17.35	255.03	5.0	24.1	348.40	

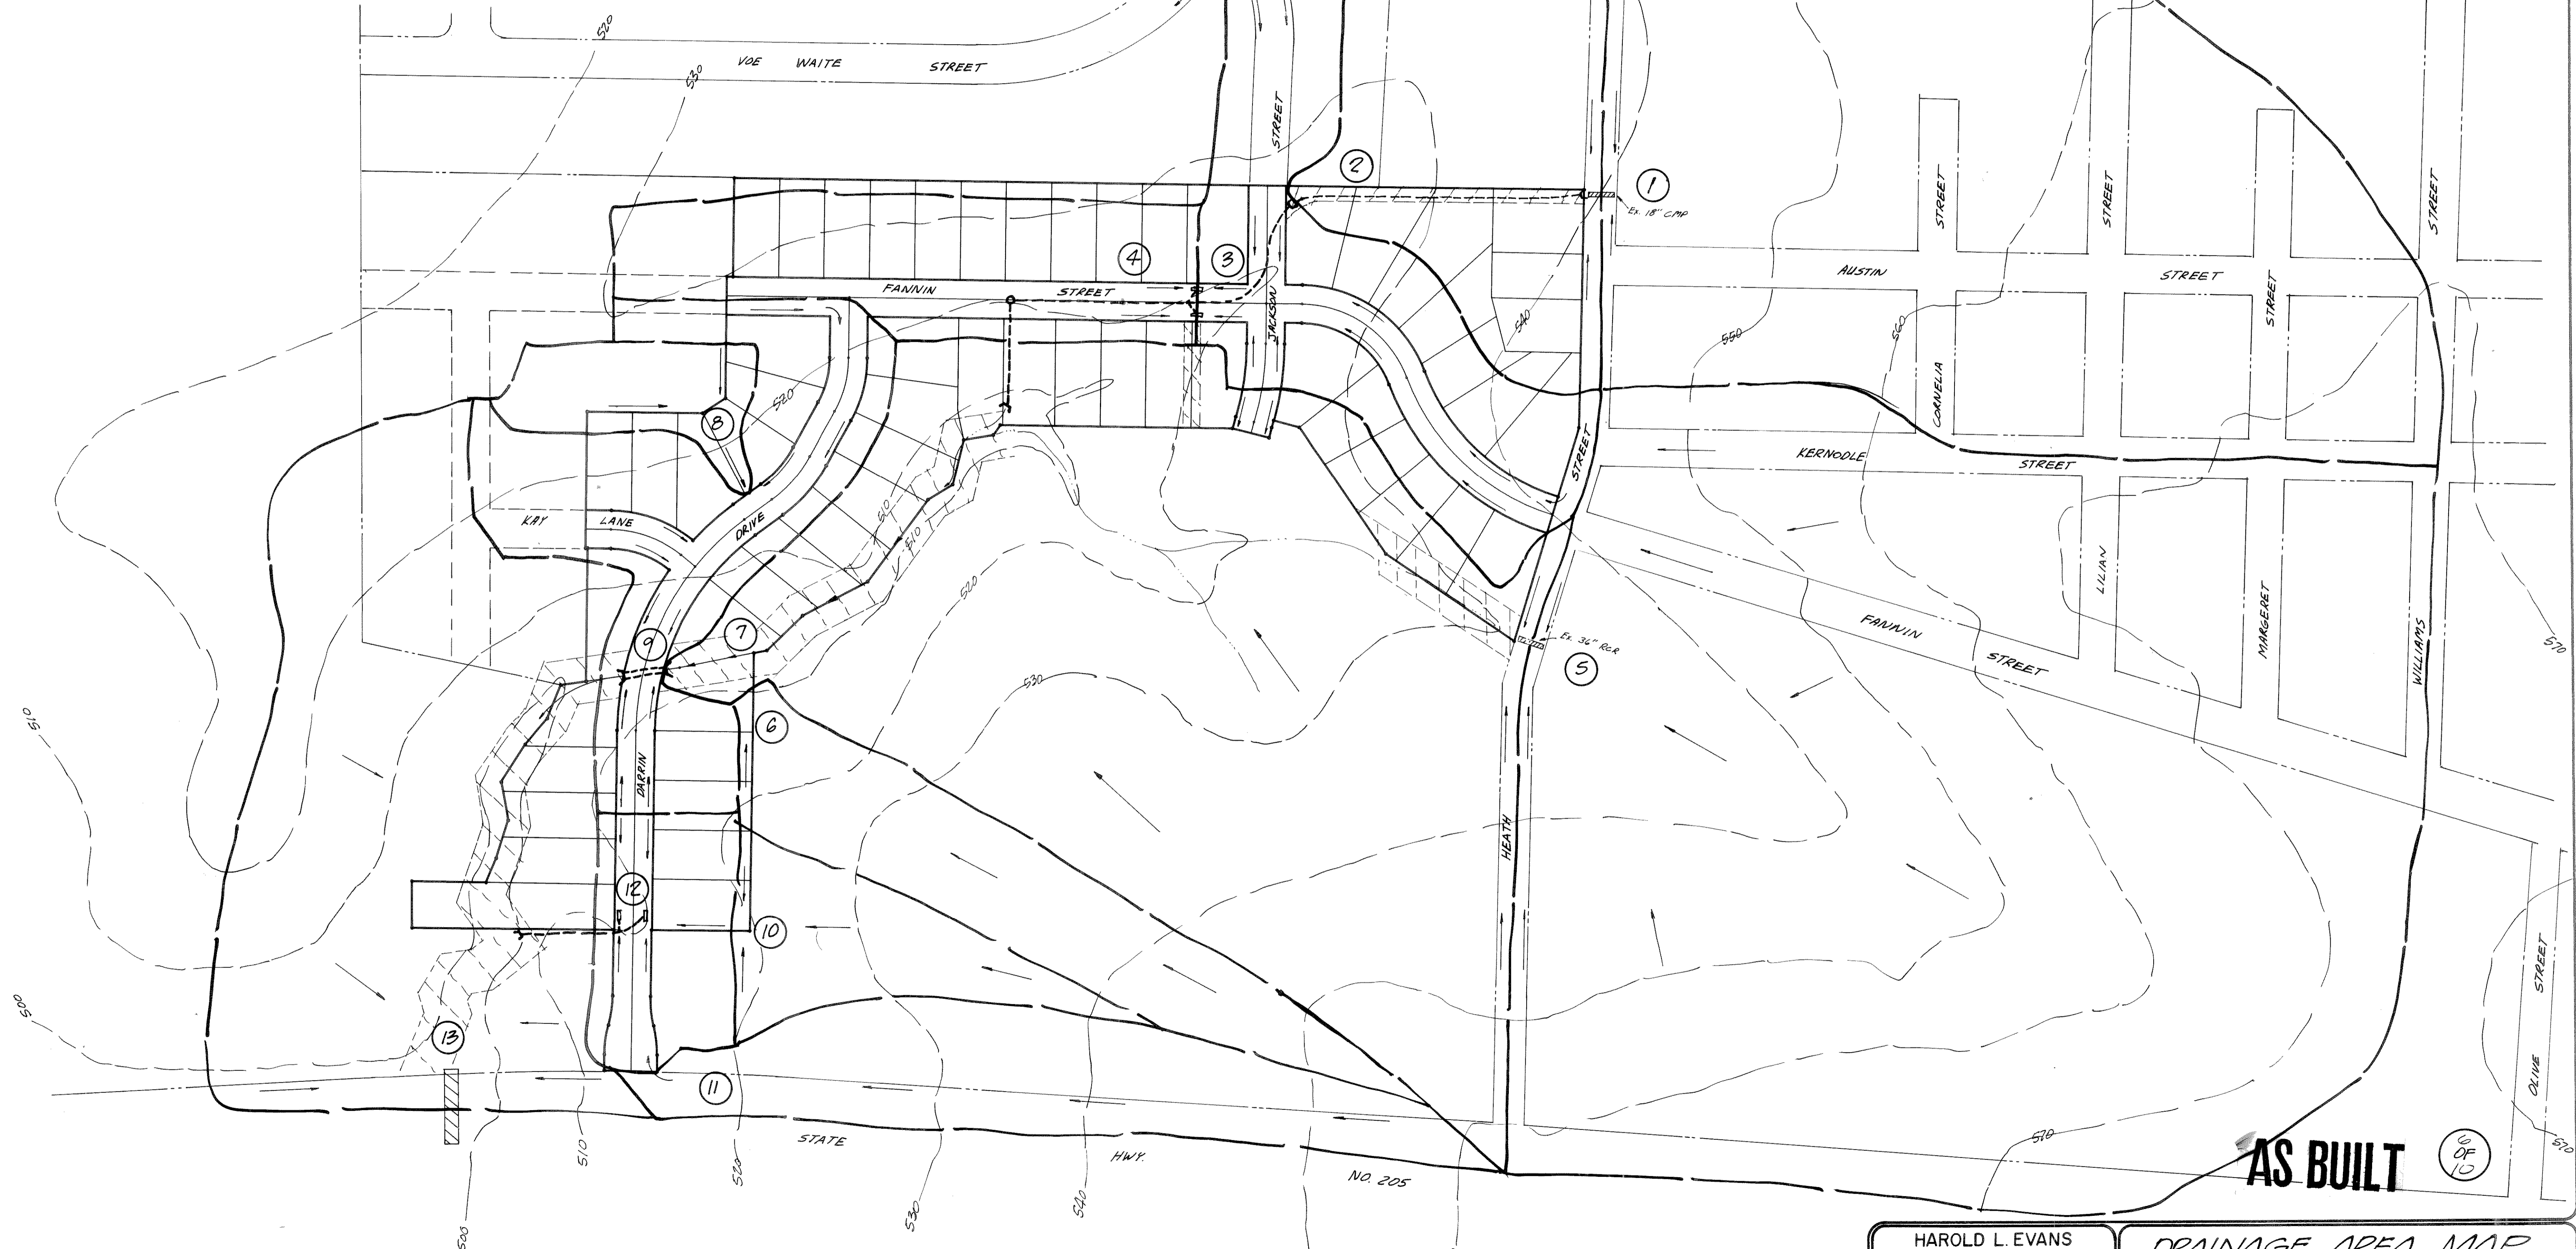

AS BUILT

60 OF 10

HAROLD L. EVANS CONSULTING ENGINEER 2331 GUS THOMASSON RD. SUITE 102 DALLAS, TEXAS 75228 PHONE (214) 328-8133			DRAINAGE AREA MAP HARRIS HEIGHTS ADDITION PHASE ONE CITY OF ROCKWALL ROCKWALL COUNTY, TEXAS		
SCALE	DATE	JOB NO.			
1"=100'	12-12-83	83235			

INDICATES 100 FT FLOODWAY ESMT.