


PLAN VIEW

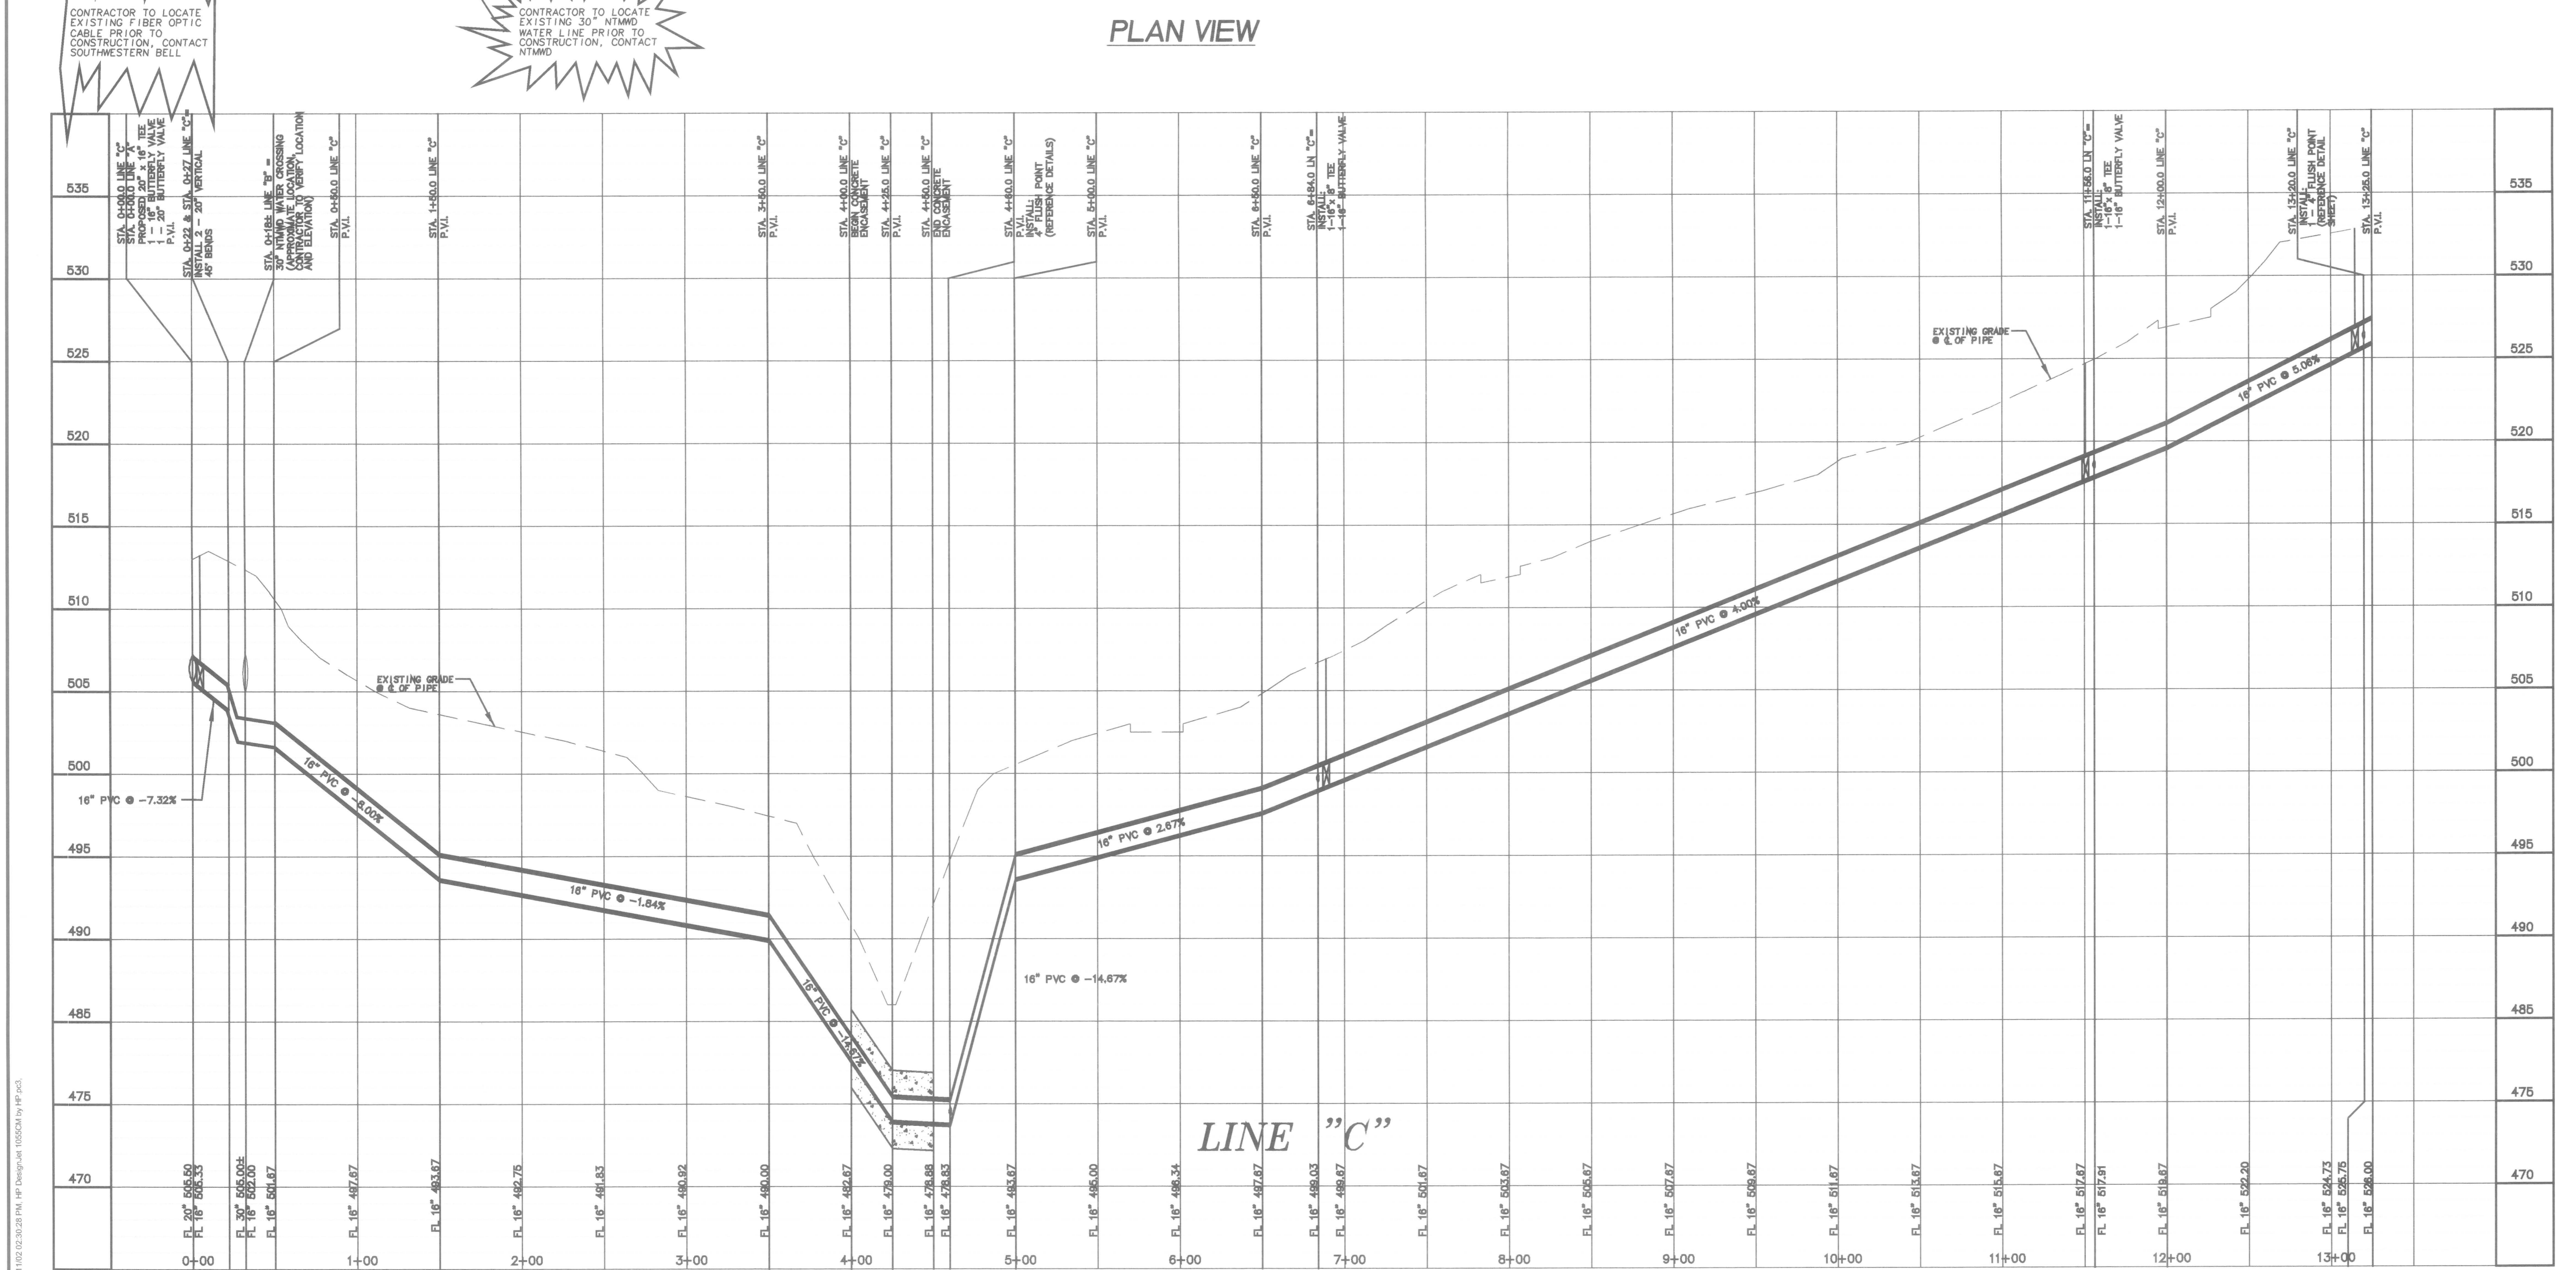

PROFILE VIEW

PLAN + PROFILE LN "C" STA. 0+00 TO 13+25

SCALE: 1" = 50'
1" = 5' V

BENCH MARK:
#1 CITY OF ROCKWALL MONUMENT 0008, 8d NAIL W/SHINER IN POWER POLE, LOCATED IN THE SOUTHWEST QUADRANT OF THE INTERSECTION OF S.H. 205 AND F.M. 552 AND DALTON ROAD APPROXIMATELY 26' SOUTH OF THE CENTERLINE OF DALTON ROAD, AND 133.5' WEST OF THE CENTERLINE OF S.H. 205. ELEVATION = 542.34

REFERENCE SHEET C1.01 FOR WATER NOTES



PHONE 972-777-8551
100 DECKER COURT - SUITE 250
IRVING, TEXAS 75062



SHEET NUMBER C
OF 2.07
SHEET NUMBER

FINAL PLANS FOR BIDDING AND CONSTRUCTION



16" & 20" WATER LINE CONSTURCTION
ROCKWALL INDEPENDENT SCHOOL DISTRICT
ROCKWALL, TEXAS

DNE SEPTEMBER 12, 2002
DRAWN BY TJC
CHECKED RAH
COMM NO 144101044
REVISED

I:\Projects\DWG\ROCKWALL\WATER LINE\BID\LINE.C.dwg, 09/12/02 10:29:28 PM, P:\Design\100024.rvt, 10/02/04 by HP/pcj