


CONSTRUCTION PLANS

HICKORY RIDGE PHASE FOUR

CITY OF ROCKWALL
ROCKWALL COUNTY, TEXAS

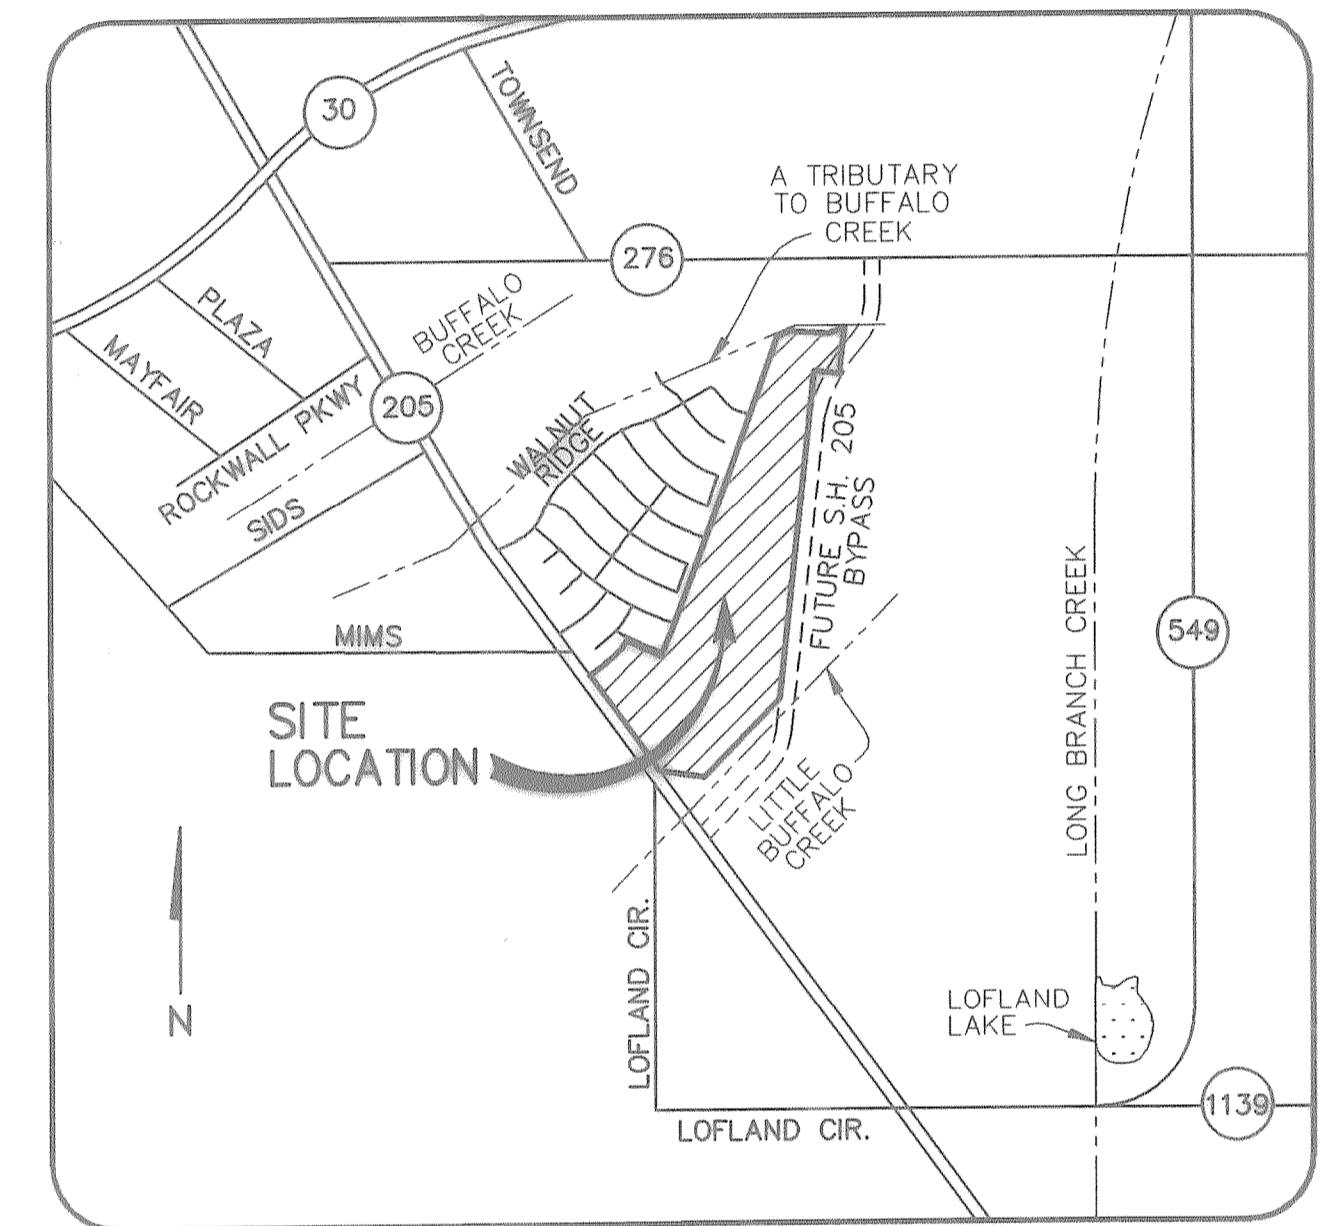

LOCATION MAP

N.T.S.

OWNER

HICKORY RIDGE, LTD.

5225 VILLAGE CREEK DRIVE SUITE 300
(972) 931-9537 PLANO, TEXAS 75093

DEVELOPER

PAPAGOLOS DEVELOPMENT COMPANY

5225 VILLAGE CREEK DRIVE SUITE 300
(972) 931-9537 PLANO, TEXAS 75093

ENGINEER

DOWDEY, ANDERSON & ASSOCIATES, INC.

5225 VILLAGE CREEK DRIVE SUITE 200
(972) 931-0694 PLANO, TEXAS 75093

RECORD DRAWINGS January 27, 2004
NOTE: THE INTENT OF THE OWNER AND ENGINEER WAS TO CONSTRUCT THE IMPROVEMENTS ACCORDING TO THESE PLANS AS APPROVED BY THE CITY OF ROCKWALL. THE LINES AND GRADES WERE SET ON THE GROUND FOR CONSTRUCTION ACCORDING TO SAID PLANS. WE ARE NOT AWARE OF ANY CHANGES OR REVISIONS TO THESE PLANS DURING CONSTRUCTION EXCEPT AS NOTED ON THE PLANS.

THESE CONSTRUCTION PLANS WERE PREPARED UNDER THE RESPONSIBLE SUPERVISION OF DAN M. DOWDEY REGISTERED PROFESSIONAL ENGINEER No. 21433



INDEX

PLATE	DESCRIPTION
1	COVER SHEET
2-7	FINAL PLAT
8-35	PAVING PLAN & PROFILES
36	LEFT TURN LANE & TRAFFIC CONTROL
37	RAMP DETAILS
38-40	DRAINAGE AREA MAP
41-52	STORM SEWER PLAN & PROFILES
53-54	WATER AND SANITARY SEWER PLAN
55-59	SANITARY SEWER PROFILES
60	16" WATER LINE PROFILE
61-65	GRADING PLANS
66-67	STORMWATER POLLUTION PREVENTION PLAN
68-71	LANDSCAPE AND WALL PLANS
72-73	TREE SURVEY PLANS
74-75	FORCEMAIN PLAN & PROFILES
76-81	LIFT STATION PLANS
82-85	LIFT STATION ELECTRICAL PLANS
86	CONSTRUCTION STAGING PLAN
87	TxDOT CONCRETE HEADWALL DETAILS

99-066

REVISED: 3/31/03