

STATE HIGHWAY No. 205


OVERLAY 40' WIDTH (OR EXIST. ROAD WIDTH) x 720', 1 1/2" TYPE "C"

RECORD DRAWINGS January 27, 2004
 NOTE: THE INTENT OF THE OWNER AND ENGINEER WAS TO CONSTRUCT THE IMPROVEMENTS ACCORDING TO THESE PLANS AS APPROVED BY THE CITY OF ROCKWALL. THE LINES AND GRADES WERE SET ON THE GROUND FOR CONSTRUCTION ACCORDING TO SAID PLANS. WE ARE NOT AWARE OF ANY CHANGES OR REVISIONS TO THESE PLANS DURING CONSTRUCTION EXCEPT AS NOTED ON THE PLANS.

NOTE:
 ALL TRAFFIC CONTROL AND PROTECTIVE DEVICES USED MUST CONFORM TO THE TEXAS MANUAL ON UNIFORM TRAFFIC CONTROL DEVICES FOR STREETS AND HIGHWAYS, PART VI IN PARTICULAR.

THE CONTRACTOR SHALL CONTACT THE TEXAS DEPARTMENT OF TRANSPORTATION PRIOR TO DOING ANY WORK WITHIN THE STATE RIGHT OF WAY.

THESE CONSTRUCTION PLANS WERE PREPARED UNDER THE RESPONSIBLE SUPERVISION OF DAN M. DOWDEY REGISTERED PROFESSIONAL ENGINEER No. 21433

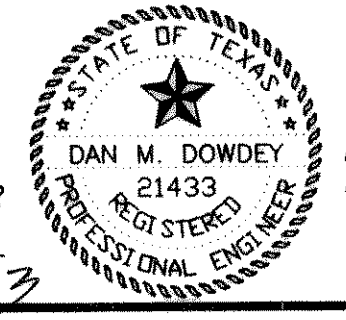

THE SEAL APPEARING ON THIS DOCUMENT WAS AUTHORIZED BY DAN M. DOWDEY P.E. # 21433

NO.	DATE	BY	REVISION
1	1-8-03	JDS	ADDED DIMENSION FOR FUTURE FIRE STATION DRIVEWAY
2	3-3-03	JDS	CITY MARKUPS

LEFT TURN DETAILS & TRAFFIC CONTROL PLAN
HICKORY RIDGE PHASE FOUR
 CITY OF ROCKWALL
 ROCKWALL COUNTY, TEXAS

DOWDEY, ANDERSON & ASSOCIATES, INC.
 5225 VILLAGE CREEK DR., STE. 200 (972) 931-0694 PLANO, TEXAS

DESIGN	DRAWN	CHECKED	DATE	SCALE	JOB	SHEET
JDS	JDS	MSD	OCT 2002	1"=40'	99-066	1/1