


TYPICAL WALL & COLUMN LAYOUT PLAN


OTHER CONSTRUCTION SHALL CONFORM TO SD-7 BRICK SCREENING WALL SCALE: 1" = 1'-0"

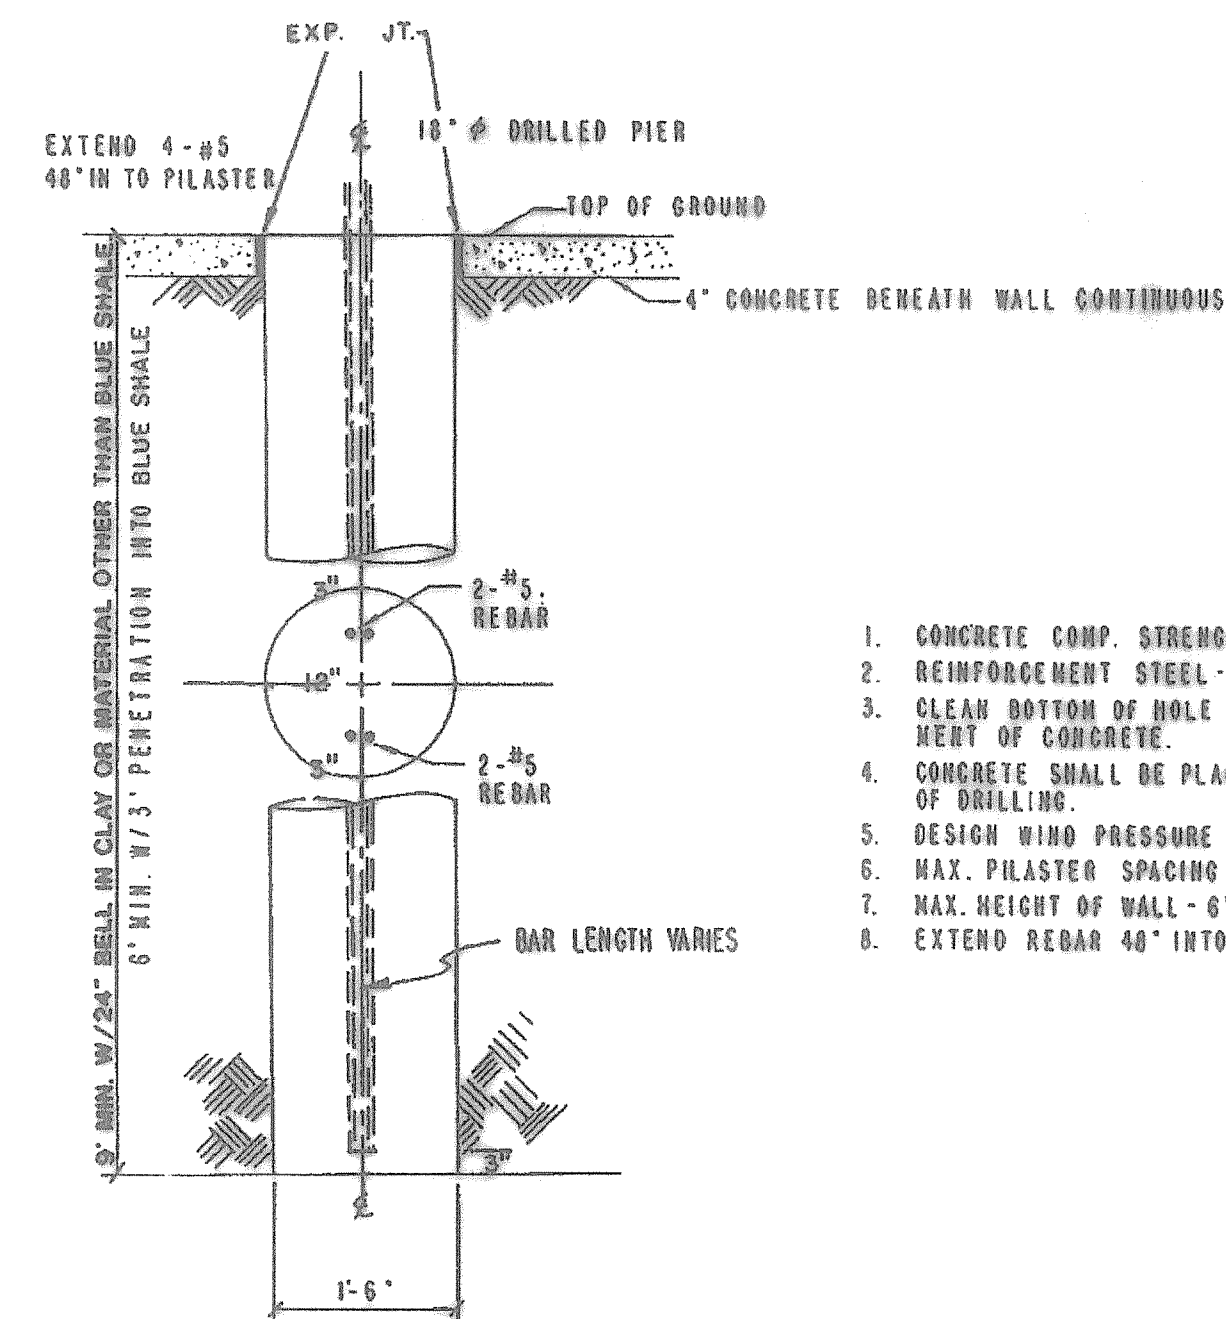

1. CONCRETE COMP. STRENGTH - 4000 P.S.I.
2. REINFORCEMENT STEEL - ASTM A615 - GR 60.
3. CLEAN BOTTOM OF HOLE PRIOR TO PLACE - MENT OF CONCRETE.
4. CONCRETE SHALL BE PLACED WITHIN 8 HOURS OF DRILLING.
5. DESIGN WIND PRESSURE - 20 PSF.
6. MAX. PILASTER SPACING - 10'-0".
7. MAX. HEIGHT OF WALL - 6'-0".
8. EXTEND REBAR 40" INTO PILASTER AND COLUMN.

PIER DETAIL

SCALE 3/4" = 1'-0"

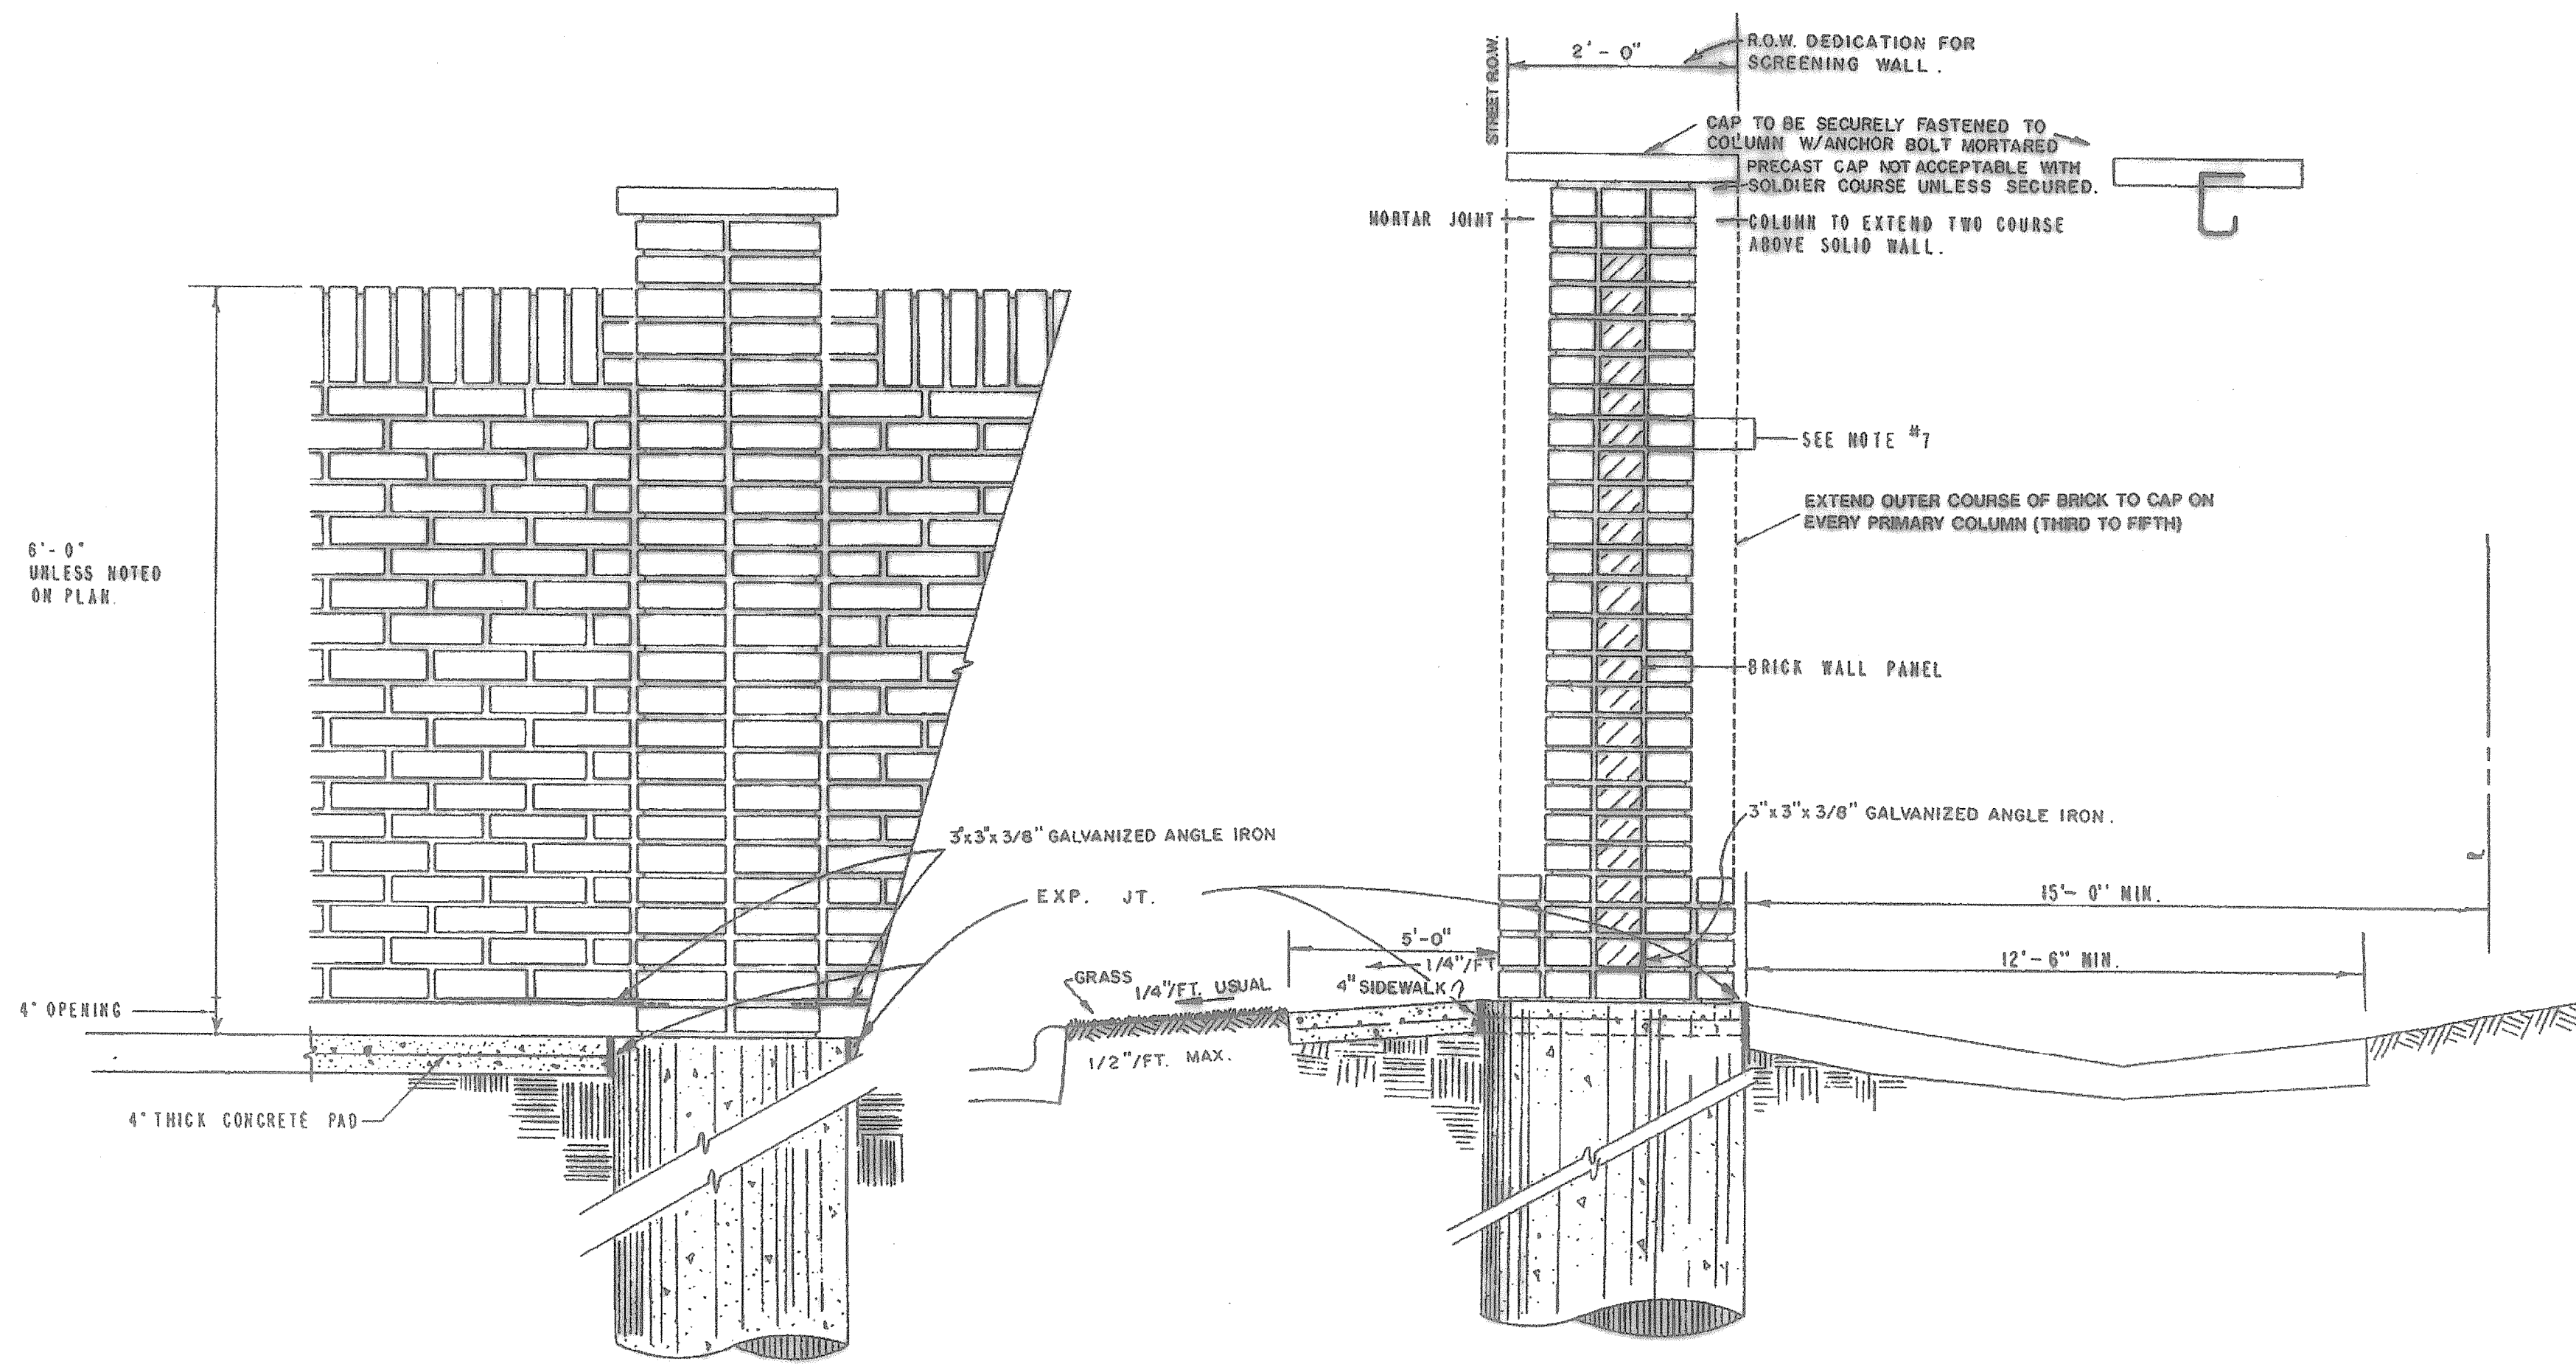

ELEVATION


SCALE 1" = 1'-0"

NOTES:

1. CONCRETE SHALL HAVE A MINIMUM COMPRESSIVE STRENGTH OF 4000 PSI AT 28 DAYS.
2. REINFORCING STEEL SHALL BE NEW BILLET STEEL CONFORMING TO THE REQUIREMENTS OF ASTM A-615-GR.60.
3. CONCRETE FOR DRILLED PIERS SHALL BE PLACED WITHIN 8 HOURS OF DRILLING PIER HOLES.
4. BRICK MASONRY SHALL BE AS SPECIFIED IN ITEM 2.3.6 OF THE SPECIAL PROVISIONS.
5. MORTAR SHALL BE TYPE 'S'.
6. CONSTRUCTION SHALL BE IN ACCORDANCE WITH THE REQUIREMENTS OF THE "RECOMMENDED PRACTICE FOR ENGINEERED BRICK MASONRY" - BRICK INSTITUTE OF AMERICA.
7. USE #9 GAUGE 1-3/4" WIDE GALVANIZED LADDER WIRE TO EXTEND HORIZONTAL IN WALL PANEL DURAWALL CORP. EVERY COURSE.
8. #9 GAUGE WIRE FABRICATED AS SHOWN BETWEEN EACH COURSE OF COLUMN BRICK.
9. THE WALL SHALL BE A MINIMUM OF SIX FEET IN HEIGHT AS MEASURED FROM THE NEAREST ALLEY EDGE OR SIDEWALK GRADE, WHICHEVER IS HIGHER. THE COLOR OF THE WALL SHALL BE LIMITED TO EARTH-TONE COLORS, EXCLUDING GREY, GREEN AND WHITE. THE COLOR OF THE WALL SHALL BE UNIFORM ON EACH SIDE OF A THROUGHFARE FOR THE ENTIRE LENGTH BETWEEN TWO INTERSECTING TYPE A, B, OR C THROUGHFARES, UNLESS OTHERWISE APPROVED BY THE ENGINEERING DEPARTMENT. THE FINISH OF THE WALL SHALL BE CONSISTENT ON ALL SURFACES.

RECORD DRAWINGS January 27, 2004
 NOTE: THE INTENT OF THE OWNER AND ENGINEER WAS TO CONSTRUCT THE IMPROVEMENTS ACCORDING TO THESE PLANS AS APPROVED BY THE CITY OF ROCKWALL. THE LINES AND GRADES WERE SET ON THE GROUND FOR CONSTRUCTION ACCORDING TO SAID PLANS. WE ARE NOT AWARE OF ANY CHANGES OR REVISIONS TO THESE PLANS DURING CONSTRUCTION EXCEPT AS NOTED ON THE PLANS.

THESE CONSTRUCTION PLANS WERE PREPARED UNDER THE RESPONSIBLE SUPERVISION OF DAN M. DOWDEY REGISTERED PROFESSIONAL ENGINEER No. 21433

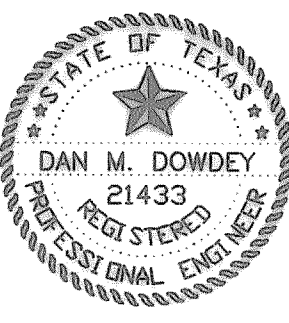

THE SEAL APPEARING ON THIS DOCUMENT WAS AUTHORIZED BY DAN M. DOWDEY P.E. # 21433

OWNER
HICKORY RIDGE, LTD.

5225 VILLAGE CREEK DRIVE SUITE 300
 (972) 931-9537 PLANO, TEXAS 75093
 CONTACT: JOHN PAPAGOLOS

NO.	DATE	BY	REVISION
1	3-3-03	JDS	CITY MARKUPS

SCREENING WALL DETAILS						
HICKORY RIDGE PHASE FOUR						
CITY OF ROCKWALL						
ROCKWALL COUNTY, TEXAS						
DOWDEY, ANDERSON & ASSOCIATES, INC.						
5225 VILLAGE CREEK DR., STE. 200		(972) 931-0694		PLANO, TEXAS		
DESIGN	DRAWN	CHECKED	DATE	SCALE	JOB	SHEET
JP	JDS	DMD	02-27-03	NTS	99066	4 / 4