



NUMBER	DESCRIPTION
300	9" HACKBERRY *
301	6" HACKBERRY *
302	6" HACKBERRY
303	16" MT. BOIS D' ARC
304	6" LOCUST
305	6" LOCUST
306	8" HACKBERRY
307	8" HACKBERRY
308	10" HACKBERRY
309	7" HACKBERRY
310	10" MT. HACKBERRY
311	7" HACKBERRY
312	15" HACKBERRY
313	7" HACKBERRY
314	10" BOIS D' ARC
315	8" BOIS D' ARC
316	6" BOIS D' ARC
317	10" MT. BOIS D' ARC
318	10" MT. BOIS D' ARC
319	8" BOIS D' ARC
320	7" BOIS D' ARC
321	7" BOIS D' ARC
322	10" BOIS D' ARC
323	7" BOIS D' ARC
324	9" MT. BOIS D' ARC
325	11" MT. BOIS D' ARC *
326	9" MT. BOIS D' ARC *
327	7" BOIS D' ARC *
328	11" BOIS D' ARC *
329	11" MT. BOIS D' ARC
330	8" MT. BOIS D' ARC
331	6" BOIS D' ARC
332	6" BOIS D' ARC
333	8" MT. BOIS D' ARC
334	10" MT. BOIS D' ARC *
335	6" LOCUST *
336	18" MT. HACKBERRY
337	12" HACKBERRY
338	15" HACKBERRY
339	11" HACKBERRY
340	15" MT. BOIS D' ARC
341	8" HACKBERRY
342	7" HACKBERRY
343	10" HACKBERRY
344	9" HACKBERRY
345	10" HACKBERRY
346	8" HACKBERRY
347	9" MT. BOIS D' ARC
348	14" MT. HACKBERRY
349	10" HACKBERRY
350	6" HACKBERRY
351	8" HACKBERRY
352	10" MT. BOIS D' ARC
353	32" MT. HACKBERRY
354	23" MT. HACKBERRY
355	7" CEDAR

NUMBER	DESCRIPTION
356	7" CEDAR
357	9" CEDAR
358	10" MT. BOIS D' ARC
359	8" MT. BOIS D' ARC
360	8" MT. BOIS D' ARC
361	7" HACKBERRY
362	12" HACKBERRY
363	16" MT. HACKBERRY
364	24" HACKBERRY
365	10" HACKBERRY
366	14" HACKBERRY
367	8" HACKBERRY
368	8" HACKBERRY
369	10" HACKBERRY
370	8" HACKBERRY
371	7" HACKBERRY
372	8" MT. HACKBERRY
373	14" MT. HACKBERRY
374	20" MT. HACKBERRY
375	9" HACKBERRY
376	14" HACKBERRY
377	19" MT. HACKBERRY
378	15" HACKBERRY
379	12" MT. HACKBERRY
380	6" HACKBERRY
381	11" HACKBERRY
382	20" MT. HACKBERRY
383	6" HACKBERRY
384	13" MT. HACKBERRY
385	18" MT. HACKBERRY
386	6" HACKBERRY
387	15" MT. HACKBERRY
388	26" MT. HACKBERRY
389	20" MT. HACKBERRY
390	14" MT. HACKBERRY
391	14" MT. HACKBERRY
392	20" MT. HACKBERRY
393	8" HACKBERRY
394	8" HACKBERRY
395	15" MT. HACKBERRY
396	8" HACKBERRY
397	22" MT. HACKBERRY
398	7" HACKBERRY
399	28" MT. HACKBERRY
400	16" MT. HACKBERRY
401	12" HACKBERRY
402	17" MT. HACKBERRY
403	8" HACKBERRY
404	27" MT. HACKBERRY
405	25" HACKBERRY
406	15" HACKBERRY
407	8" HACKBERRY
408	11" MT. HACKBERRY
409	28" MT. HACKBERRY
410	21" MT. HACKBERRY
411	10" HACKBERRY
412	9" HACKBERRY
413	29" HACKBERRY
414	9" HACKBERRY
415	18" MT. HACKBERRY
416	30" MT. HACKBERRY
417	7" HACKBERRY
418	10" MT. HACKBERRY
419	12" HACKBERRY
420	8" MT. HACKBERRY
421	10" HACKBERRY
422	13" MT. HACKBERRY
423	8" HACKBERRY
424	26" HACKBERRY
425	10" HACKBERRY
426	8" HACKBERRY
427	7" HACKBERRY
428	20" MT. HACKBERRY
429	14" MT. HACKBERRY
430	7" HACKBERRY
431	10" HACKBERRY
432	14" HACKBERRY
433	10" HACKBERRY
434	6" AMERICAN ELM
435	9" MT. HACKBERRY
436	13" MT. HACKBERRY
437	8" HACKBERRY
438	8" HACKBERRY
439	6" CEDAR
440	8" CEDAR
441	30" MT. HACKBERRY
442	8" HACKBERRY
443	7" HACKBERRY
444	6" HACKBERRY
445	20" MT. HACKBERRY
446	6" HACKBERRY
447	10" MT. HACKBERRY
448	6" HACKBERRY
449	10" MT. HACKBERRY
450	6" HACKBERRY
451	7" AMERICAN ELM
452	7" HACKBERRY
453	13" HACKBERRY
454	11" HACKBERRY
455	6" HACKBERRY
456	8" MT. BOIS D' ARC
457	8" MT. BOIS D' ARC
458	21" MT. HACKBERRY
459	16" MT. HACKBERRY
460	10" HACKBERRY
461	8" HACKBERRY
462	8" HACKBERRY
463	18" BOIS D' ARC
464	8" MT. BOIS D' ARC
465	16" MT. HACKBERRY
466	10" HACKBERRY
467	8" HACKBERRY

NUMBER	DESCRIPTION
412	9" HACKBERRY
413	29" HACKBERRY
414	9" HACKBERRY
415	18" MT. HACKBERRY
416	30" MT. HACKBERRY
417	7" HACKBERRY
418	10" MT. HACKBERRY
419	12" HACKBERRY
420	8" MT. HACKBERRY
421	10" HACKBERRY
422	13" MT. HACKBERRY
423	8" HACKBERRY
424	26" HACKBERRY
425	10" HACKBERRY
426	8" HACKBERRY
427	7" HACKBERRY
428	20" MT. HACKBERRY
429	14" MT. HACKBERRY
430	7" HACKBERRY
431	10" HACKBERRY
432	14" HACKBERRY
433	10" HACKBERRY
434	6" AMERICAN ELM
435	9" MT. HACKBERRY
436	13" MT. HACKBERRY
437	8" HACKBERRY
438	8" HACKBERRY
439	6" CEDAR
440	8" CEDAR
441	30" MT. HACKBERRY
442	8" HACKBERRY
443	7" HACKBERRY
444	6" HACKBERRY
445	20" MT. HACKBERRY
446	6" HACKBERRY
447	10" MT. HACKBERRY
448	6" HACKBERRY
449	10" MT. HACKBERRY
450	6" HACKBERRY
451	7" AMERICAN ELM
452	7" HACKBERRY
453	13" HACKBERRY
454	11" HACKBERRY
455	6" HACKBERRY
456	8" MT. BOIS D' ARC
457	8" MT. BOIS D' ARC
458	21" MT. HACKBERRY
459	16" MT. HACKBERRY
460	10" HACKBERRY
461	8" HACKBERRY
462	8" HACKBERRY
463	18" BOIS D' ARC
464	8" MT. BOIS D' ARC
465	16" MT. HACKBERRY
466	10" HACKBERRY
467	8" HACKBERRY


NUMBER	DESCRIPTION
468	8" HACKBERRY
469	7" HACKBERRY
470	7" HACKBERRY
471	21" HACKBERRY
472	8" BOIS D' ARC
473	8" HACKBERRY
474	34" MT. BOIS D' ARC
475	7" HACKBERRY
476	8" HACKBERRY
477	20" MT. HACKBERRY
478	6" HACKBERRY
479	7" HACKBERRY
480	7" HACKBERRY
481	8" HACKBERRY
482	6" HACKBERRY
483	16" MT. HACKBERRY
484	7" HACKBERRY
485	26" MT. BOIS D' ARC
486	6" CEDAR
487	6" HACKBERRY
488	6" HACKBERRY
489	6" HACKBERRY
490	7" HACKBERRY
491	10" MT. HACKBERRY
492	7" HACKBERRY
493	8" HACKBERRY
494	6" HACKBERRY
495	6" HACKBERRY
496	6" HACKBERRY
497	7" HACKBERRY
498	7" HACKBERRY
499	8" HACKBERRY
500	7" HACKBERRY
501	7" HACKBERRY
502	6" HACKBERRY
503	7" HACKBERRY
504	9" HACKBERRY
505	9" MT. HACKBERRY
506	6" HACKBERRY
507	6" HACKBERRY
508	7" HACKBERRY
509	8" MT. HACKBERRY
510	8" HACKBERRY
511	10" HACKBERRY
512	7" HACKBERRY
513	8" HACKBERRY
514	6" HACKBERRY
515	6" HACKBERRY
516	7" HACKBERRY
517	7" HACKBERRY
518	8" HACKBERRY
519	18" BOIS D' ARC
520	6" HACKBERRY
521	7" HACKBERRY
522	11" LOCUST
523	9" HACKBERRY

NUMBER	DESCRIPTION
524	21" MT. BOIS D' ARC
525	6" HACKBERRY
526	9" HACKBERRY
527	12" HACKBERRY
528	7" HACKBERRY
529	6" HACKBERRY
530	8" HACKBERRY
531	21" MT. BOIS D' ARC
532	20" BOIS D' ARC
533	9" CEDAR
534	9" CEDAR
535	10" CEDAR
536	6" HACKBERRY
537	8" BLACK WILLOW
538	12" CEDAR
539	14" CEDAR
540	23" MT. BOIS D' ARC
541	12" CEDAR
542	6" HACKBERRY
543	8" BOIS D' ARC
544	11" MT. BOIS D' ARC
545	7" BOIS D' ARC
546	12" HACKBERRY
547	10" MT. HACKBERRY
548	6" HACKBERRY
549	7" CEDAR
550	7" HACKBERRY
551	15" HACKBERRY
552	8" HACKBERRY
553	6" CEDAR
554	25" HACKBERRY
555	12" HACKBERRY
556	7" WALKING STICK
557	13" MT. HACKBERRY
558	6" CEDAR
559	6" CEDAR
560	19" MT. HACKBERRY
561	6" CEDAR
562	6" CEDAR
563	6" CEDAR
564	7" CEDAR
565	7" CEDAR
566	27" MT. HACKBERRY
567	6" CEDAR *
568	6" CEDAR *
569	6" CEDAR *
570	6" CEDAR *
571	6" CEDAR *
572	8" CEDAR *
573	7" CEDAR *
574	7" CEDAR *

NOTES:

- ALL TREES WITHIN THE RIGHT-OF-WAY OF STATE HIGHWAY NO. 205 BYPASS THAT WILL BE REMOVED ARE NOT SUBJECT TO MITIGATION.
- MITIGATION SUMMARY:
TREES REMOVED = 16 TOTAL (POINT NO. 300, 301, 325-328, 334, 335, 567-574)
TOTAL INCHES REMOVED = 121"
REPLACEMENT TREES REQUIRED = 41 TREES AT 3" CALIPER EACH
PLACEMENT TO BE IN LANDSCAPE AREA ALONG S.H. 205 BYPASS.

RECORD DRAWINGS January 27, 2004
NOTE: THE INTENT OF THE OWNER AND ENGINEER WAS TO CONSTRUCT THE IMPROVEMENTS ACCORDING TO THESE PLANS AS APPROVED BY THE CITY OF ROCKWALL. THE LINES AND GRADES WERE SET ON THE GROUND FOR CONSTRUCTION ACCORDING TO SAID PLANS. WE ARE NOT AWARE OF ANY CHANGES OR REVISIONS TO THESE PLANS DURING CONSTRUCTION EXCEPT AS NOTED ON THE PLANS.

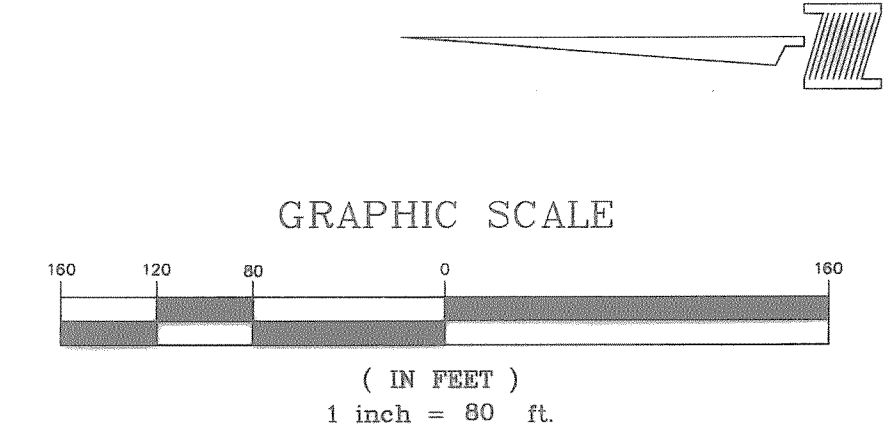

- * TO BE REMOVED
- TO BE SAVED

DATE: 2-4-2008

Designed By: _____
Drawn By: _____
Approved By: _____

Issued For: CONSTRUCTION
Job No. 021715.00
Scale 1" = 80'-0"

STATE OF TEXAS
JOE D. GRUBBS
1713

HICKORY RIDGE
PHASE FOUR
ROCKWALL, TEXAS

Date: _____

Revisions: _____

Sheet Title: **TREE SURVEY & REPLACEMENT PLAN**

Sheet Number: **1**
of 2 sheets