




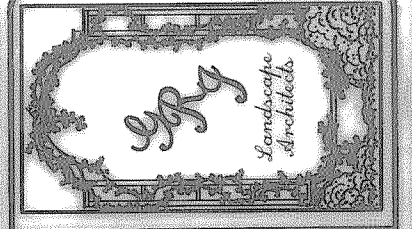

RECORD DRAWINGS January 27, 2004  
 NOTE: THE INTENT OF THE OWNER AND ENGINEER WAS TO CONSTRUCT THE IMPROVEMENTS ACCORDING TO THESE PLANS AS APPROVED BY THE CITY OF ROCKWALL. THE LINES AND GRADES WERE SET ON THE GROUND FOR CONSTRUCTION ACCORDING TO SAID PLANS. WE ARE NOT AWARE OF ANY CHANGES OR REVISIONS TO THESE PLANS DURING CONSTRUCTION EXCEPT AS NOTED ON THE PLANS.

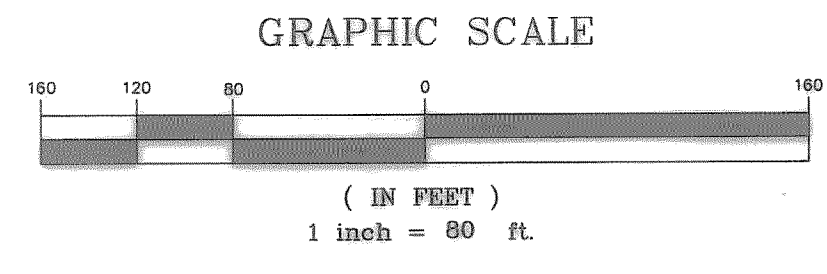

Issued For:	CONSTRUCTION
Job No.:	02173.00
Scale:	1" = 80'-0"
Designed By:	
Drawn By:	
Approved By:	
DATE:	2-4-2003

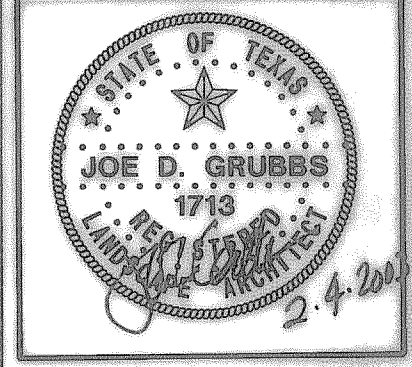

# HICKORY RIDGE

## PHASE FOUR

ROCKWALL, TEXAS

Date:	
Revisions:	

Sheet Title:  
**TREE SURVEY & REPLACEMENT PLAN**

Sheet Number:  
 2  
 of 2 Sheets