



HORIZONTAL SECTION
1"=2'

BENCHMARK:
SQUARE CUT ON TOP OF HEADWALL AT THE MOST NORTHERLY
CORNER OF BRIDGE. NORTHEASTERLY SIDE OF FM 205.
1680' NORTHWEST OF CL OF MIMS ROAD.
ELEV = 529.11

BENCHMARK:
CITY OF ROCKWALL, TEXAS CONTROL MONUMENT #929. TOP OF
HEADWALL IN NORTHWEST CORNER OF BRIDGE OVER SQUABBLE
CREEK. SOUTHWESTERLY SIDE OF FM 205.
ELEV = 524.55

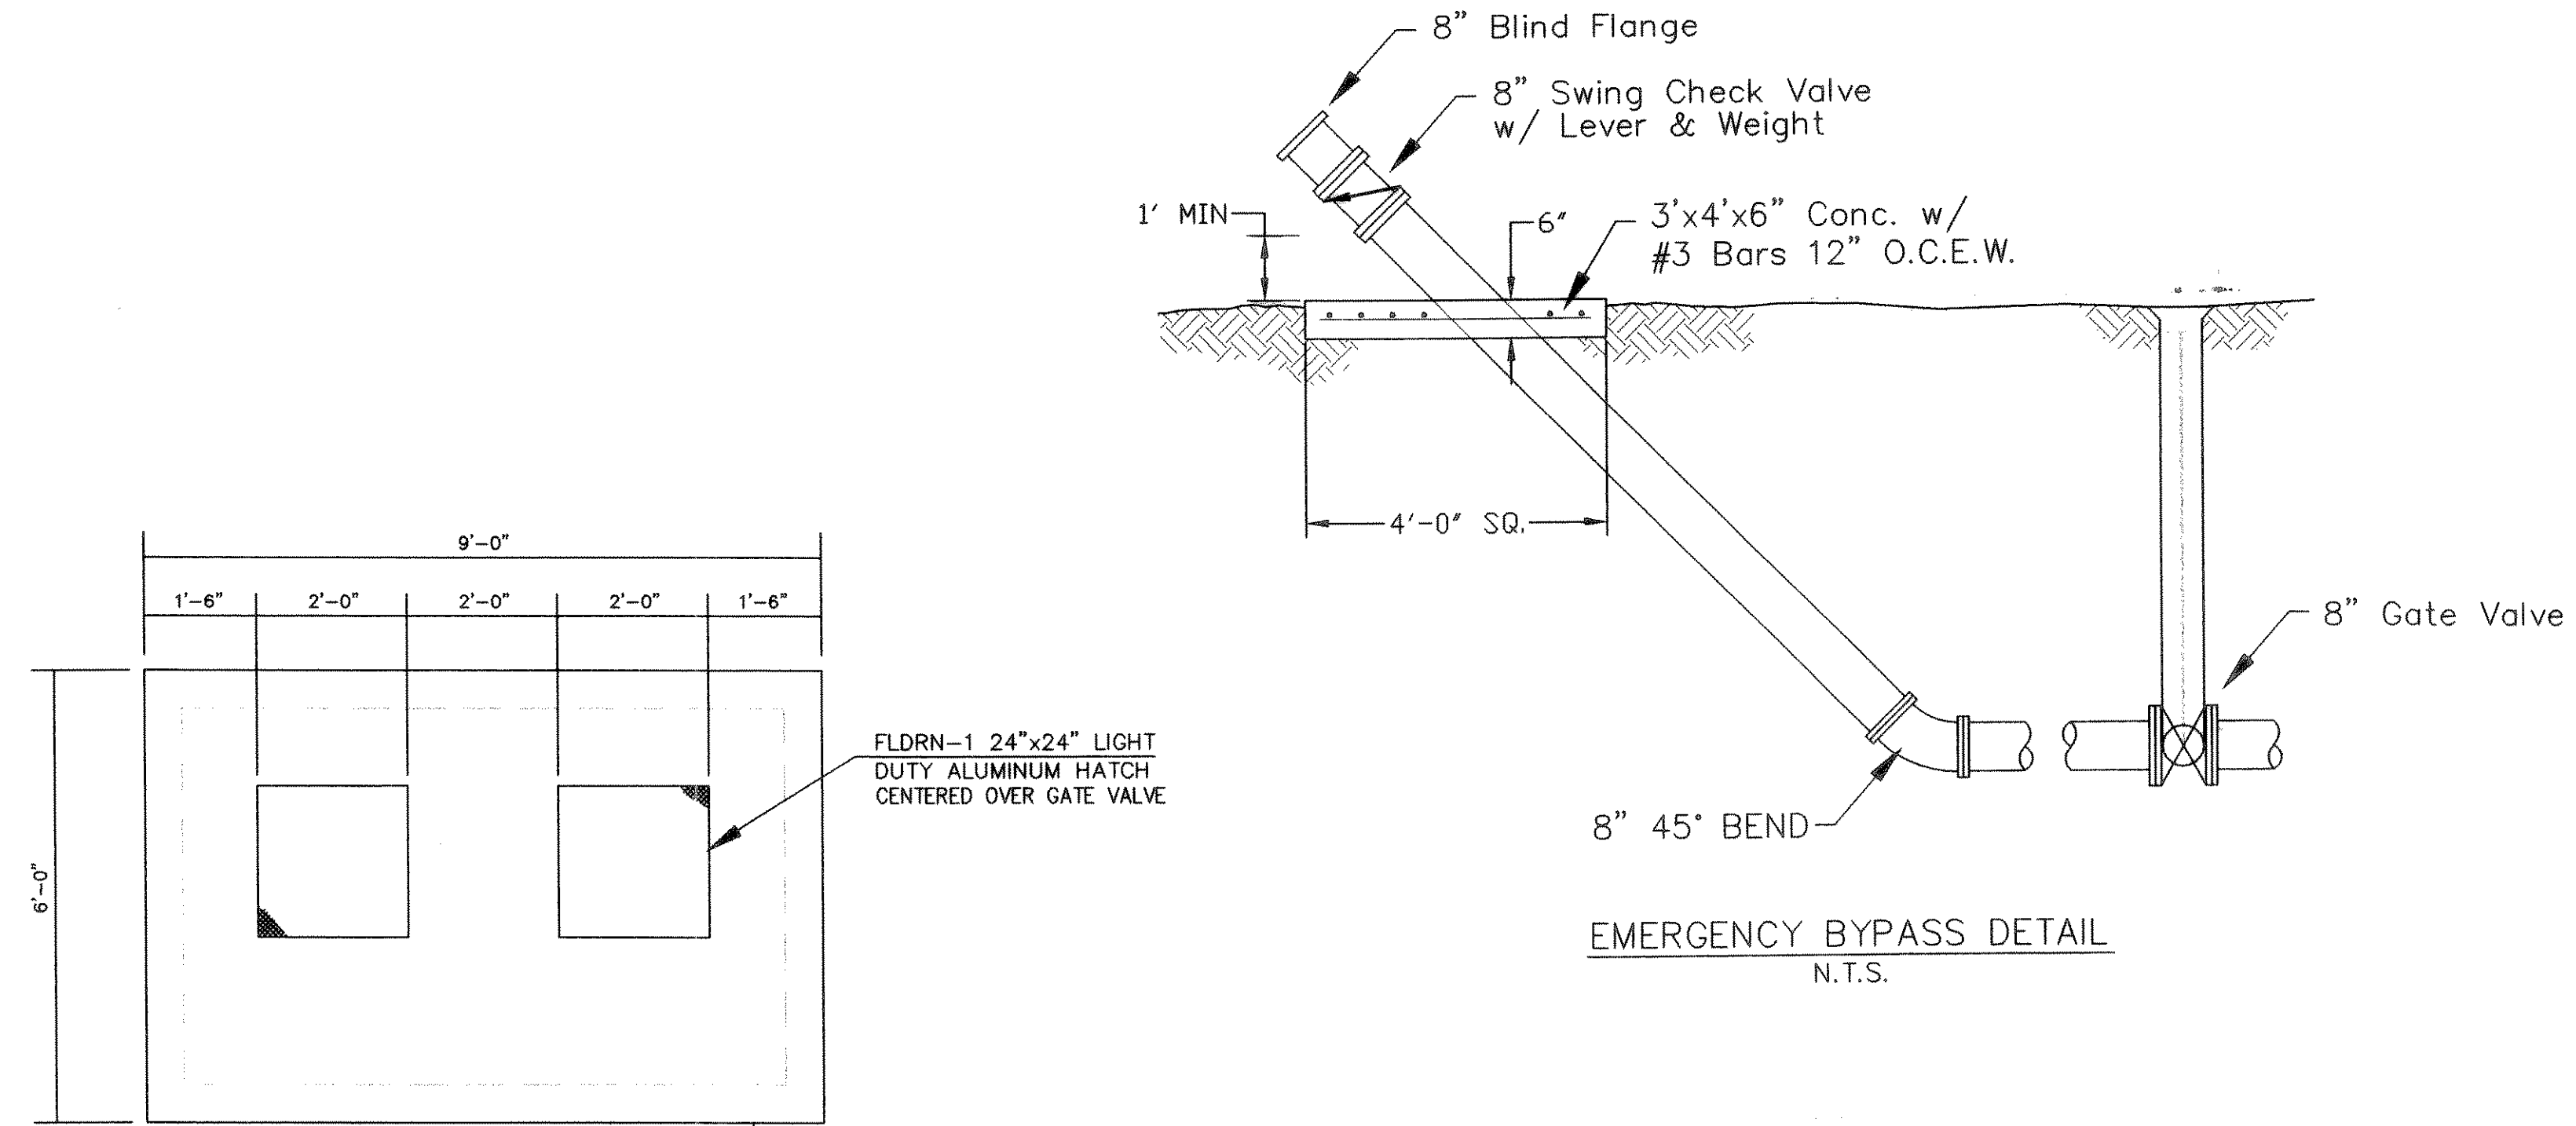

EMERGENCY BYPASS DETAIL
N.T.S.

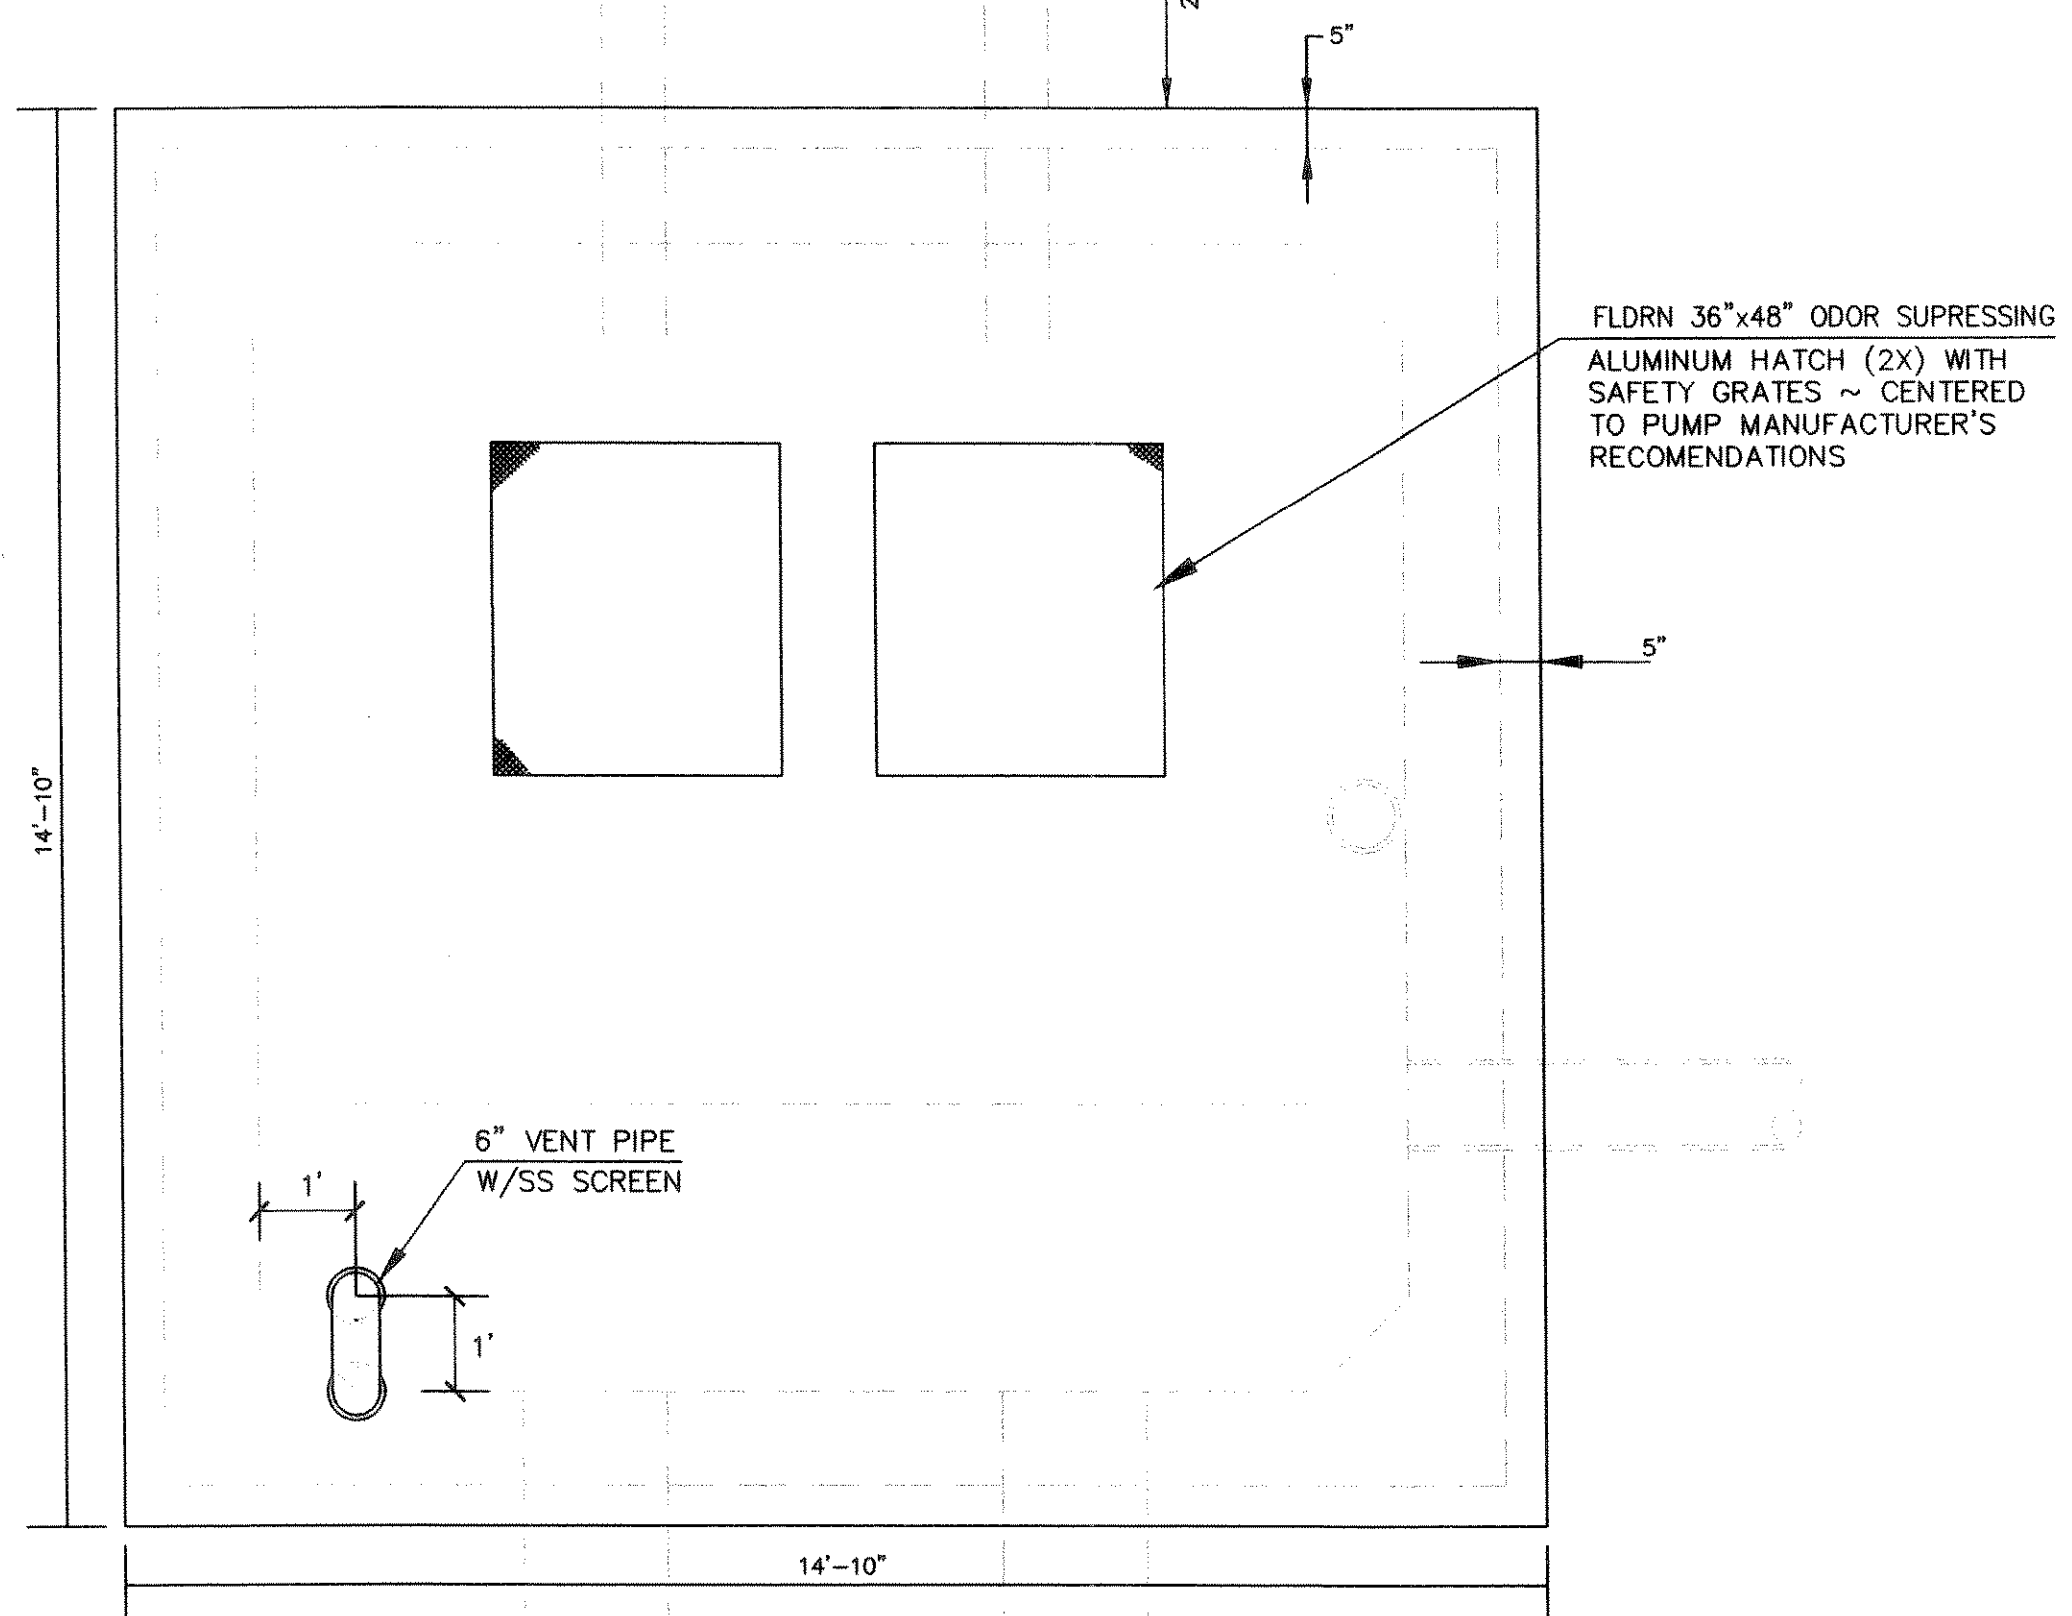

TOP VIEW
1"=2'

RECORD DRAWINGS January 27, 2004
NOTE: THE INTENT OF THE OWNER AND
ENGINEER WAS TO CONSTRUCT THE
IMPROVEMENTS ACCORDING TO THESE
PLANS AS APPROVED BY THE CITY OF
ROCKWALL. THE LINES AND GRADES
WERE SET ON THE GROUND FOR
CONSTRUCTION ACCORDING TO SAID
PLANS. WE ARE NOT AWARE OF ANY
CHANGES OR REVISION TO THESE PLANS
DURING CONSTRUCTION EXCEPT AS
NOTED ON THE PLANS.

HORIZONTAL SECTION

**LIFT STATION DETAILS
HICKORY RIDGE PHASE FOUR**

CITY OF ROCKWALL

ROCKWALL COUNTY, TEXAS

DOWDEY, ANDERSON & ASSOCIATES, INC.
5225 VILLAGE CREEK DR., STE. 200 (972) 931-0894 PLANO, TEXAS

DESIGN	DRAWN	CHECKED	DATE	SCALE	JOB	SHEET
DLH	DLH	DMD	MAR 2003	1"=2'	99-066	3/6

THESE CONSTRUCTION PLANS WERE PREPARED
UNDER THE RESPONSIBLE SUPERVISION OF DAN
M. DOWDEY, REGISTERED PROFESSIONAL ENGINEER
NO. 21433.



Dan M. Dowdey 02/14/03

NO.	DATE	BY	REVISION
1	3-3-03	DLH	CITY MARKUPS
2	3-31-03	DLH	CITY MARKUPS