


BENCHMARK:
 SQUARE CUT ON TOP OF HEADWALL AT THE MOST NORTHERLY
 CORNER OF BRIDGE. NORTHEASTERLY SIDE OF FM 205.
 1680' NORTHWEST OF CL OF MIMS ROAD.
 ELEV = 529.11

BENCHMARK:
 CITY OF ROCKWALL, TEXAS CONTROL MONUMENT #929. TOP OF
 HEADWALL IN NORTHWEST CORNER OF BRIDGE OVER SQUABBLE
 CREEK. SOUTHWESTERLY SIDE OF FM 205.
 ELEV = 524.55

These construction plans were prepared
 under the responsible supervision of
 Dan M. Dowdey, Registered Professional
 Engineer No. 21433

Dan M. Dowdey 12/10/03

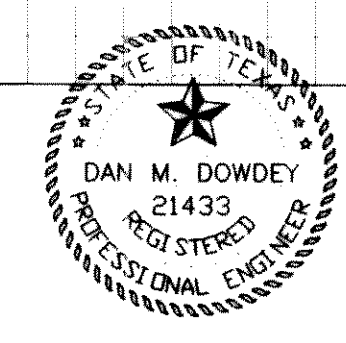

RECORD DRAWINGS January 27, 2004
 NOTE: THE INTENT OF THE OWNER AND
 ENGINEER WAS TO CONSTRUCT THE
 IMPROVEMENTS ACCORDING TO THESE
 PLANS AS APPROVED BY THE CITY OF
 ROCKWALL. THE LINES AND GRADES
 WERE SET ON THE GROUND FOR
 CONSTRUCTION ACCORDING TO SAID
 PLANS. WE ARE NOT AWARE OF ANY
 CHANGES OR REVISION TO THESE PLANS
 DURING CONSTRUCTION EXCEPT AS
 NOTED ON THE PLANS.

| NO. | DATE | BY | REVISION |
|-----|---------|-----|--------------|
| 1 | 3-3-03 | JDS | CITY MARKUPS |
| 2 | 3-14-03 | JDS | CITY MARKUPS |

**LINE 'A' (CONT.)
 LINE 'B' & LINE 'C'**

**SANITARY SEWER PROFILES
 HICKORY RIDGE - PHASE FOUR**

CITY OF ROCKWALL
 ROCKWALL COUNTY, TEXAS

DOWDEY, ANDERSON & ASSOCIATES, INC.
 5225 VILLAGE CREEK DRIVE (972) 931-0694 PLANO, TEXAS

| DESIGN | DRAWN | CHECKED | DATE | SCALE | JOB | SHEET |
|--------|-------|---------|-----------|---------------------|--------|-------|
| JDS | LAC | MSD | DEC. 2002 | 1" = 40' 1" = 4' | 99-066 | 2 / 5 |