


**STORM SEWER PLAN & PROFILE**  
**HICKORY RIDGE PHASE FOUR**  
 CITY OF ROCKWALL  
 ROCKWALL COUNTY, TEXAS

<b>DOWDEY, ANDERSON &amp; ASSOCIATES, INC.</b>					
5225 VILLAGE CREEK DR., STE. 200 (972) 931-0694 PLANO, TEXAS					
DESIGN	DRAWN	CHECKED	DATE	SCALE	JOB SHEET
JDS	JDS	MSD	DEC. 2001	H: 1"=40' V: 1"=4'	99-066 3/12

**BENCHMARK:**  
 SQUARE CUT ON TOP OF HEADWALL AT THE MOST NORTHERLY CORNER OF BRIDGE. NORTHEASTERLY SIDE OF FM 205. 1680' NORTHWEST OF CL OF MIMS ROAD. ELEV = 529.11

**BENCHMARK:**  
 CITY OF ROCKWALL, TEXAS CONTROL MONUMENT #929. TOP OF HEADWALL IN NORTHWEST CORNER OF BRIDGE OVER SQUABBLE CREEK. SOUTHWESTERLY SIDE OF FM 205. ELEV = 524.55

These construction plans were prepared under the responsible supervision of Dan M. Dowdey, Registered Professional Engineer No. 21433

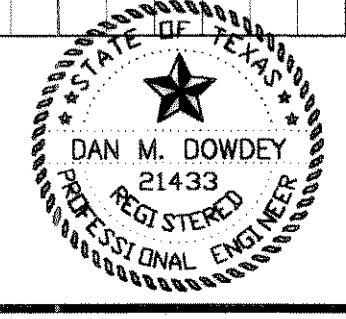

NO.	DATE	BY	REVISION
3	3-31-03	JDS	RELOCATED OUTFALL ON LINE "B" & INLETS 13 & F-1
4	7-25-03	JDS	RELOCATED OUTFALL ON LINE "B"
5	8-18-03	JDS	DISSIPATERS ON HEADWALL
6	12-16-03	JDS	WINGWALL MODIFICATION
7	2-4-04	MSD	ADD STEEL POST BOLLARDS

*Dan M. Dowdey* PE 02/24/04