


**RECORD DRAWINGS** - January 27, 2004  
 NOTE: THE INTENT OF THE OWNER AND ENGINEER WAS TO CONSTRUCT THE IMPROVEMENTS ACCORDING TO THESE PLANS AS APPROVED BY THE CITY OF ROCKWALL. THE LINES AND GRADES WERE SET ON THE GROUND FOR CONSTRUCTION ACCORDING TO SAID PLANS. WE ARE NOT AWARE OF ANY CHANGES OR REVISIONS TO THESE PLANS DURING CONSTRUCTION EXCEPT AS NOTED ON THE PLANS.

**LINES 'C-1', 'D-1' & 'F'**  
**STORM SEWER PLAN & PROFILE**  
**HICKORY RIDGE PHASE FOUR**  
 CITY OF ROCKWALL  
 ROCKWALL COUNTY, TEXAS

BENCHMARK: SQUARE CUT ON TOP OF HEADWALL AT THE MOST NORTHERLY CORNER OF BRIDGE, NORTHEASTERLY SIDE OF FM 205. 1680' NORTHWEST OF CL OF MIMS ROAD. ELEV = 529.11

BENCHMARK: CITY OF ROCKWALL, TEXAS CONTROL MONUMENT #929. TOP OF HEADWALL IN NORTHWEST CORNER OF BRIDGE OVER SQUABBLE CREEK, SOUTHWESTERLY SIDE OF FM 205. ELEV = 524.55

These construction plans were prepared under the responsible supervision of Dan M. Dowdey, Registered Professional Engineer No. 21433

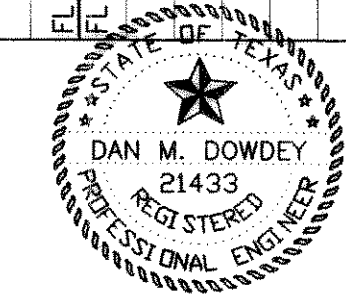

| NO. | DATE    | BY  | REVISION     |
|-----|---------|-----|--------------|
| 1   | 3-3-03  | JDS | CITY MARKUPS |
| 2   | 3-14-03 | JDS | CITY MARKUPS |

| DESIGN | DRAWN | CHECKED | DATE      | SCALE                 | JOB    | SHEET |
|--------|-------|---------|-----------|-----------------------|--------|-------|
| JDS    | JDS   | MSD     | DEC. 2001 | H: 1"=40'<br>V: 1"=4' | 99-066 | 6     |