


CONSTRUCTION PLANS

HICKORY RIDGE PHASE ONE

CITY OF ROCKWALL
ROCKWALL COUNTY, TEXAS

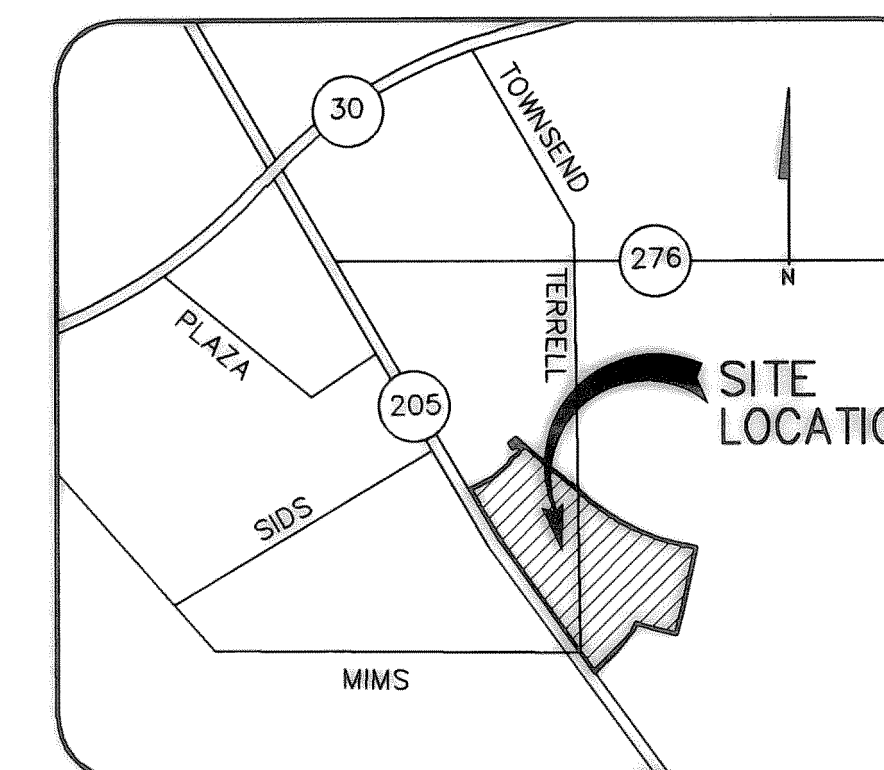

LOCATION MAP

N.T.S.

OWNER

HICKORY RIDGE, LTD.

5225 VILLAGE CREEK DRIVE SUITE 300
(972) 931-9537 PLANO, TEXAS 75093

DEVELOPER

PAPAGOLOS DEVELOPMENT COMPANY

5225 VILLAGE CREEK DRIVE SUITE 300
(972) 931-9537 PLANO, TEXAS 75093


ENGINEER

DOWDEY, ANDERSON & ASSOCIATES, INC.

5225 VILLAGE CREEK DRIVE SUITE 200
(972) 931-0694 PLANO, TEXAS 75093

RECORD DRAWINGS OCT. 8, 2001
NOTE: THE INTENT OF THE OWNER AND ENGINEER WAS TO CONSTRUCT THE IMPROVEMENTS ACCORDING TO THESE PLANS AS APPROVED BY THE CITY OF ROCKWALL. THE LINES AND GRADES WERE SET ON THE GROUND FOR CONSTRUCTION ACCORDING TO SAID PLANS. WE ARE NOT AWARE OF ANY CHANGES OR REVISIONS TO THESE PLANS DURING CONSTRUCTION EXCEPT AS NOTED ON THE PLANS.

THESE CONSTRUCTION PLANS WERE PREPARED UNDER THE RESPONSIBLE SUPERVISION OF DAN M. DOWDEY REGISTERED PROFESSIONAL ENGINEER No. 21433

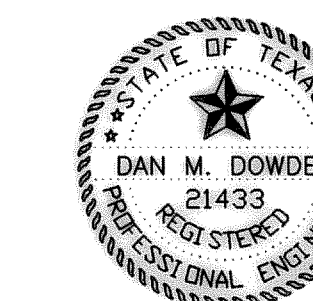

THE SEAL APPEARING ON THIS DOCUMENT WAS AUTHORIZED BY DAN M. DOWDEY P.E. # 21433

INDEX	
PLATE	DESCRIPTION
	COVER SHEET
1-3	FINAL PLAN
4-23A	PAVING PLAN & PROFILES
24	DRAINAGE AREA MAP
25-32	STORM SEWER PLAN & PROFILES
33	WATER AND SANITARY SEWER PLAN
34-36	SANITARY SEWER PROFILES
37	12" WATER LINE PROFILES
38-39	16" WATER LINE PLAN & PROFILES
40-42	GRADING PLANS
43	LEFT TURNING LANE & TRAFFIC CONTROL
44	STORMWATER POLLUTION PREVENTION PLAN
45-46	LANDSCAPE AND WALL PLANS
47-50	TREE SURVEY PLANS