


OVERLAY 44' WIDTH (OR EXIST. ROAD WIDTH) x 600', 1 1/2" TYPE "C"

NOTE:
 ALL TRAFFIC CONTROL AND PROTECTIVE DEVICES USED MUST CONFORM TO THE TEXAS MANUAL ON UNIFORM TRAFFIC CONTROL DEVICES FOR STREETS AND HIGHWAYS, PART VI IN PARTICULAR.
 THE CONTRACTOR SHALL CONTACT THE TEXAS DEPARTMENT OF TRANSPORTATION PRIOR TO DOING ANY WORK WITHIN THE STATE RIGHT OF WAY.

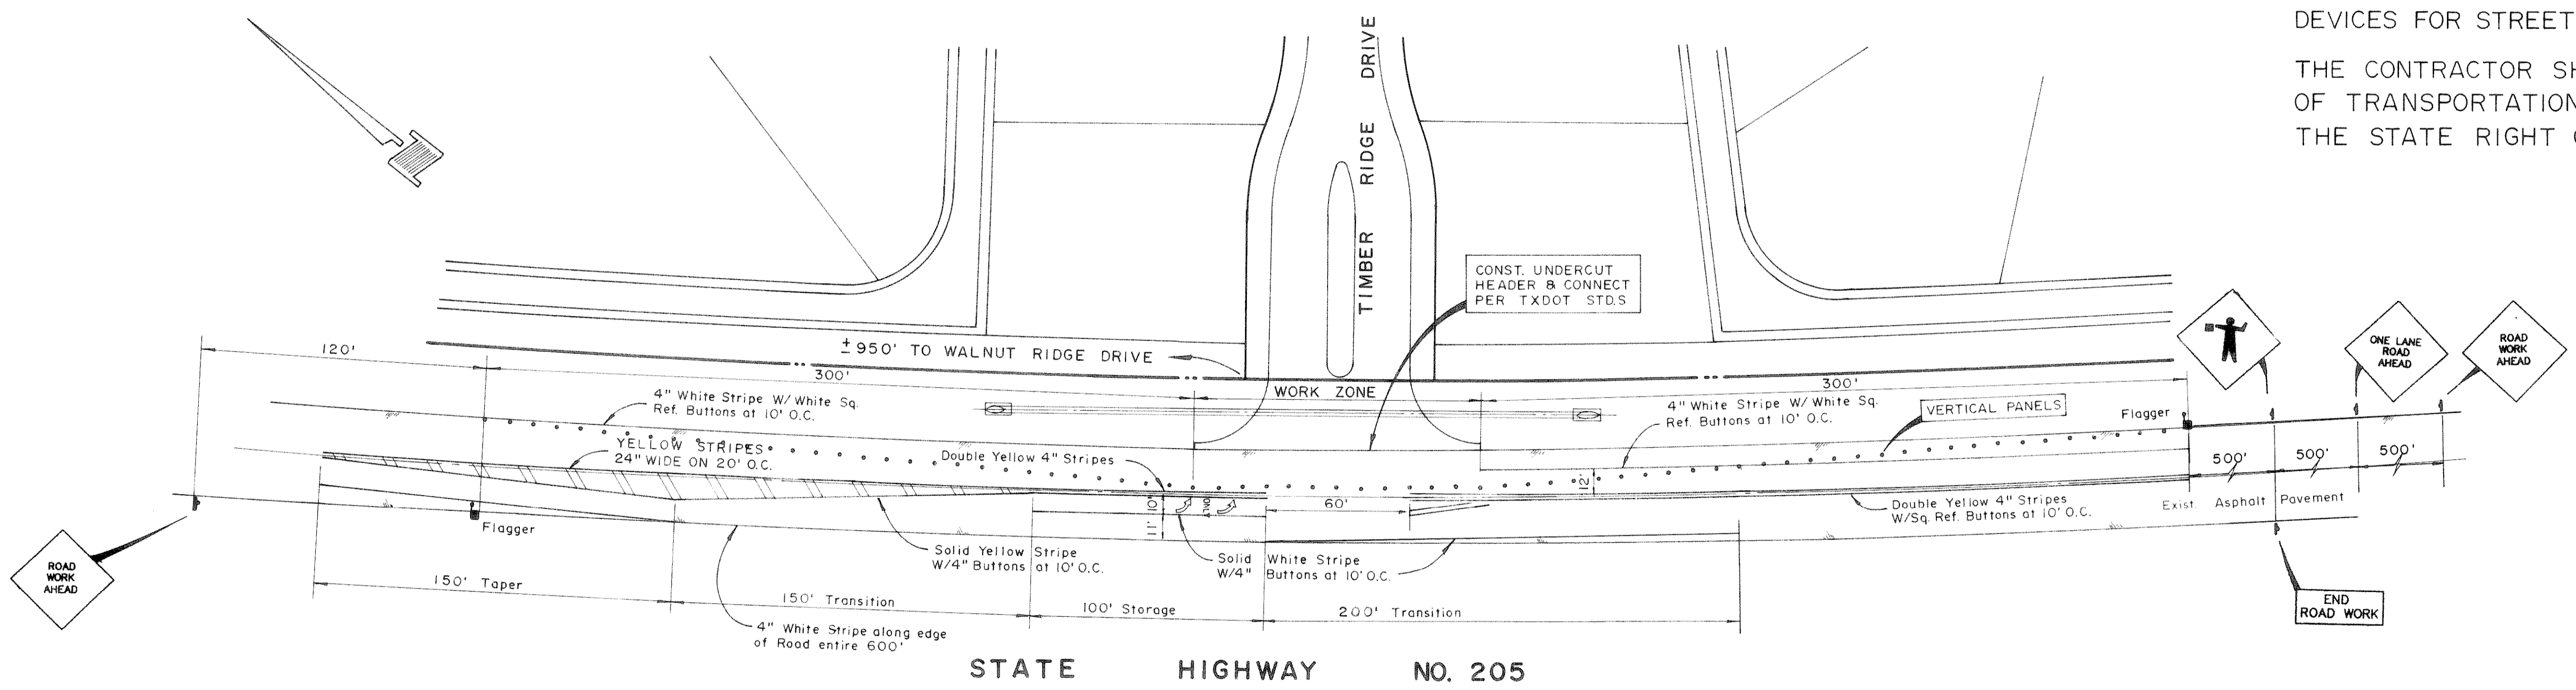

OVERLAY 44' WIDTH (OR EXIST. ROAD WIDTH) x 600', 1 1/2" TYPE "C"

RECORD DRAWINGS OCT. 8, 2001
 NOTE: THE INTENT OF THE OWNER AND ENGINEER WAS TO CONSTRUCT THE IMPROVEMENTS ACCORDING TO THESE PLANS AS APPROVED BY THE CITY OF ROCKWALL. THE LINES AND GRADES WERE SET ON THE GROUND FOR CONSTRUCTION ACCORDING TO SAID PLANS. WE ARE NOT AWARE OF ANY CHANGES OR REVISIONS TO THESE PLANS DURING CONSTRUCTION EXCEPT AS NOTED ON THE PLANS.

THESE CONSTRUCTION PLANS WERE PREPARED UNDER THE RESPONSIBLE SUPERVISION OF DAN M. DOWDEY, REGISTERED PROFESSIONAL ENGINEER NO. 21433.

Dan M. Dowdey 10-17-01

**LEFT TURN DETAILS & TRAFFIC CONTROL PLANS
 HICKORY RIDGE PHASE ONE**

CITY OF ROCKWALL
 ROCKWALL COUNTY, TEXAS

DOWDEY, ANDERSON & ASSOCIATES, INC.
 5225 VILLAGE CREEK DRIVE SUITE 200
 (972) 931-0694 PLANO, TEXAS 75093

NO	DATE	BY	REVISION
1	10/22/01	R.E.	AS BUILTS: REVISED STRIPING

DESIGN	DRAWN	CHECKED	DATE	SCALE	JOB	SHEET
D.M.D.	R.E.	D.M.D.	11-00	1" = 40'	99-066	1/1