

ENTRY WALL WITH SIGN

LARGE TREES / ORNAMENTAL TREES			
QUANTITY	SYMBOL	CALLOUT	SIZE & CONDITION
23		Live Oak, Red Oak or Cedar Elm	7'-8' Ht., 3'-4' spread, 3" caliper B & B straight trunk
9		Crape Myrtle	Multi-trunk, 6'-8' Ht., clustered

SHRUBS			
QUANTITY	SYMBOL	CALLOUT	SIZE & CONDITION
406		Red Tip Photina	5 gallon, 24" spread, bushy

LANDSCAPE AREA	
Lot 1, Block X	0.31 Ac.
Lot 2, Block X	0.13 Ac.


**RECORD DRAWINGS OCT. 8, 2001**  
 NOTE: THE INTENT OF THE OWNER AND ENGINEER WAS TO CONSTRUCT THE IMPROVEMENTS ACCORDING TO THESE PLANS AS APPROVED BY THE CITY OF ROCKWALL. THE LINES AND GRADES WERE SET ON THE GROUND FOR CONSTRUCTION ACCORDING TO SAID PLANS. WE ARE NOT AWARE OF ANY CHANGES OR REVISION TO THESE PLANS DURING CONSTRUCTION EXCEPT AS NOTED ON THE PLANS.

NOTES:  
 1. 3" Tree to be either, Live Oak, Red Oak or Cedar Elm.


**OWNER**  
**HICKORY RIDGE, LTD.**  
 5225 VILLAGE CREEK DRIVE SUITE 300  
 (972) 931-9537 PLANO, TEXAS 75093  
 CONTACT: JOHN PAPAGOLOS

NO.	DATE	BY	REVISION
1	10-24-01	R.E.	ADDED 2"x2" BRICK COLUMNS W/BRICK CAPS


**LANDSCAPE & WALL PLAN**  
**HICKORY RIDGE PHASE ONE**  
 CITY OF ROCKWALL  
 ROCKWALL COUNTY, TEXAS  
**DOWDEY, ANDERSON & ASSOCIATES, INC.**  
 5225 VILLAGE CREEK DR., STE. 200 (972) 931-0694 PLANO, TEXAS  
 DESIGN: JP DRAWN: MPC CHECKED: DD DATE: 09-00 SCALE: 1"=20' JOB: 99-066 SHEET: 1/2

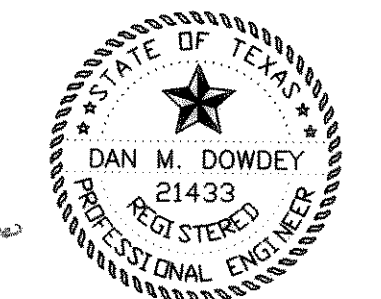

THE SEAL APPEARING ON THIS DOCUMENT WAS AUTHORIZED BY DAN M. DOWDEY P.E. # 21433

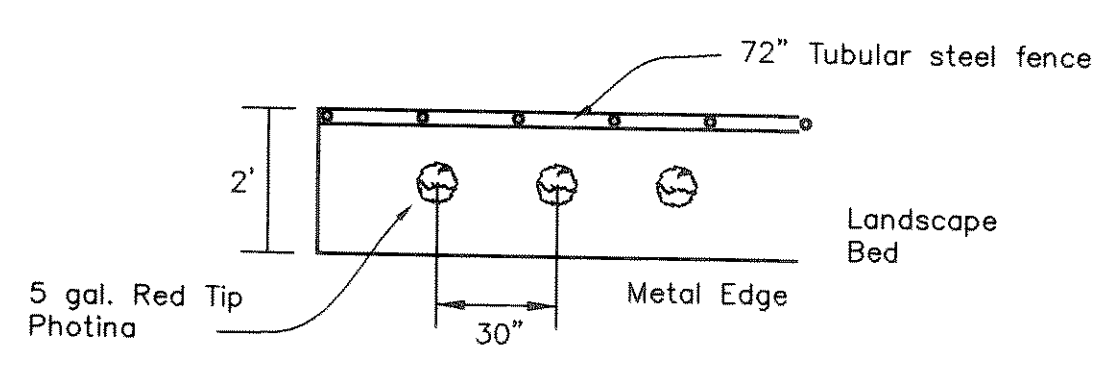

LIVING SCREEN DETAIL

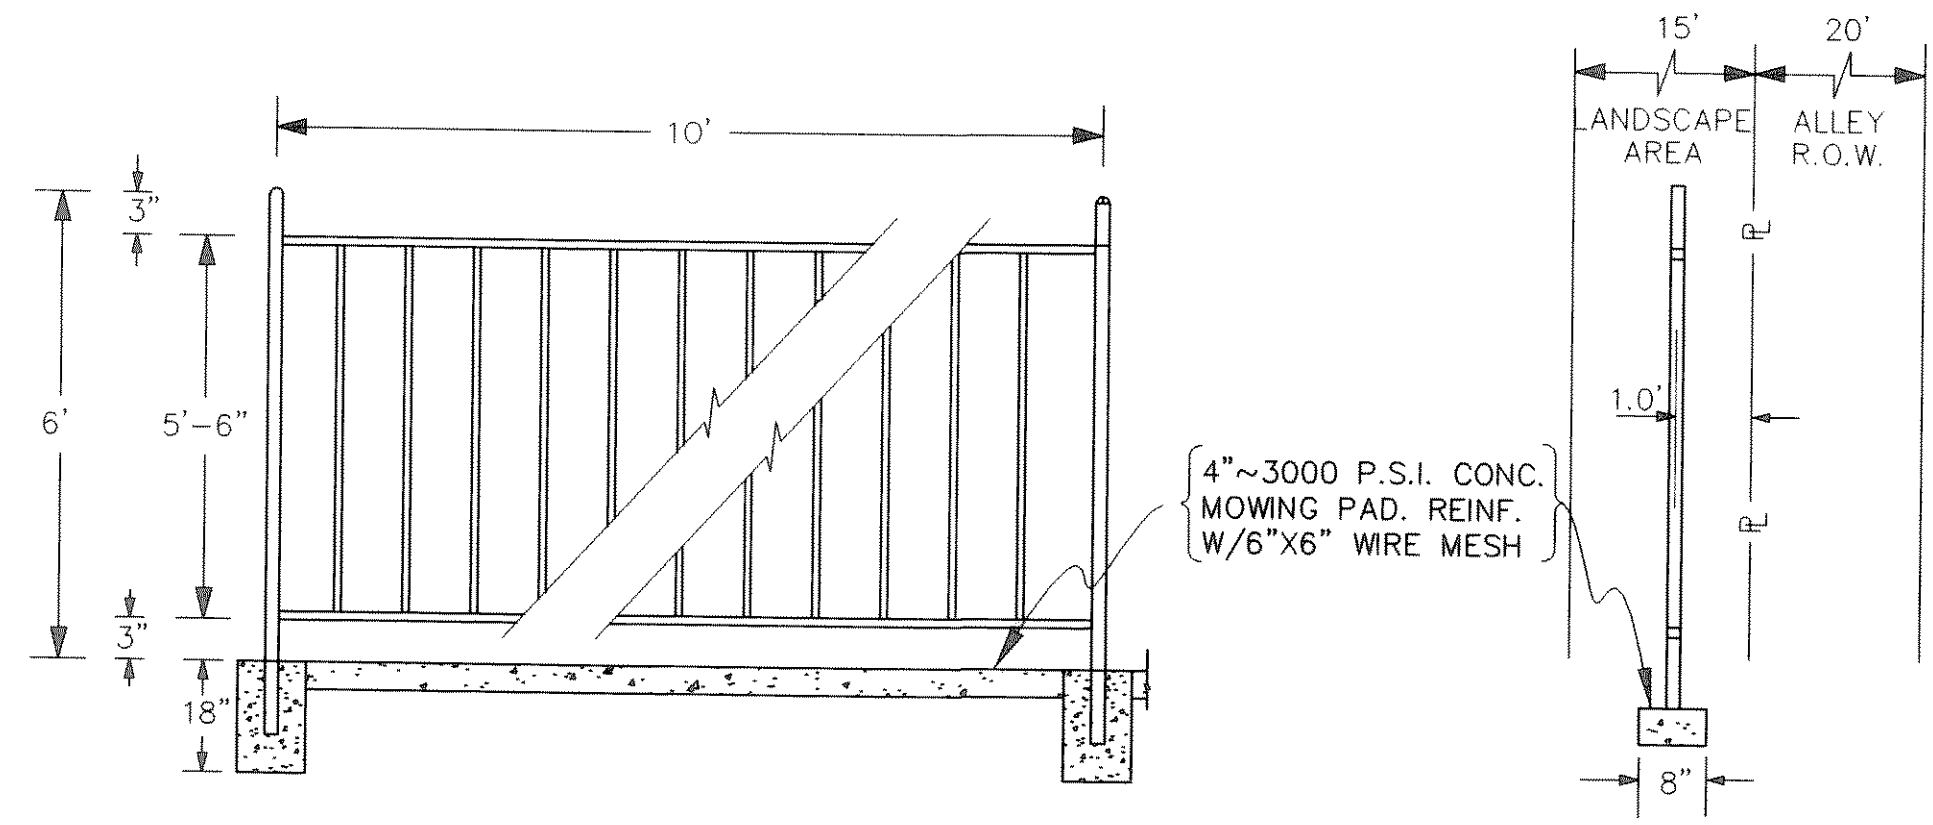

TYPICAL TUBULAR STEEL FENCE SECTION

NOT TO SCALE  
 • PRIME AND PAINT  
 • ACTUAL DIMENSION WILL VARY