

# CONSTRUCTION PLANS

# HICKORY RIDGE PHASE ONE

CITY OF ROCKWALL  
ROCKWALL COUNTY, TEXAS

## OWNER

HICKORY RIDGE, LTD.

5225 VILLAGE CREEK DRIVE SUITE 300  
(972) 931-9537 PLANO, TEXAS 75093

## DEVELOPER


PAPAGOLOS DEVELOPMENT COMPANY

5225 VILLAGE CREEK DRIVE SUITE 300  
(972) 931-9537 PLANO, TEXAS 75093


## ENGINEER

DOWDEY, ANDERSON & ASSOCIATES, INC.

5225 VILLAGE CREEK DRIVE SUITE 200  
(972) 931-0694 PLANO, TEXAS 75093

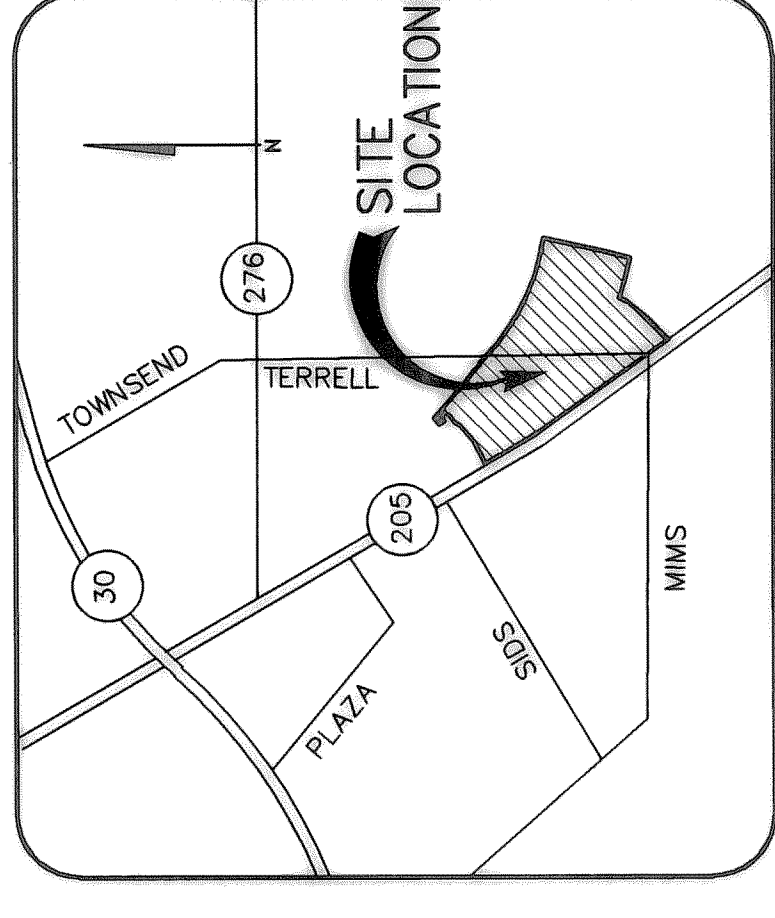

RECORD DRAWINGS OCT. 8, 2001  
NOTE: THE INTENT OF THE OWNER AND ENGINEER WAS TO CONSTRUCT THE IMPROVEMENTS ACCORDING TO THESE PLANS AS APPROVED BY THE CITY OF ROCKWALL. THE LINES AND GRADES WERE SET ON THE GROUND FOR CONSTRUCTION ACCORDING TO SAID PLANS. WE ARE NOT AWARE OF ANY CHANGES OR REVISIONS TO THESE PLANS DURING CONSTRUCTION EXCEPT AS NOTED ON THE PLANS.

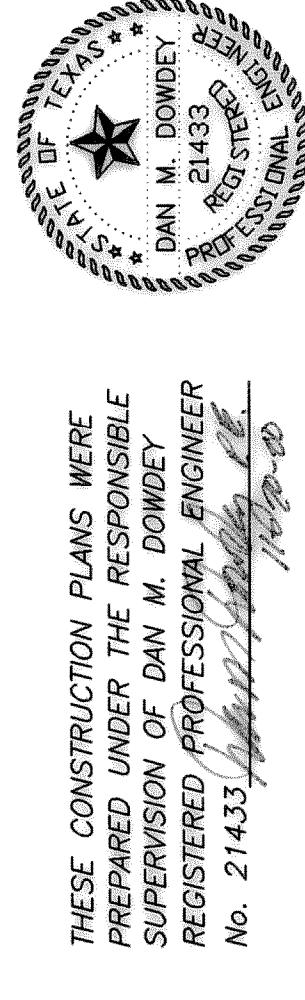

THESE CONSTRUCTION PLANS WERE PREPARED UNDER THE RESPONSIBLE SUPERVISION OF DAN M. DOWDEY, REGISTERED PROFESSIONAL ENGINEER No. 21433.

THE SEAL APPEARING ON THIS DOCUMENT WAS AUTHORIZED BY DAN M. DOWDEY P.E. # 21433

| INDEX       |                                      |
|-------------|--------------------------------------|
| PLATE       | DESCRIPTION                          |
| COVER SHEET |                                      |
| 1-3         | FINAL PLAT                           |
| 4-23A       | PAVING PLAN & PROFILES               |
| 24          | DRAINAGE AREA MAP                    |
| 25-32       | STORM SEWER PLAN & PROFILES          |
| 33          | WATER AND SANITARY SEWER PLAN        |
| 34-36       | SANITARY SEWER PROFILES              |
| 37          | 12" WATER LINE PROFILES              |
| 38-39       | 16" WATER LINE PLAN & PROFILES       |
| 40-42       | GRADING PLANS                        |
| 43          | LEFT TURNING LANE & TRAFFIC CONTROL  |
| 44          | STORMWATER POLLUTION PREVENTION PLAN |
| 45-46       | LANDSCAPE AND WALL PLANS             |
| 47-50       | TREE SURVEY PLANS                    |