


BENCHMARK:  
 SQUARE CUT ON TOP OF HEADWALL AT THE MOST NORTHERLY  
 CORNER OF BRIDGE. NORTHEASTERLY SIDE OF FM 205.  
 1680± NORTHWEST OF CL OF MIMS ROAD.  
 ELEV = 529.11

BENCHMARK:  
 CITY OF ROCKWALL, TEXAS CONTROL MONUMENT #929. TOP OF  
 HEADWALL IN NORTHWEST CORNER OF BRIDGE OVER SQUABBLE  
 CREEK. SOUTHWESTERLY SIDE OF FM 205.  
 ELEV = 524.55

THESE CONSTRUCTION PLANS WERE  
 PREPARED UNDER THE RESPONSIBLE  
 SUPERVISION OF DAN M. DOWDEY  
 REGISTERED PROFESSIONAL ENGINEER  
 No. 21433. *[Signature]*

THE SEAL APPEARING ON THIS  
 DOCUMENT WAS AUTHORIZED BY  
 DAN M. DOWDEY P.E. # 21433

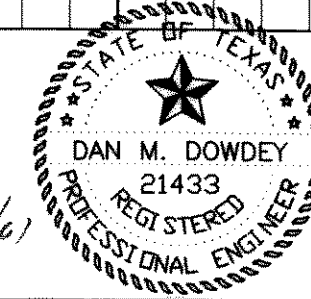

NO.	DATE	BY	REVISION
1	2/5/01	JDS	Revised San. Swr. Lines "B" & "C"

**LINE 'B' (CONT.) & LINE 'C'**  
**SANITARY SEWER PROFILES**  
**HICKORY RIDGE, PHASE ONE**

CITY OF ROCKWALL  
 ROCKWALL COUNTY, TEXAS

**DOWDEY, ANDERSON & ASSOCIATES, INC.**  
 5225 VILLAGE CREEK DRIVE (972) 931-0694 PLANO, TEXAS

DESIGN	DRAWN	CHECKED	DATE	SCALE	JOB	SHEET
LAC	LAC	DD	09-00	1" = 40' 1" = 4'	99-066	2 / 3