


CONSTRUCTION PLANS

HICKORY RIDGE PHASE THREE

CITY OF ROCKWALL
ROCKWALL COUNTY, TEXAS

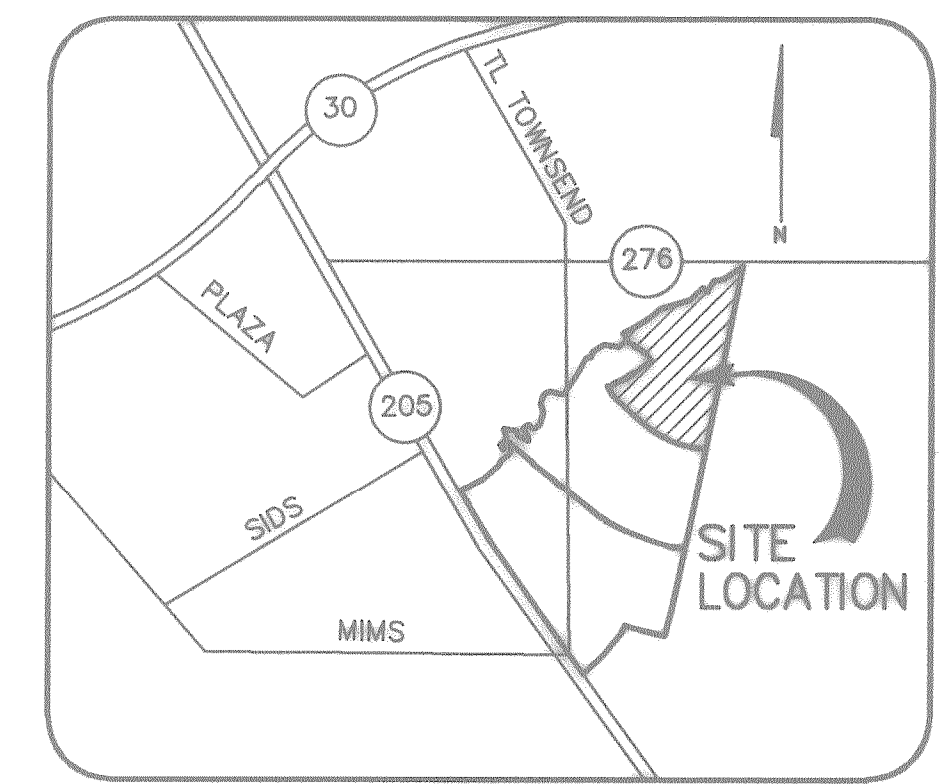

LOCATION MAP

N.T.S.

RECORD DRAWINGS AUGUST 19, 2002
NOTE: THE INTENT OF THE OWNER AND ENGINEER WAS TO CONSTRUCT THE IMPROVEMENTS ACCORDING TO THESE PLANS AS APPROVED BY THE CITY OF ROCKWALL. THE LINES AND GRADES WERE SET ON THE GROUND FOR CONSTRUCTION ACCORDING TO SAID PLANS. WE ARE NOT AWARE OF ANY CHANGES OR REVISIONS TO THESE PLANS DURING CONSTRUCTION EXCEPT AS NOTED ON THE PLANS.

OWNER

HICKORY RIDGE, LTD.

5225 VILLAGE CREEK DRIVE SUITE 300
(972) 931-9537 PLANO, TEXAS 75093

DEVELOPER

PAPAGOLOS DEVELOPMENT COMPANY

5225 VILLAGE CREEK DRIVE SUITE 300
(972) 931-9537 PLANO, TEXAS 75093

ENGINEER

DOWDEY, ANDERSON & ASSOCIATES, INC.

5225 VILLAGE CREEK DRIVE SUITE 200
(972) 931-0694 PLANO, TEXAS 75093

THESE CONSTRUCTION PLANS WERE PREPARED UNDER THE RESPONSIBLE SUPERVISION OF DAN M. DOWDEY REGISTERED PROFESSIONAL ENGINEER No. 21433



THE SEAL APPEARING ON THIS DOCUMENT WAS AUTHORIZED BY DAN M. DOWDEY P.E. # 21433

INDEX

PLATE	DESCRIPTION
	COVER SHEET
1-2	FINAL PLAT
3-8	PAVING PLAN & PROFILES
9	BARRIER FREE RAMP DETAILS
10	DRAINAGE AREA MAP
11-12	STORM SEWER PLAN & PROFILES
13	WATER AND SANITARY SEWER PLAN
14-15	SANITARY SEWER PROFILES
16	12" WATER LINE PROFILE
17-18	GRADING PLANS
19	STORMWATER POLLUTION PREVENTION PLAN
20-21	TREE SURVEY PLANS