


- 1. LATERALS TO BE LOCATED 6 FEET FROM PROPERTY LINE OR AS STAKED BY THE ENGINEER
- 2. SERVICE TEES TO BE WYE CONNECTIONS.

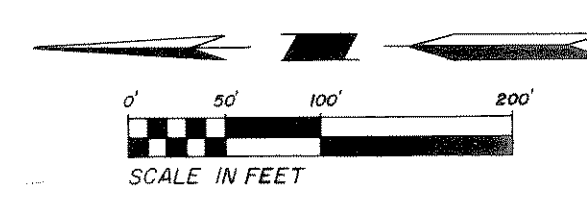

**HIGHLAND
HILLS
ADDITION**

"AS BUILT"

REVISED 4-30-70


1
2

PROPOSED SANITARY SEWERS

HIGHLAND HILLS ADDITION

CITY OF ROCKWALL, TEXAS

DESIGN	DRAWN	DATE	SCALE	NOTES	FILE	NO.
H.L.E.	J.	DEC. 69	1"=100'	G.P.P.		

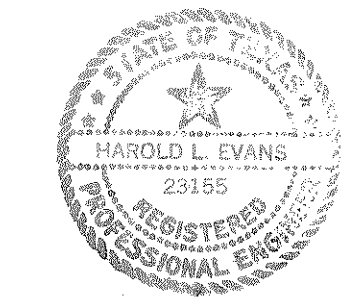

7916