

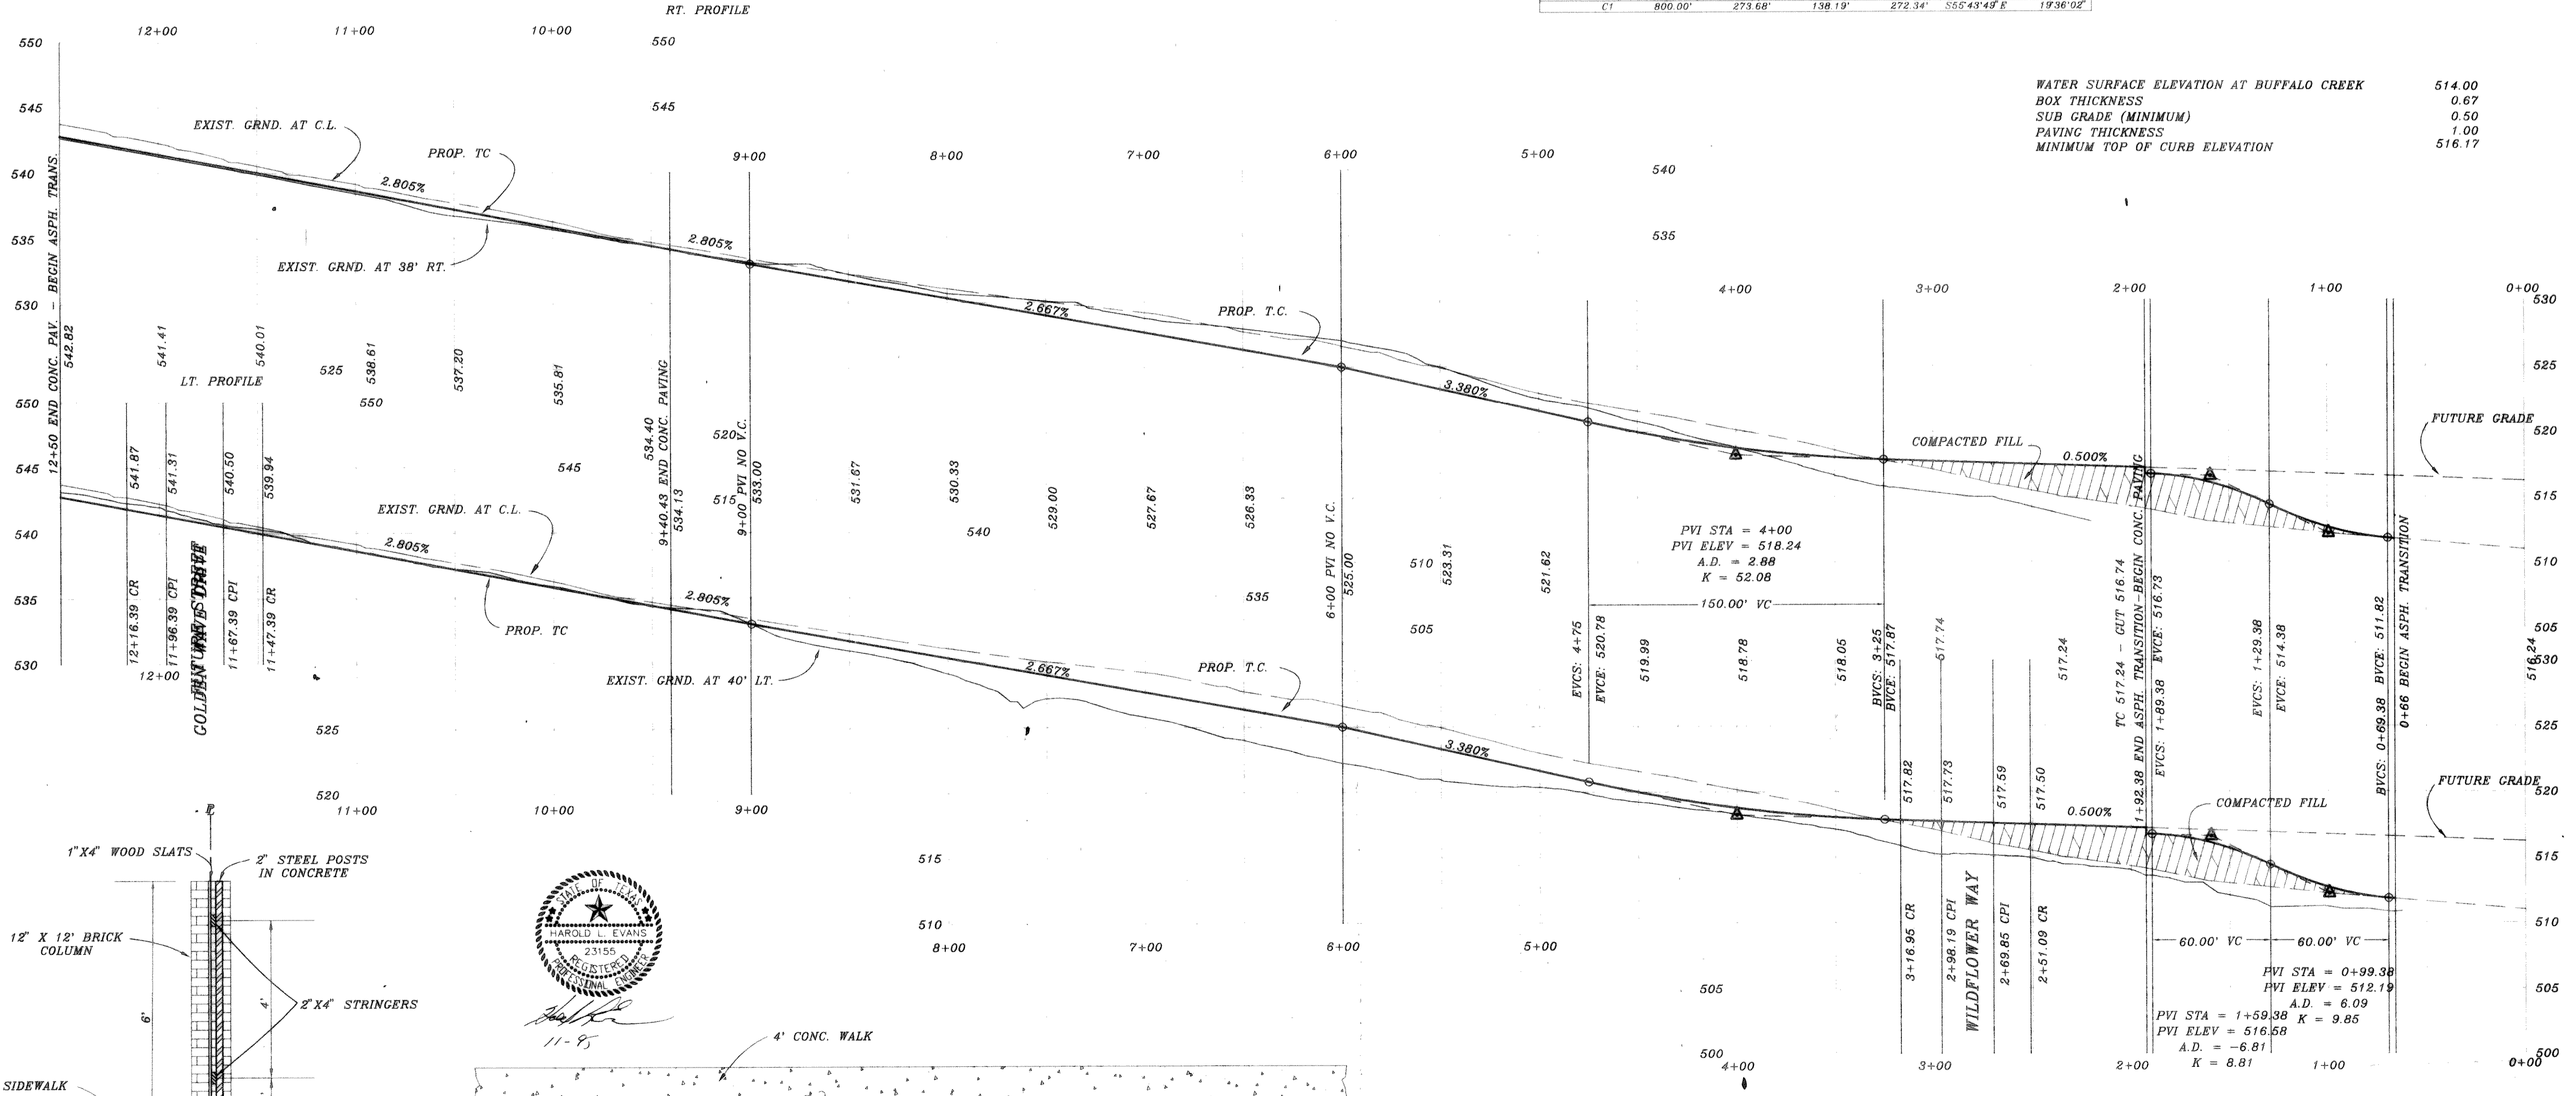


CURVE	RADIUS	LENGTH	TANGENT	CHORD	BEARING	DELTA
C1	800.00'	273.68'	138.19'	272.34'	S55°43'48" E	19°36'02"

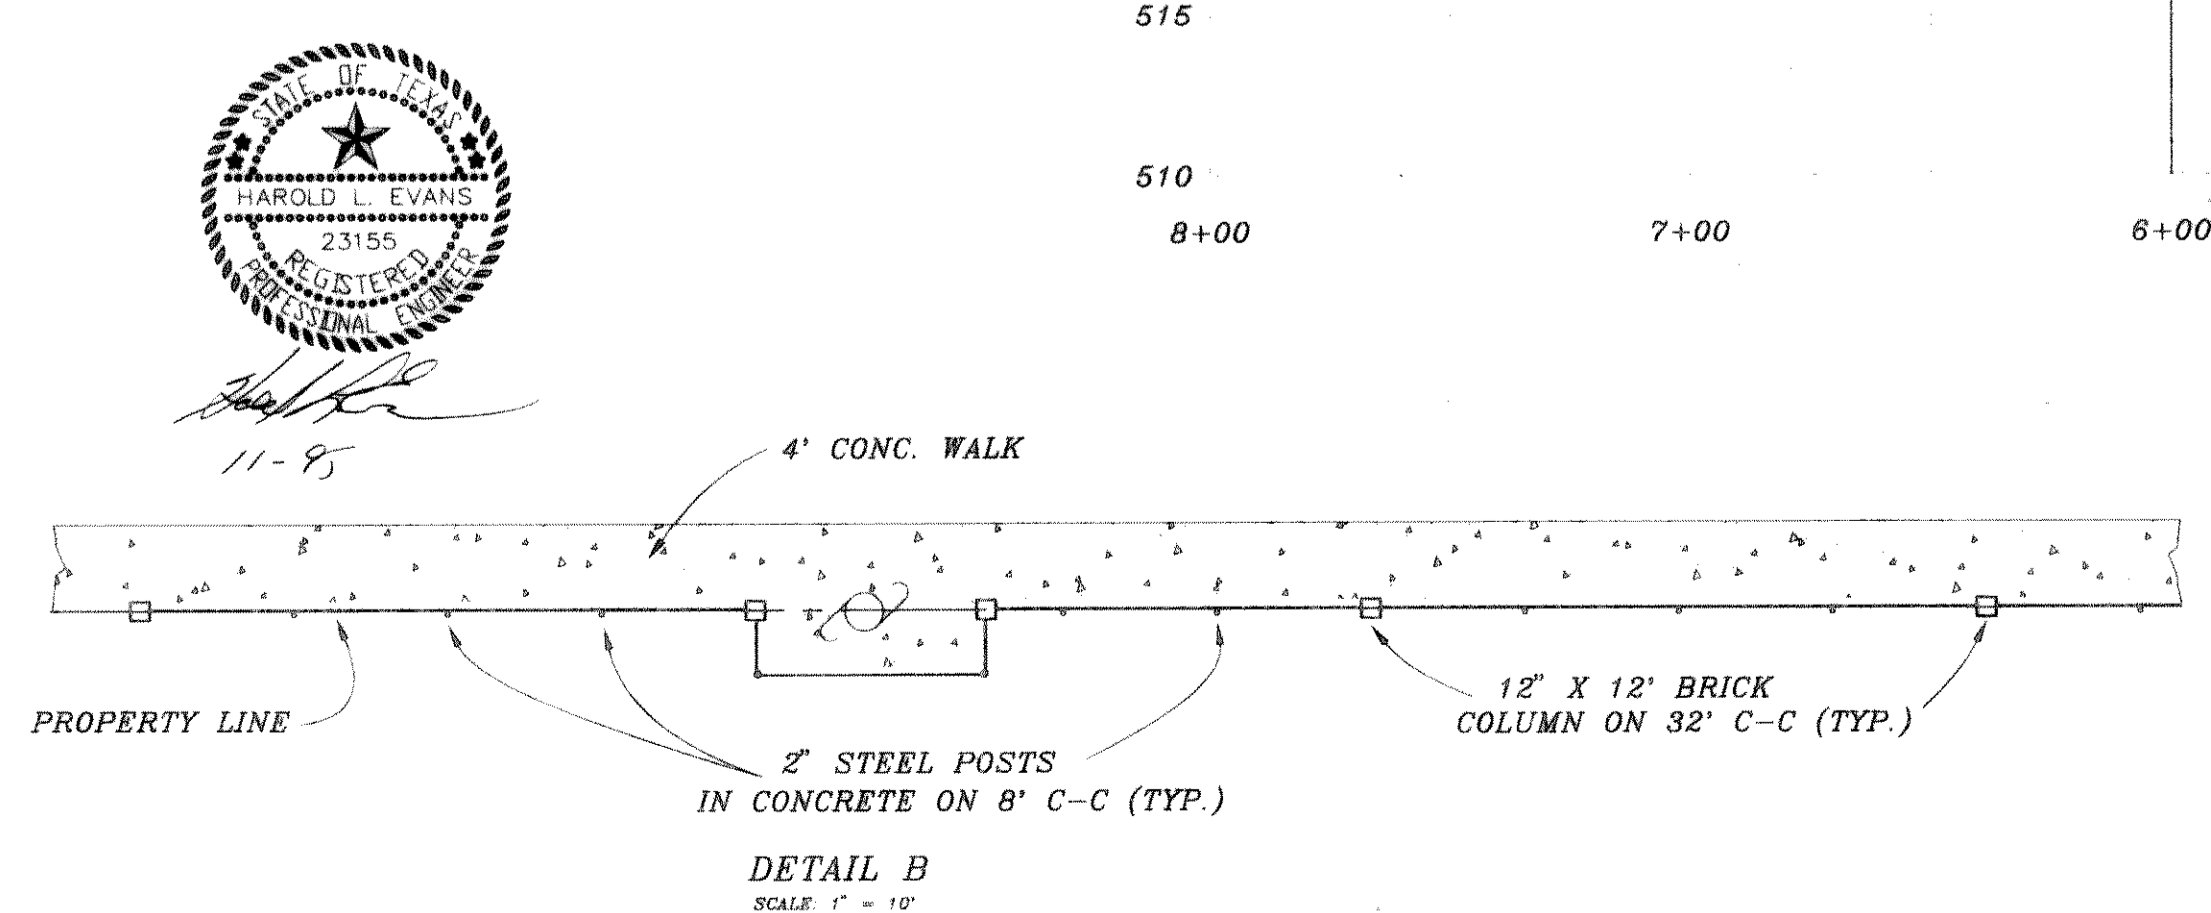

WATER SURFACE ELEVATION AT BUFFALO CREEK	514.00
BOX THICKNESS	0.67
SUB GRADE (MINIMUM)	0.50
PAVING THICKNESS	1.00
MINIMUM TOP OF CURB ELEVATION	516.17

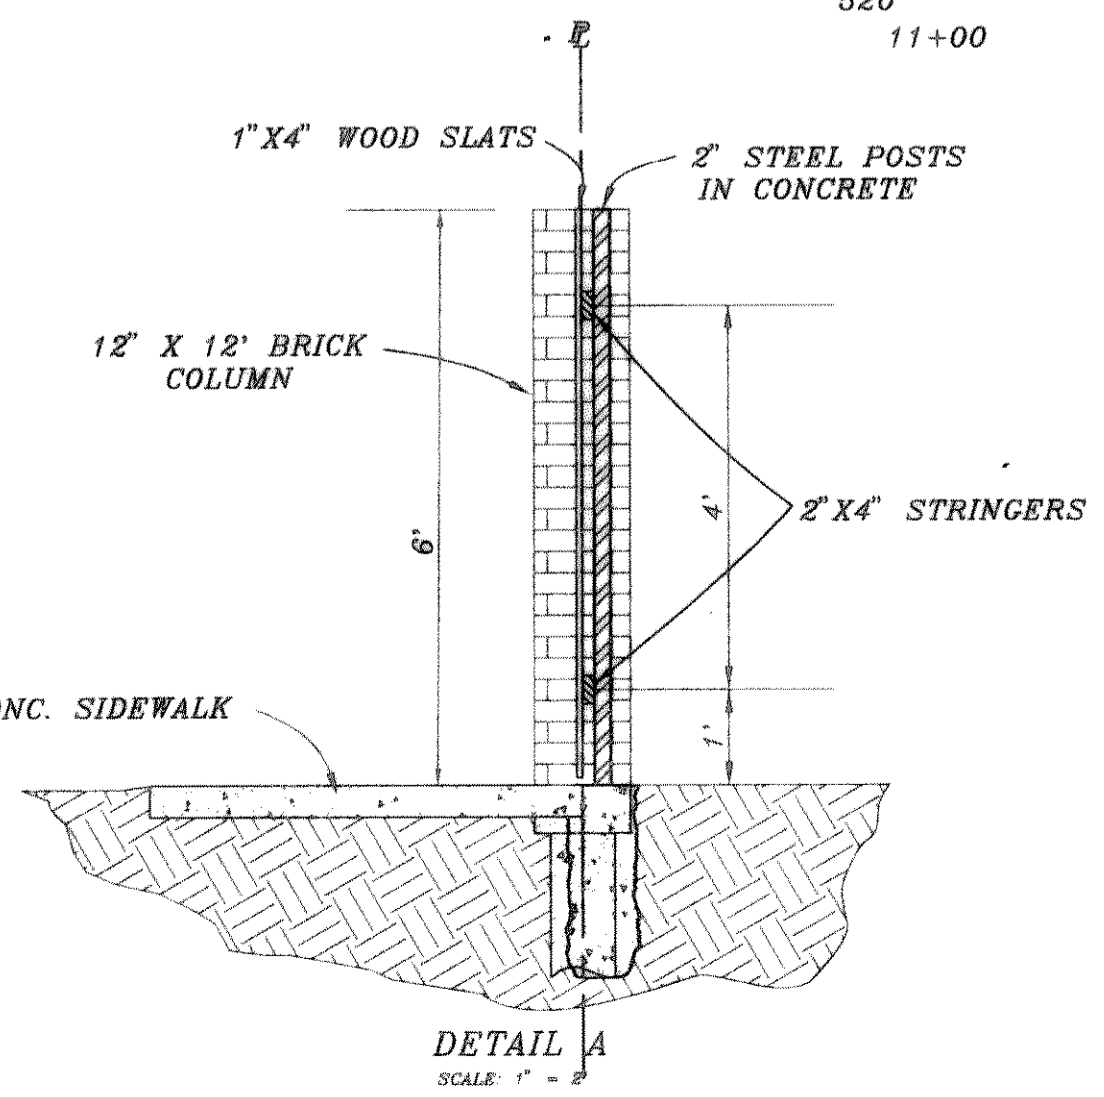

988MIMS REV PER 3rd REVIEW 11/45/95 REV PER 2nd REVIEW 11/5/95		<b>HAROLD L. EVANS</b> CONSULTING ENGINEER P.O. BOX 28855 2331 CUS THOMASSON ROAD, SUITE 102 DALLAS, TEXAS 75228, (214) 328-8133		<b>PROPOSED PAVING</b> <b>MIMS ROAD</b> <b>HIGHLAND MEADOWS</b> <b>CITY OF ROCKWALL</b>		SHEET NO. 12 23
REVISION DESCRIPTION 9/17/95		DATE 9/17/95	SCALE 1" = 40' 1" = 6'	DESIGN H.L.E.	DRAWN	JOB NO. 9563