


PLAN
 DESIGNED BY: []
 CHECKED BY: []
 DATE: []

PROFILE
 DESIGNED BY: []
 CHECKED BY: []
 DATE: []

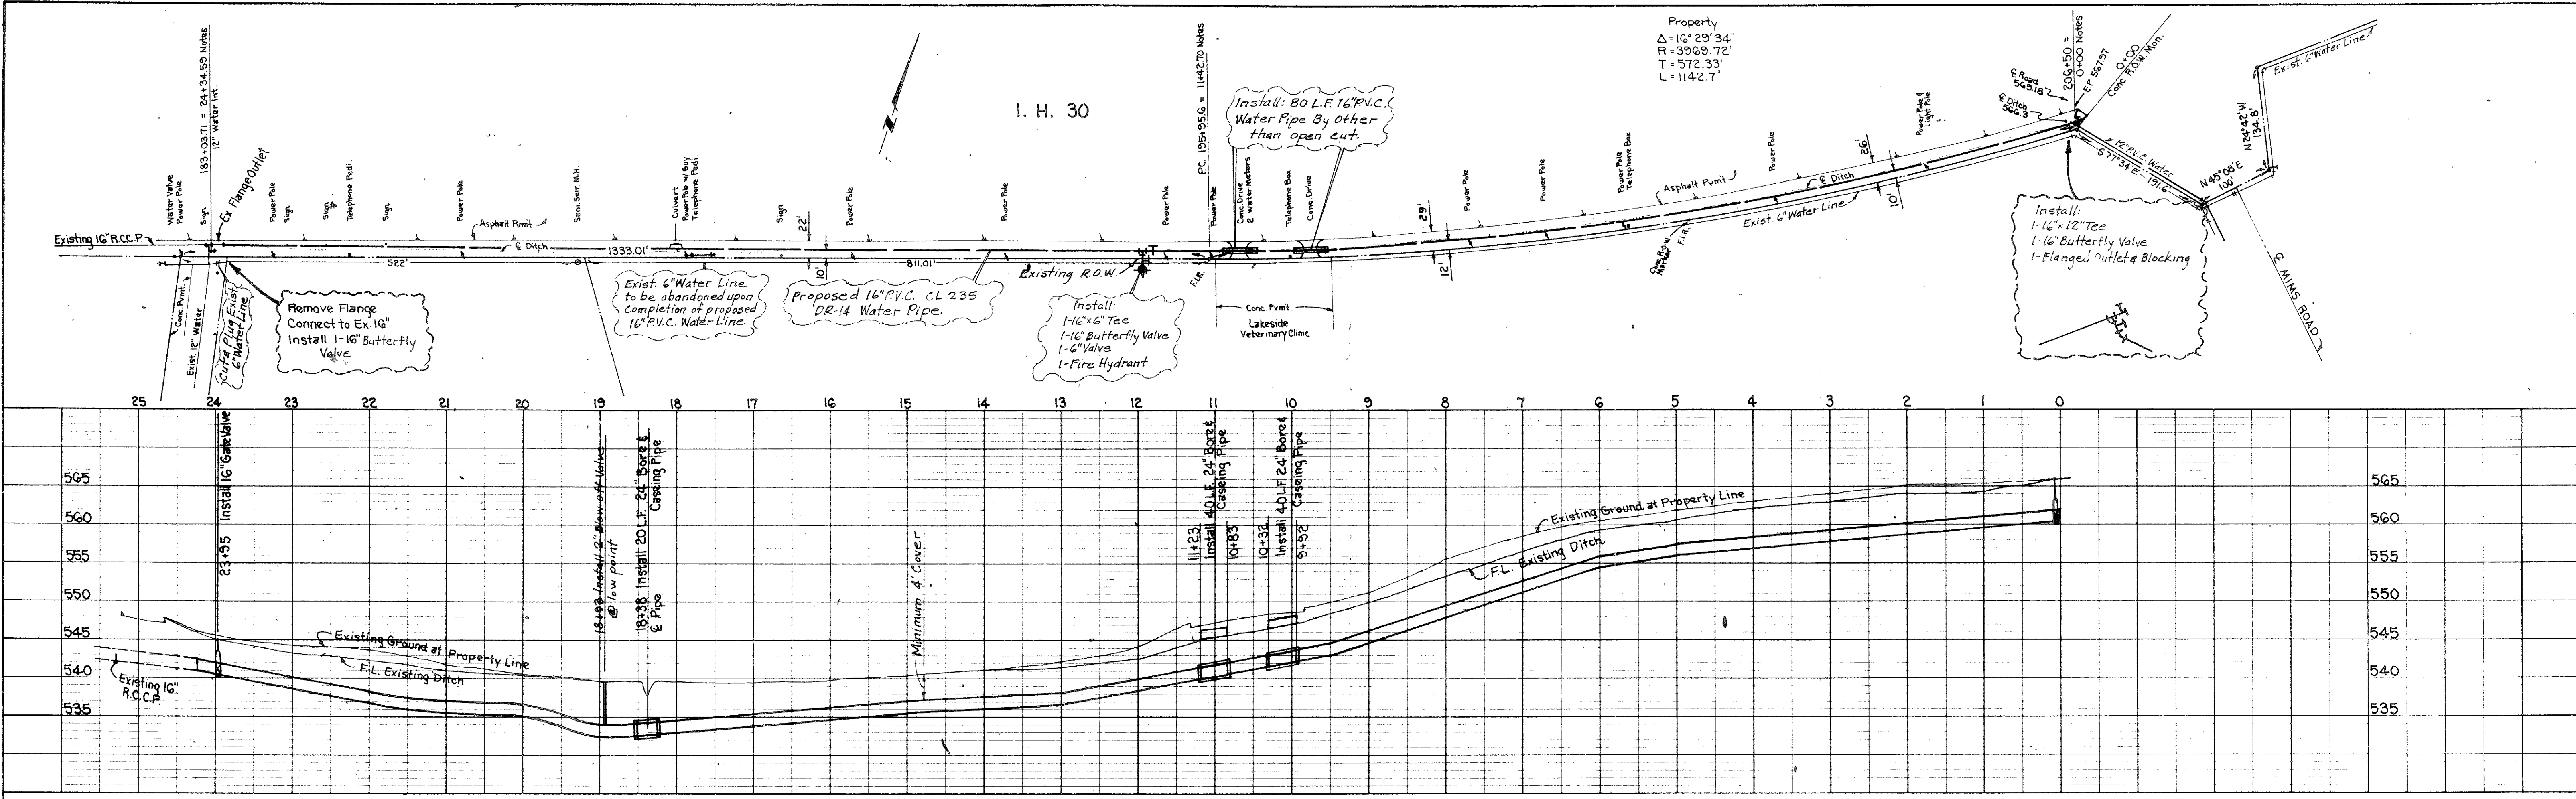

- BENCHMARKS:
- City of Rockwall Control Monument No. 7
Elev: 566.25
 - Top of existing manhole at Sta. 48 + 87.5, Buffalo Creek Interceptor Sewer
Elev: 515.72
 - Top of existing manhole at Sta. 37 + 41.5, Buffalo Creek Interceptor Sewer
Elev: 516.09

16" P.C.V. WATER LINE						
OFF-SITE WATER FOR HIGHLAND MEADOWS						
CITY OF ROCKWALL, ROCKWALL COUNTY, TEXAS						
HAROLD L. EVANS - CONSULTING ENGINEER						
DESIGN	DRAWN	DATE	SCALE	NOTES	Revisions	Date
H.L.E.	L.G.	7-19-95	H: 1"=100' V: 1"=10'	H.L.E.	1 Per City of Rockwall	7-22-95